
FHWA REGION NO.	STATE	PROJECT NO.	YEAR	SHEET NO.	TOTAL SHEETS
7	KANSAS	87 N 0024 – 01	1994	1	4

SCALE

PLAN: Lat. & Long. 20 0 20 40

PROFILE: Horiz. same as above

Vert.

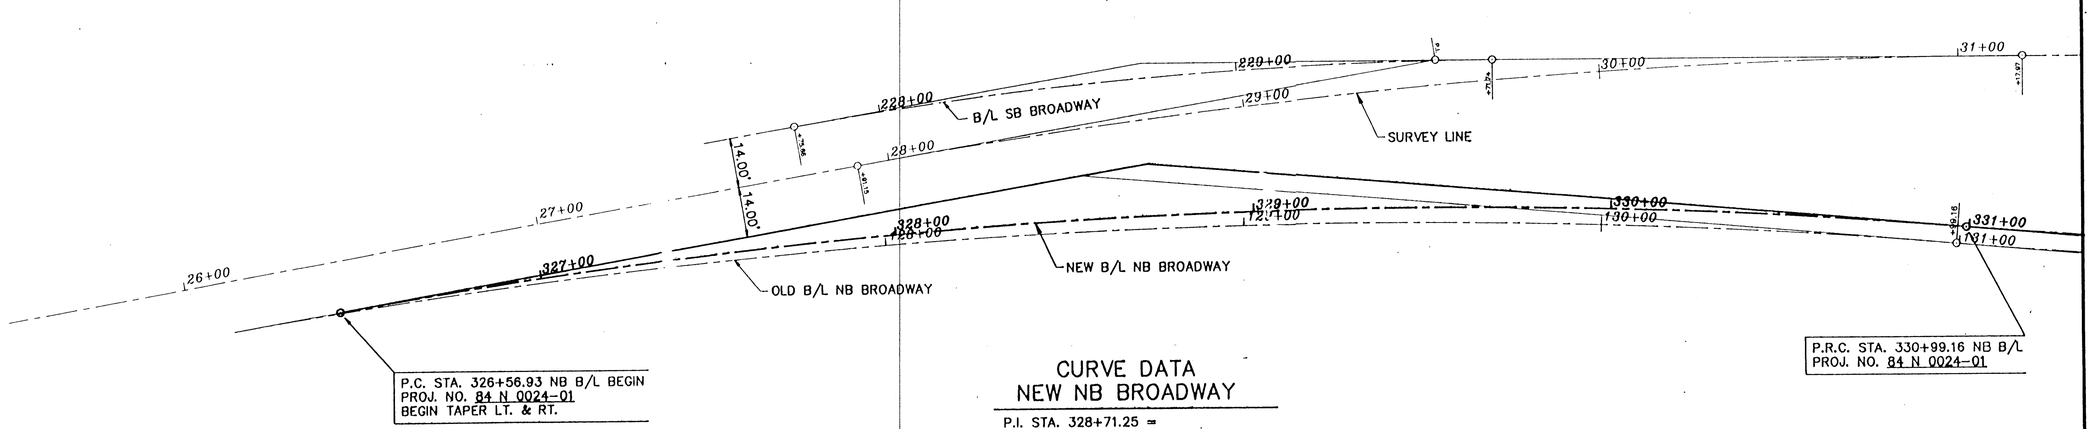

CURVE DATA
NEW NB BROADWAY

P.I. STA. 328+71.25 =
12.33' RT. STA. 28+71.25 SURVEY LINE
Δ = 14°37'26.2" RT.
D = 3°12'23.0"
R = 1786.93'
T = 229.29'
L = 456.09'
E = 14.65'

JOHN MACK BRIDGE
RE–ALIGNMENT

CARBER SURVEYING SERVICE, P.A.
CSS 423 WEST FIRST AVENUE
HUTCHINSON, KANSAS 67601
Ph. 316-665-7058 Fax 316-665-7401

BROADWAY PLAN
STA. 326+00 to STA. 331+00

Drawn By: RDB	Checked By: DEO
Scale: 20'	Job No.: C96–143
Date: 05/23/1996	Sheet 1 of 4 Sheets