

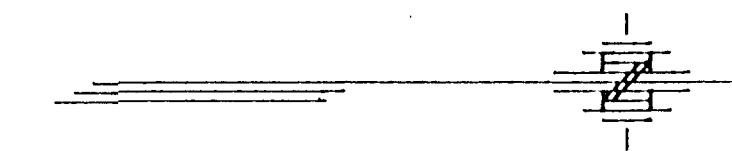


FHWA REGION NO.	STATE	PROJECT NO.	YEAR	SHEET NO.	TOTAL SHEETS
7	KANSAS	87 N 0024 - 01	1994	4	4

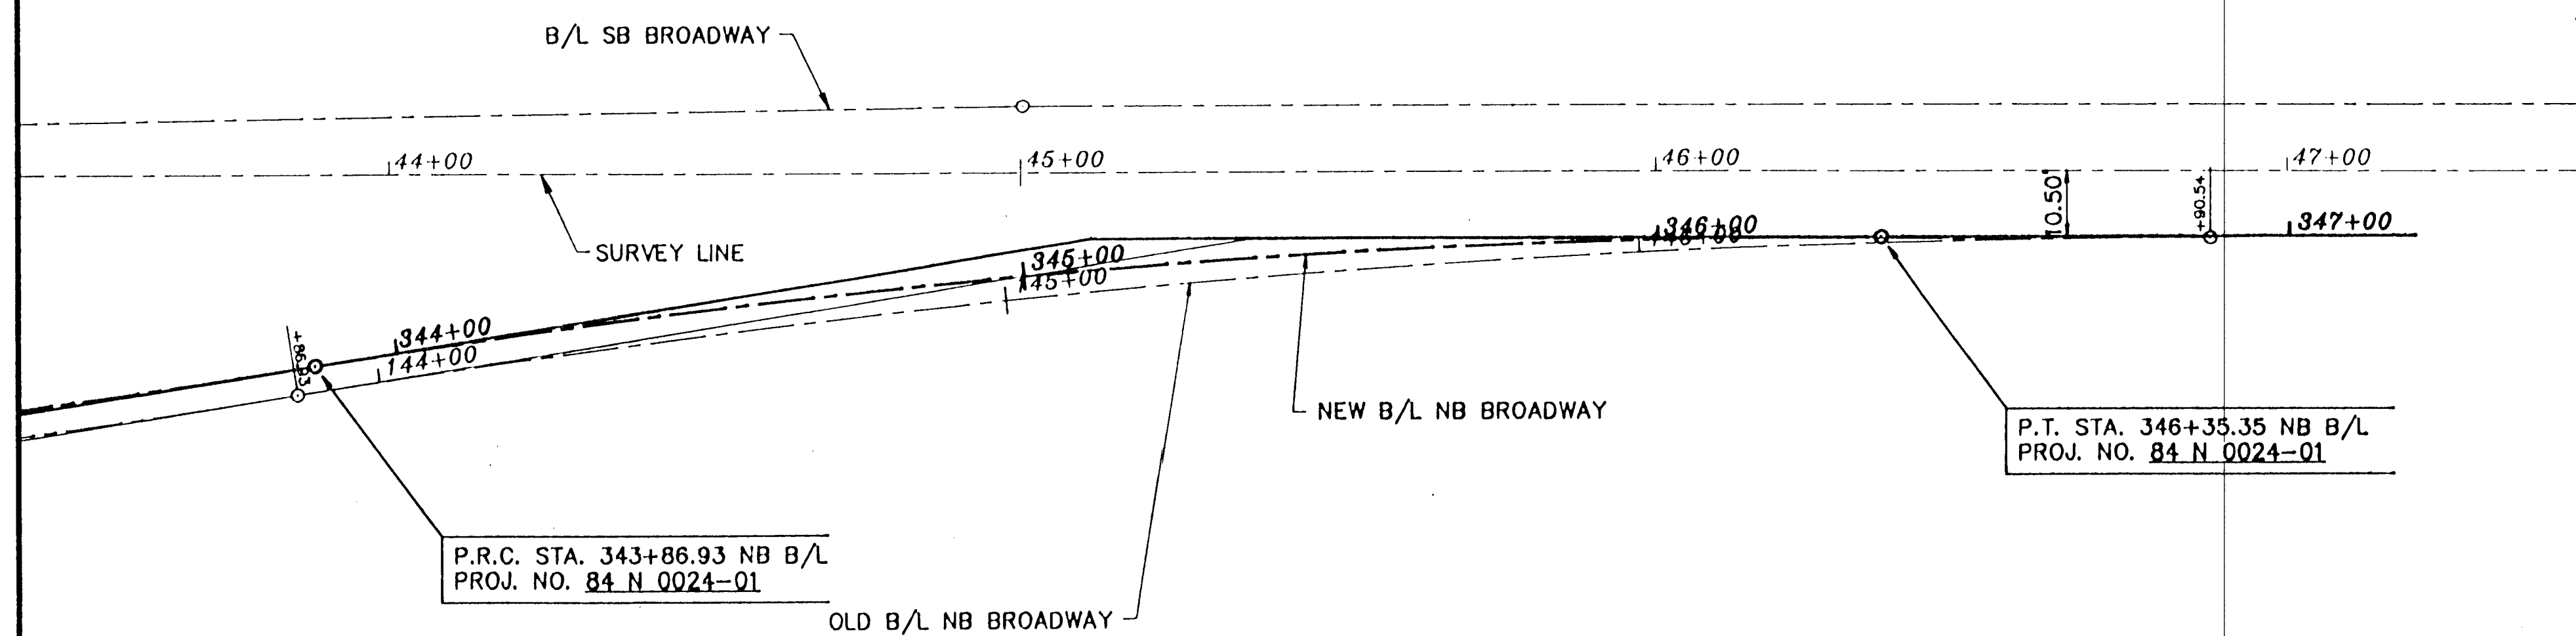

SCALE

PLAN: Lat. & Long.
PROFILE: Horiz. same as above
Vert.

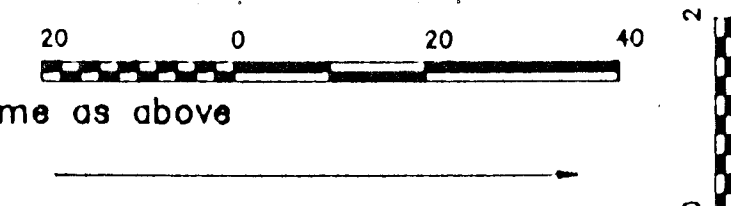

**CURVE DATA
NEW NB BROADWAY**

P.I. STA. 345+11.14 =
10.50' RT. STA. 45+11.23 SURVEY LINE
 $\Delta = 9^{\circ}05'28.8''$ LT.
 $D = 3^{\circ}39'34.8''$
 $R = 1565.60'$
 $T = 124.47'$
 $L = 248.42'$
 $E = 4.94'$

RE-ALIGNMENT

CARBER SURVEYING SERVICE, P.A.

CSS 423 WEST FIRST AVENUE
HUTCHINSON, KANSAS 67601
Ph 316-665-7032 Fax 316-665-7401

BROADWAY PLAN
STA. 343+00 to STA. 347+00

Drawn By: RDB	Checked By: DEG
Scale: 1"=20'	Job No.: C95-143
Date: 05/23/1995	Sheet 4 of 4 Sheets