


BENCHMARKS:


- #1 Top of 1/2" Iron in 6"x6" Box Located At the NE Cor. NE 1/4 Sec. 25, Twp. 27-S, R-2-W ELEV. = 141.03 CITY DATUM
- #2 RR Spike in Gulpole Located 9.28' E & 52.92' S of the SE Cor. of Reserve "A". ELEV. = 128.92 CITY DATUM

THUNDERBIRD OFFICE PARK

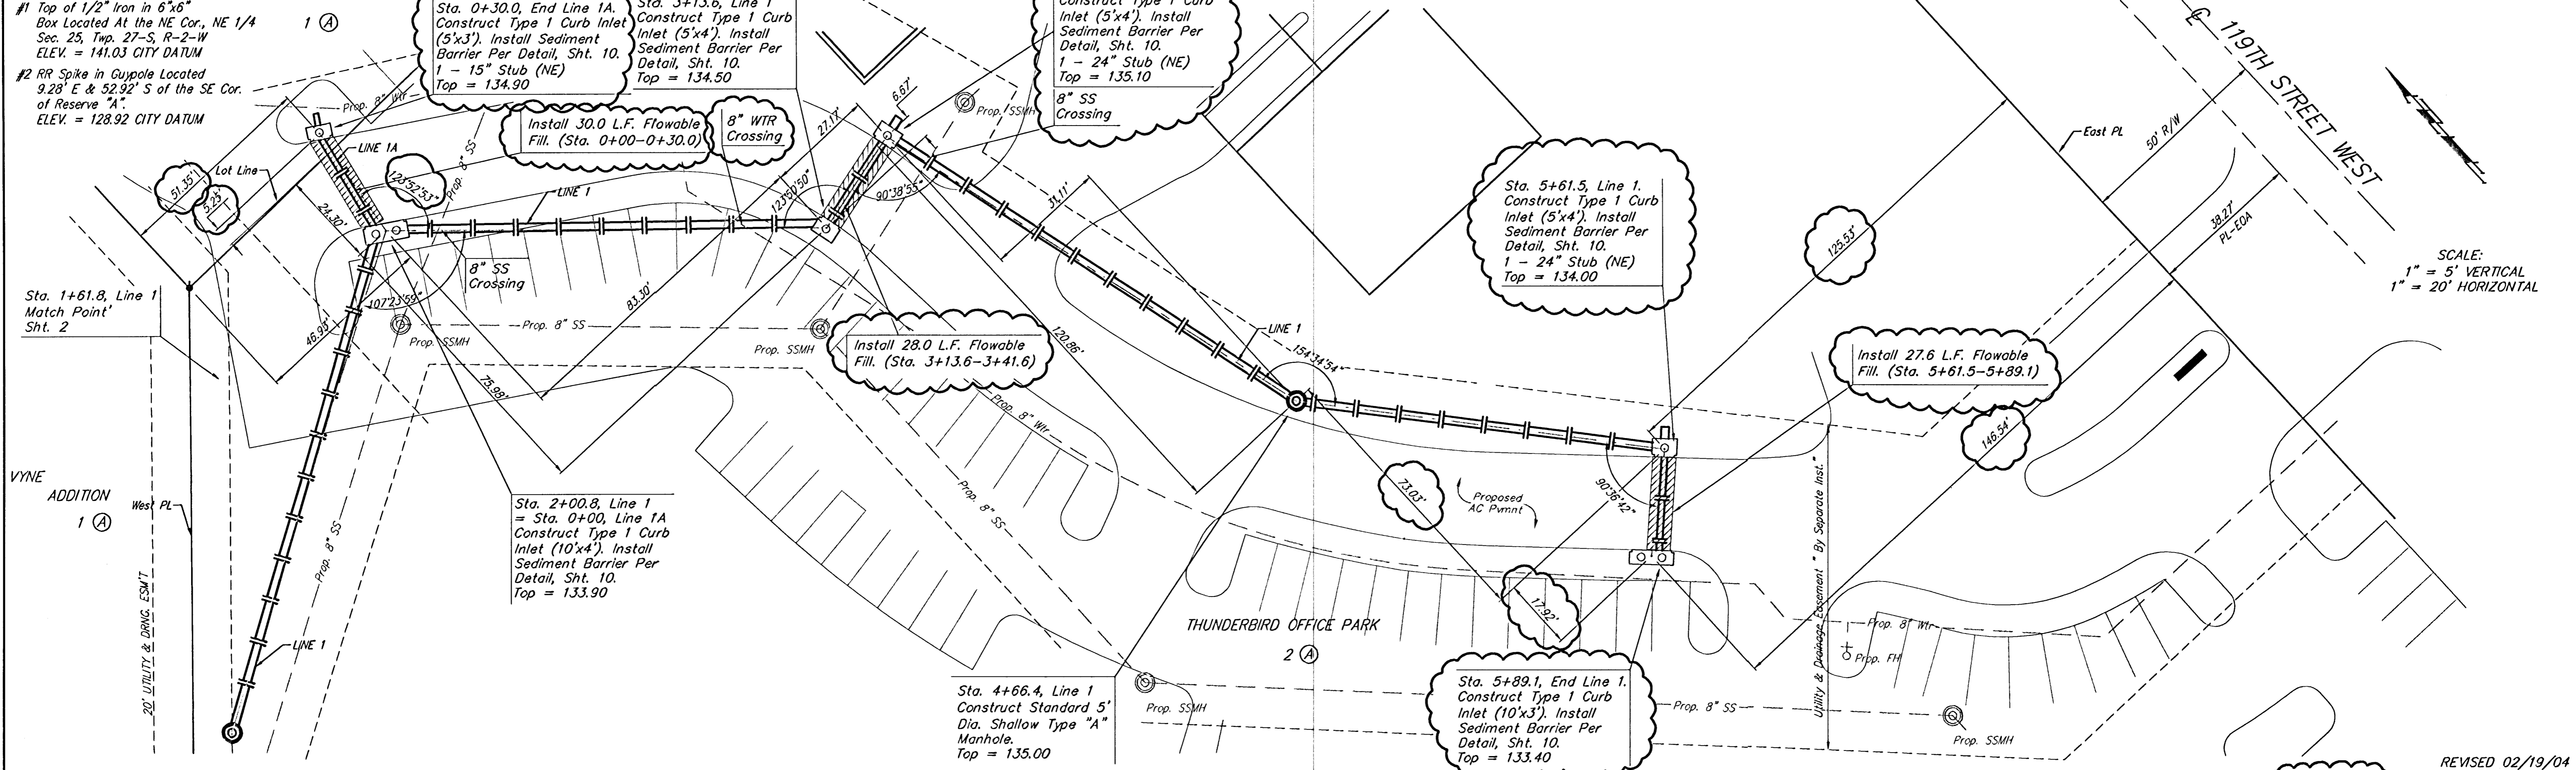

SCALE:
1" = 5' VERTICAL
1" = 20' HORIZONTAL

REVISED 02/19/04

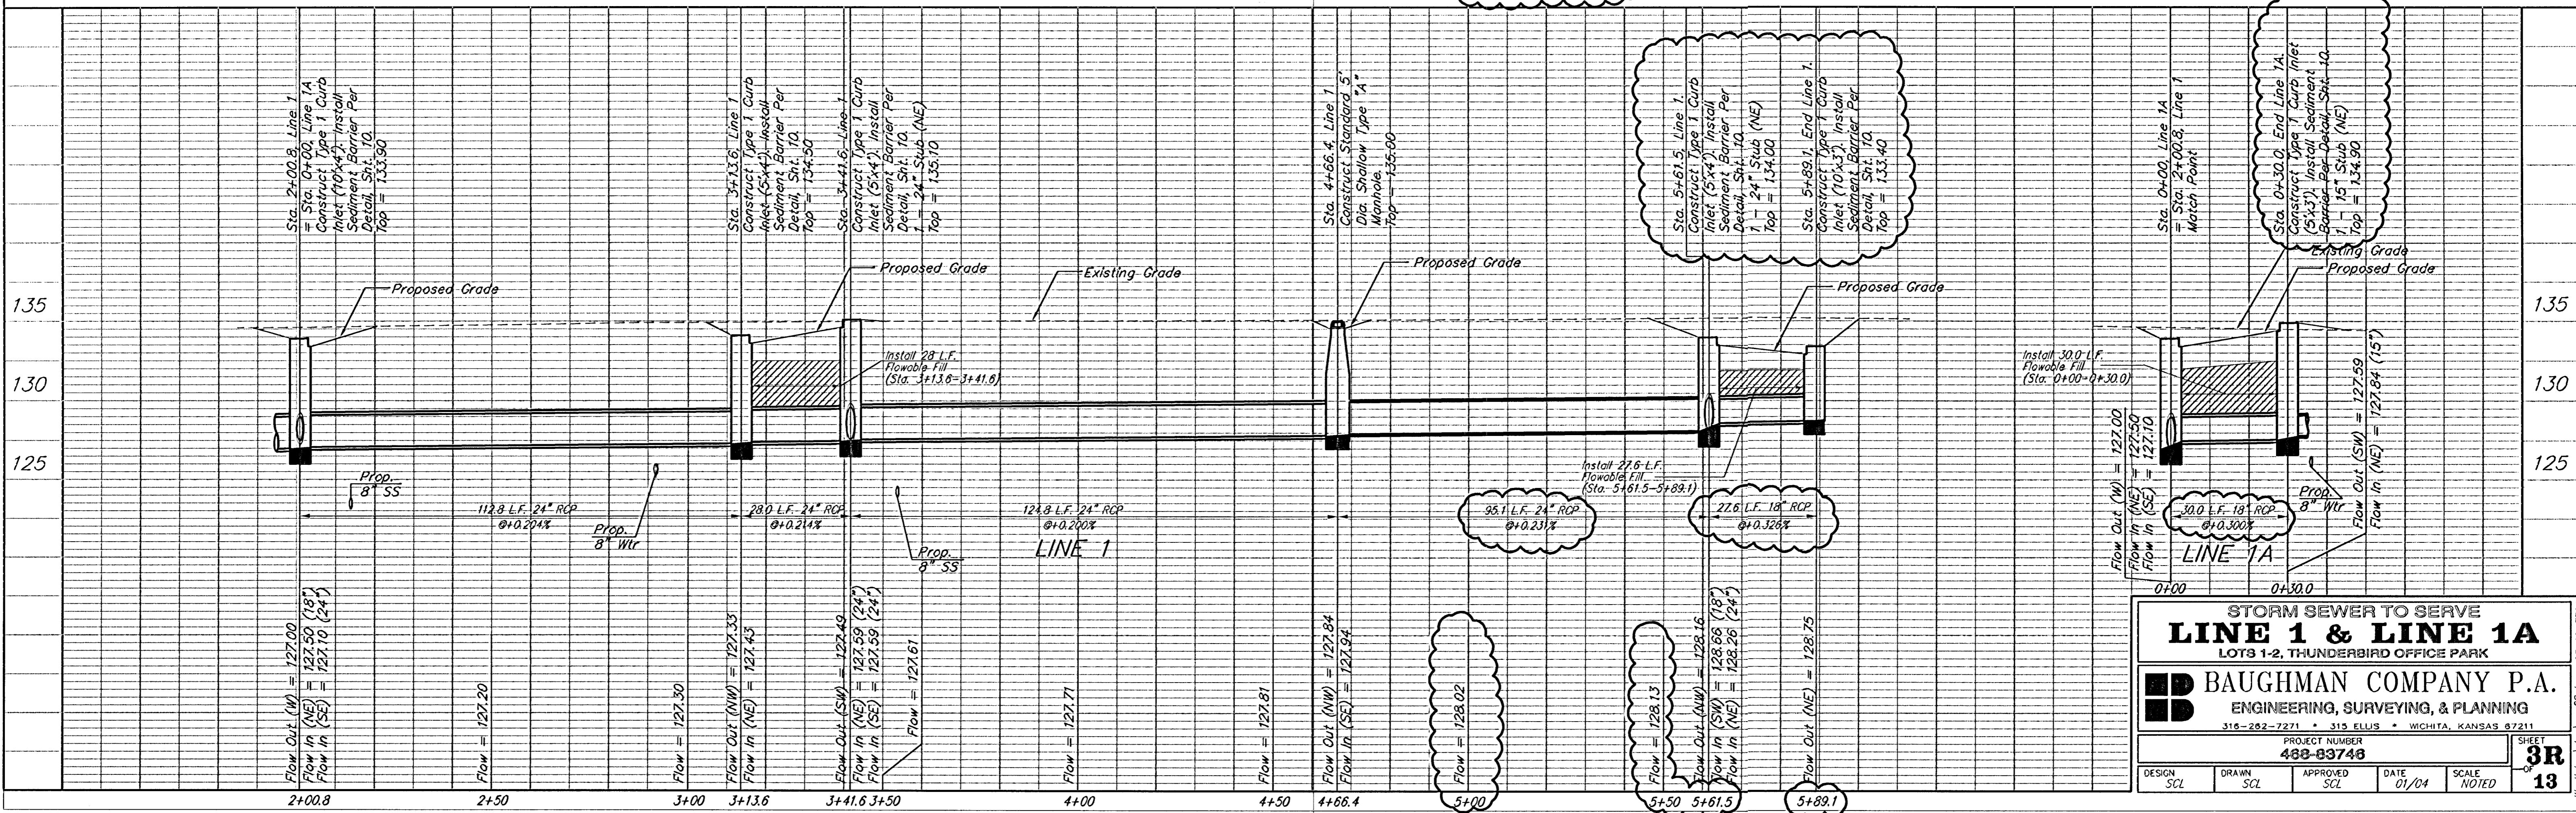

STORM SEWER TO SERVE
LINE 1 & LINE 1A
LOTS 1-2, THUNDERBIRD OFFICE PARK

BAUGHMAN COMPANY P.A.
ENGINEERING, SURVEYING, & PLANNING
316-282-7271 • 315 ELLIS • WICHITA, KANSAS 67211

PROJECT NUMBER: **488-83748**

DESIGN: SCL | DRAWN: SCL | APPROVED: SCL | DATE: 01/04 | SCALE: NOTED

SHEET **3R** OF **13**