FHWA REGION NO.	STATE	PROJECT NO.:	YEAR	SHEET NUMBER	TOTAL SHEETS
7	KANSAS	81-87 K-5988-01	1997	13	18

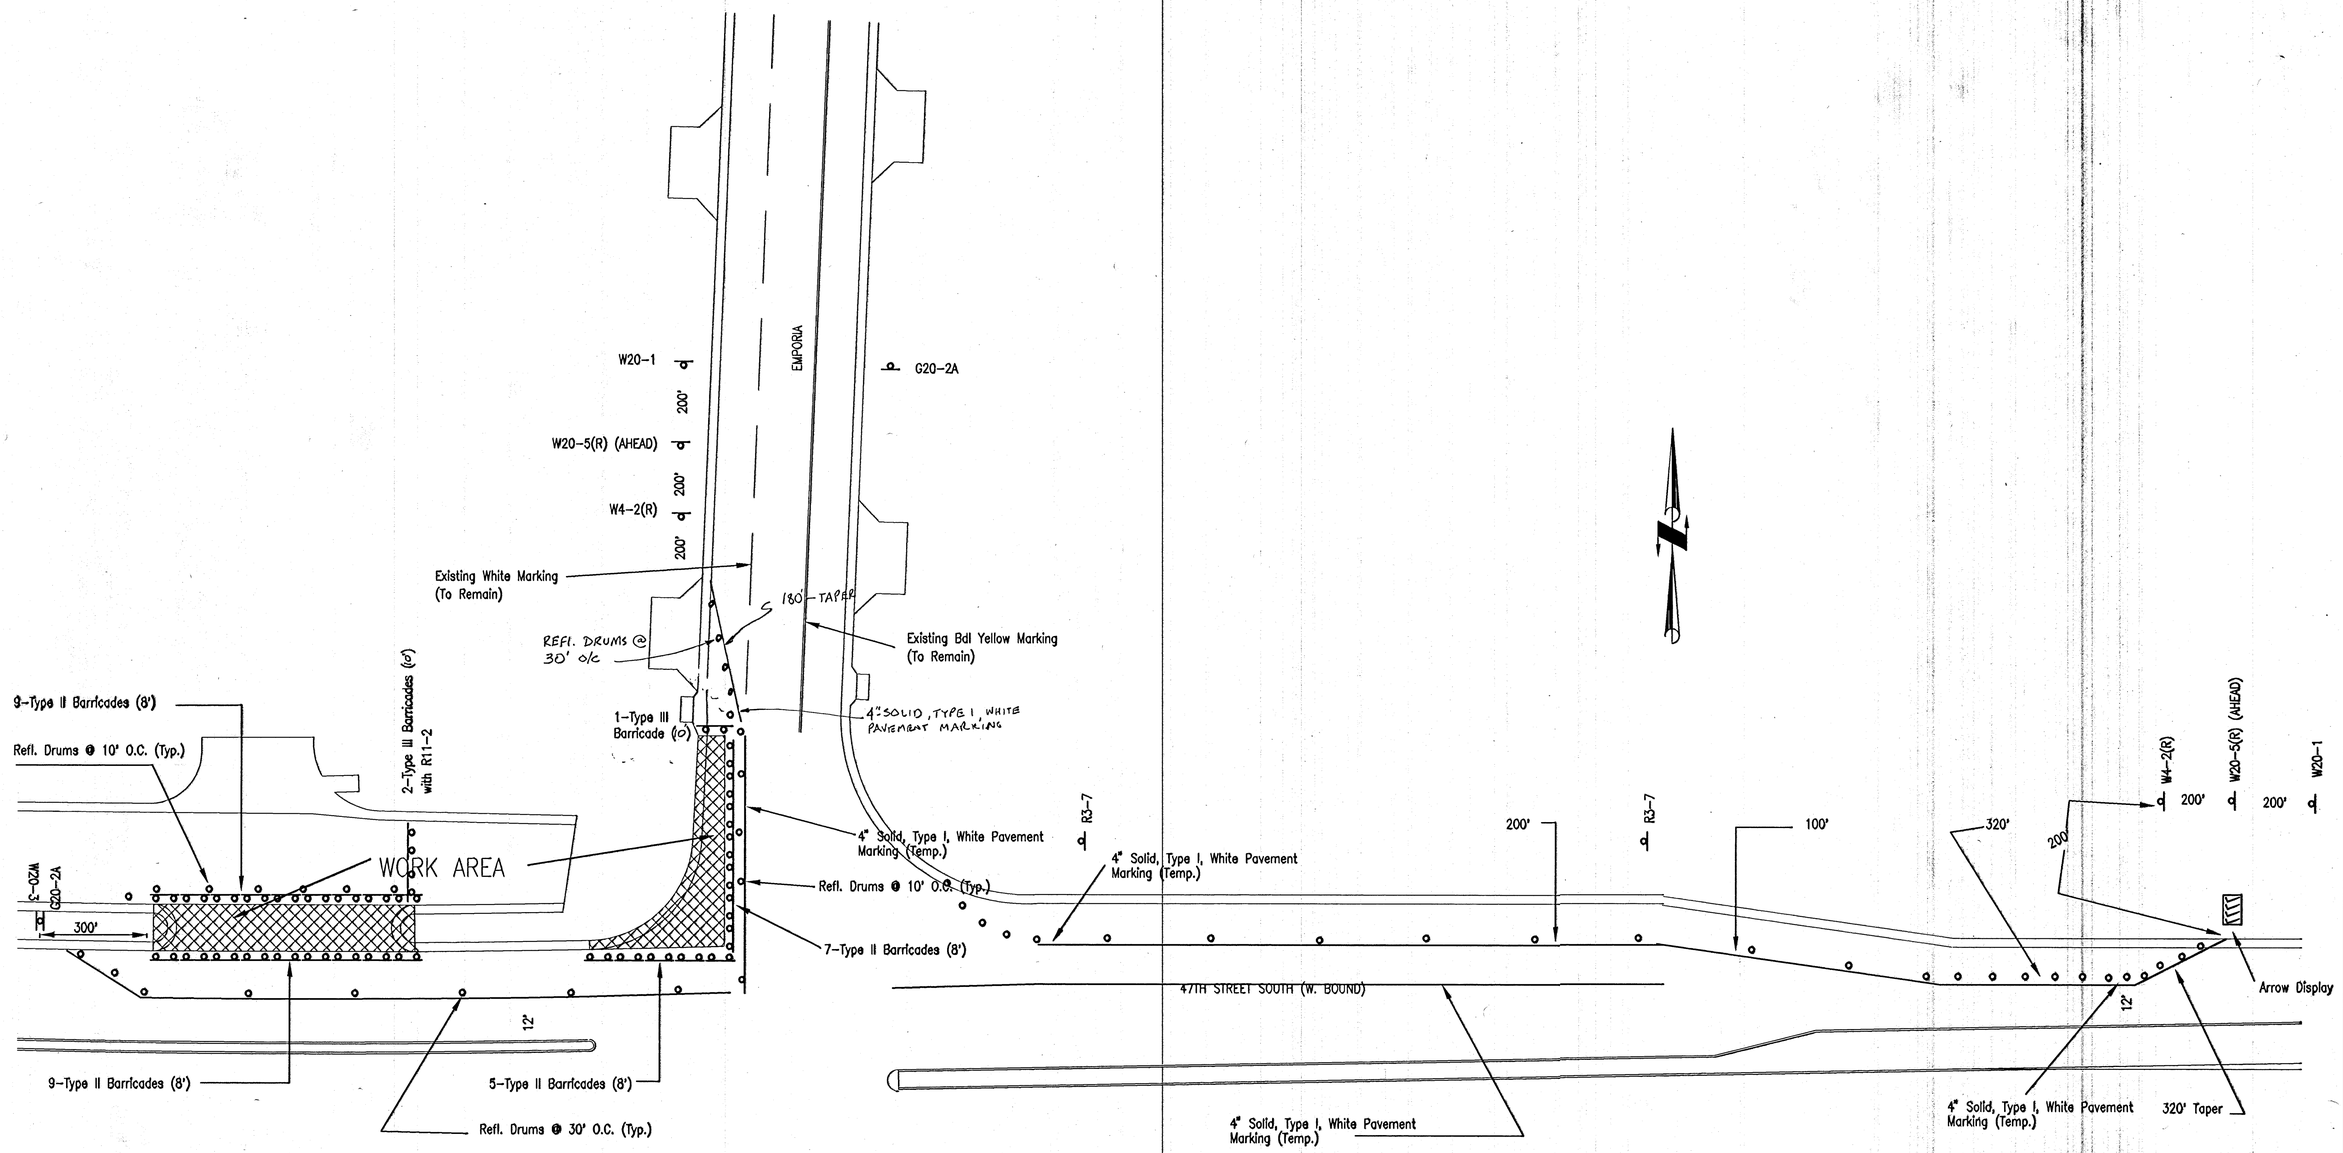

47TH STREET SOUTH & EMPORIA
CONSTRUCTION TRAFFIC CONTROL PLAN

SCALE:	APPROVED:	DRAWN BY:
DATE:		CHECKED:
PROJECT NO:		SHEET NO.: 1

MUNICIPAL ENGINEERS
214-LAURA, SUITE 201
WICHITA, KANSAS 67211
316-262-3042