

NOTES:

1. All embankment material to be placed in median to be Select Soil.
2. Contractor to resod all disturbed areas outside of designated sodding limits.
3. Top 150 mm of all embankments west of Hillside to be Select Soil.




Scale: 1 : 200


Shadybrook Addition
Block 13

Shadybrook Addition
Block 14

Shadybrook Addition
Block 15

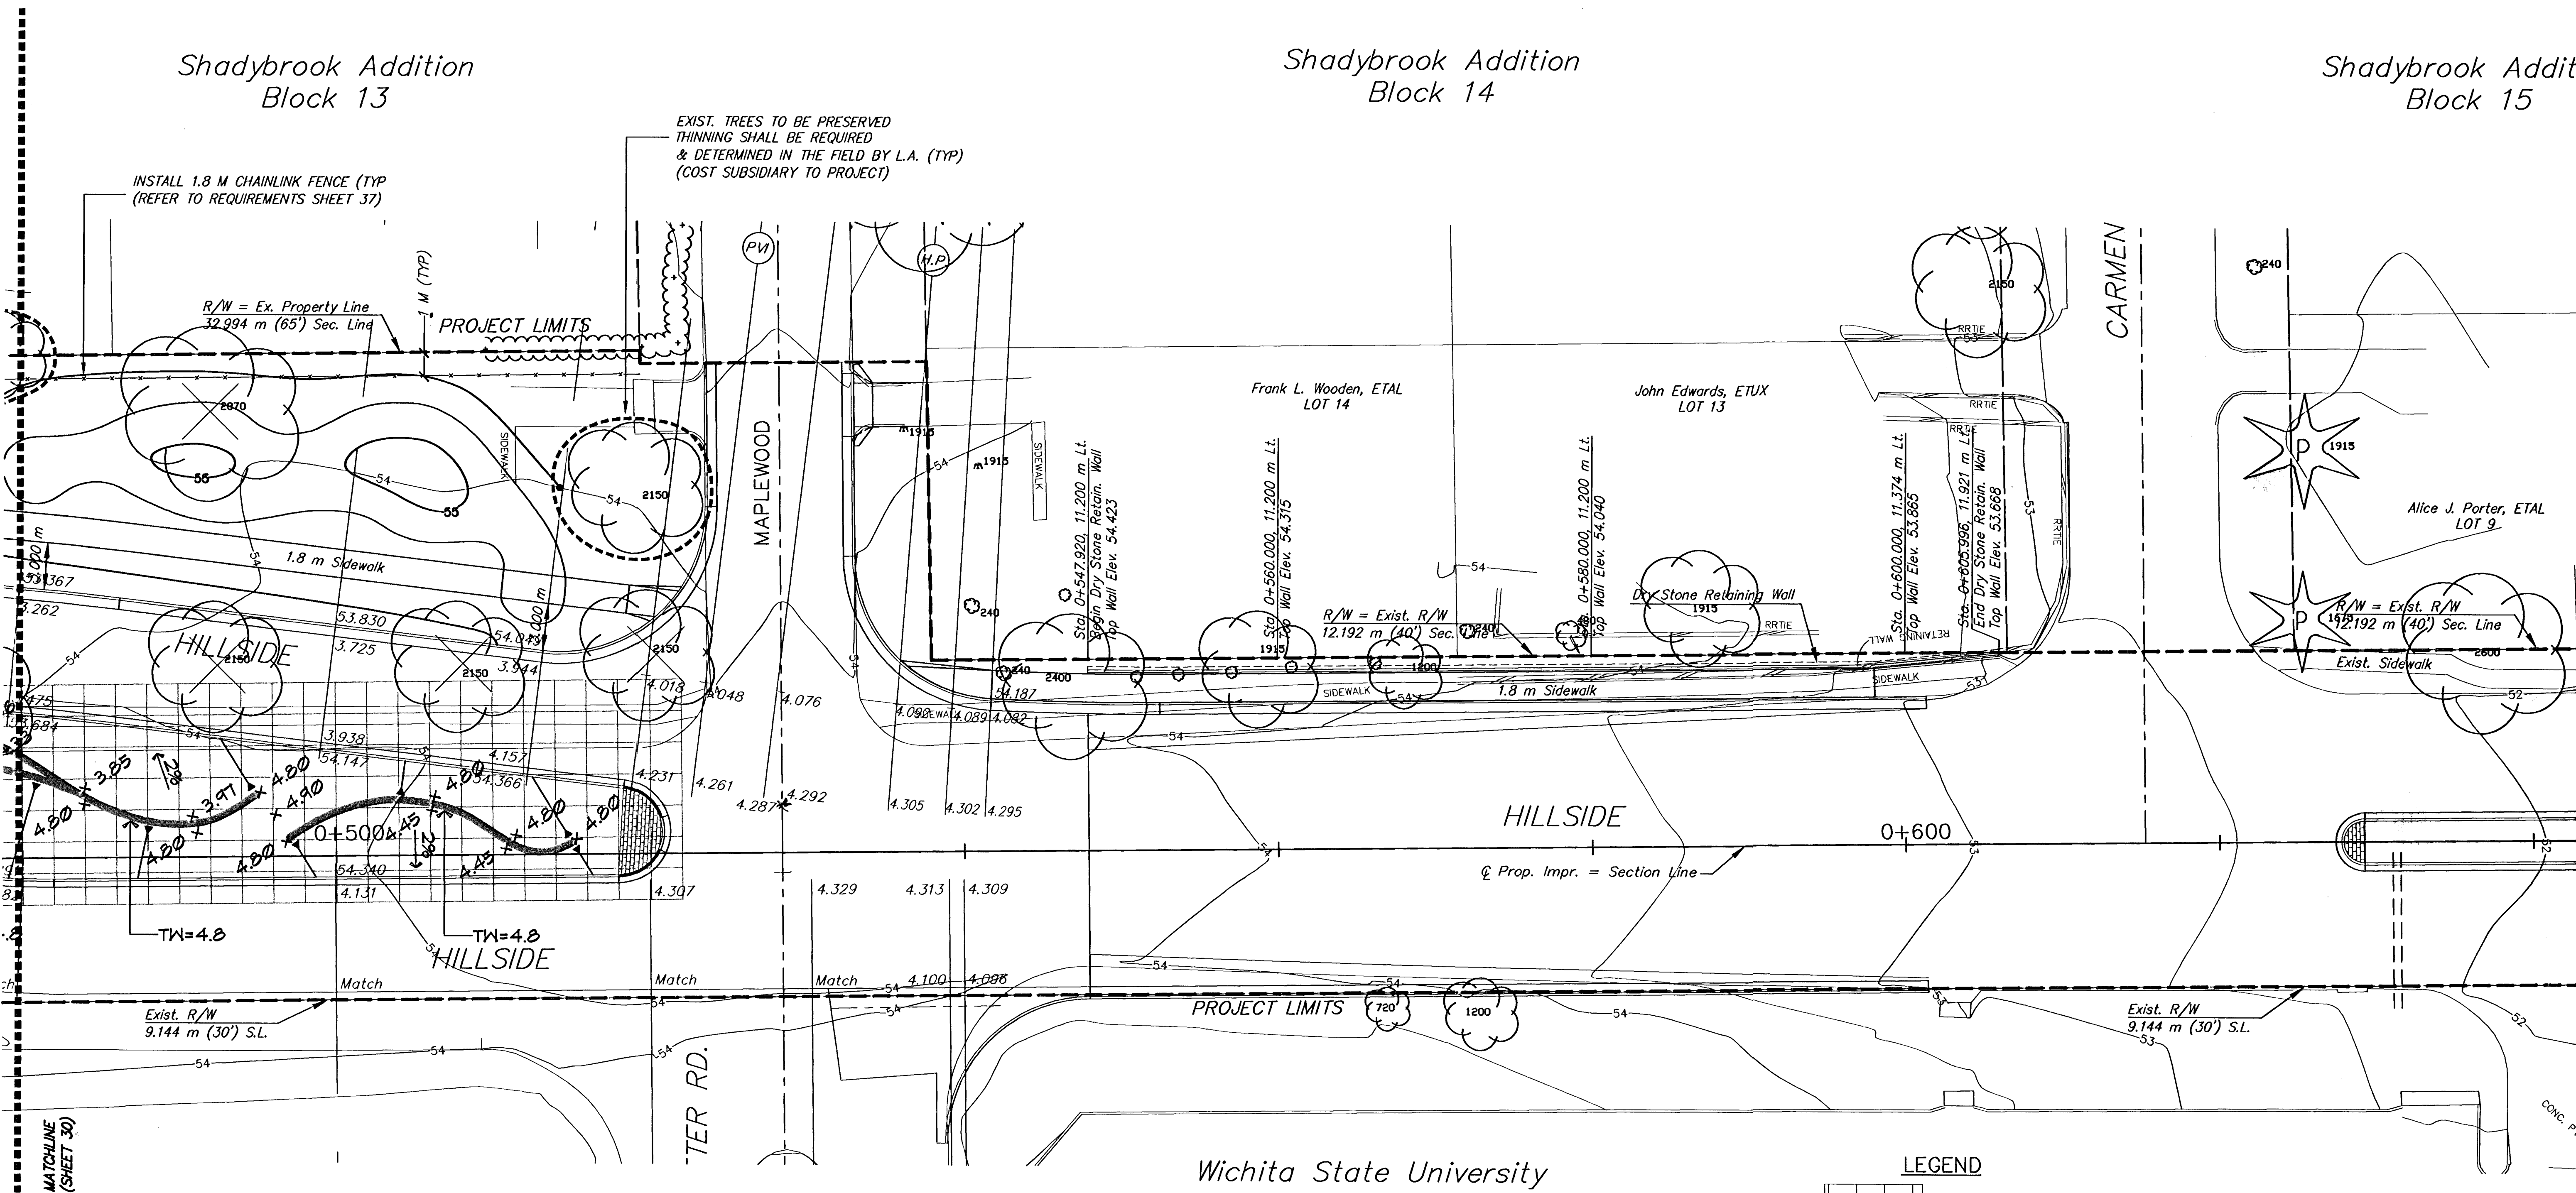

LEGEND

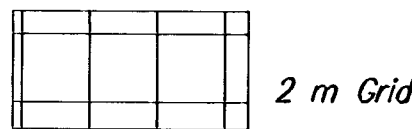

59.0 Proposed Grading Contour

Tree to be removed

Slope Arrow

H:\GVL\01053\PAVE\01053RS3.DWG 05/01/03 02:44:58 PM CDT

ROADSIDE IMPROVEMENTS
STA. 0+480 TO STA. 0+640

PROJ. NO. 472-83537 SEDGWICK CO.

MKEC ENGINEERING CONSULTANTS, INC.
WICHITA, KANSAS

DESIGNED BY: MKEC	CHECKED BY: MKEC
DRAWN BY: BJH	DATE: 04/03 SHEET 31 OF 73