
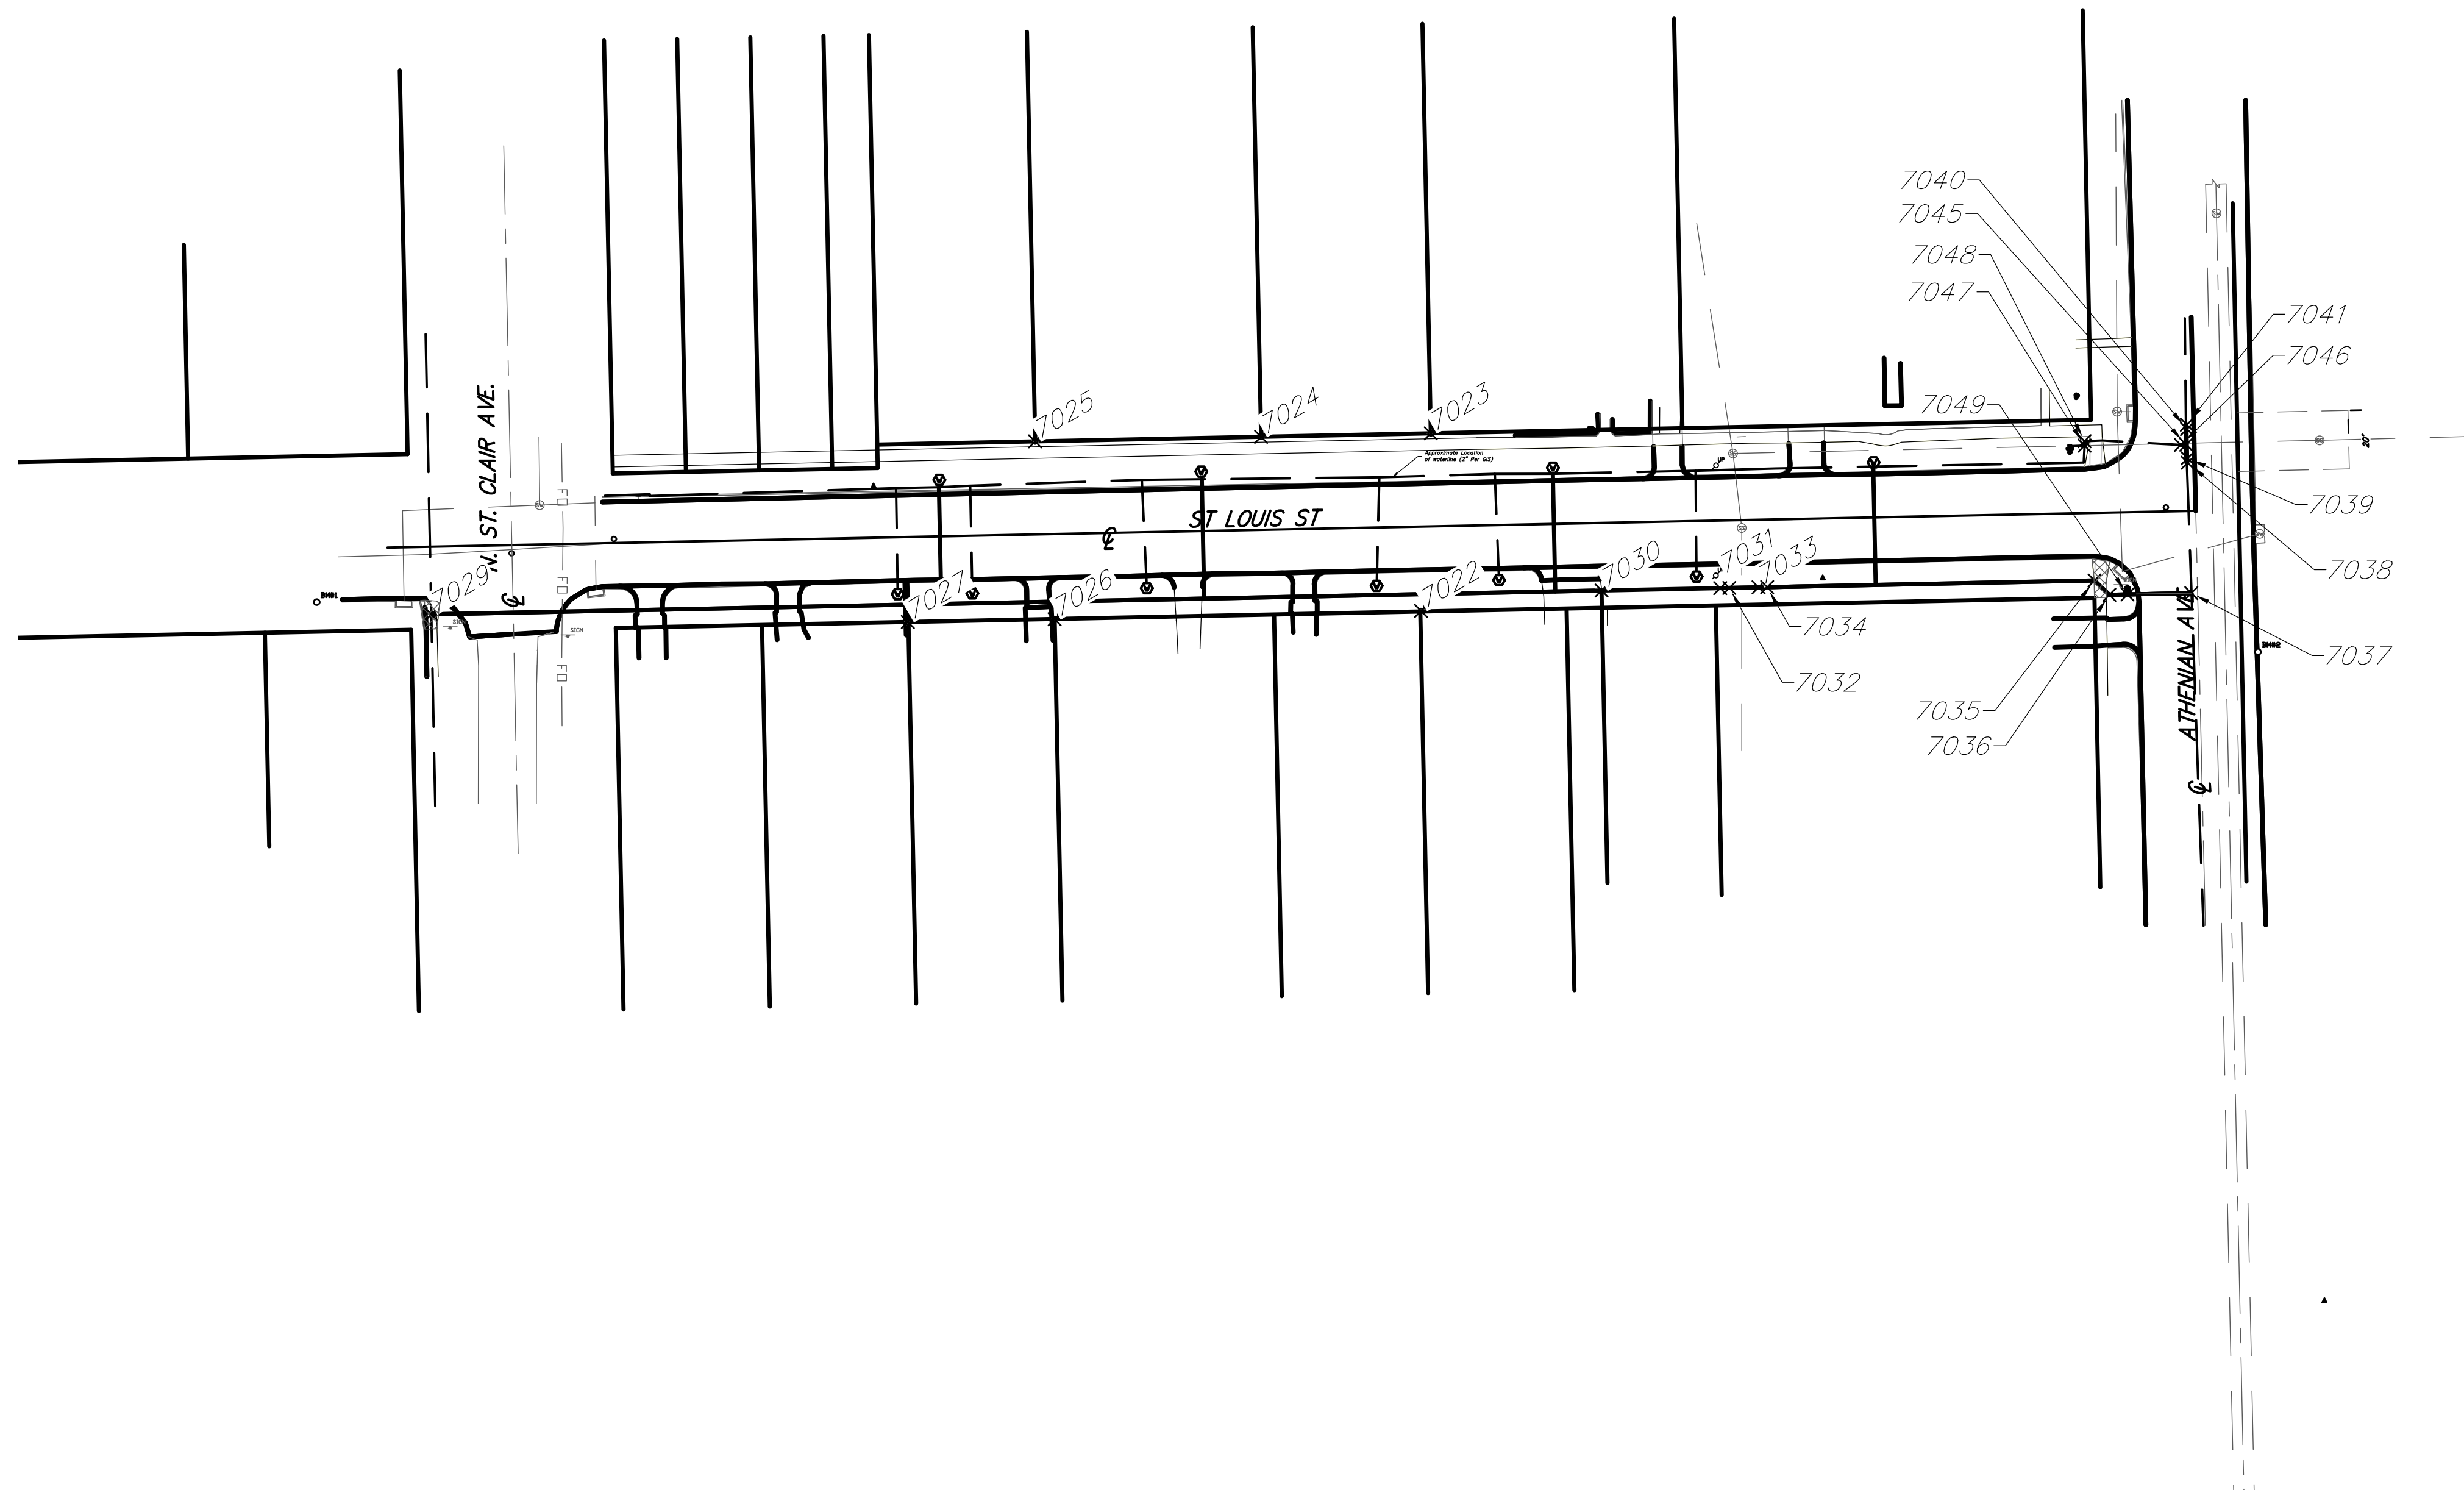


IRONS

Point Table			
Point #	Northing	Easting	Raw Description
7022	1687506.06	1639965.94	Iron
7023	1687566.74	1639969.29	Iron
7024	1687565.53	1639911.29	Iron
7025	1687563.99	1639834.06	Iron
7026	1687503.22	1639840.74	Iron
7027	1687502.27	1639790.57	Iron

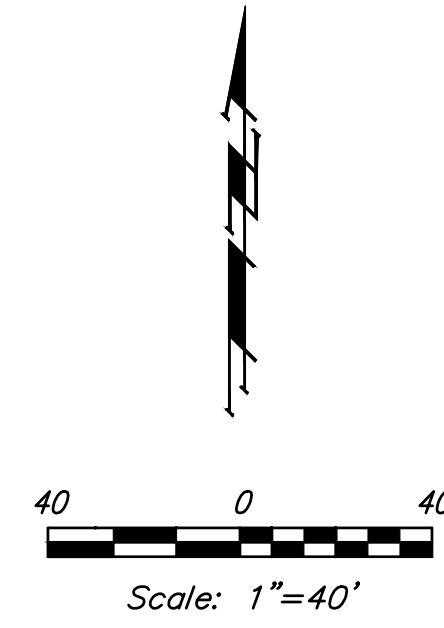

WATER DISTRIBUTION SYSTEM

Point Table			
Point #	Northing	Easting	Raw Description
7029	1687504.88	1639627.73	8"x 8" Tapping Valve
7030	1687513.02	1640027.66	Match Point
7031	1687513.85	1640068.20	45° Bend
7032	1687513.91	1640071.31	45° Bend
7033	1687514.12	1640081.30	45° Bend
7034	1687514.18	1640084.24	45° Bend
7035	1687516.45	1640196.11	45° Bend
7036	1687511.56	1640201.21	45° Bend
7037	1687512.13	1640229.19	8"x 8" Tapping Valve
7038	1687556.69	1640227.94	45° Bend
7039	1687558.20	1640227.91	45° Bend
7040	1687568.20	1640227.72	45° Bend
7041	1687569.67	1640227.69	45° Bend
7045	1687562.87	1640227.45	8"x 8" Tee
7046	1687562.77	1640225.62	Adjust Valve Box
7047	1687562.56	1640192.72	90° Bend
7048	1687564.04	1640192.71	90° Bend
7049	1687511.68	1640207.39	Fire Hydrant Assembly

