


FHWA Region No.	State	Project Number	Year	Sheet No.	Total Sheets
7	Kansas	472-82477	1994	4	38

K-42

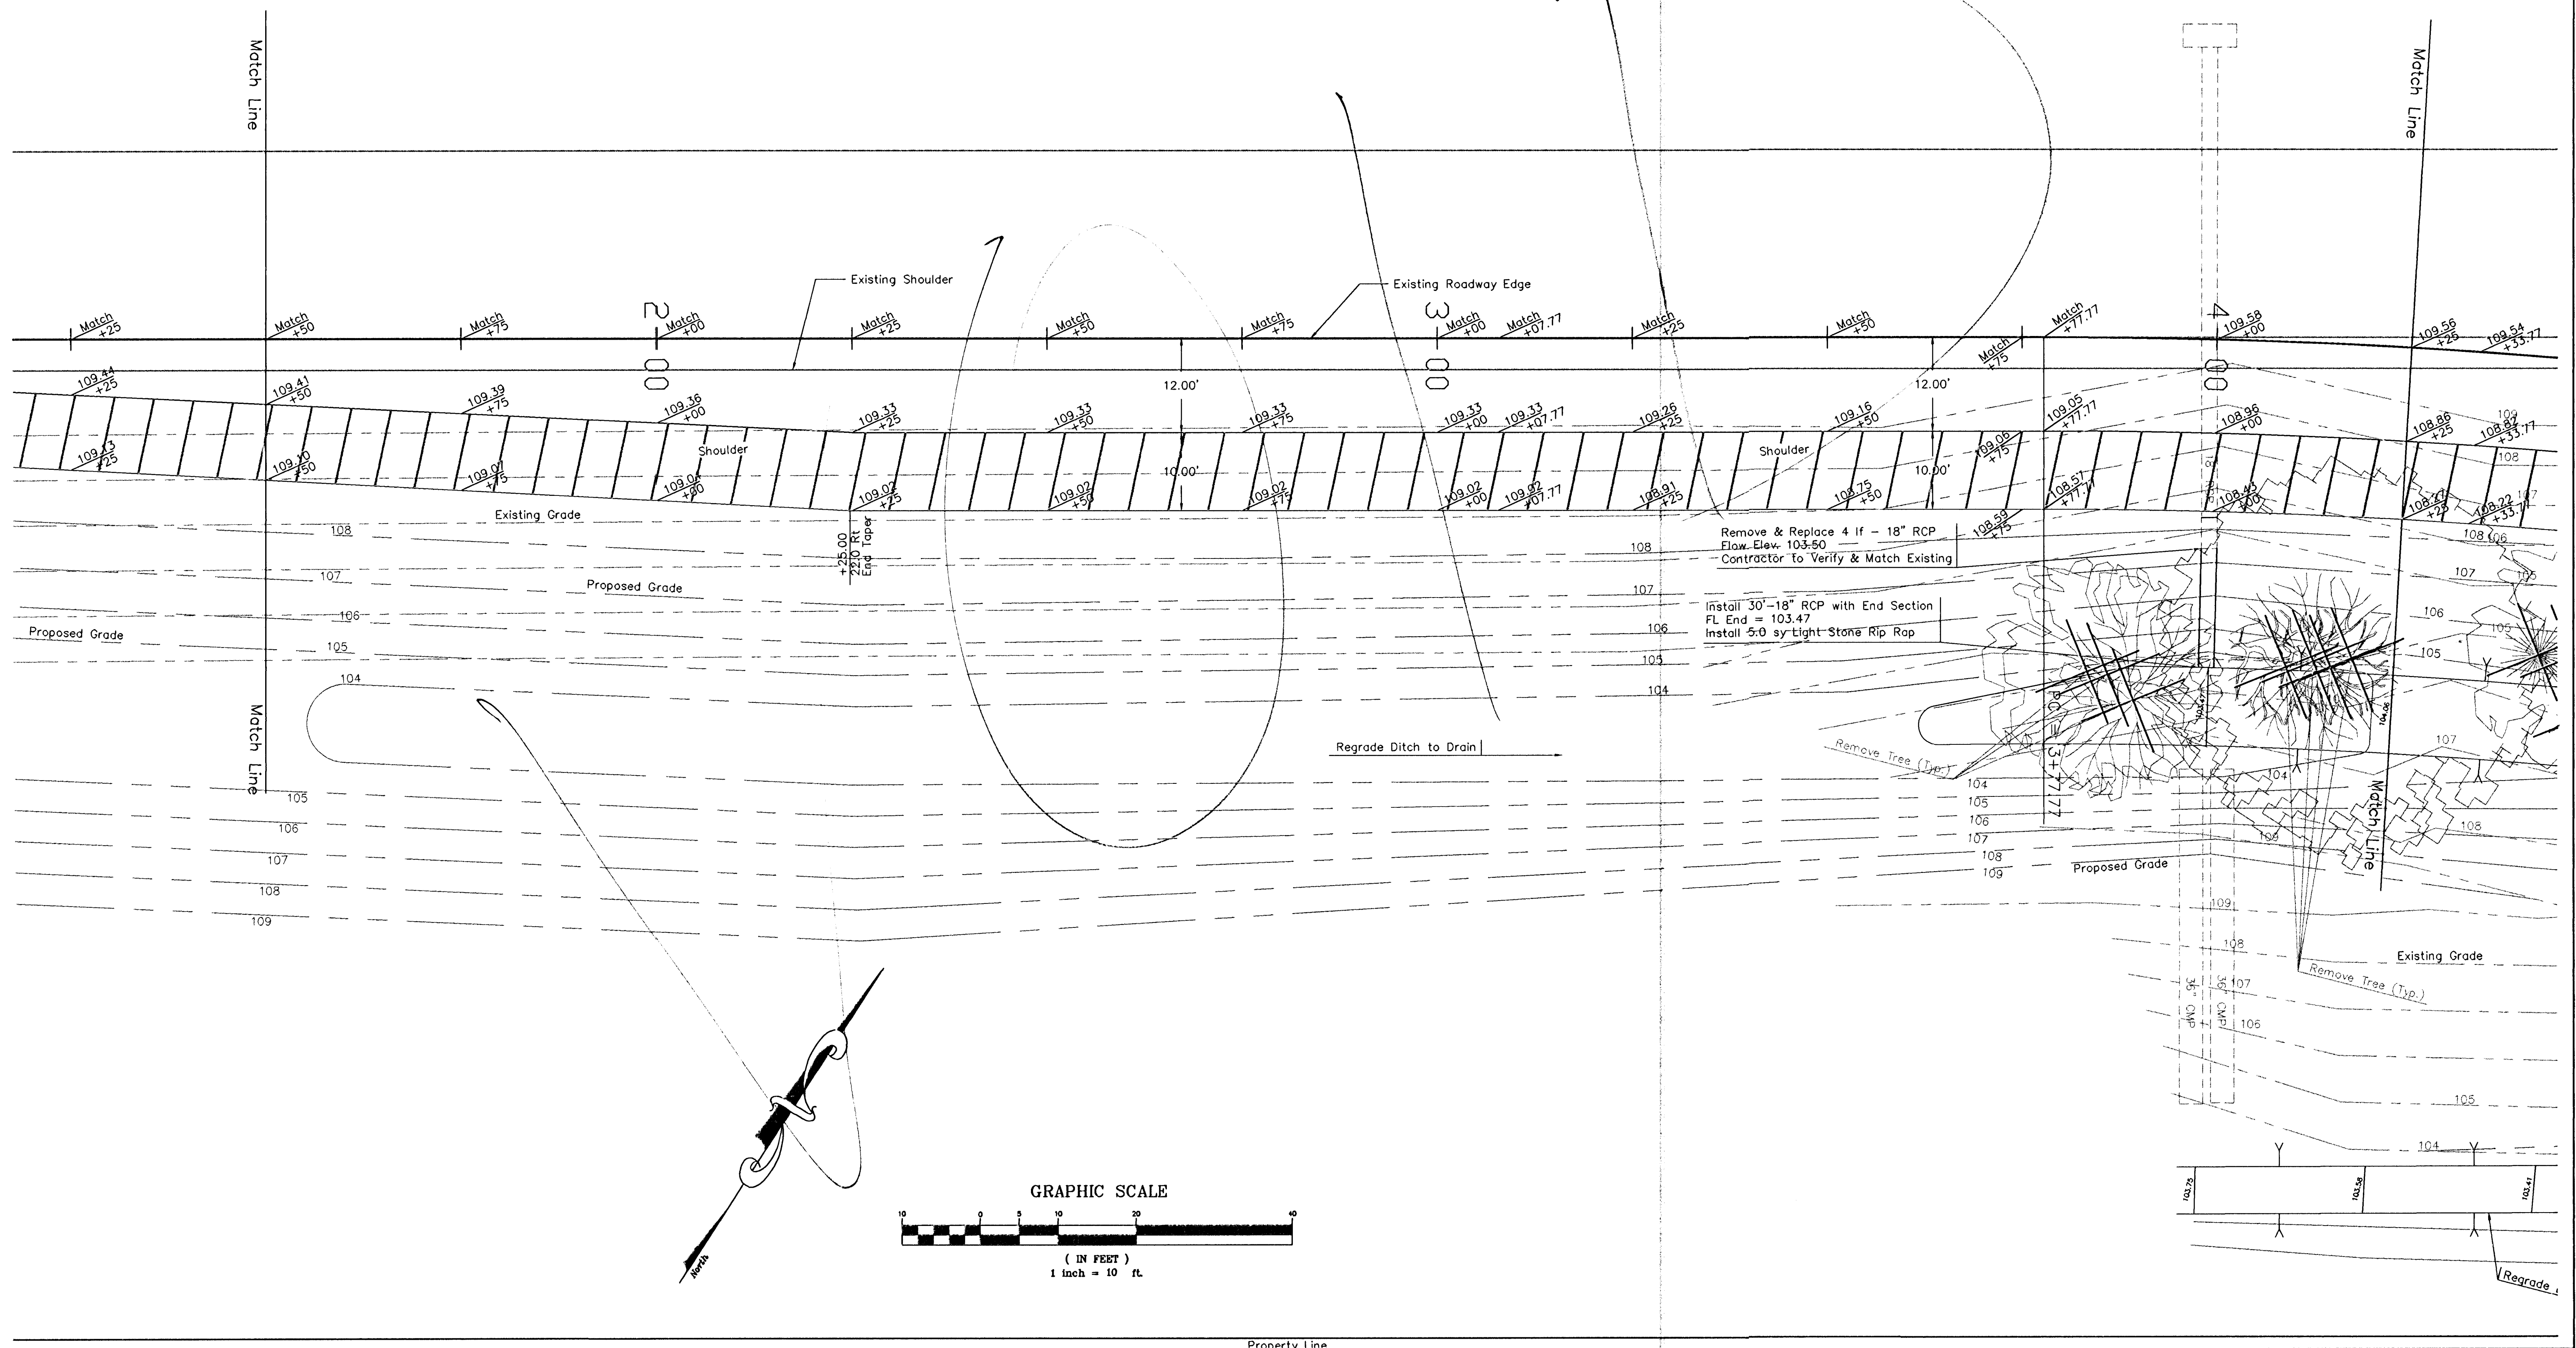

Description		
K-42/Pawnee Ave/West St Paving Plan Sheet		
Scale: 1"=10'	Drawn By: SAC	Index No.: 706028
Date: Nov 1994	Revised:	
CITY OF WICHITA DEPARTMENT OF PUBLIC WORKS ENGINEERING DIVISION City Engineer -- Michael E. Lindebak		