



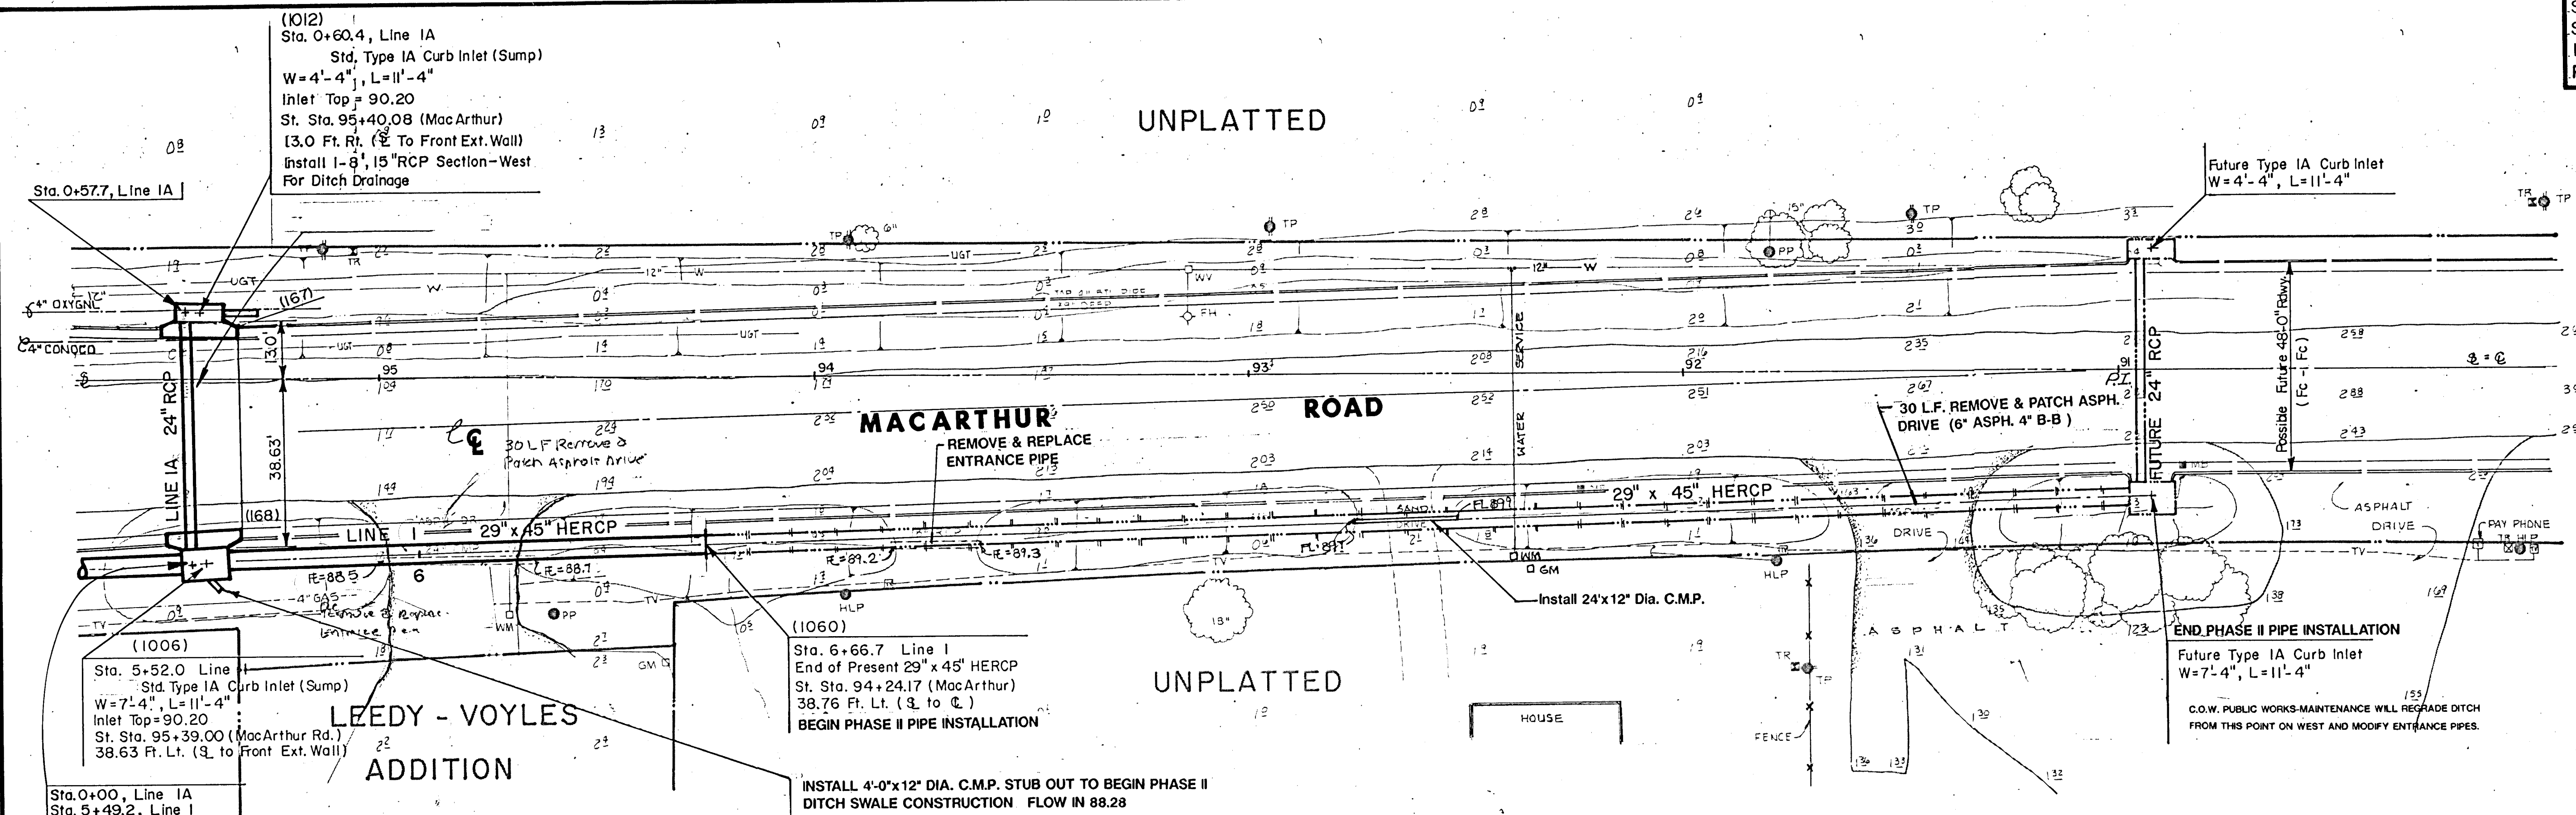

Scale: 1" = 20' HORIZ.
1" = 5' VERT.

PLAN - LINE 1 & LINE 1A

PROFILE - LINE 1 & LINE 1A

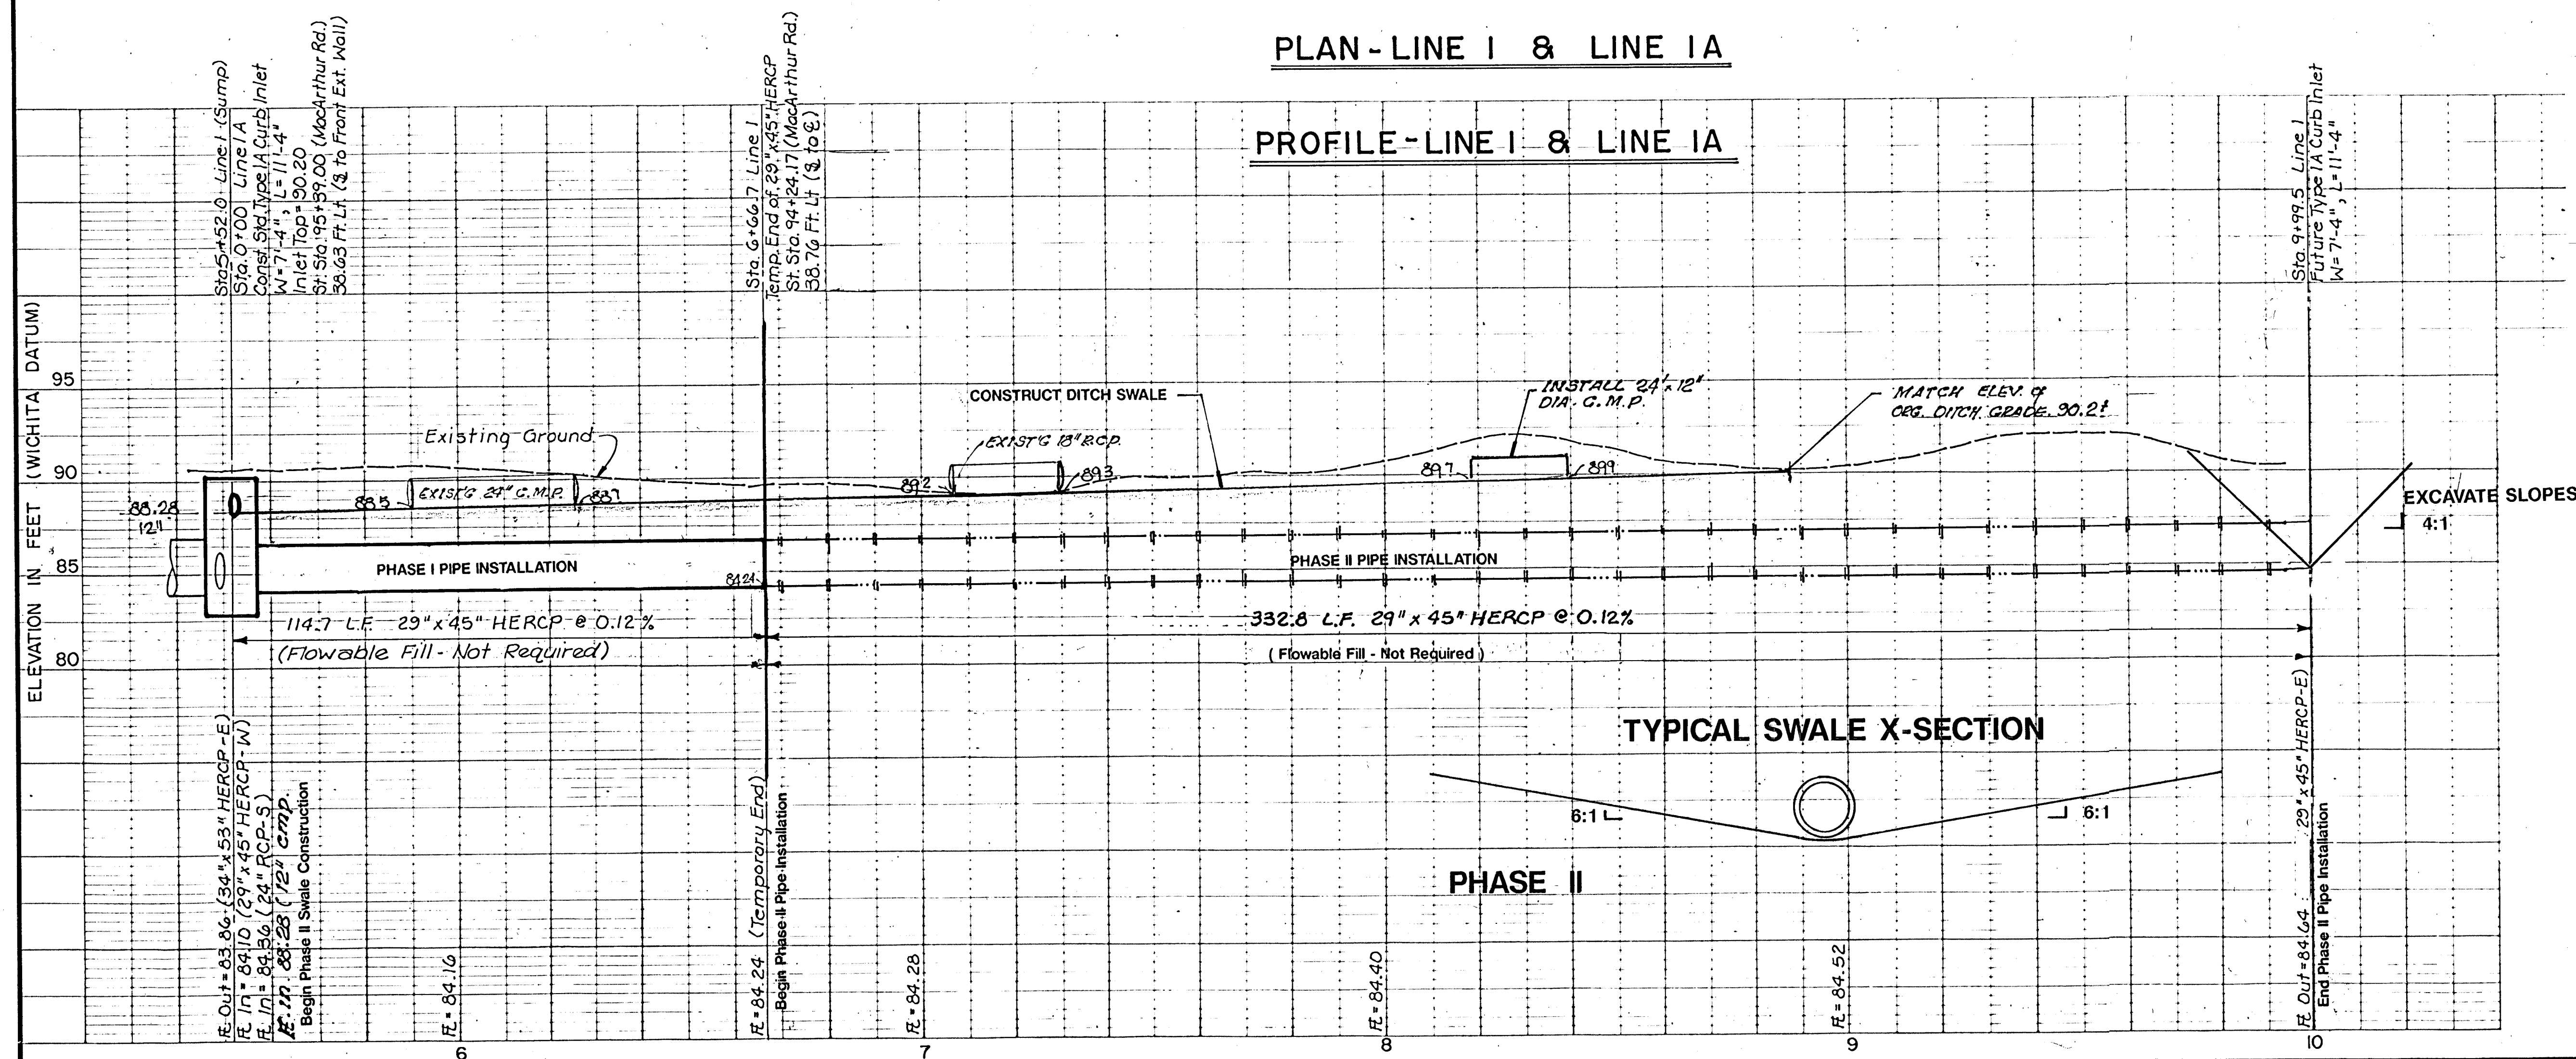

TYPICAL SWALE X-SECTION

PHASE II