



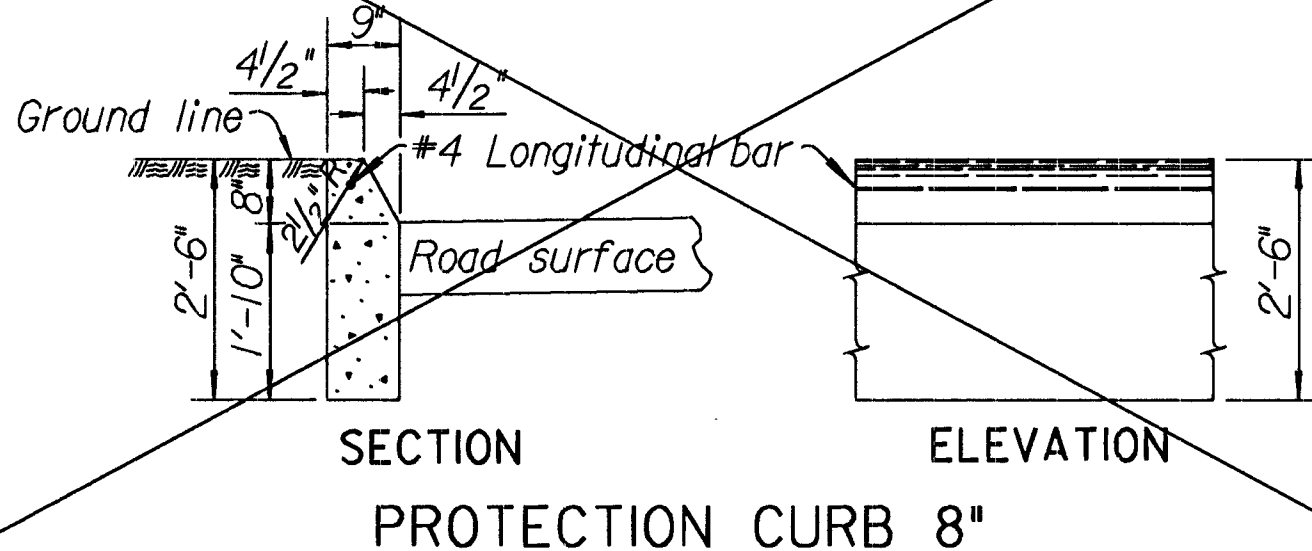

Longitudinal joints shall be sawed and sealed with joint sealant, see Sheet No. 7

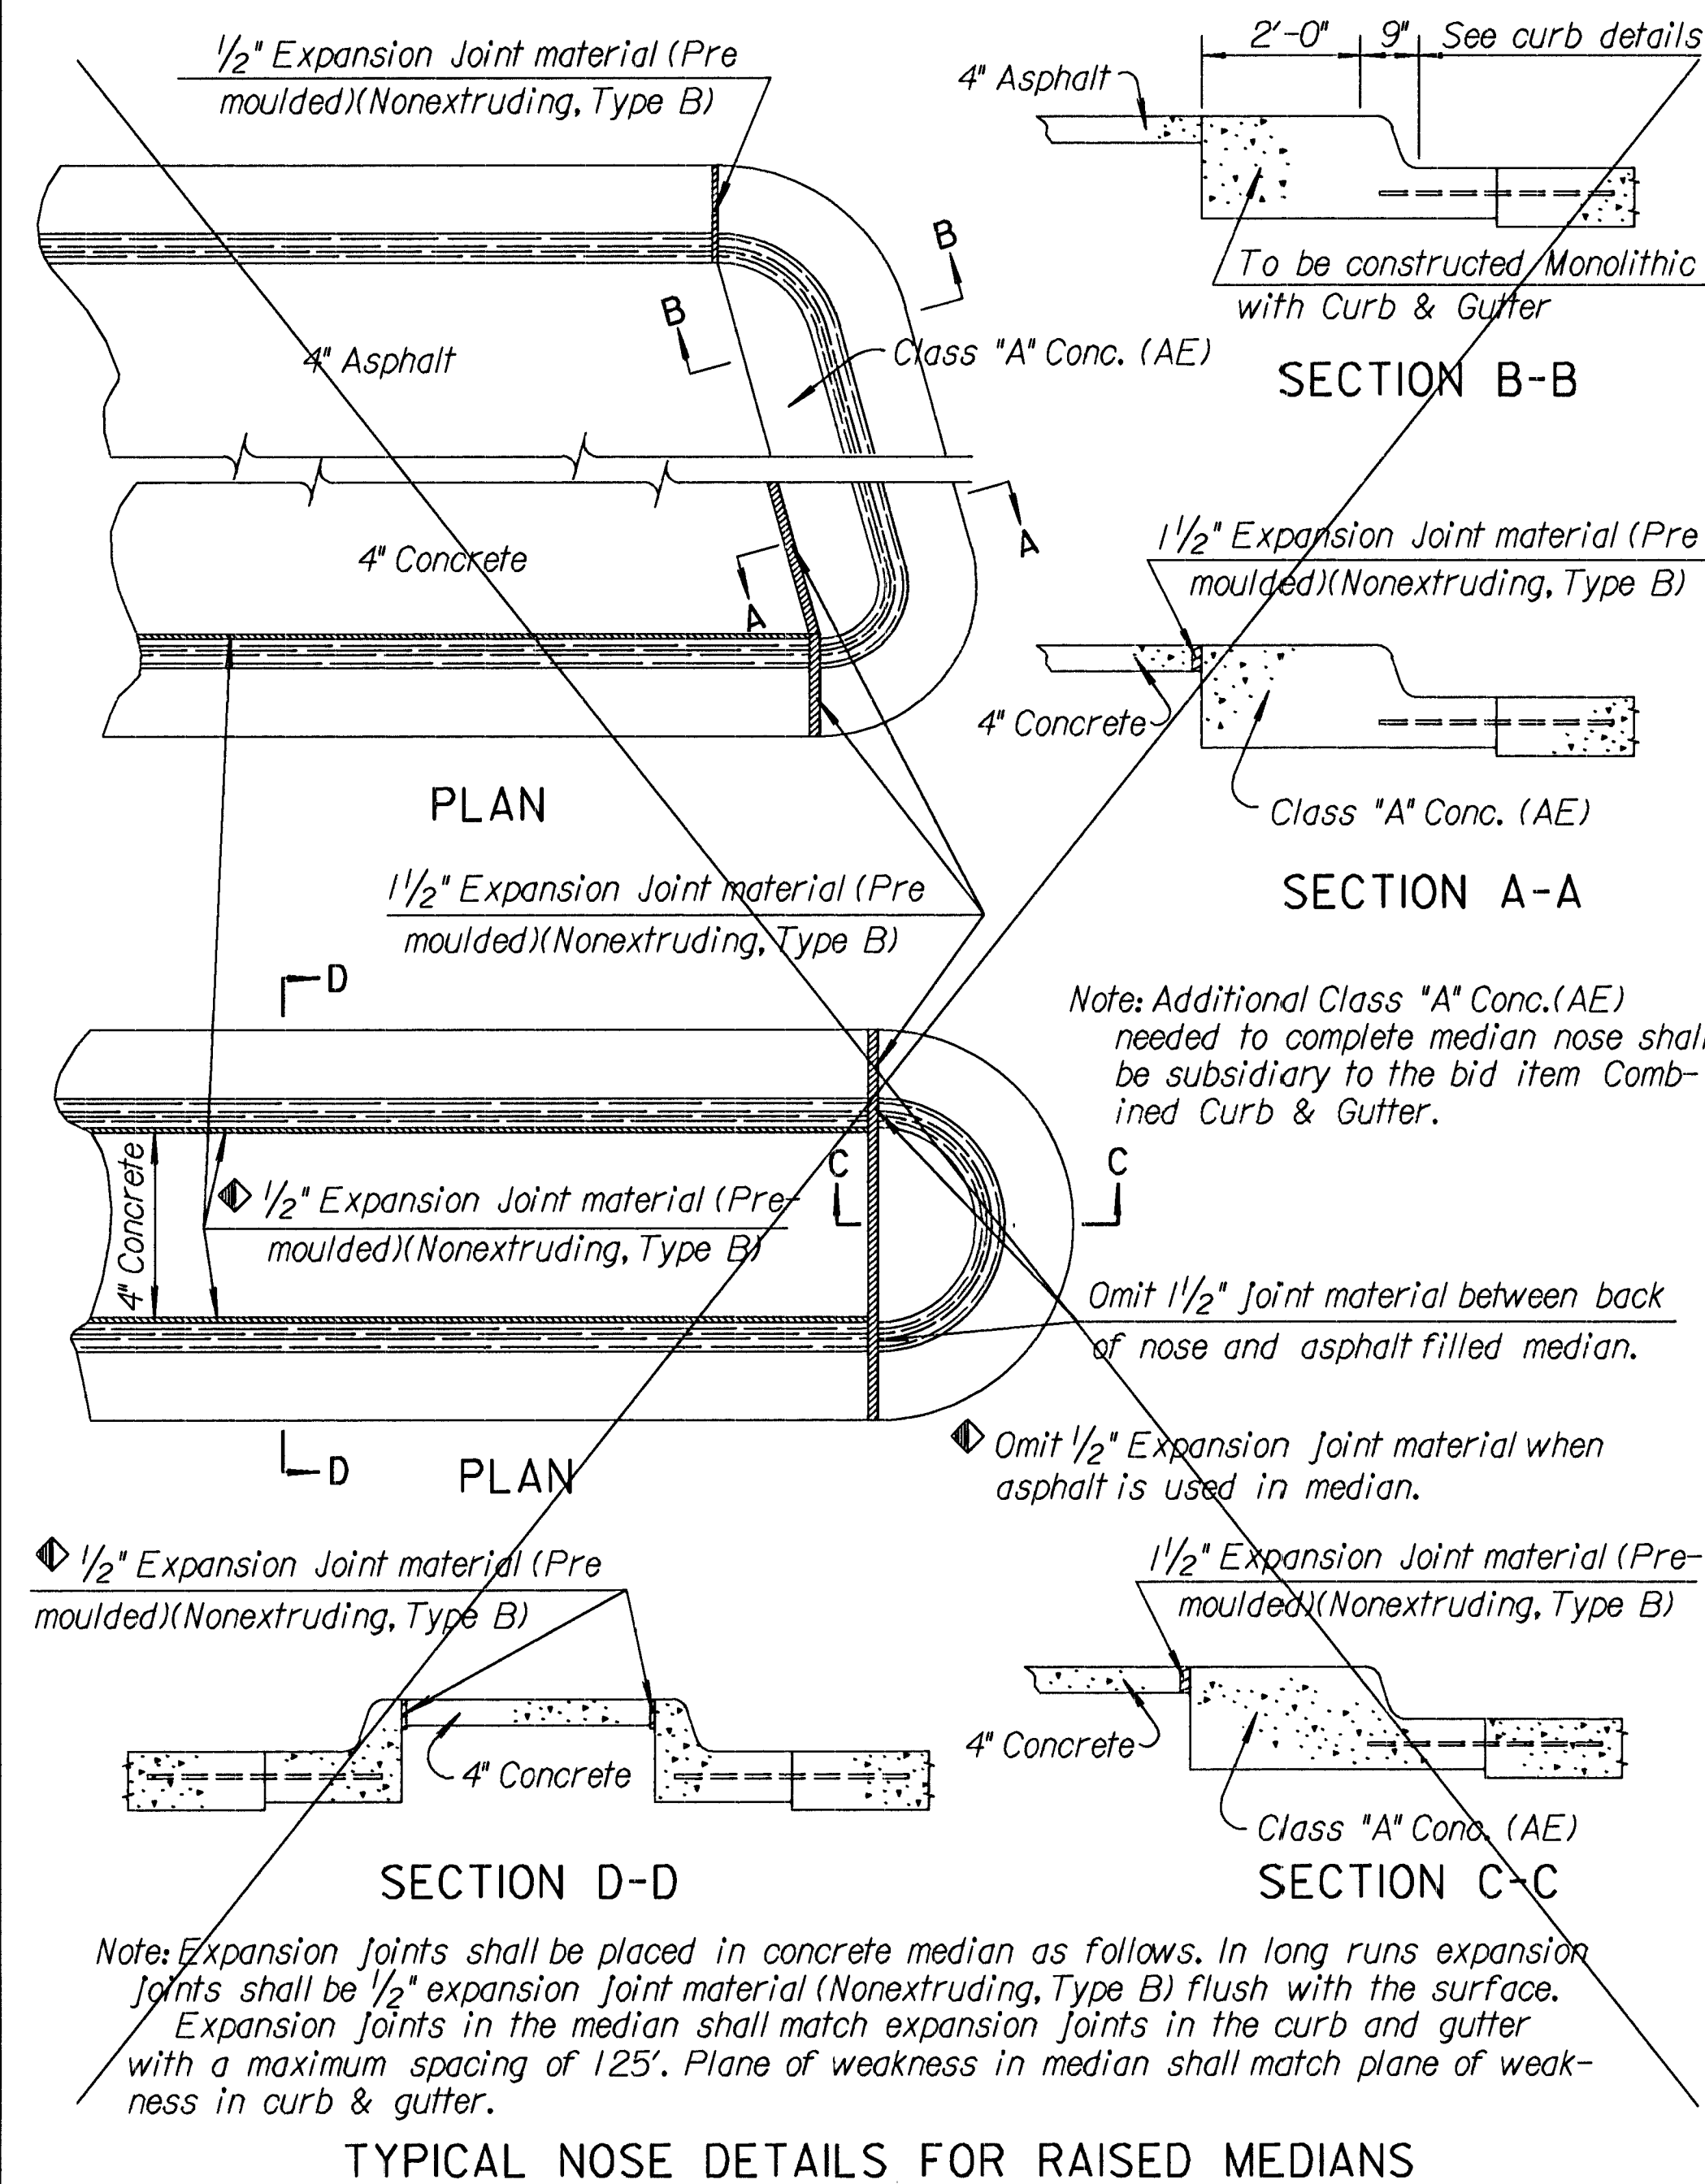