



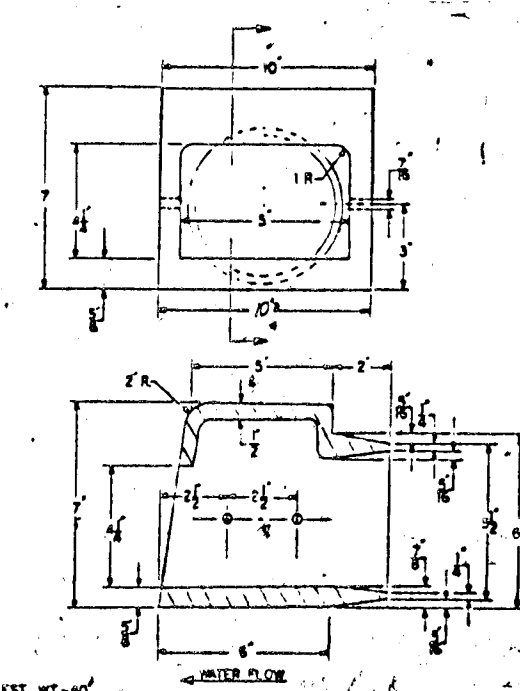

Scale: 1" = 20'

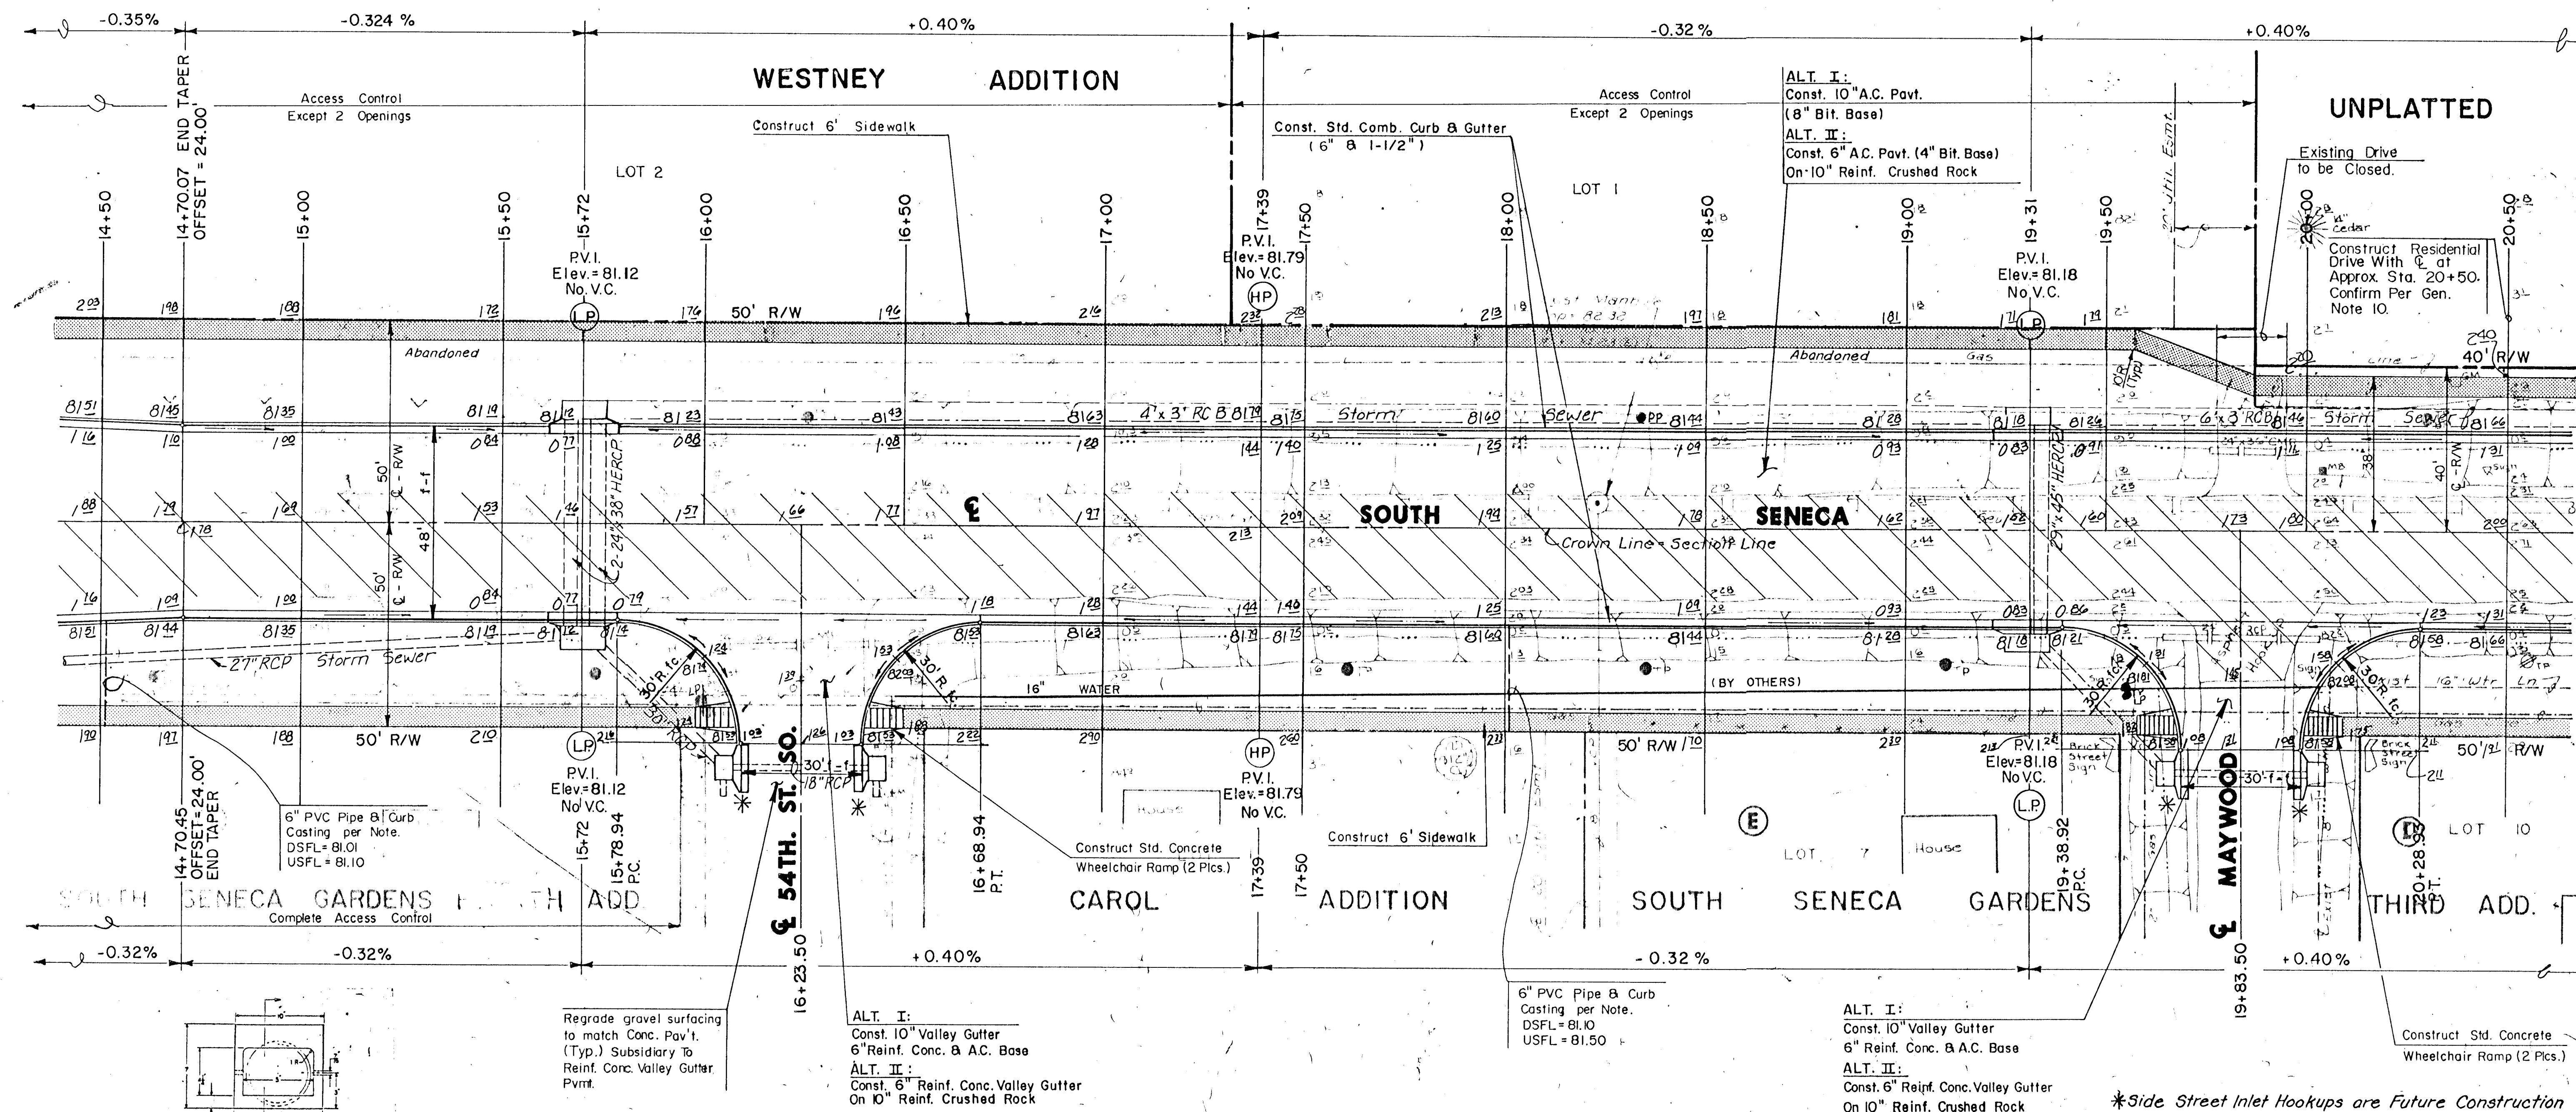

CURB CASTING DETAIL

NOTE:

Install Curb Casting, Deeter #2449-6 or approved equal, at curb & gutter. Casting unit shall be anchored with galvanized 3/8" x 2-1/2" bolts. Casting shall be painted two coats of grey paint, applied in accordance with manufacturer's recommendation.


ALT. I:
Const. 10" Valley Gutter
6" Reinf. Conc. & A.C. Base
ALT. II:
Const. 6" Reinf. Conc. Valley Gutter
On 10" Reinf. Crushed Rock

6" PVC Pipe & Curb
Casting per Note.
DSFL = 81.10
USFL = 81.50

ALT. I:
Const. 10" Valley Gutter
6" Reinf. Conc. & A.C. Base
ALT. II:
Const. 6" Reinf. Conc. Valley Gutter
On 10" Reinf. Crushed Rock

*Side Street Inlet Hookups are Future Construction and not a part of this project unless specifically stated.

SEWER MANHOLE ADJUSTMENT				WATER VALVE BOX ADJUSTMENT			
STA	OFFSET	EXIST. ELEV.	PROP. ELEV.	STA	OFFSET	EXIST. ELEV.	PROP. ELEV.
15+12	5'L	82.17	81.50	16+45	55'R	82.46/82.39	81.60
18+23	6'L	82.32	81.68	16+47	45'R	81.41	81.75
				20+08	40'R	81.10	81.95

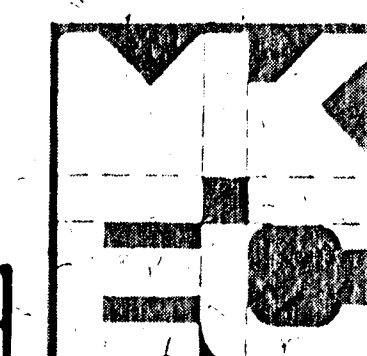

SOUTH SENECA IMPROVEMENTS

PAVING PLAN

55TH ST. SO. TO 48TH ST. SO.

MID-KANSAS ENGINEERING CONSULTANTS PA
3500 NORTH ROCK ROAD
BUILDING #800
WICHITA, KANSAS 67226

636-5566

Design
DCH
Drawn by
DLM
Checked by
Date
OCT 1989
100 ps
Sheet
6
of
58