
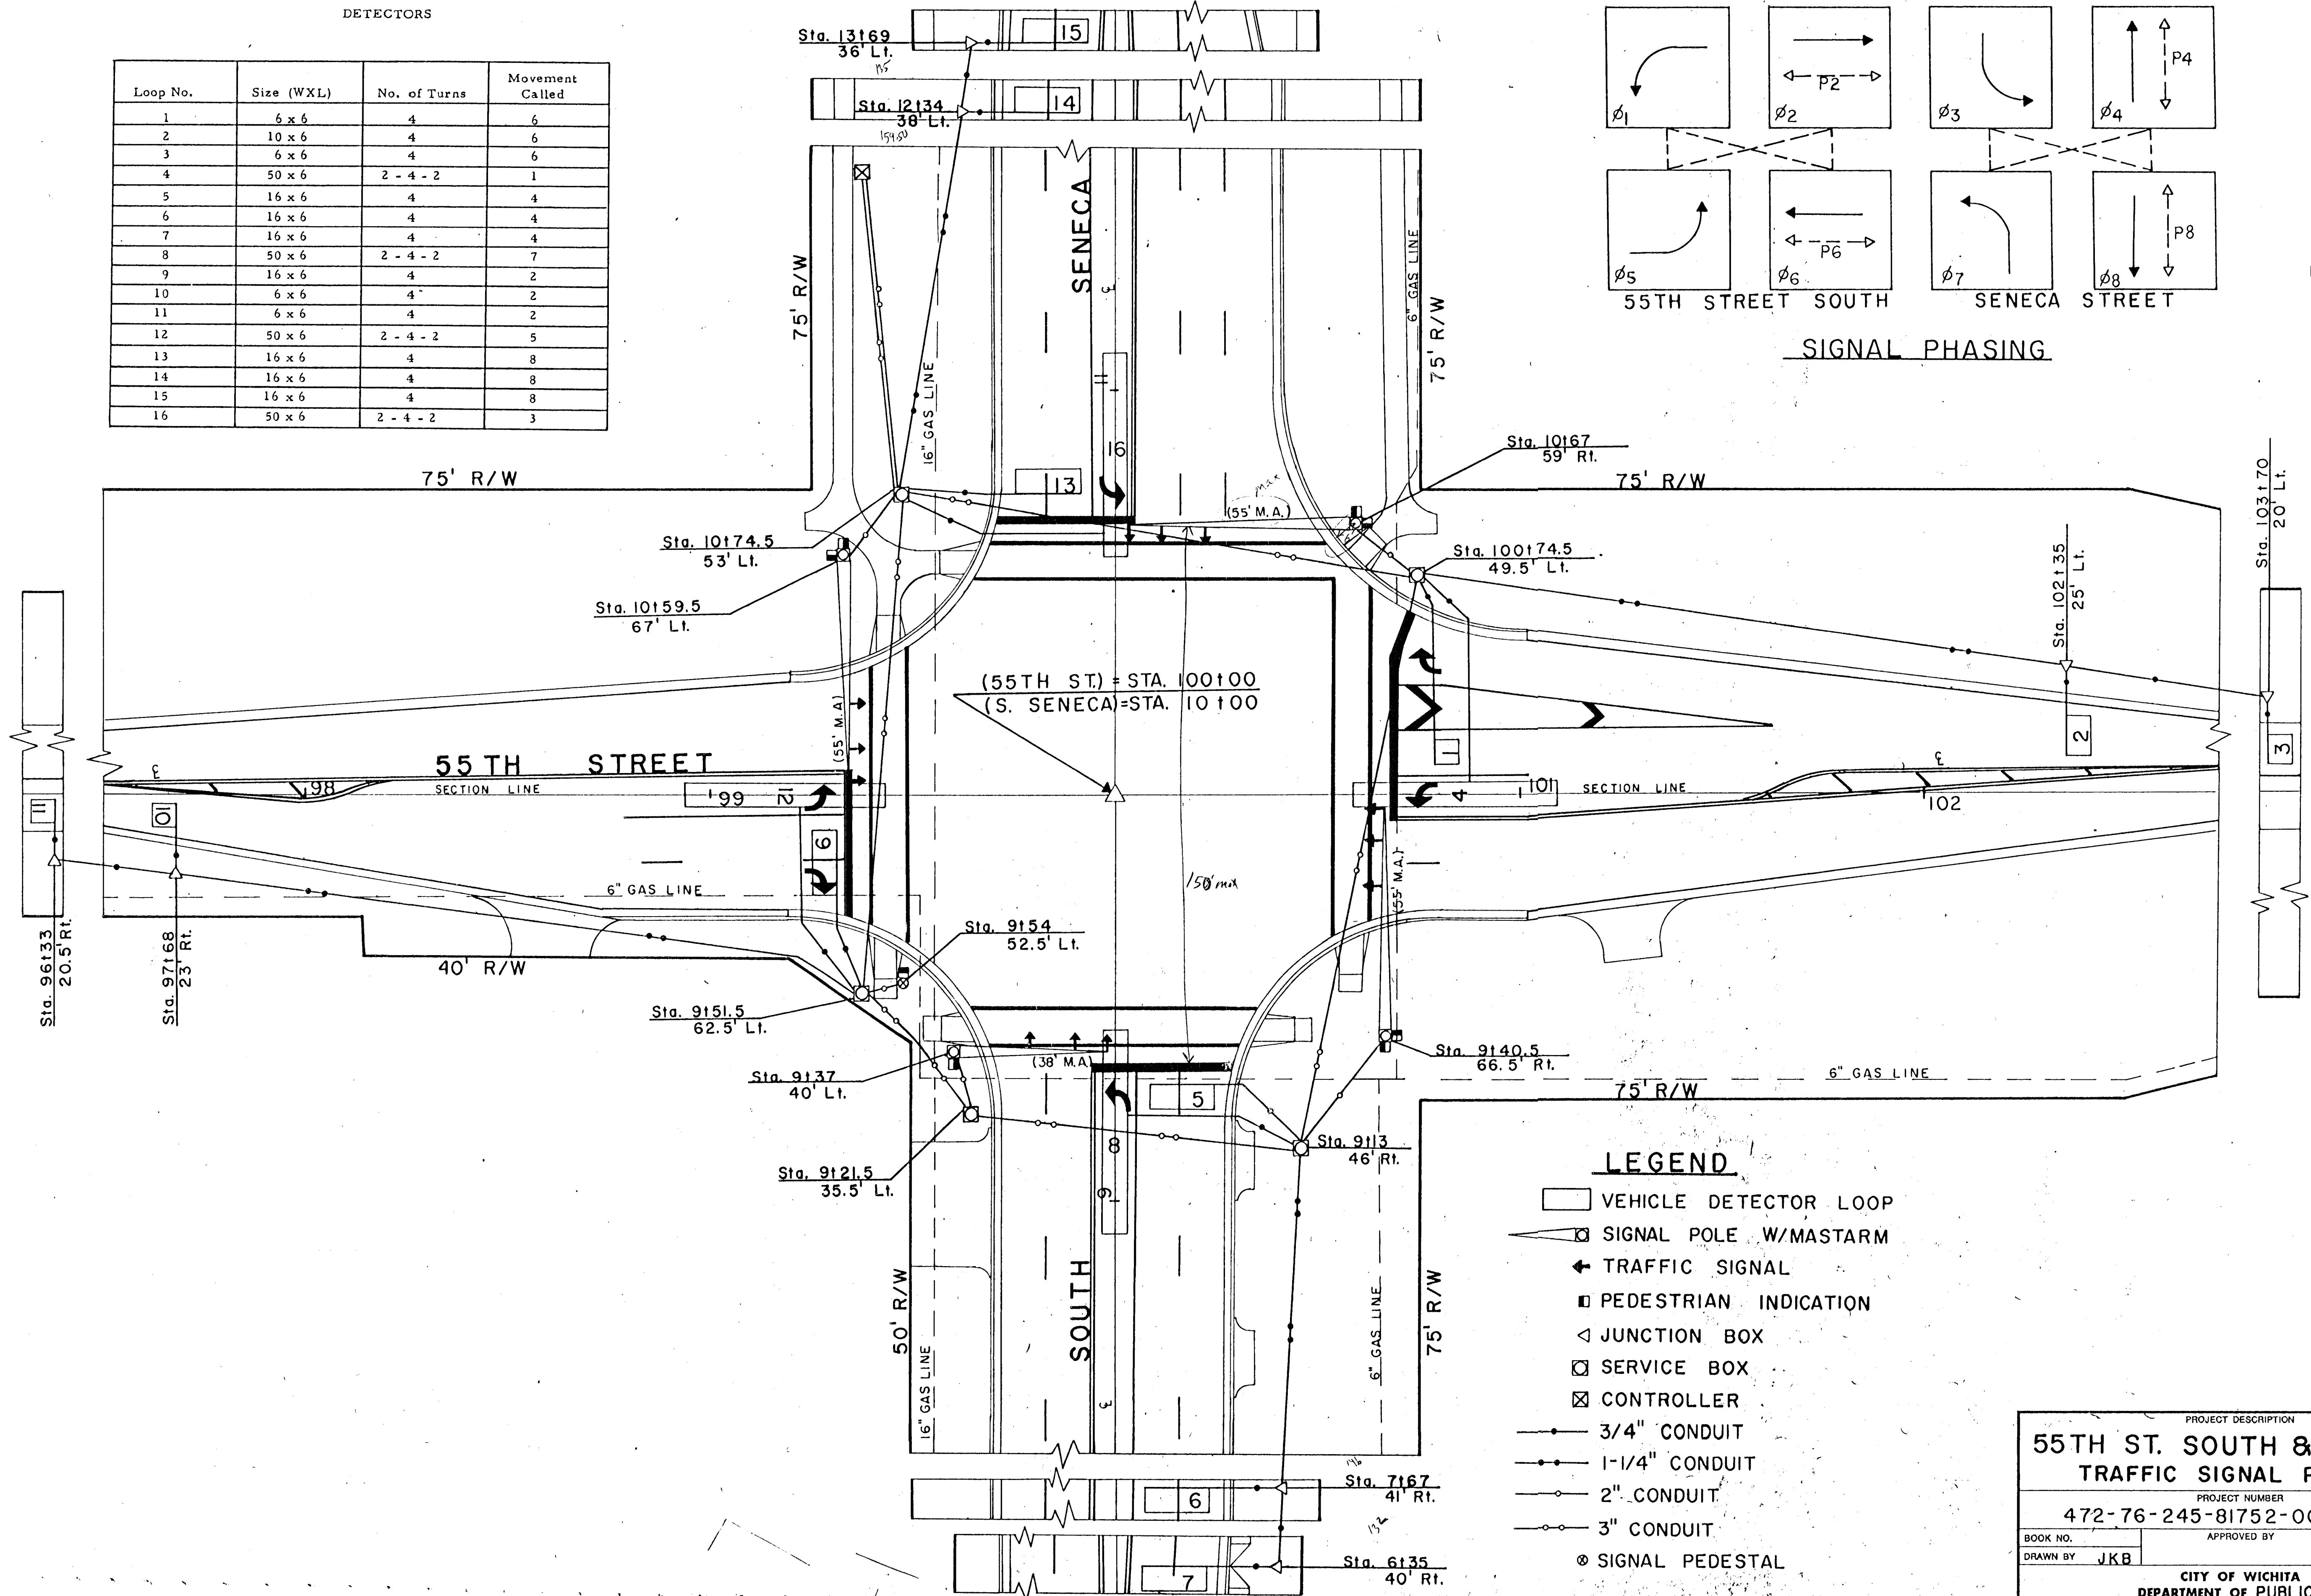


DETECTORS

Loop No.	Size (WXL)	No. of Turns	Movement Called
1	6 x 6	4	6
2	10 x 6	4	6
3	6 x 6	4	6
4	50 x 6	2 - 4 - 2	1
5	16 x 6	4	4
6	16 x 6	4	4
7	16 x 6	4	4
8	50 x 6	2 - 4 - 2	7
9	16 x 6	4	2
10	6 x 6	4	2
11	6 x 6	4	2
12	50 x 6	2 - 4 - 2	5
13	16 x 6	4	8
14	16 x 6	4	8
15	16 x 6	4	8
16	50 x 6	2 - 4 - 2	3

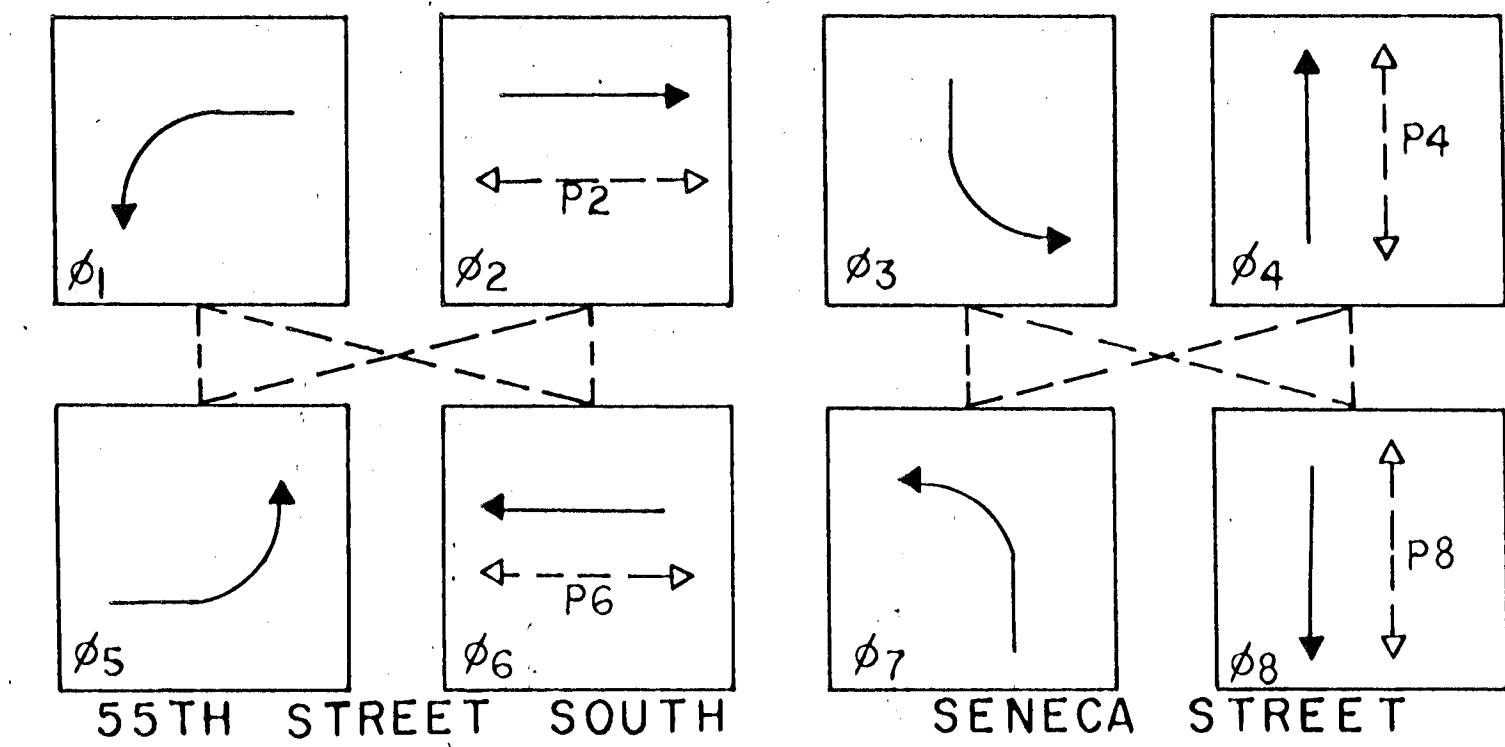

LEGEND

- VEHICLE DETECTOR LOOP
- ◻ SIGNAL POLE W/MASTARM
- ◀ TRAFFIC SIGNAL
- ◻ PEDESTRIAN INDICATION
- ◻ JUNCTION BOX
- ◻ SERVICE BOX
- ◻ CONTROLLER
- 3/4" CONDUIT
- 1-1/4" CONDUIT
- 2" CONDUIT
- 3" CONDUIT
- ⊙ SIGNAL PEDESTAL

PROJECT DESCRIPTION		
55TH ST. SOUTH & SENECA		
TRAFFIC SIGNAL PLAN		
PROJECT NUMBER		
472-76-245-81752-000-000-001		
BOOK NO.	APPROVED BY	DATE
DRAWN BY JKB		NOV. 90
CITY OF WICHITA		SCALE
DEPARTMENT OF PUBLIC WORKS		1" = 20'
TRAFFIC ENGINEERING DIVISION		29 of 58