


FHWA Region No.	STATE	PROJECT NO.	FISCAL YEAR	SHEET NO.	TOTAL SHEETS
7	KANSAS	87-N-0038-01 STP-11003(801)	1995	4	34



SCALE:


PLAN : 1" = 20'
PROFILE : 1" = 20' (H)
1" = 2' (V)

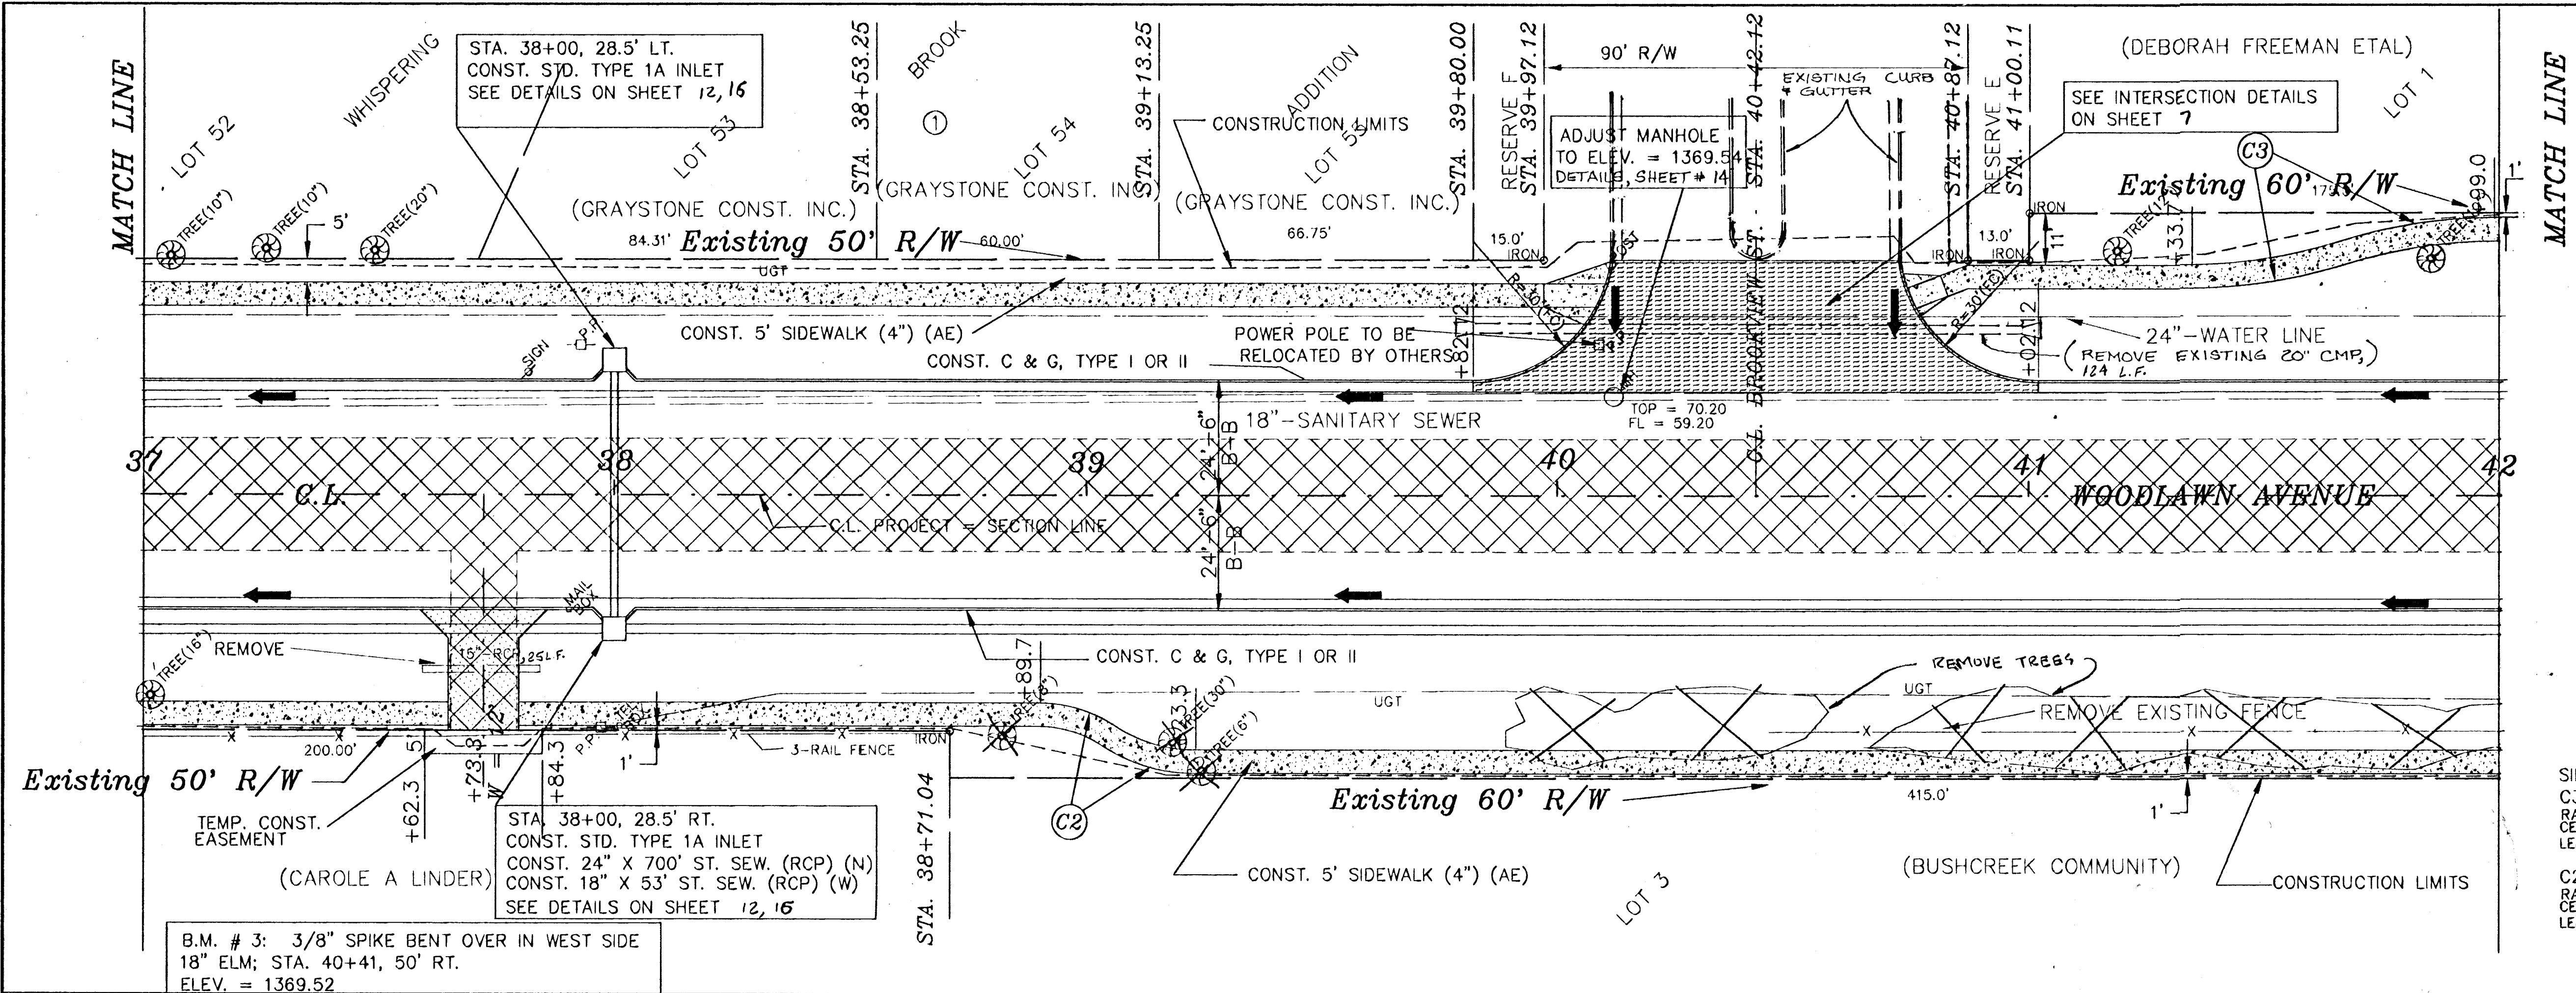

SIDEWALK CURVE DATA:
C3:
RADIUS = 114.0'
CENTRAL ANGLE = 16°-57'-48"
LENGTH = 33.75'
C2:
RADIUS = 30.0'
CENTRAL ANGLE = 36°-52'-12"
LENGTH = 19.31'

UTILITIES

WICHITA WATER
WICHITA SEWER
BELL TELEPHONE CO.

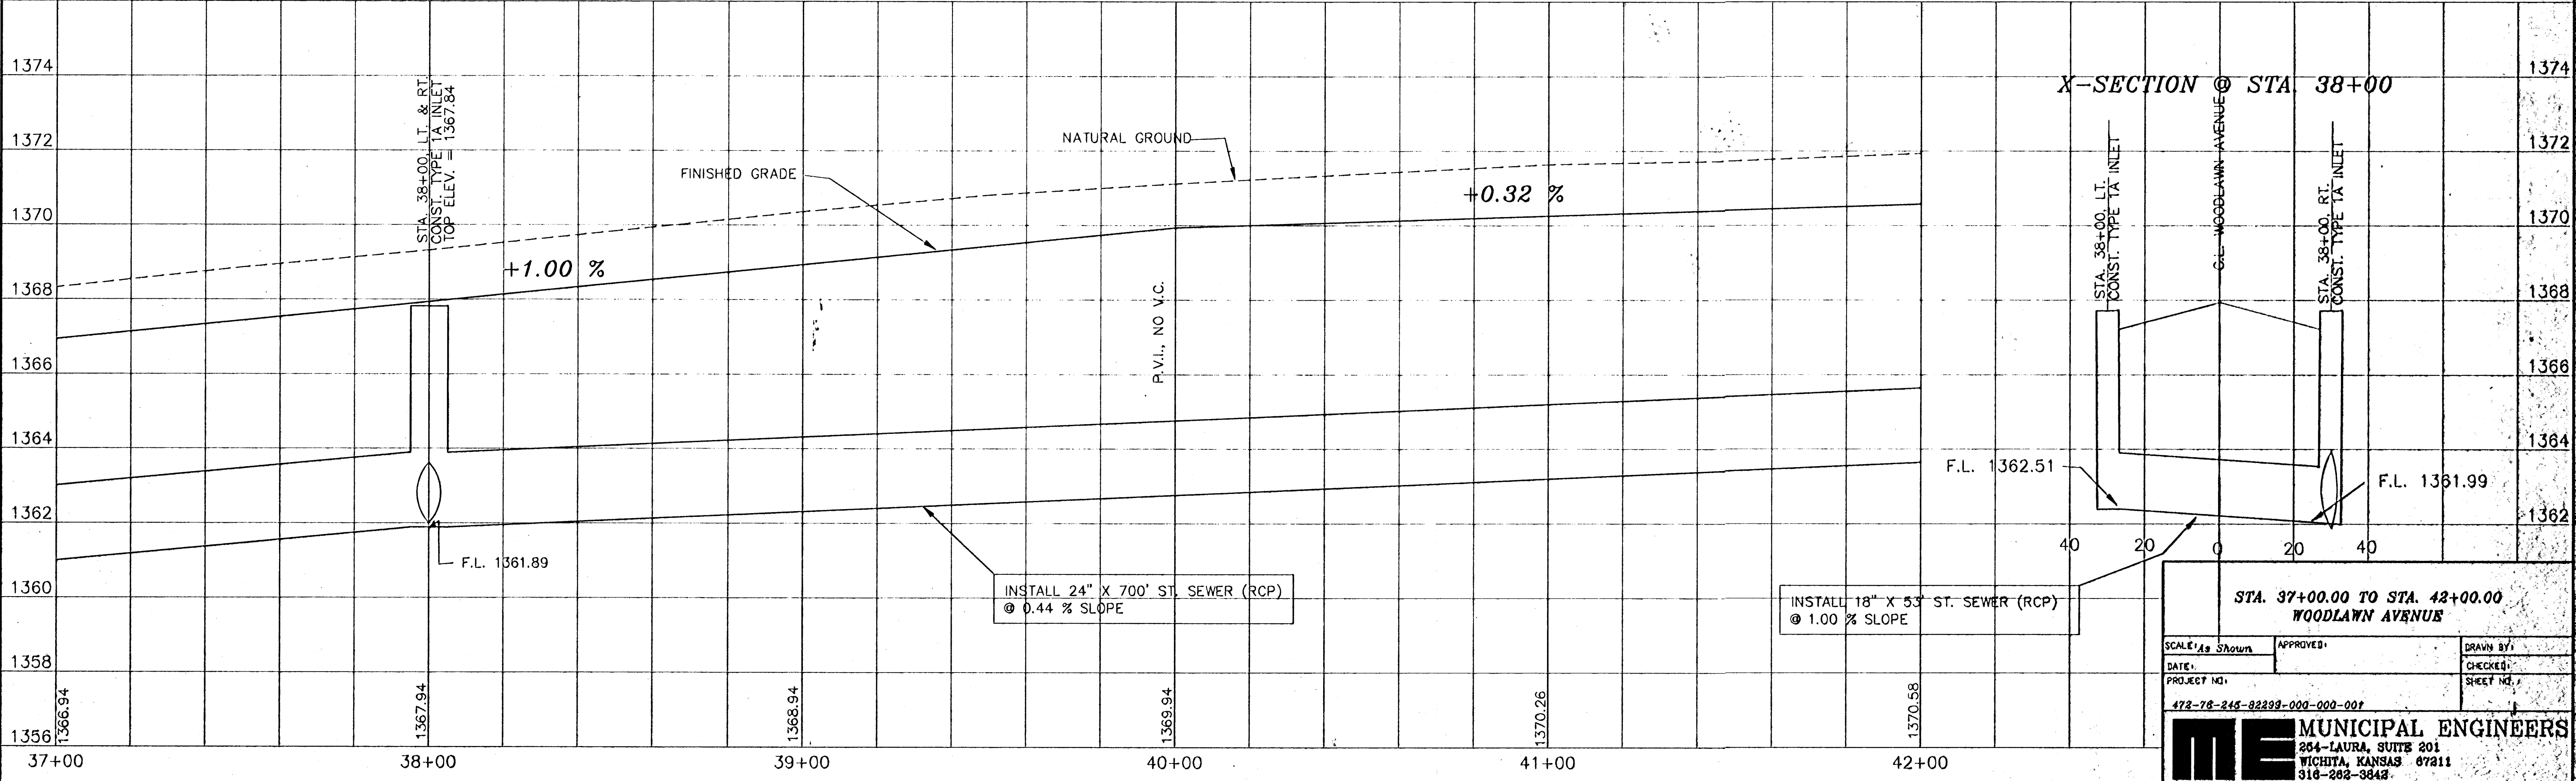

STA. 37+00.00 TO STA. 42+00.00
WOODLAWN AVENUE

SCALE: As Shown
DATE: _____
PROJECT NO. 472-76-245-82239-000-000-001
APPROVED: _____
DRAWN BY: _____
CHECKED: _____
SHEET NO. _____

ME MUNICIPAL ENGINEERS
204-LAURA, SUITE 201
WICHITA, KANSAS 67211
316-262-3842