


LEGEND: Location of Revised Tenant Parking

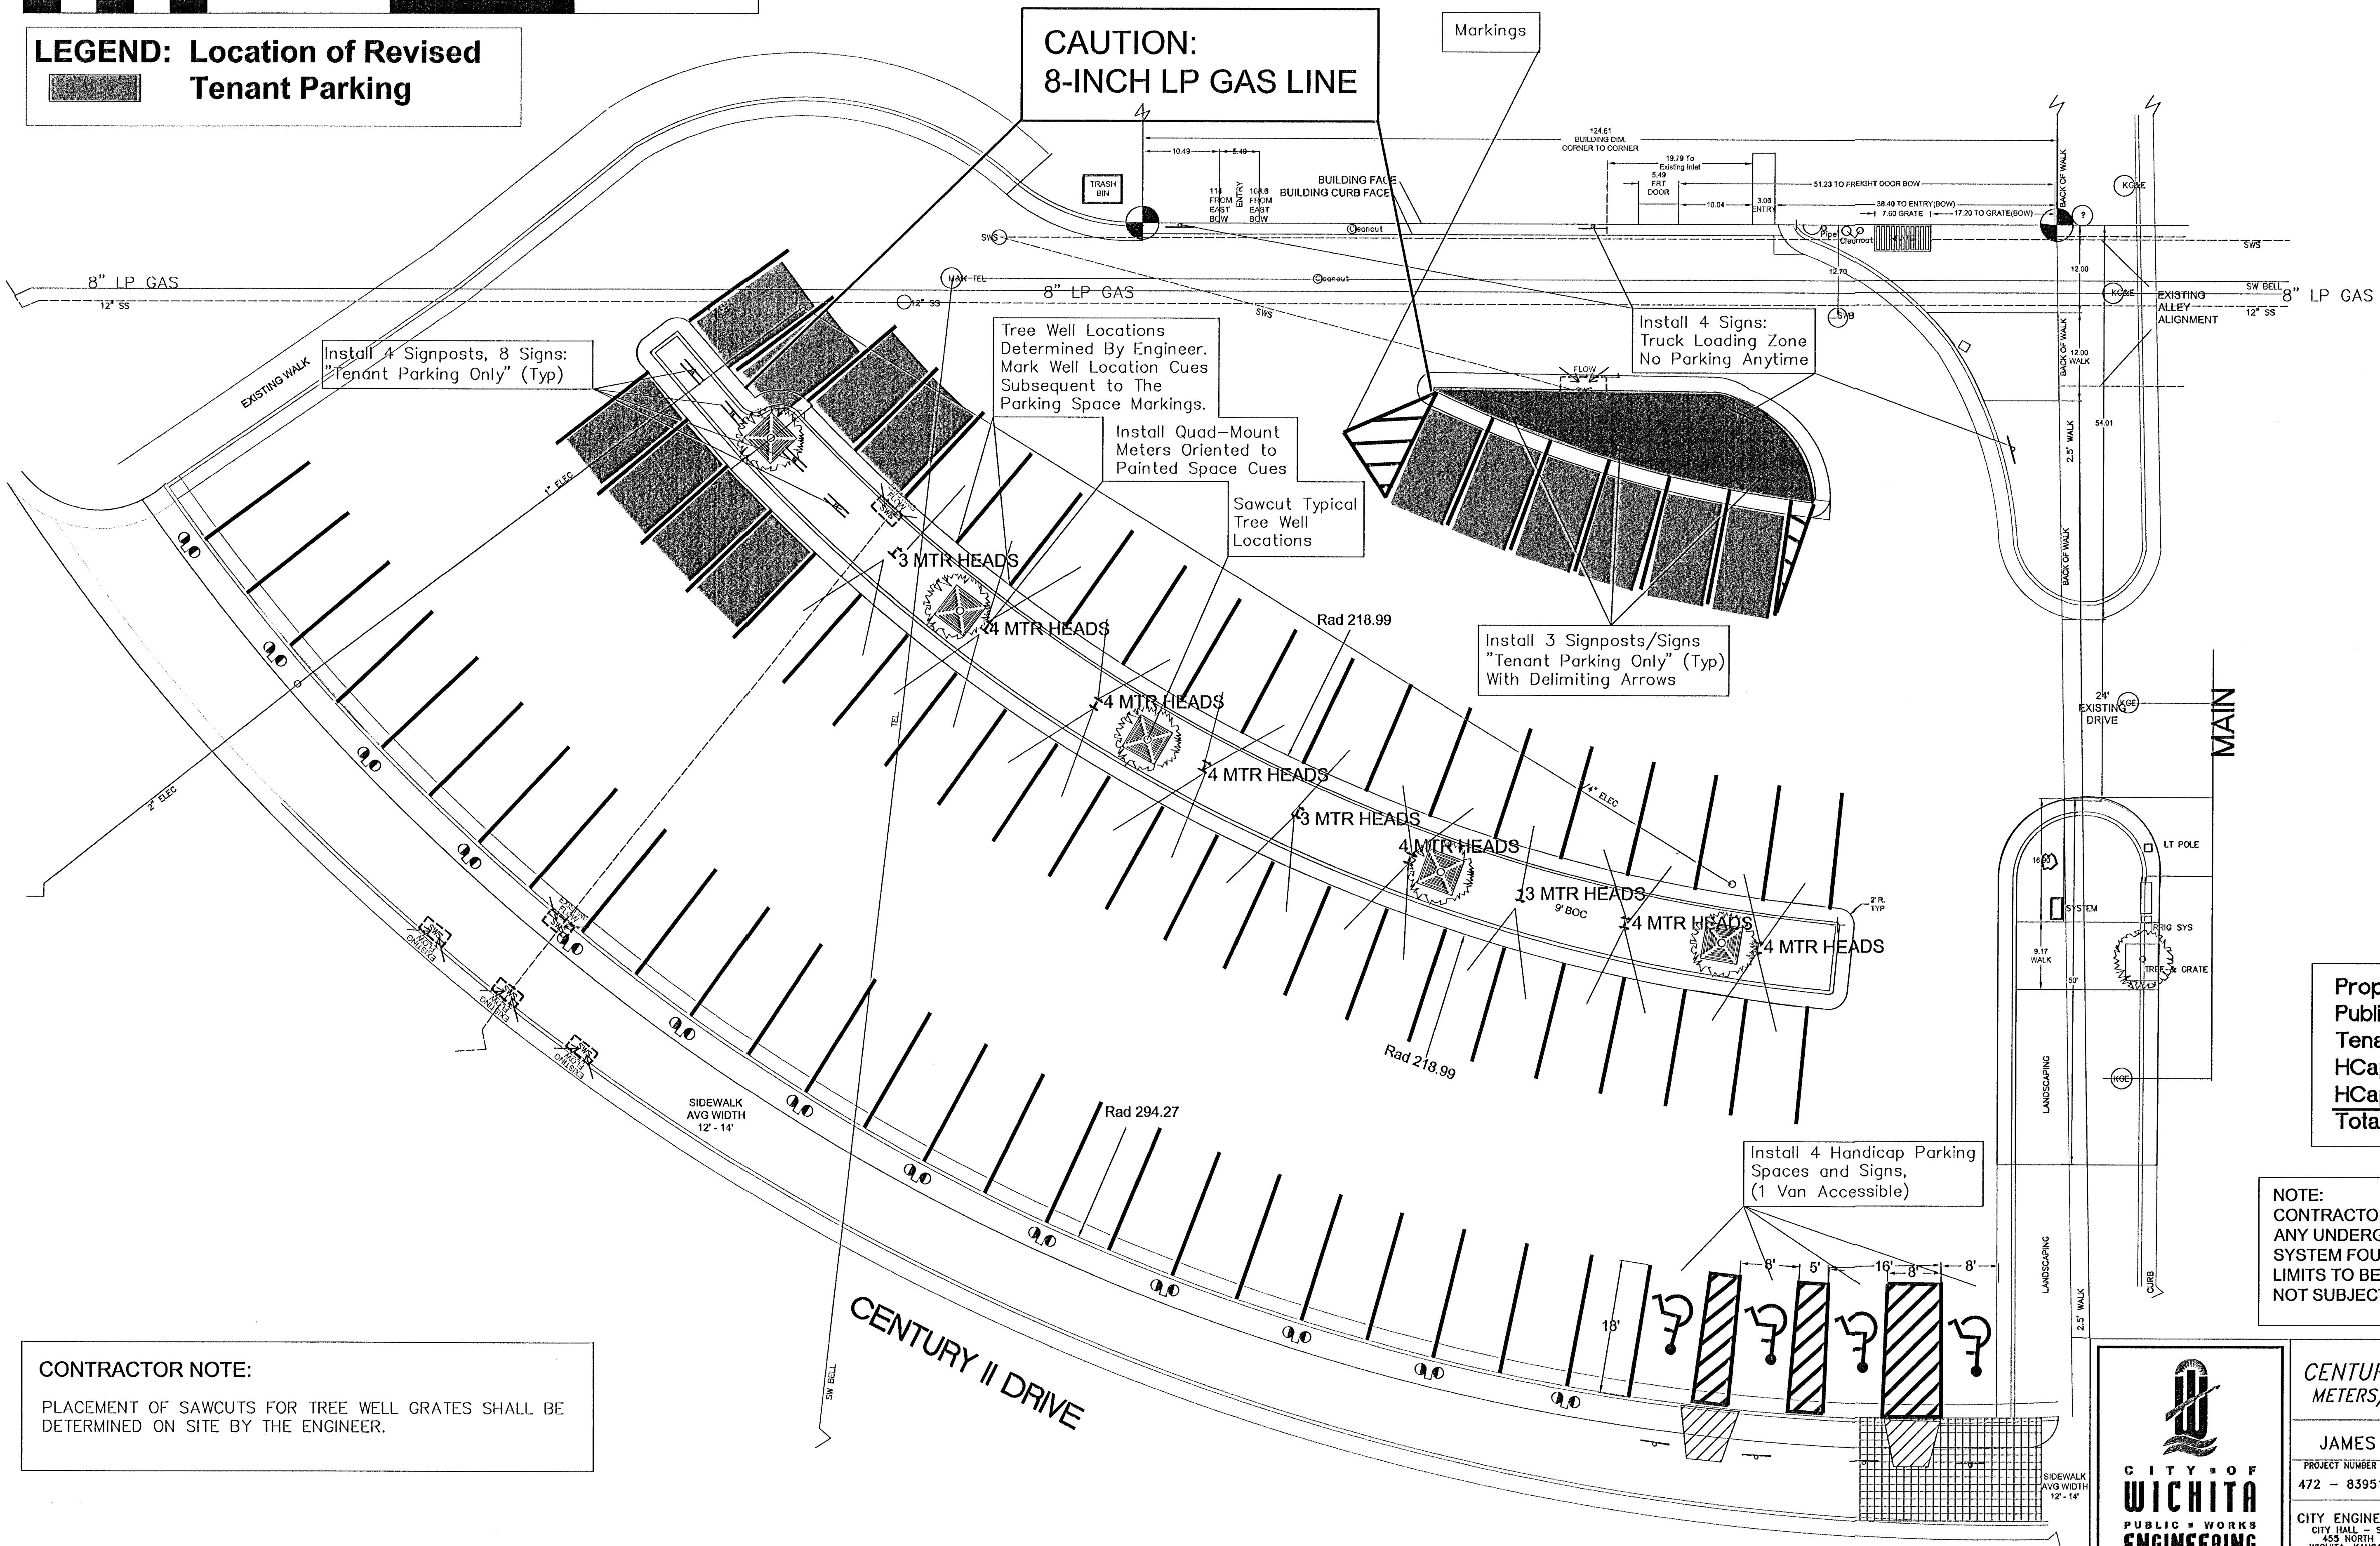

CONTRACTOR NOTE:
PLACEMENT OF SAWCUTS FOR TREE WELL GRATES SHALL BE DETERMINED ON SITE BY THE ENGINEER.

Proposed Parking:	
Public	59 Regular
Tenant	14 Signed
HCap	3 Signed
HCap	1 Van
Total:	77 Spaces

NOTE:
CONTRACTOR IS TO CONSIDER ANY UNDERGROUND SPRINKLER SYSTEM FOUND WITHIN PROJECT LIMITS TO BE ABANDONED AND NOT SUBJECT TO SALVAGE.



CENTURY II PLAZA LOT METERS/MARKING/SIGNAGE		
CITY ENGINEER JAMES L. ARMOUR, P.E.		
PROJECT NUMBER 472 - 83951	OCA NUMBER 706878	DATE MAR 2, 04
CITY ENGINEER'S OFFICE CITY HALL - SEVENTH FLOOR 455 NORTH MAIN STREET WICHITA, KANSAS 67202-1620 (316) 268-4501 (316) 268-4114 FAX		DESIGN LRB
		DRAWN LRB
		SHEET 3 OF 8