



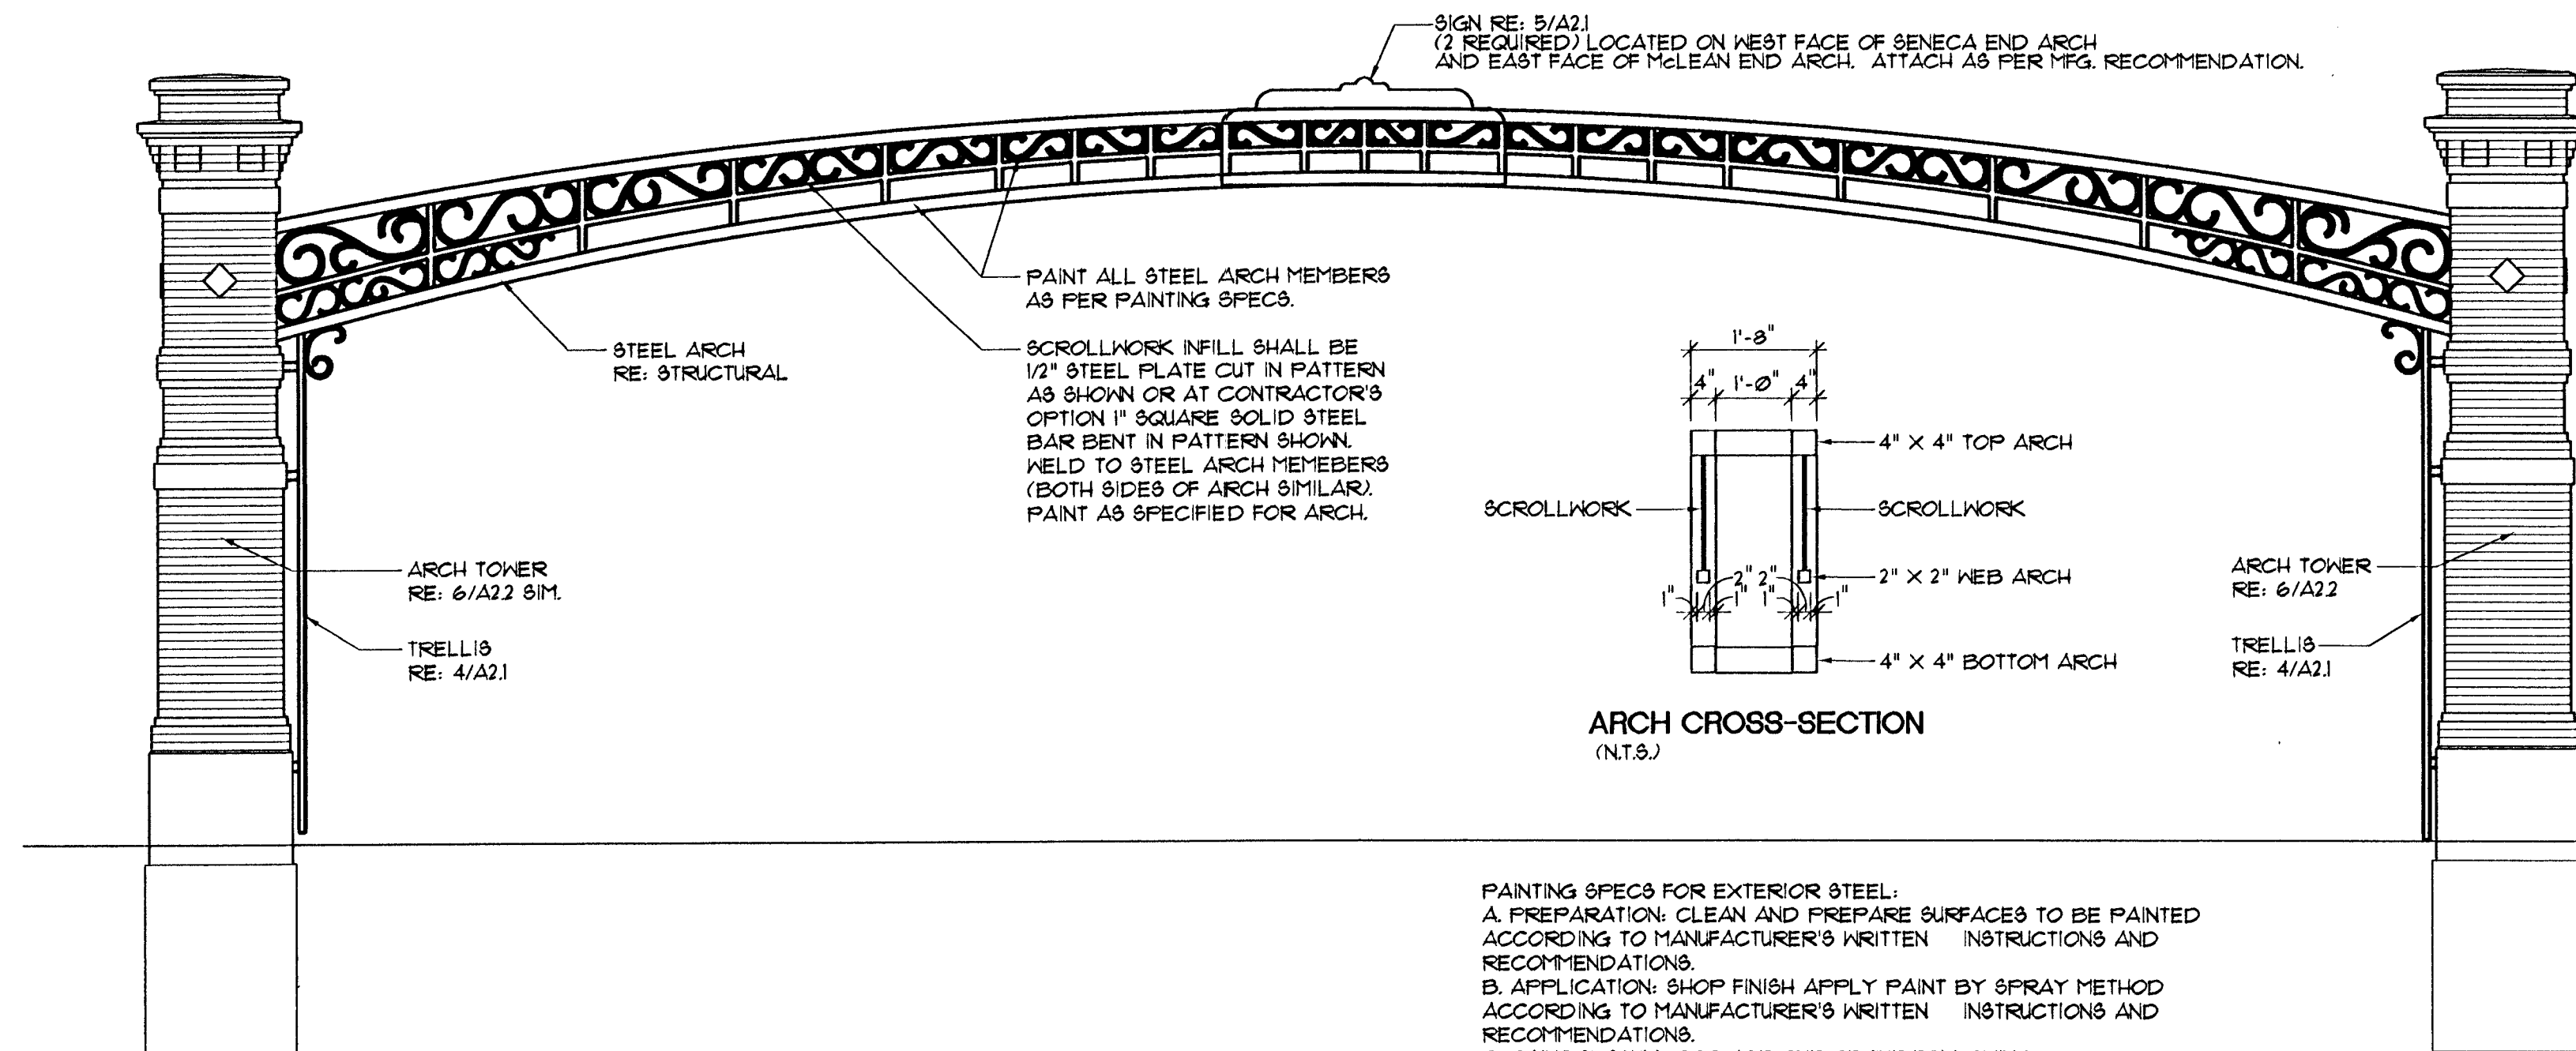


1 ARCH ELEVATION (ALT. #3)
(2 REQUIRED)
SCALE: 1/4" = 1'-0"

NOTE: ALTERNATE #3 INCLUDES ARCH, TOWERS, SIGNS, TRELLISES, LIGHTING OF ARCH, AND PLANTINGS AT TOWERS. SEE SPECS FOR DISCUSSION.
NOTE: EXCAVATION FOR FOOTINGS SHALL BE SUBSIDIARY TO ENTRY ARCH.

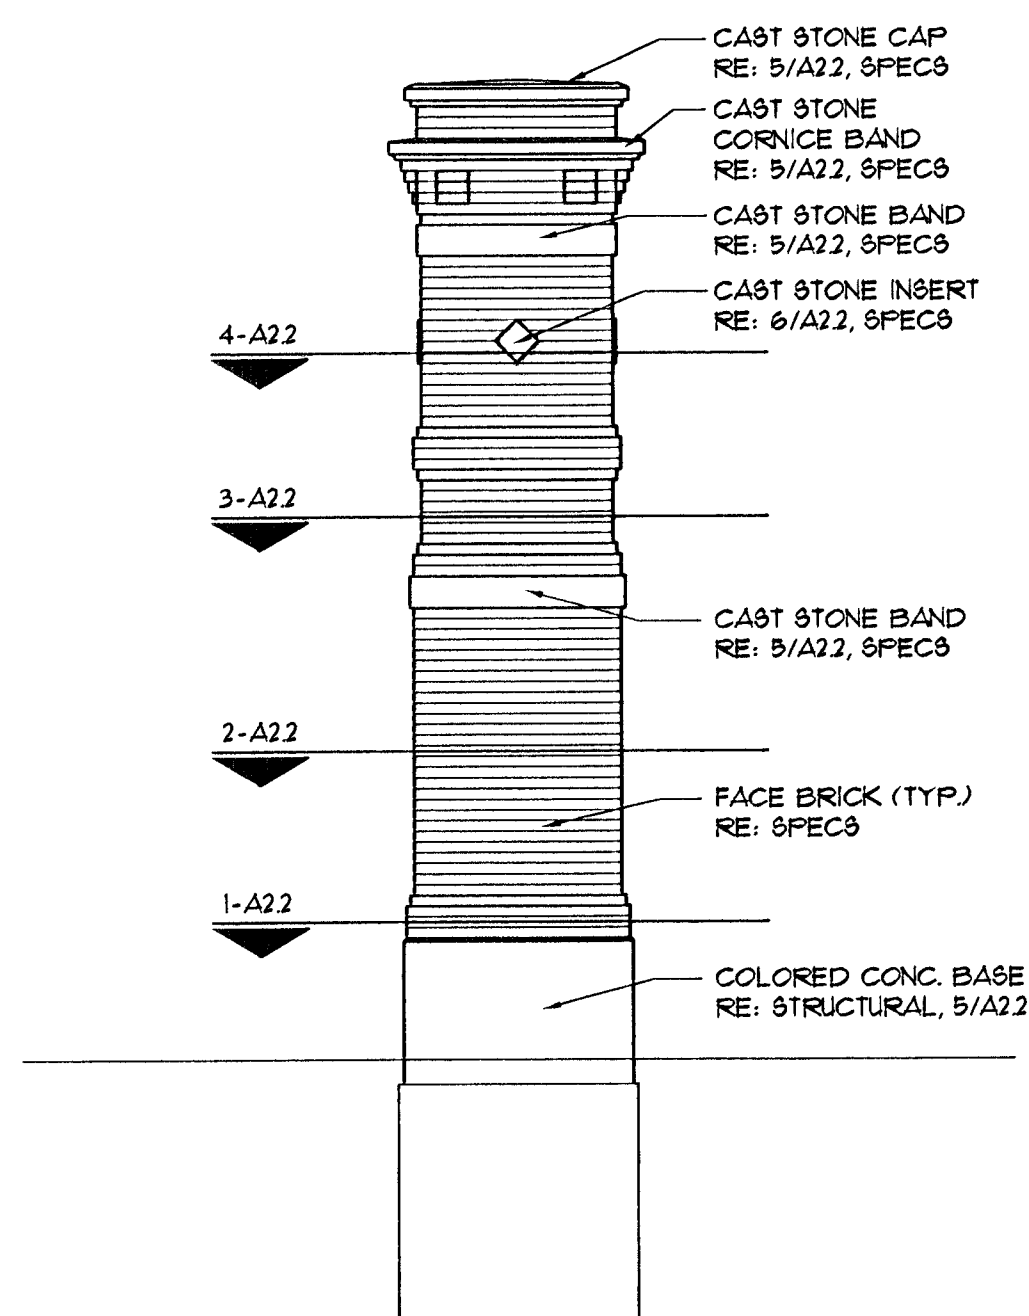


2 ARCH BUILDINGSIDE ELEVATION
SCALE: 1/4" = 1'-0"

3 ARCH STREETSIDE ELEVATION
SCALE: 1/4" = 1'-0"


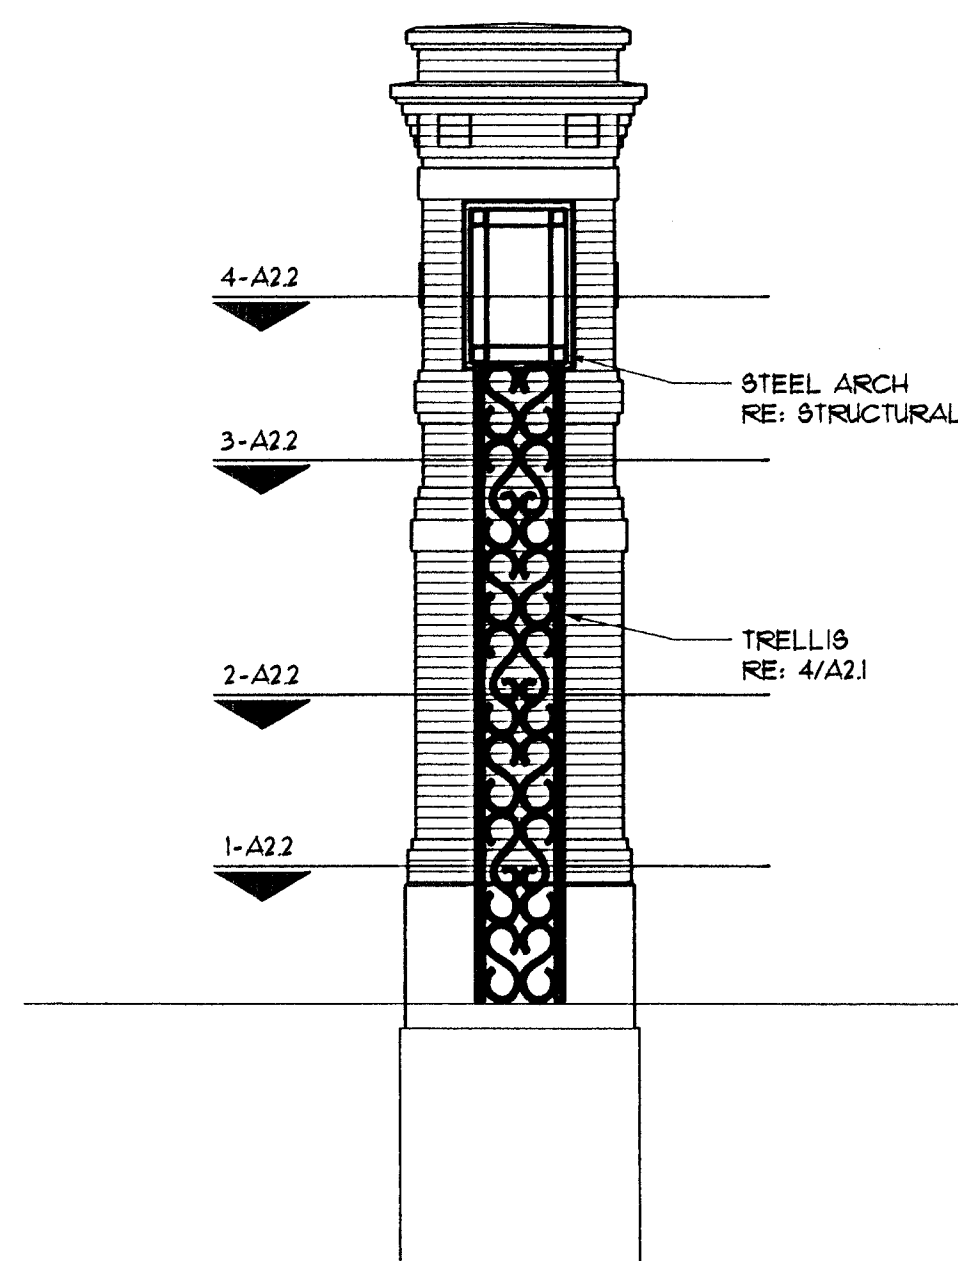


4 TRELLIS AT ARCH COLUMN
(4 REQUIRED)
SCALE: 1/2" = 1'-0"

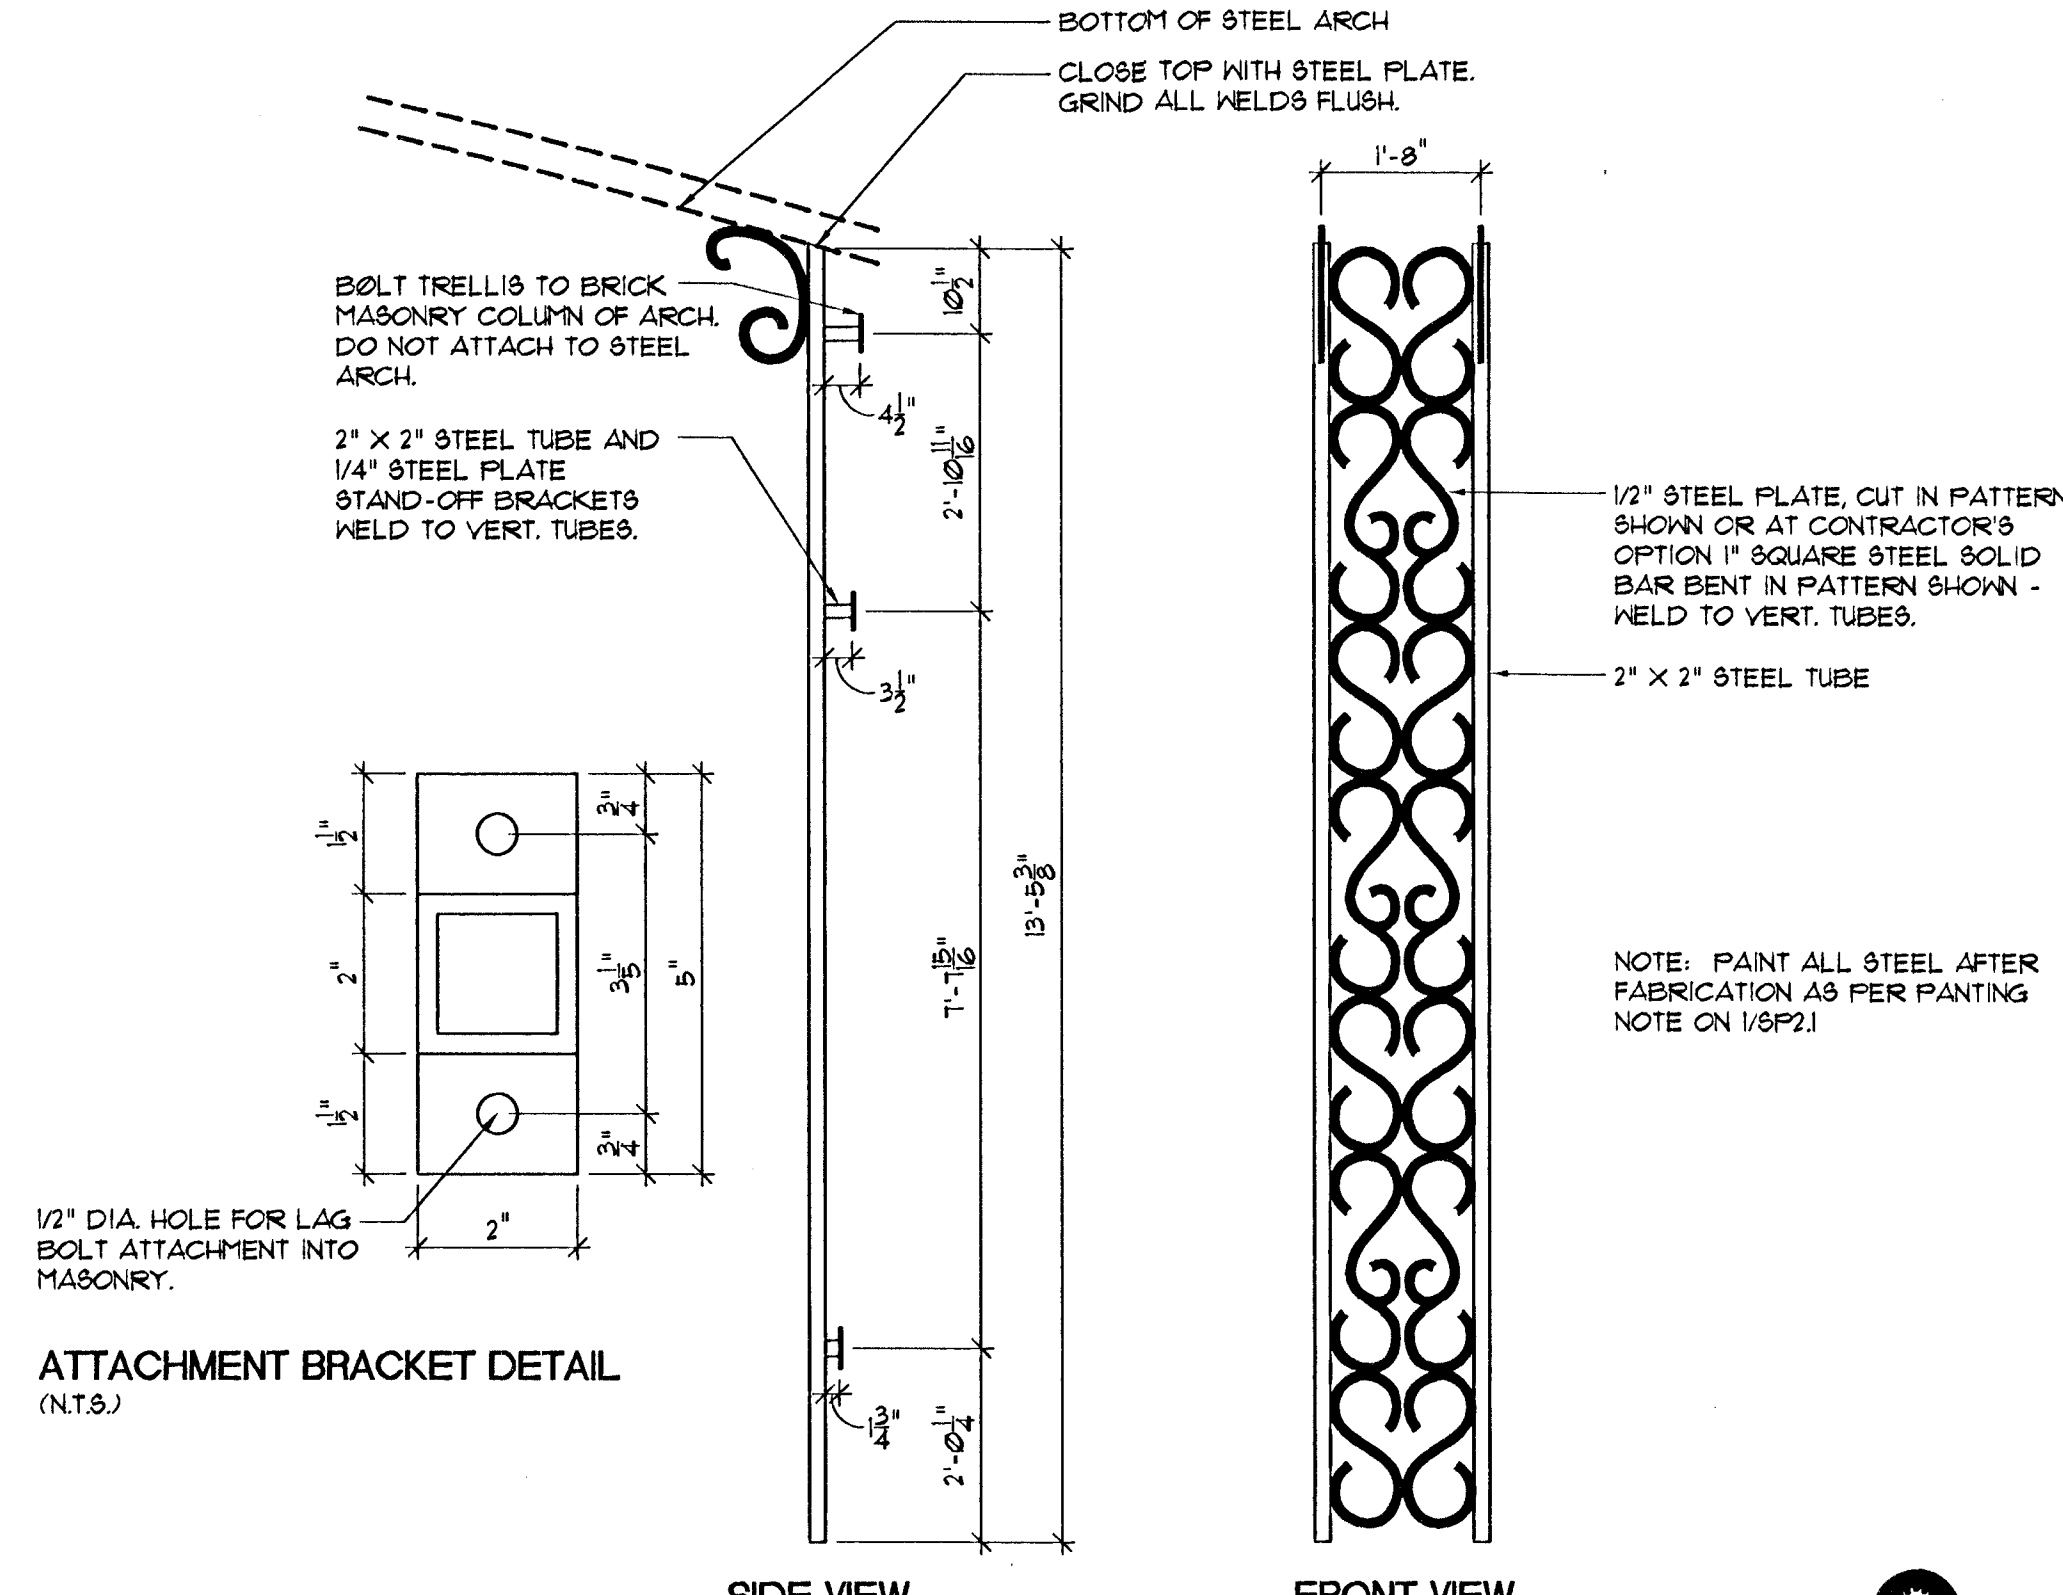


ATTACHMENT BRACKET DETAIL
(NTS.)

1/2" DIA. HOLE FOR LAG BOLT ATTACHMENT INTO MASONRY.

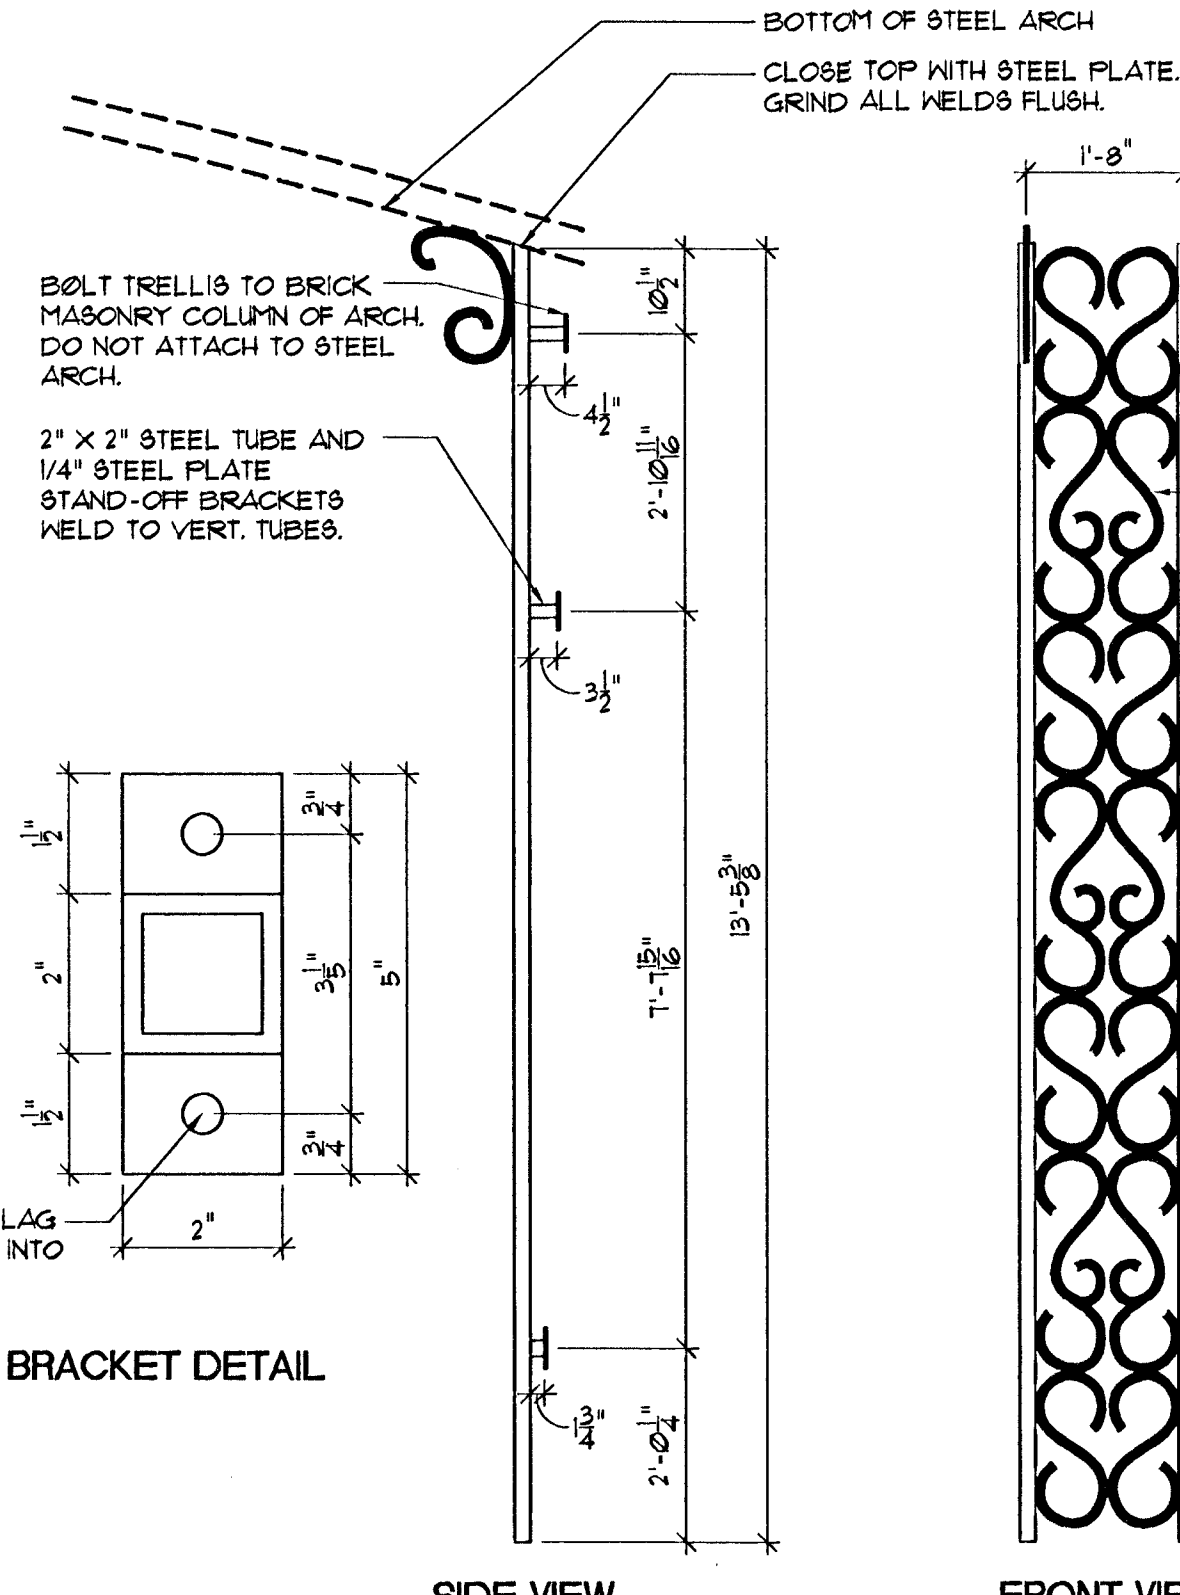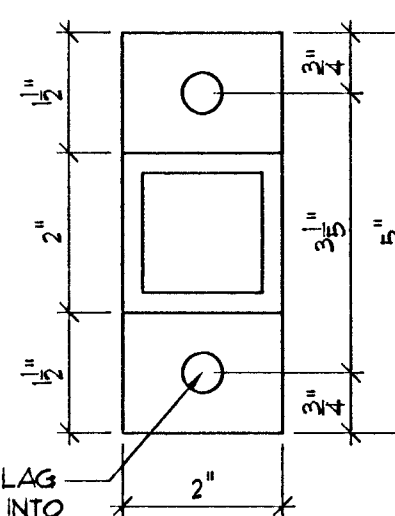

NOTE: PAINT ALL STEEL AFTER FABRICATION AS PER PAINTING NOTE ON 1/8P2.1

5 ARCH SIGN
(2 REQUIRED)
SCALE: 1" = 1'-0"

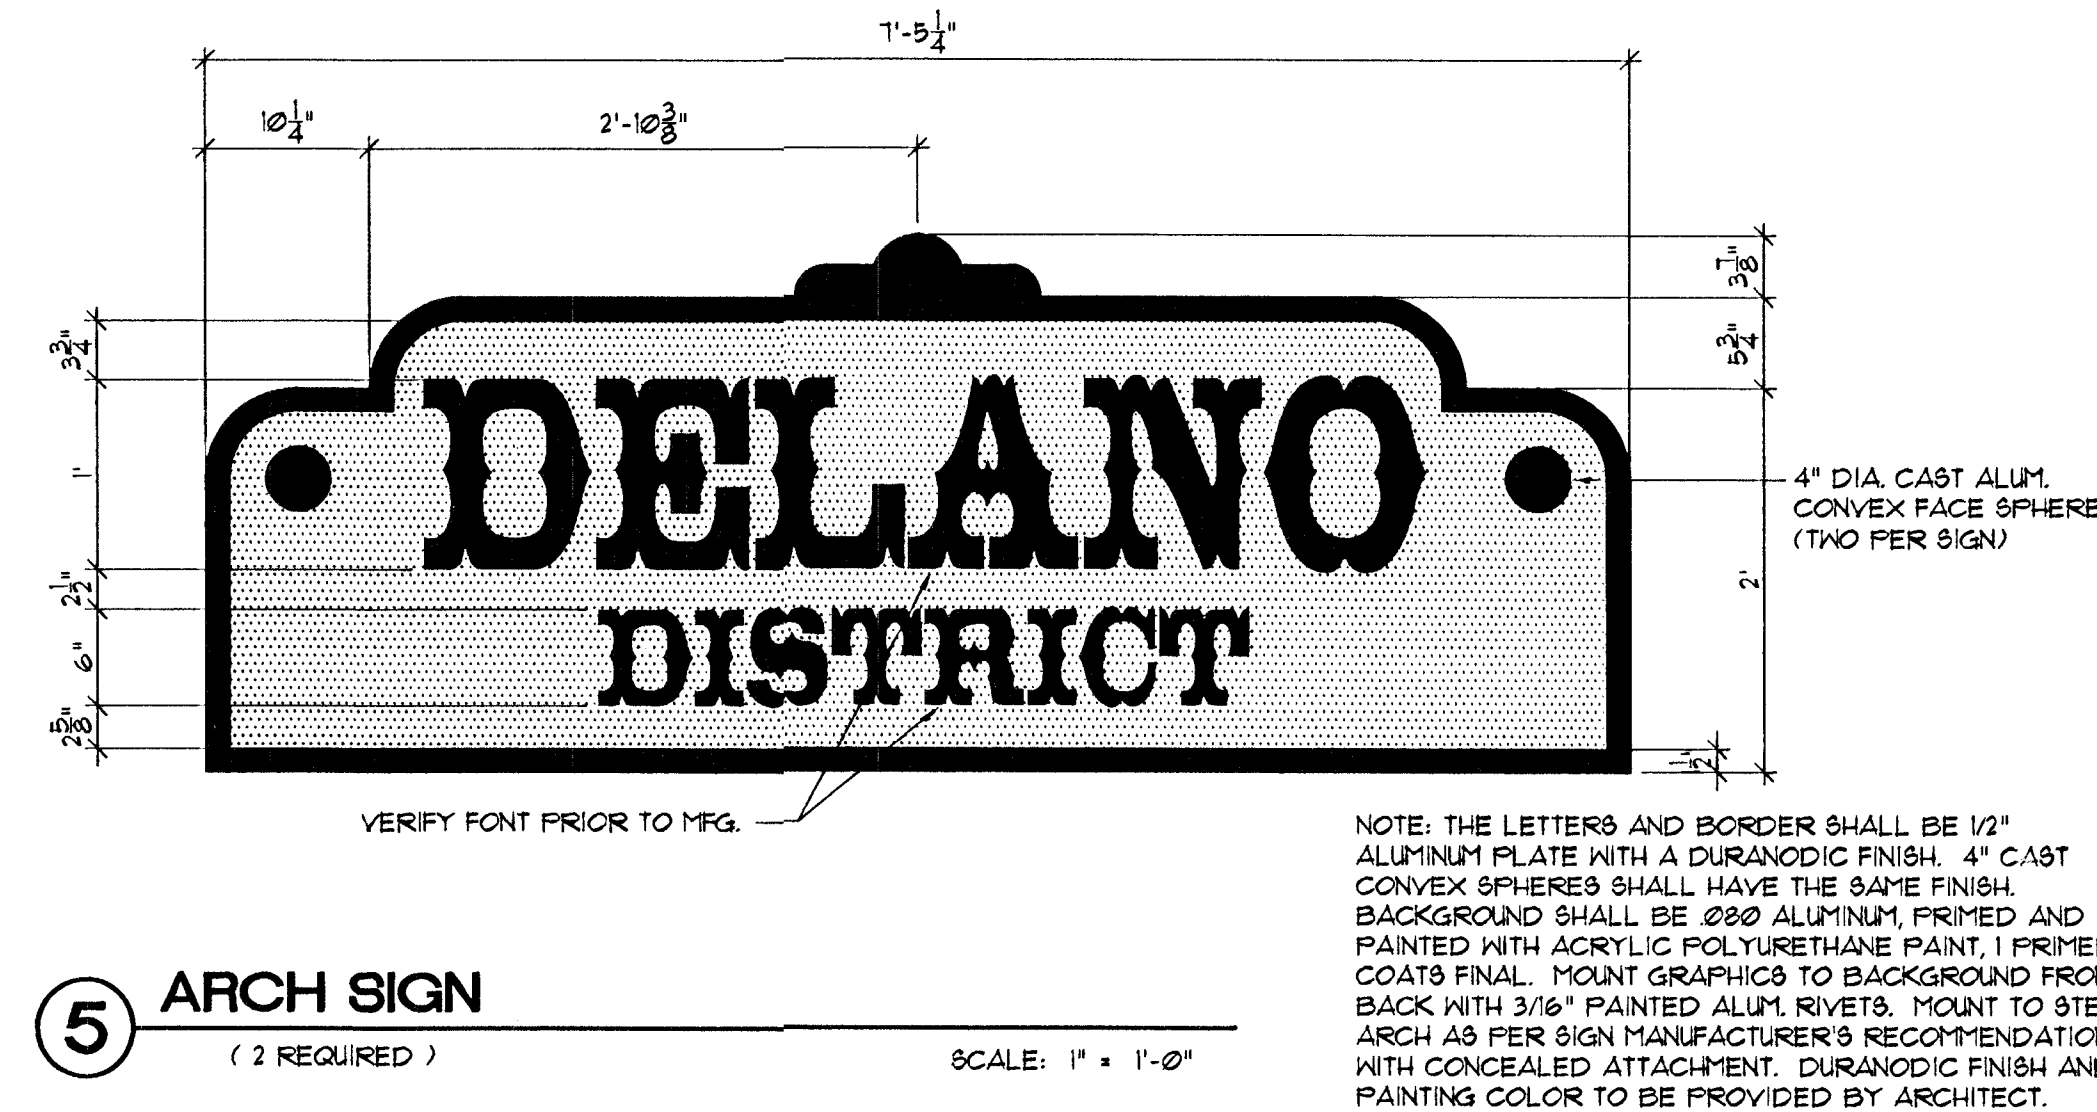

Did not Build



ARCH DETAILS

SHEET
A2.1

PROJECT NO. 472 83608
MVP PROJECT NO. 10/008
DATE: AUGUST 1, 2002
REVISED

WEST DOUGLAS STREETSCAPE
ARKANSAS RIVER TO SENECA
WICHITA, KANSAS

ARCHITECTS • PLANNERS • LANDSCAPE ARCHITECTS
15 S. WASHINGTON WICHITA, KANSAS 67202
P.O. BOX 346 WICHITA, KANSAS 67201
TEL. 360.2046 • FAX 360.2046
MCCLUGGAGE VAN SICKLE & PERRY