



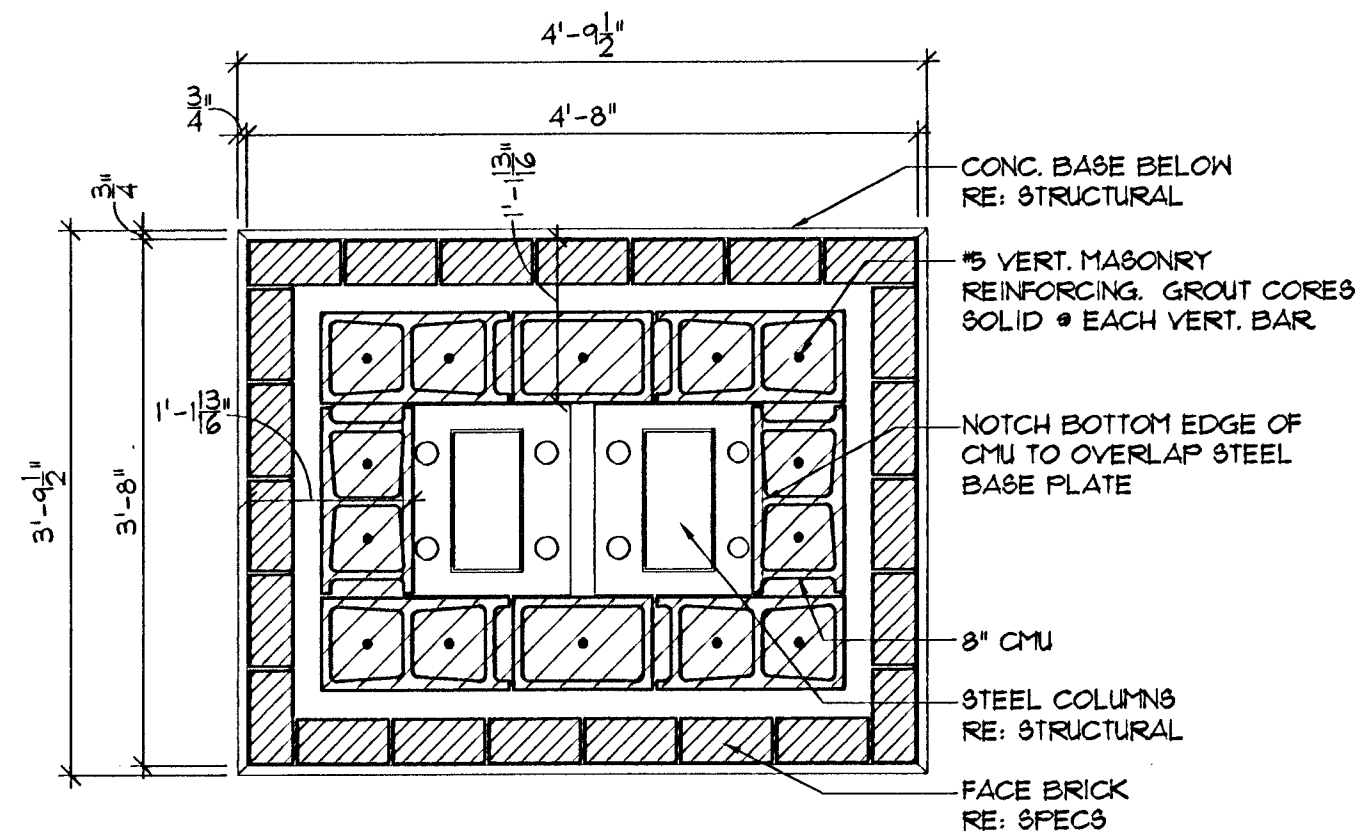


① ARCH SECTION DETAIL

SCALE: 3/4" = 1'-0"

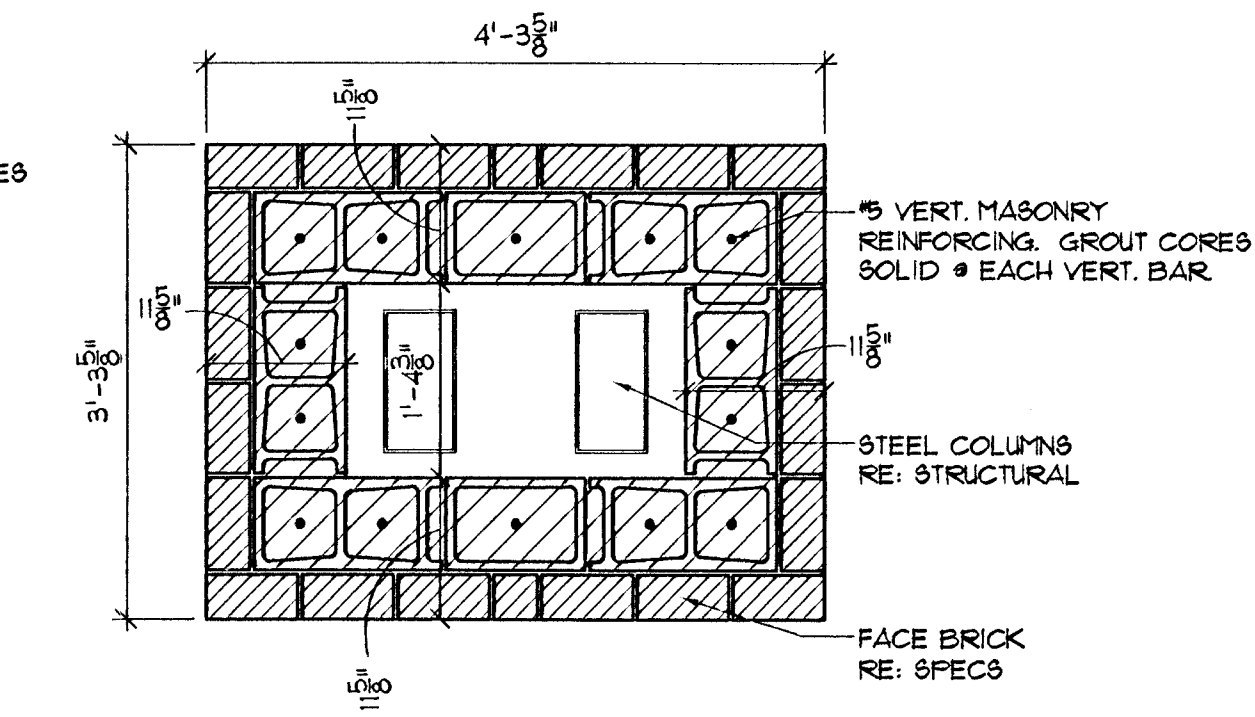


② ARCH SECTION DETAIL

SCALE: 3/4" = 1'-0"

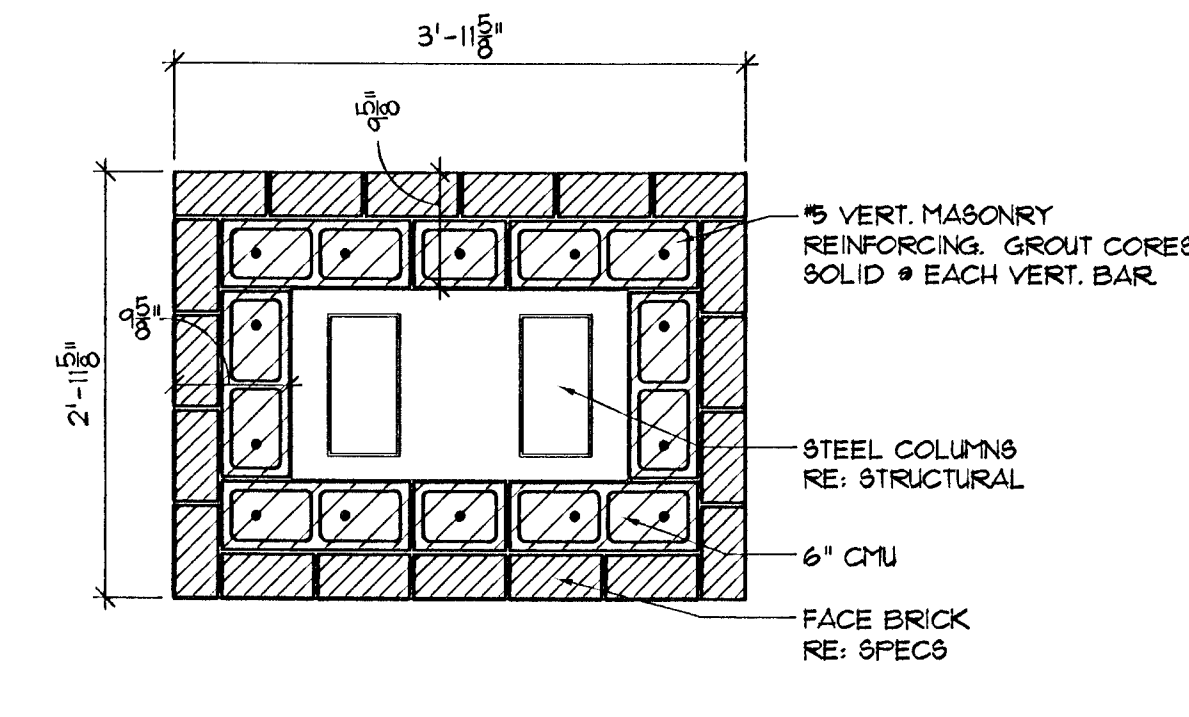


③ ARCH SECTION DETAIL

SCALE: 3/4" = 1'-0"

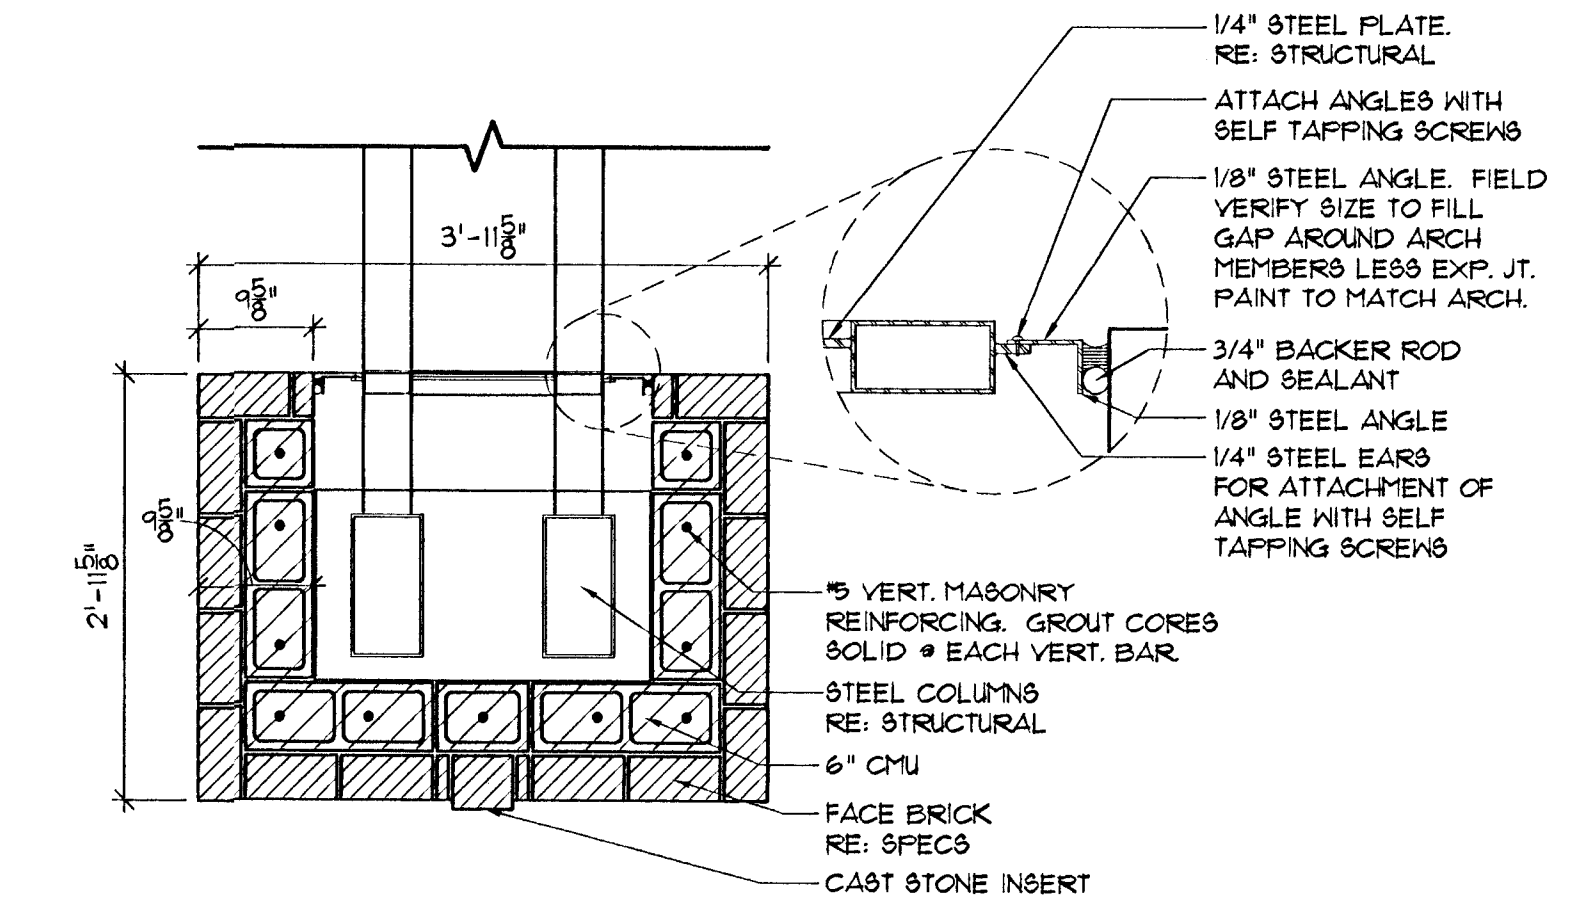

④ ARCH SECTION DETAIL


SCALE: 3/4" = 1'-0"

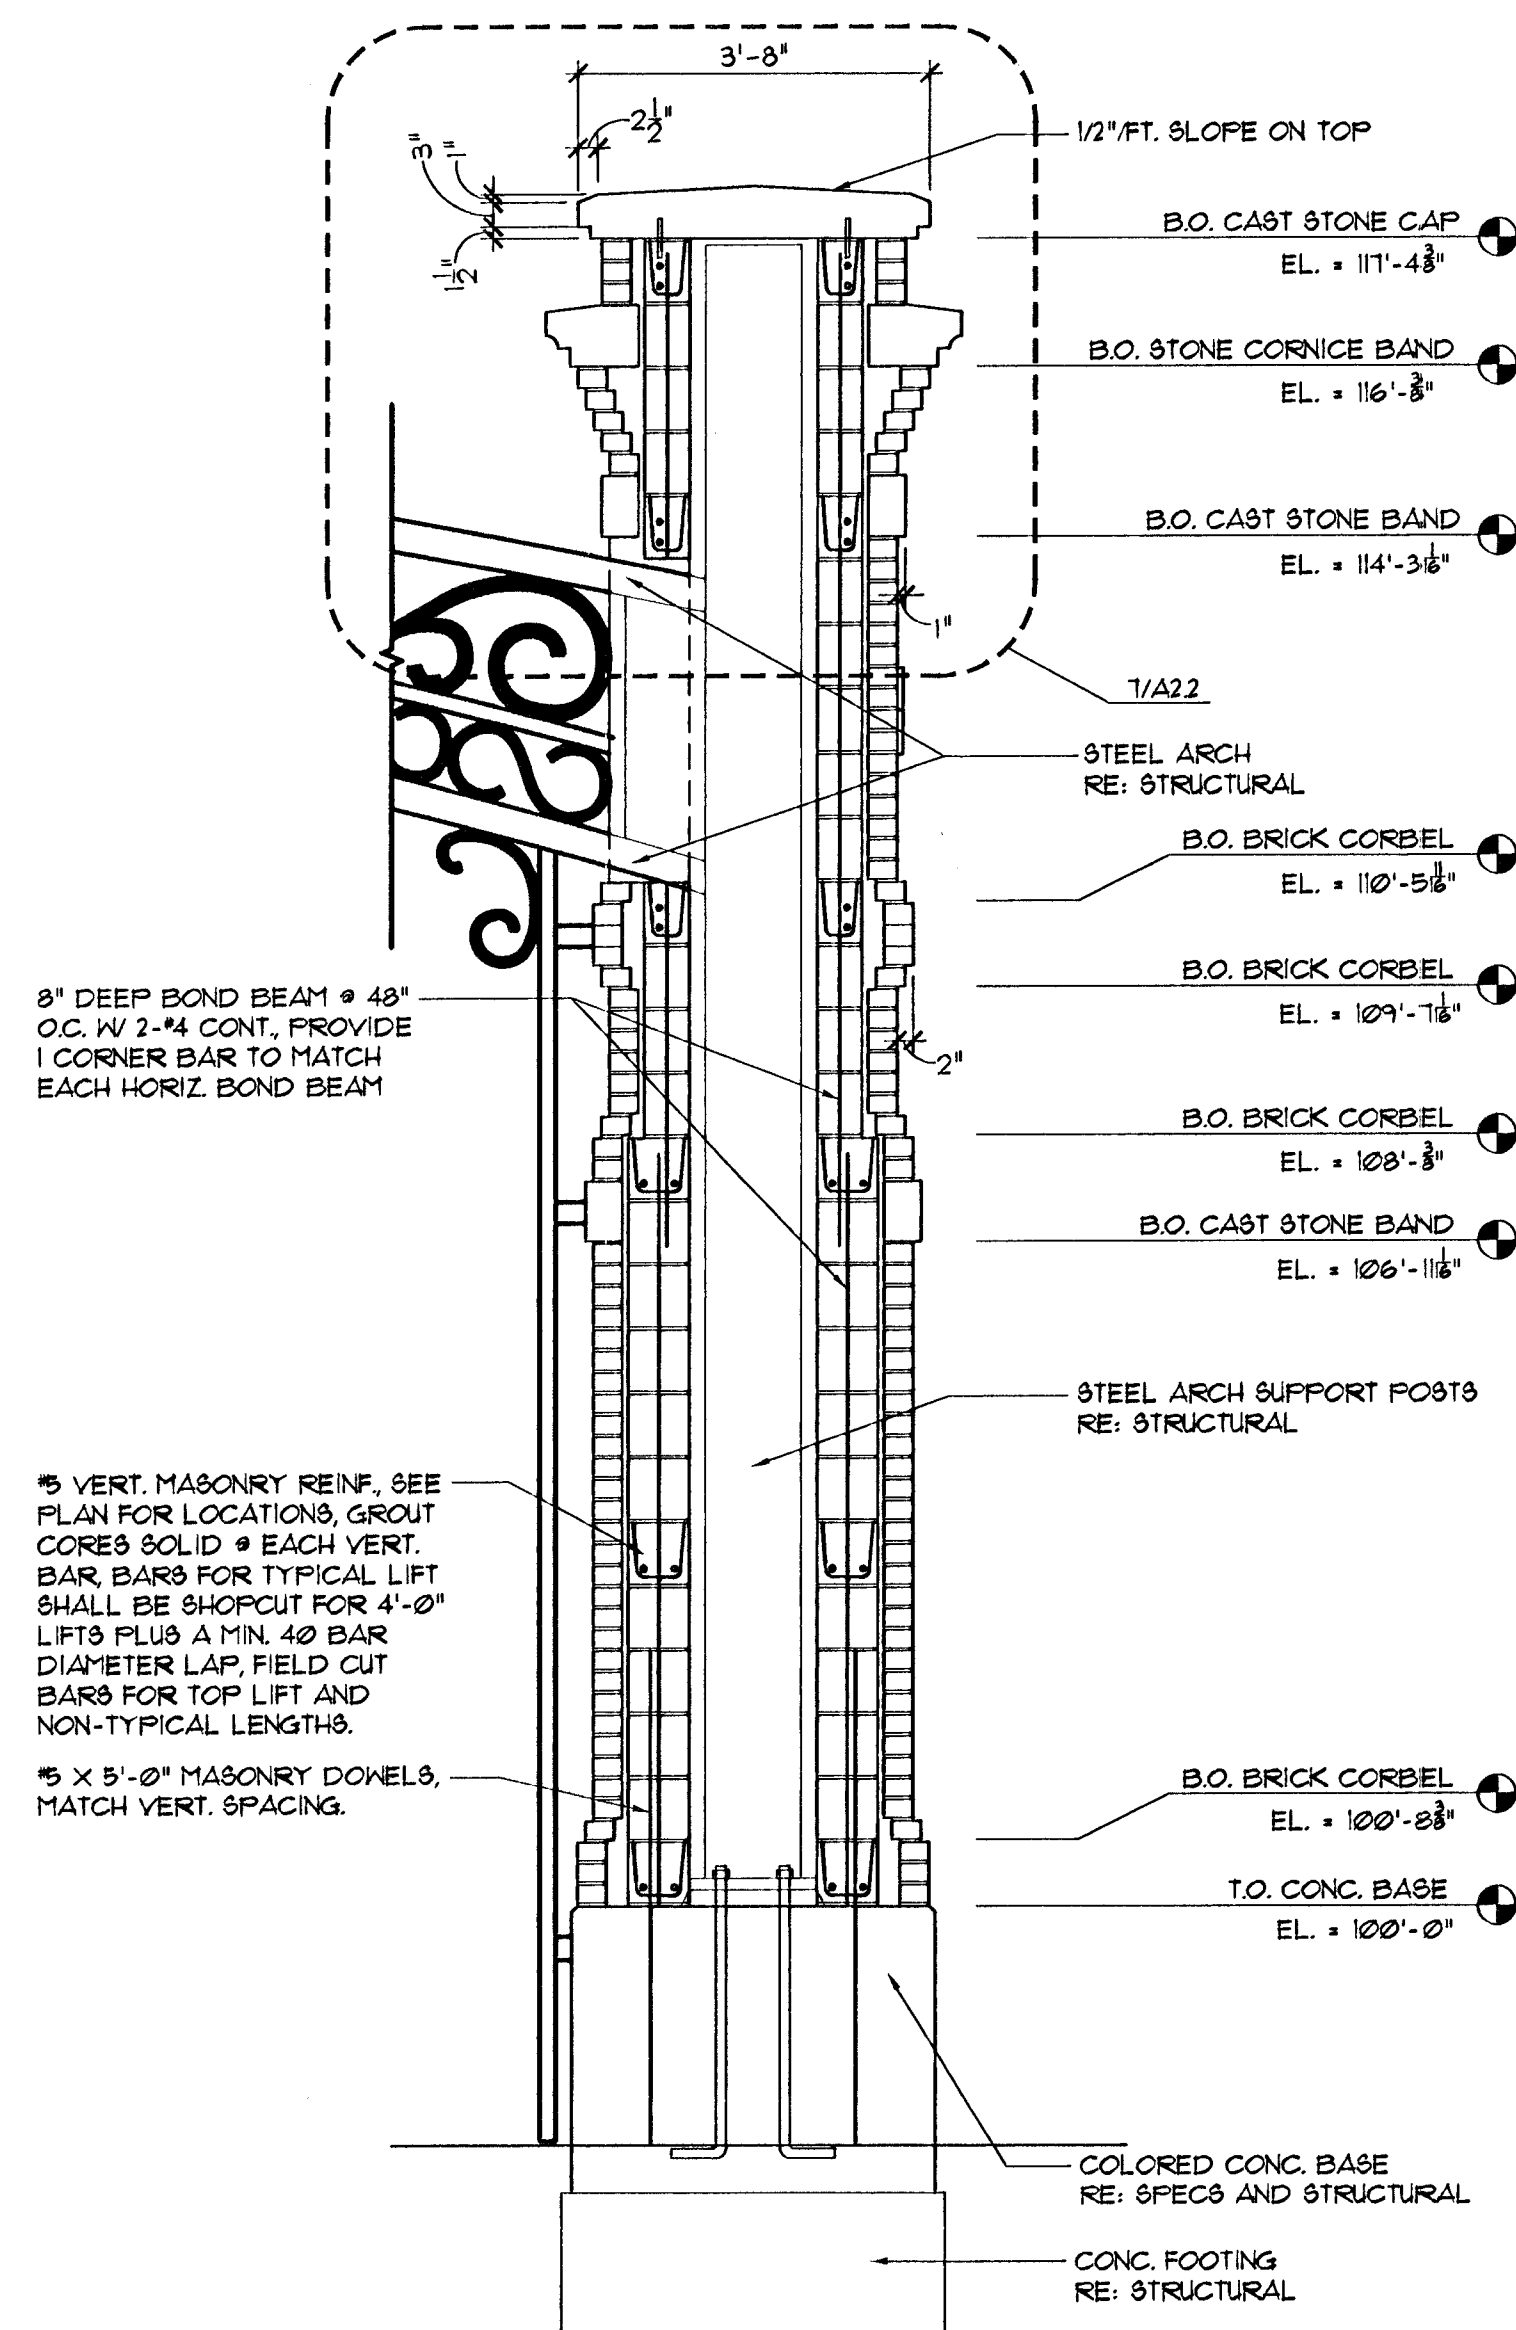

⑤ ENLARGED ARCH TOWER


SCALE: 1/2" = 1'-0"

NOTE:
REFER TO SP11 AND SP15 FOR CORRESPONDING SITE ELEVATIONS
ARCH. ELEVATION 100'-0" = SITE ELEVATION AS NOTED

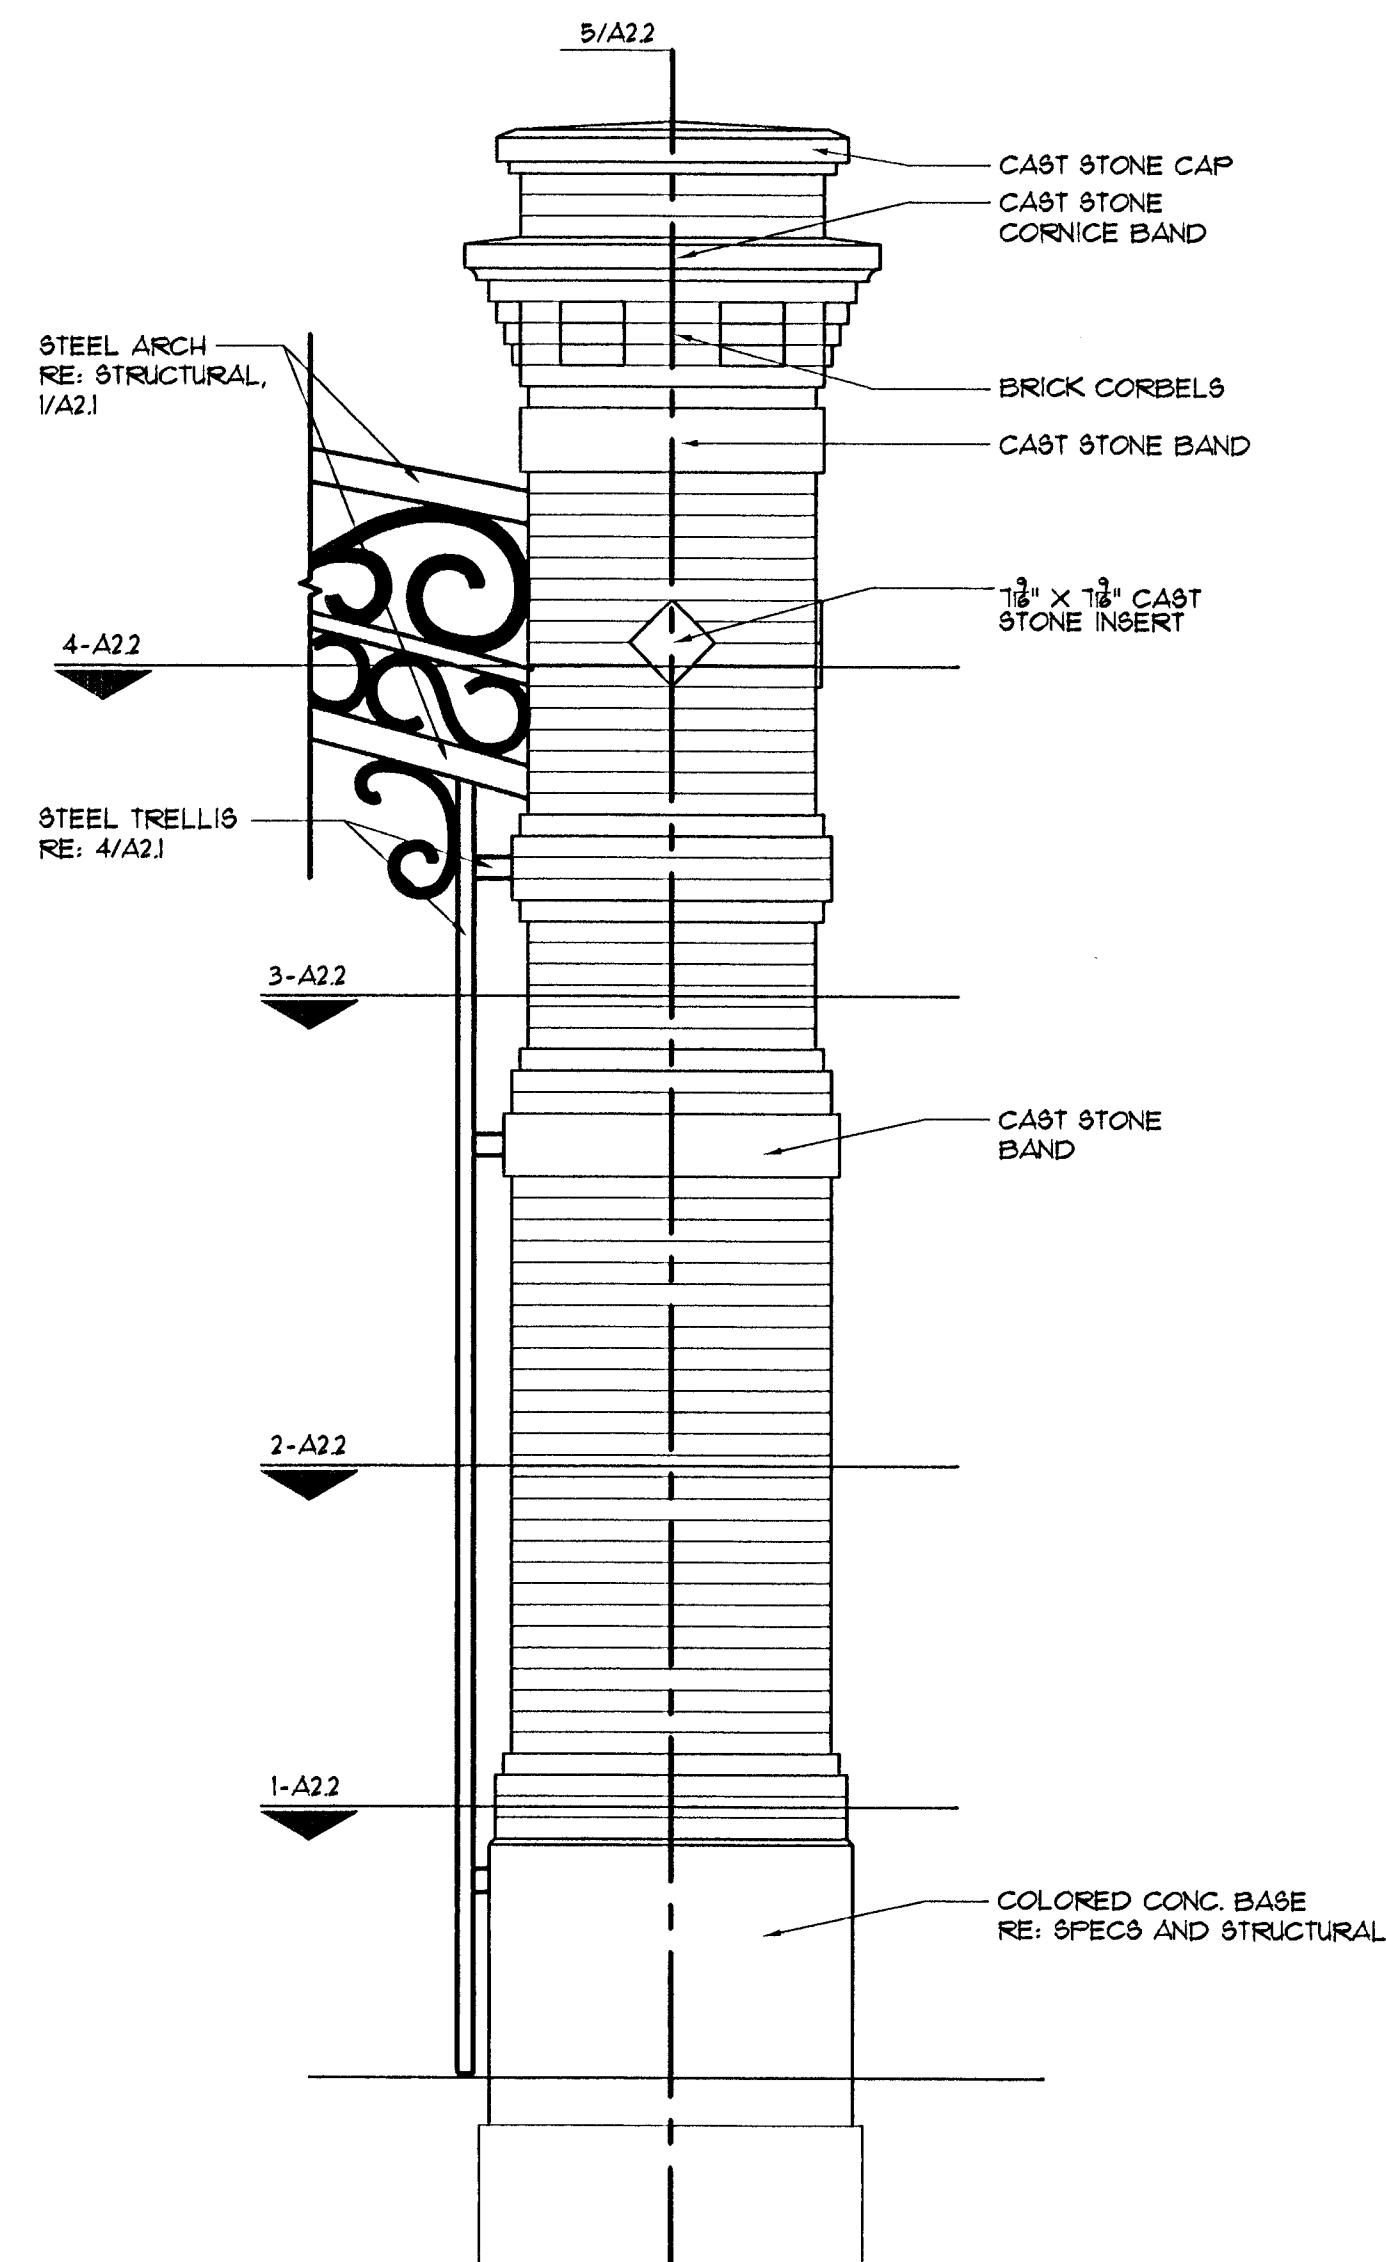


⑥ ENLARGED ARCH TOWER

SCALE: 1/2" = 1'-0"

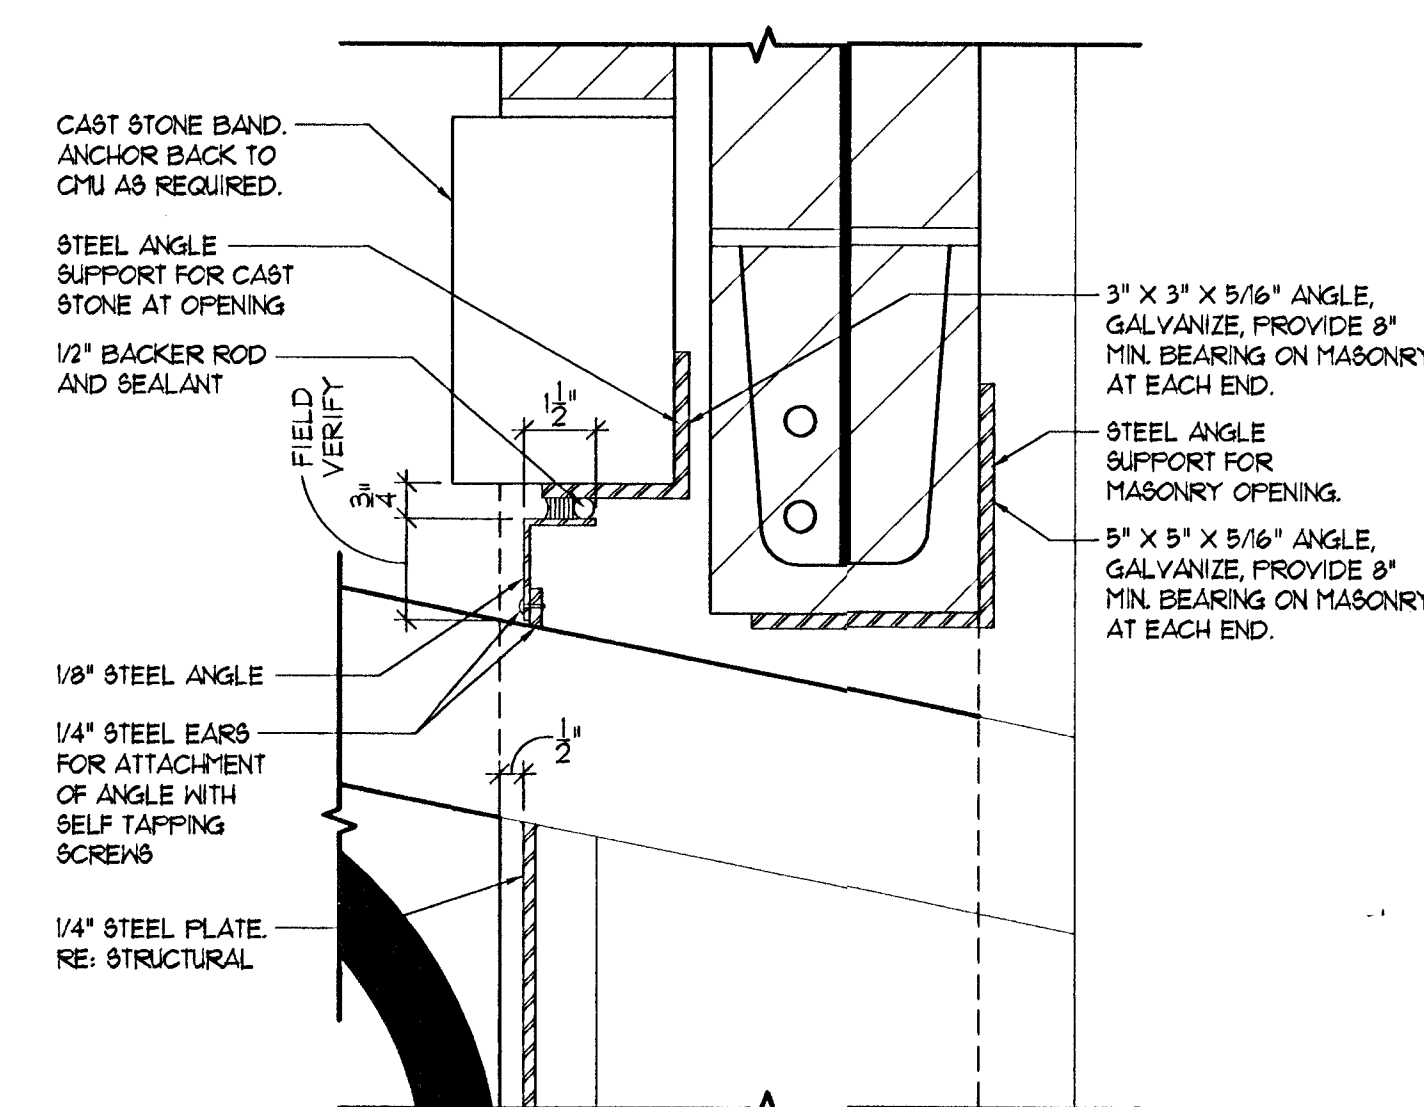

⑥ WALL SECTION DETAIL AT OPENINGS

SCALE: 3" = 1'-0"

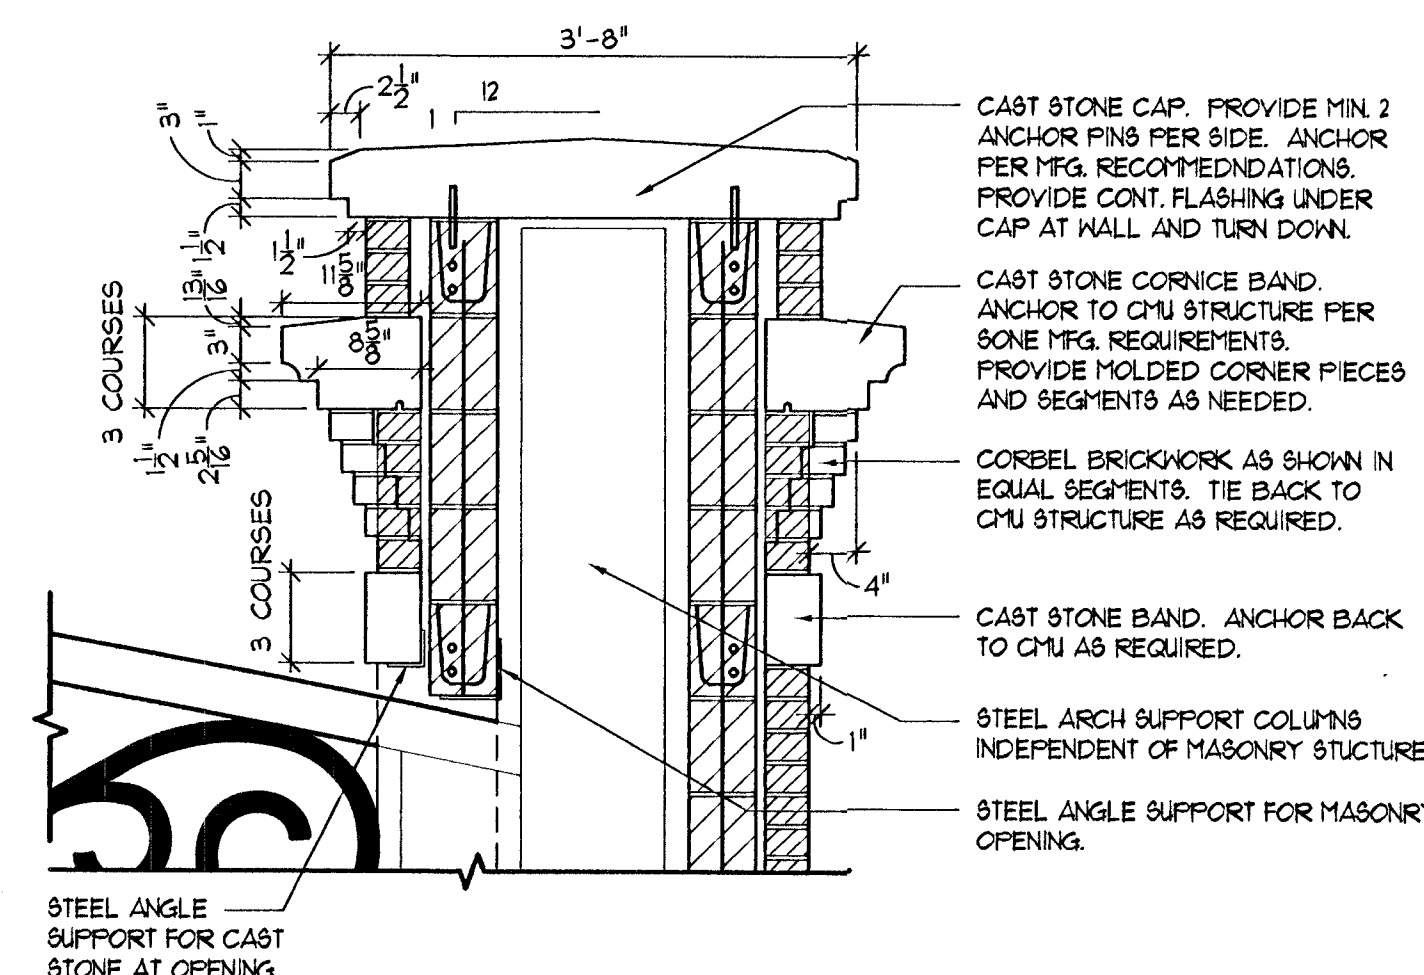

⑦ WALL SECTION DETAIL


SCALE: 3/4" = 1'-0"

*Did Not
Build*



ARCH DETAILS

WEST DOUGLAS STREETSCAPE
ARKANSAS RIVER TO SENECA
WICHITA, KANSAS

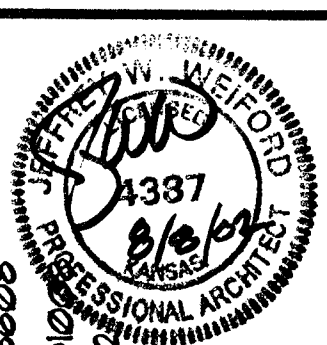

PROJECT NO. 472 836-06
MVP PROJECT NO. 1070
DATE: AUGUST 1, 2007
REVISIONS

SHEET
A2.2

ARCHITECTS • PLANNERS • LANDSCAPE ARCHITECTS
125 S. WASHINGTON WICHITA, KANSAS 67202
P.O. BOX 346 WICHITA, KANSAS 67201
PH: 316.262.0400 • FAX: 316.262.0405

MCCLEGGAGE VAN SICKLE & PERRY