


THIS SHEET ELIMINATED DUE TO
RE-ROUTING OF BIKE PATH WITHIN PARK.

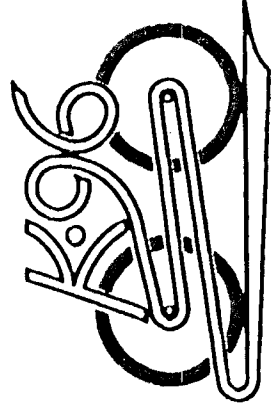


BIKE PATH
WICHITA, KANSAS

drawn WDM check LME

WDM no. 93242

prints issued
5/1/95 FIELD CHECK
11/3/95 NOT ISSUED
5/10/96 OFFICE CHECK
10/15/96 CONST.
3/5/97 FINAL CHECK

COPYRIGHT © 1994
Wilson Darnell Mann, PA

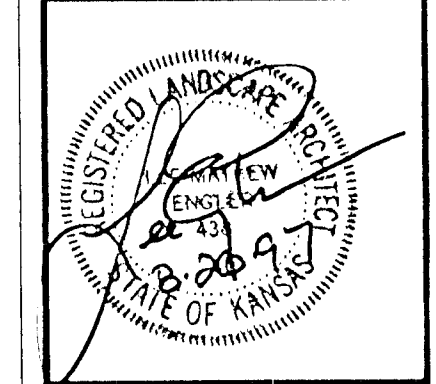

Wilson Darnell Mann PA
architecture site planning interiors
105 N. Washington Wichita, Kansas 67202 316-262-4700

