


BID ALTERNATE SECTION A-A'



NOTE: Existing pipe to remain. Pipe to be inspected prior to construction and after construction to verify that it is undamaged. Pipe to be replaced if damaged.

CONSTRUCTION AT POND:
Pond may be drained to facilitate construction but this shall be kept to the minimum required for construction activities. Contractor shall be responsible for any damage or erosion during construction, and shall be responsible to repair or restore this area back to original condition. Disturbed areas are to be protected with erosion control blanket and seeding (Curlex erosion control blanket or other per City standards). Install and maintain per manufacturer and City standards.

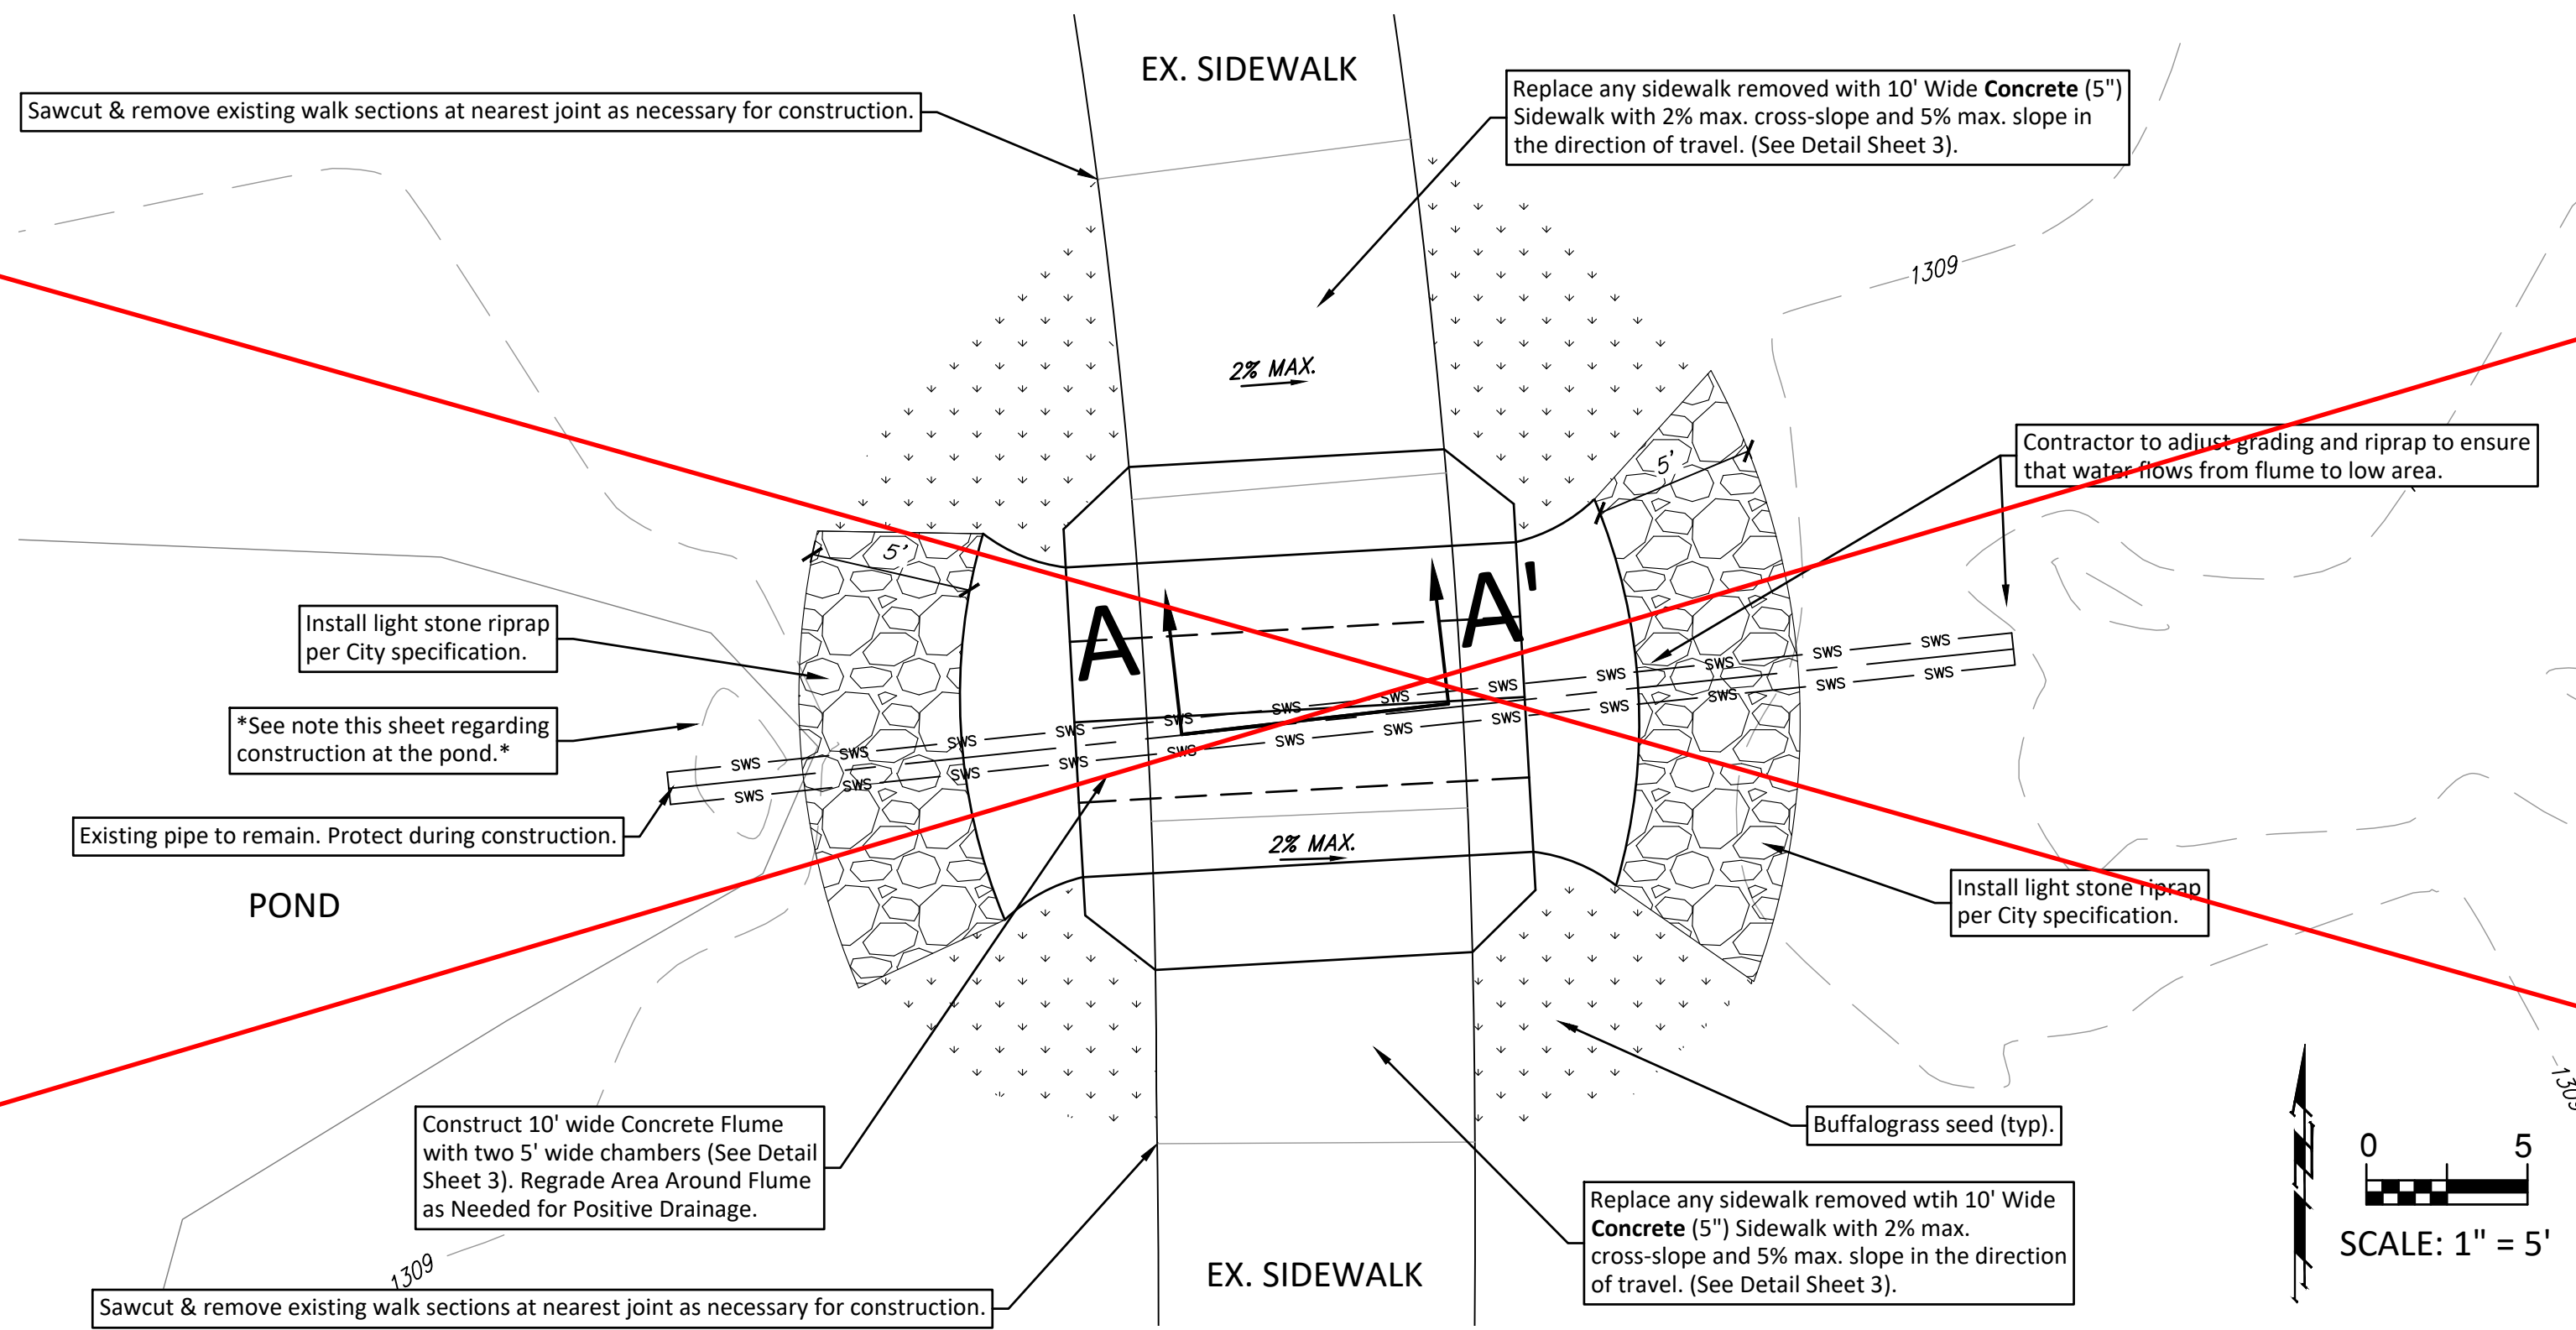

**BID ALTERNATE 1
HASKELL STREET POND DRAINAGE IMPROVEMENTS**

QUANTITIES	
ITEM	QUANTITY
5" CONCRETE SIDEWALK (REINFORCED)	100 - 300 sf
BUFFALO GRASS SEED	207 SF
LIGHT STONE RIPRAP	16 SQ YD

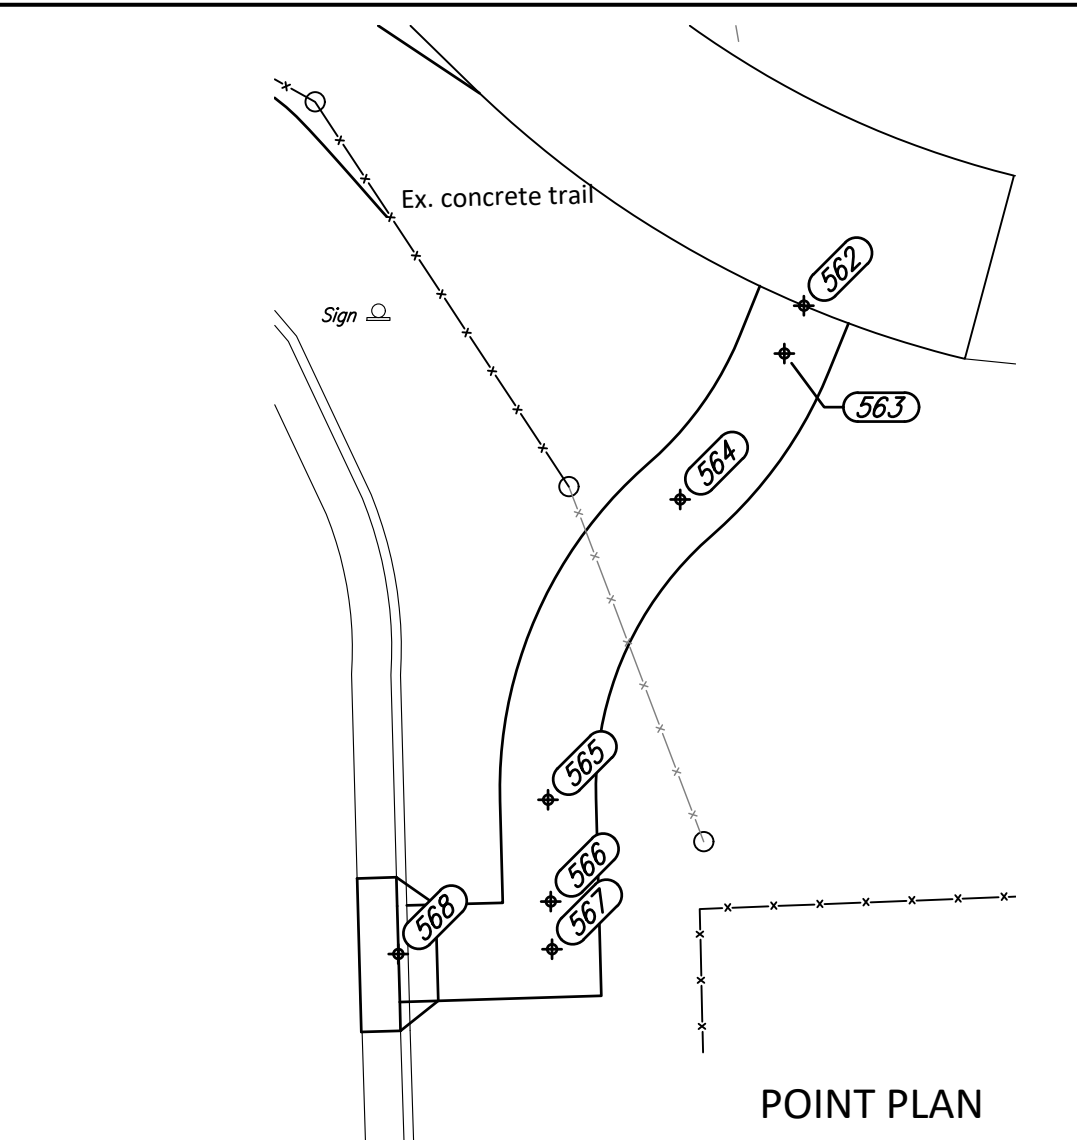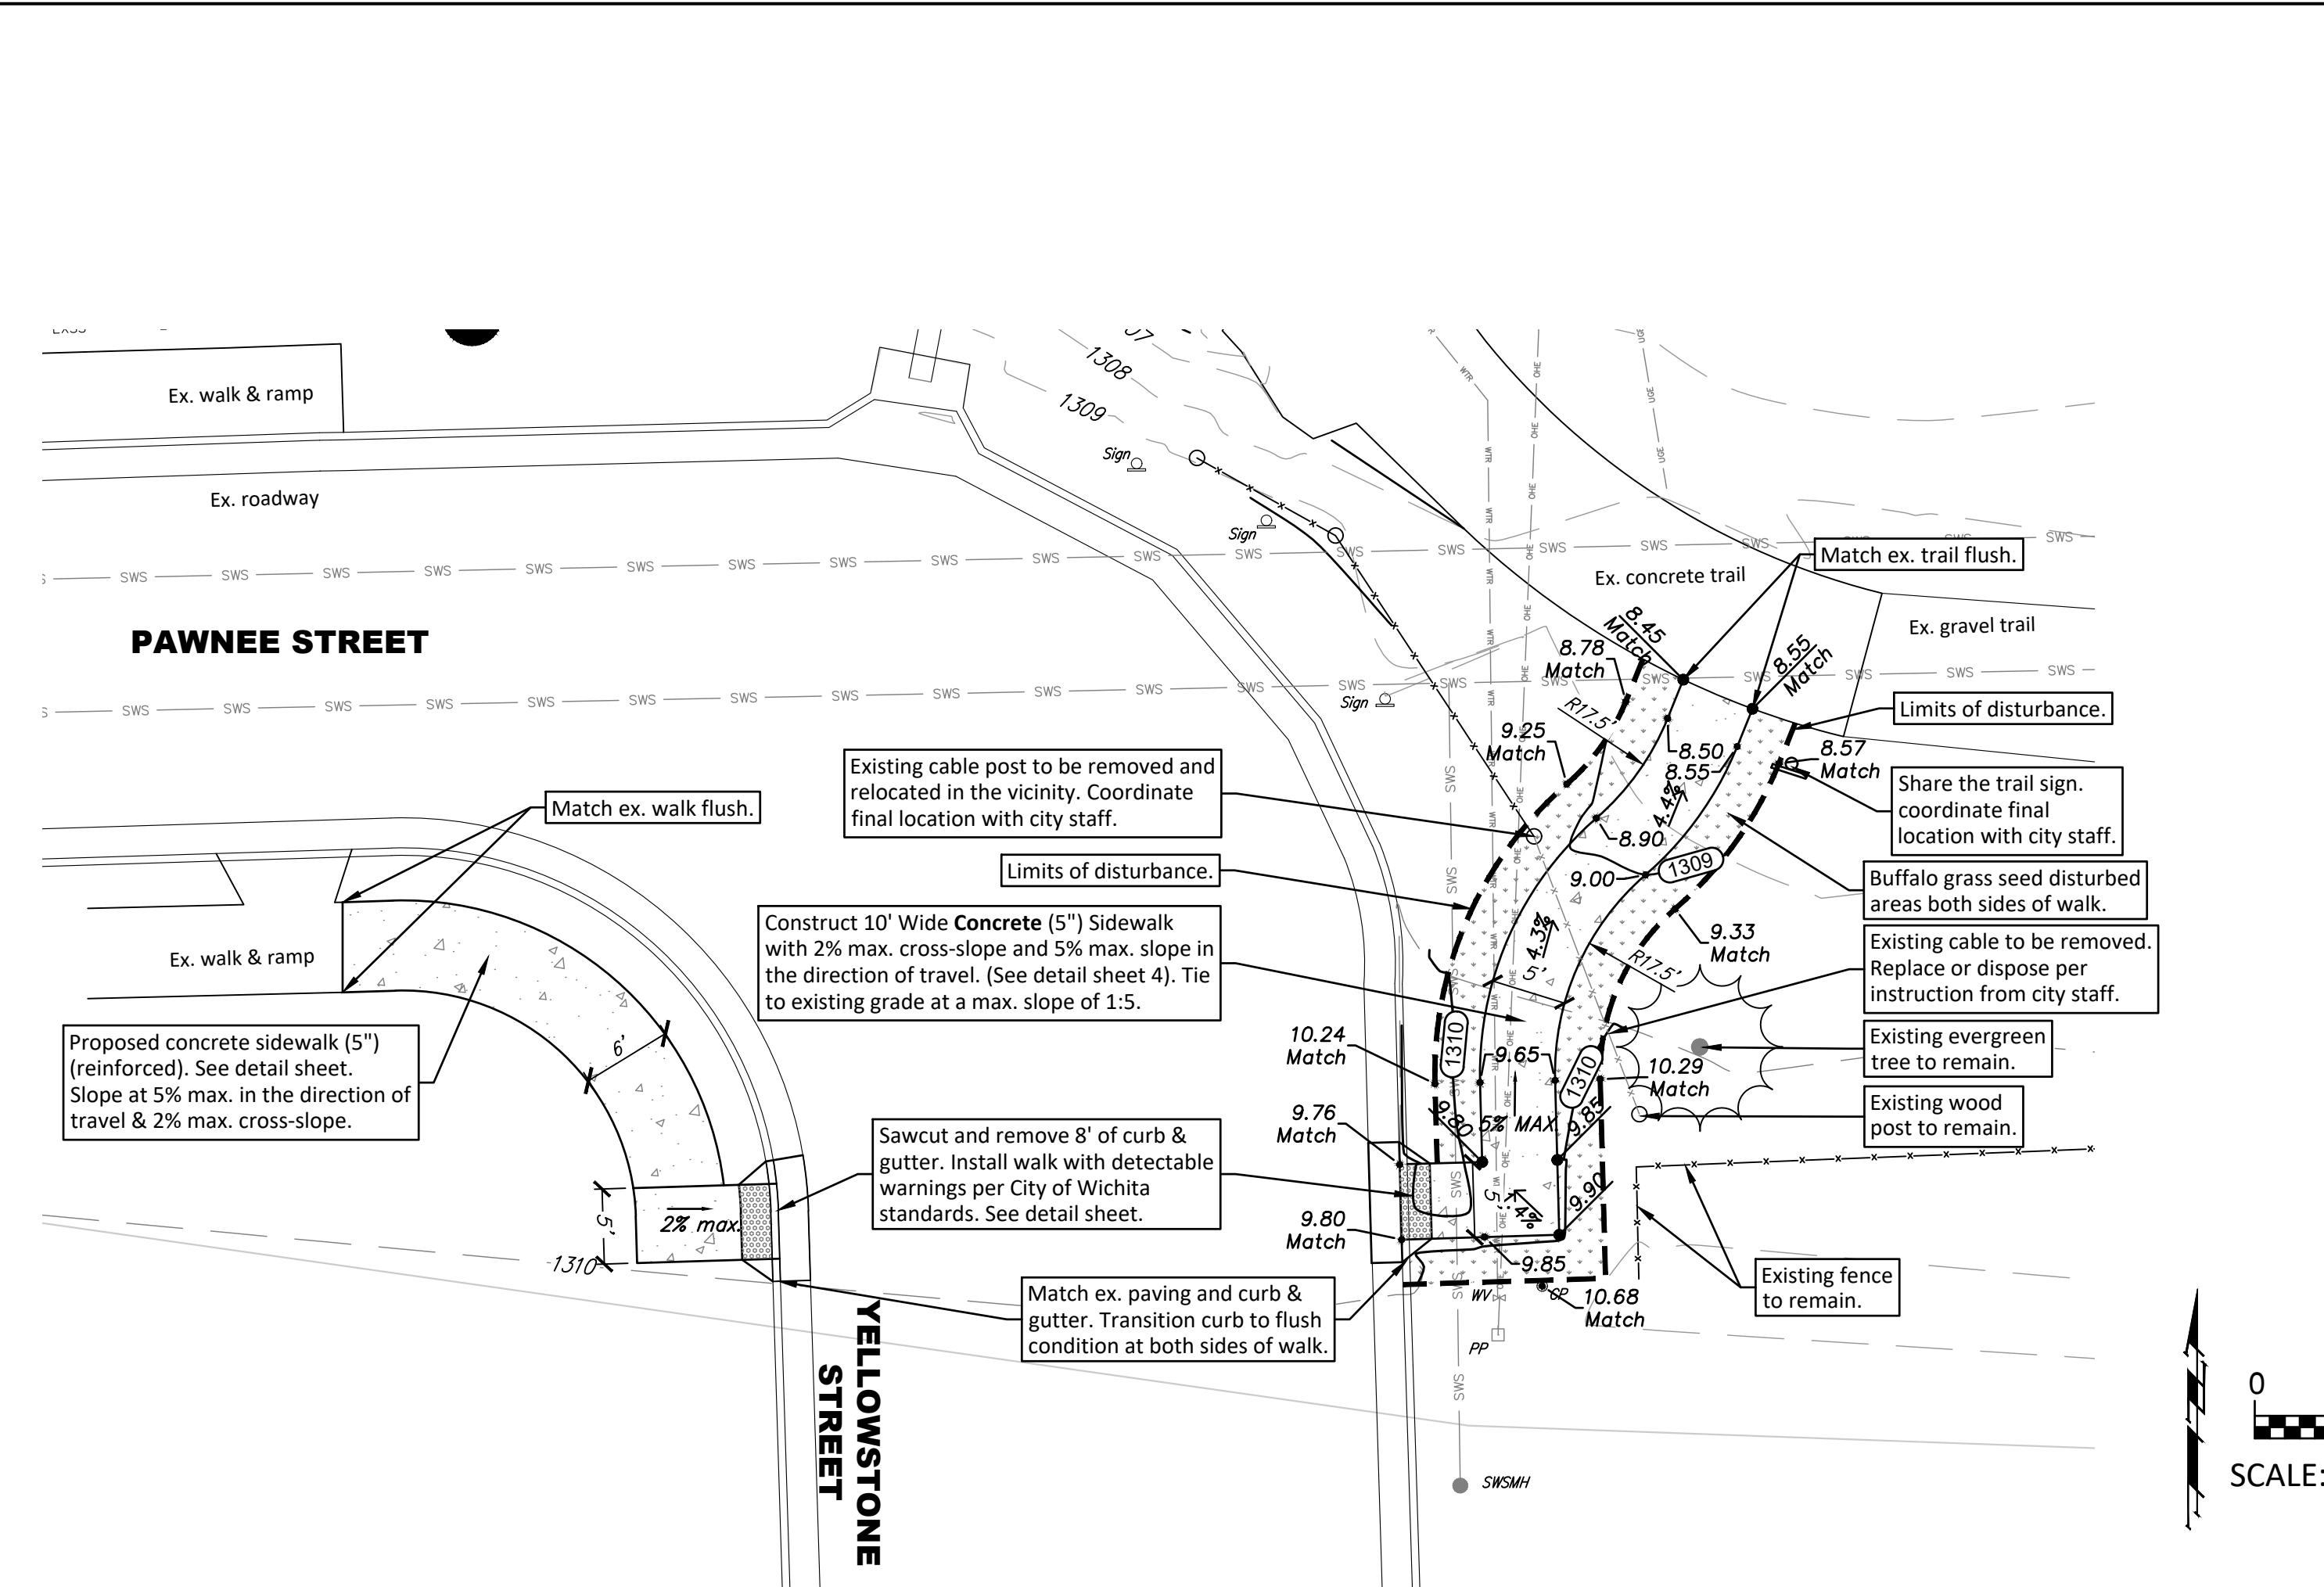

NOTE
1. Pedestrian improvements at this intersection are Bid Alternate only. Bid Alternate includes:
- Curb demolition & installation of detectable pavers.
- Installation of 6" sidewalk on the west side of Yellowstone & 5' sidewalk on the east side.
- Installation of share the trail sign.
- Relocation of wood posts and signage in coordination with city staff.

**BID ALTERNATE 2
YELLOWSTONE STREET CROSSWALK IMPROVEMENTS**

QUANTITIES	
ITEM	QUANTITY
5" CONCRETE SIDEWALK (REINFORCED)	440 SF
CURB RAMP	2
SIGN - SHARE THE TRAIL	1
BUFFALO GRASS SEED	271 SF

