ADD ALTERNATE #2

REMOVE & REPLACE THE NET TIE DOWN.
REMOVE & REPLACE THE NET POSTS.
MILL, PATCH & PAINT THE CENTER CRACK.
CLEAN, CRACK SEAL THE EDGES & PAINT.

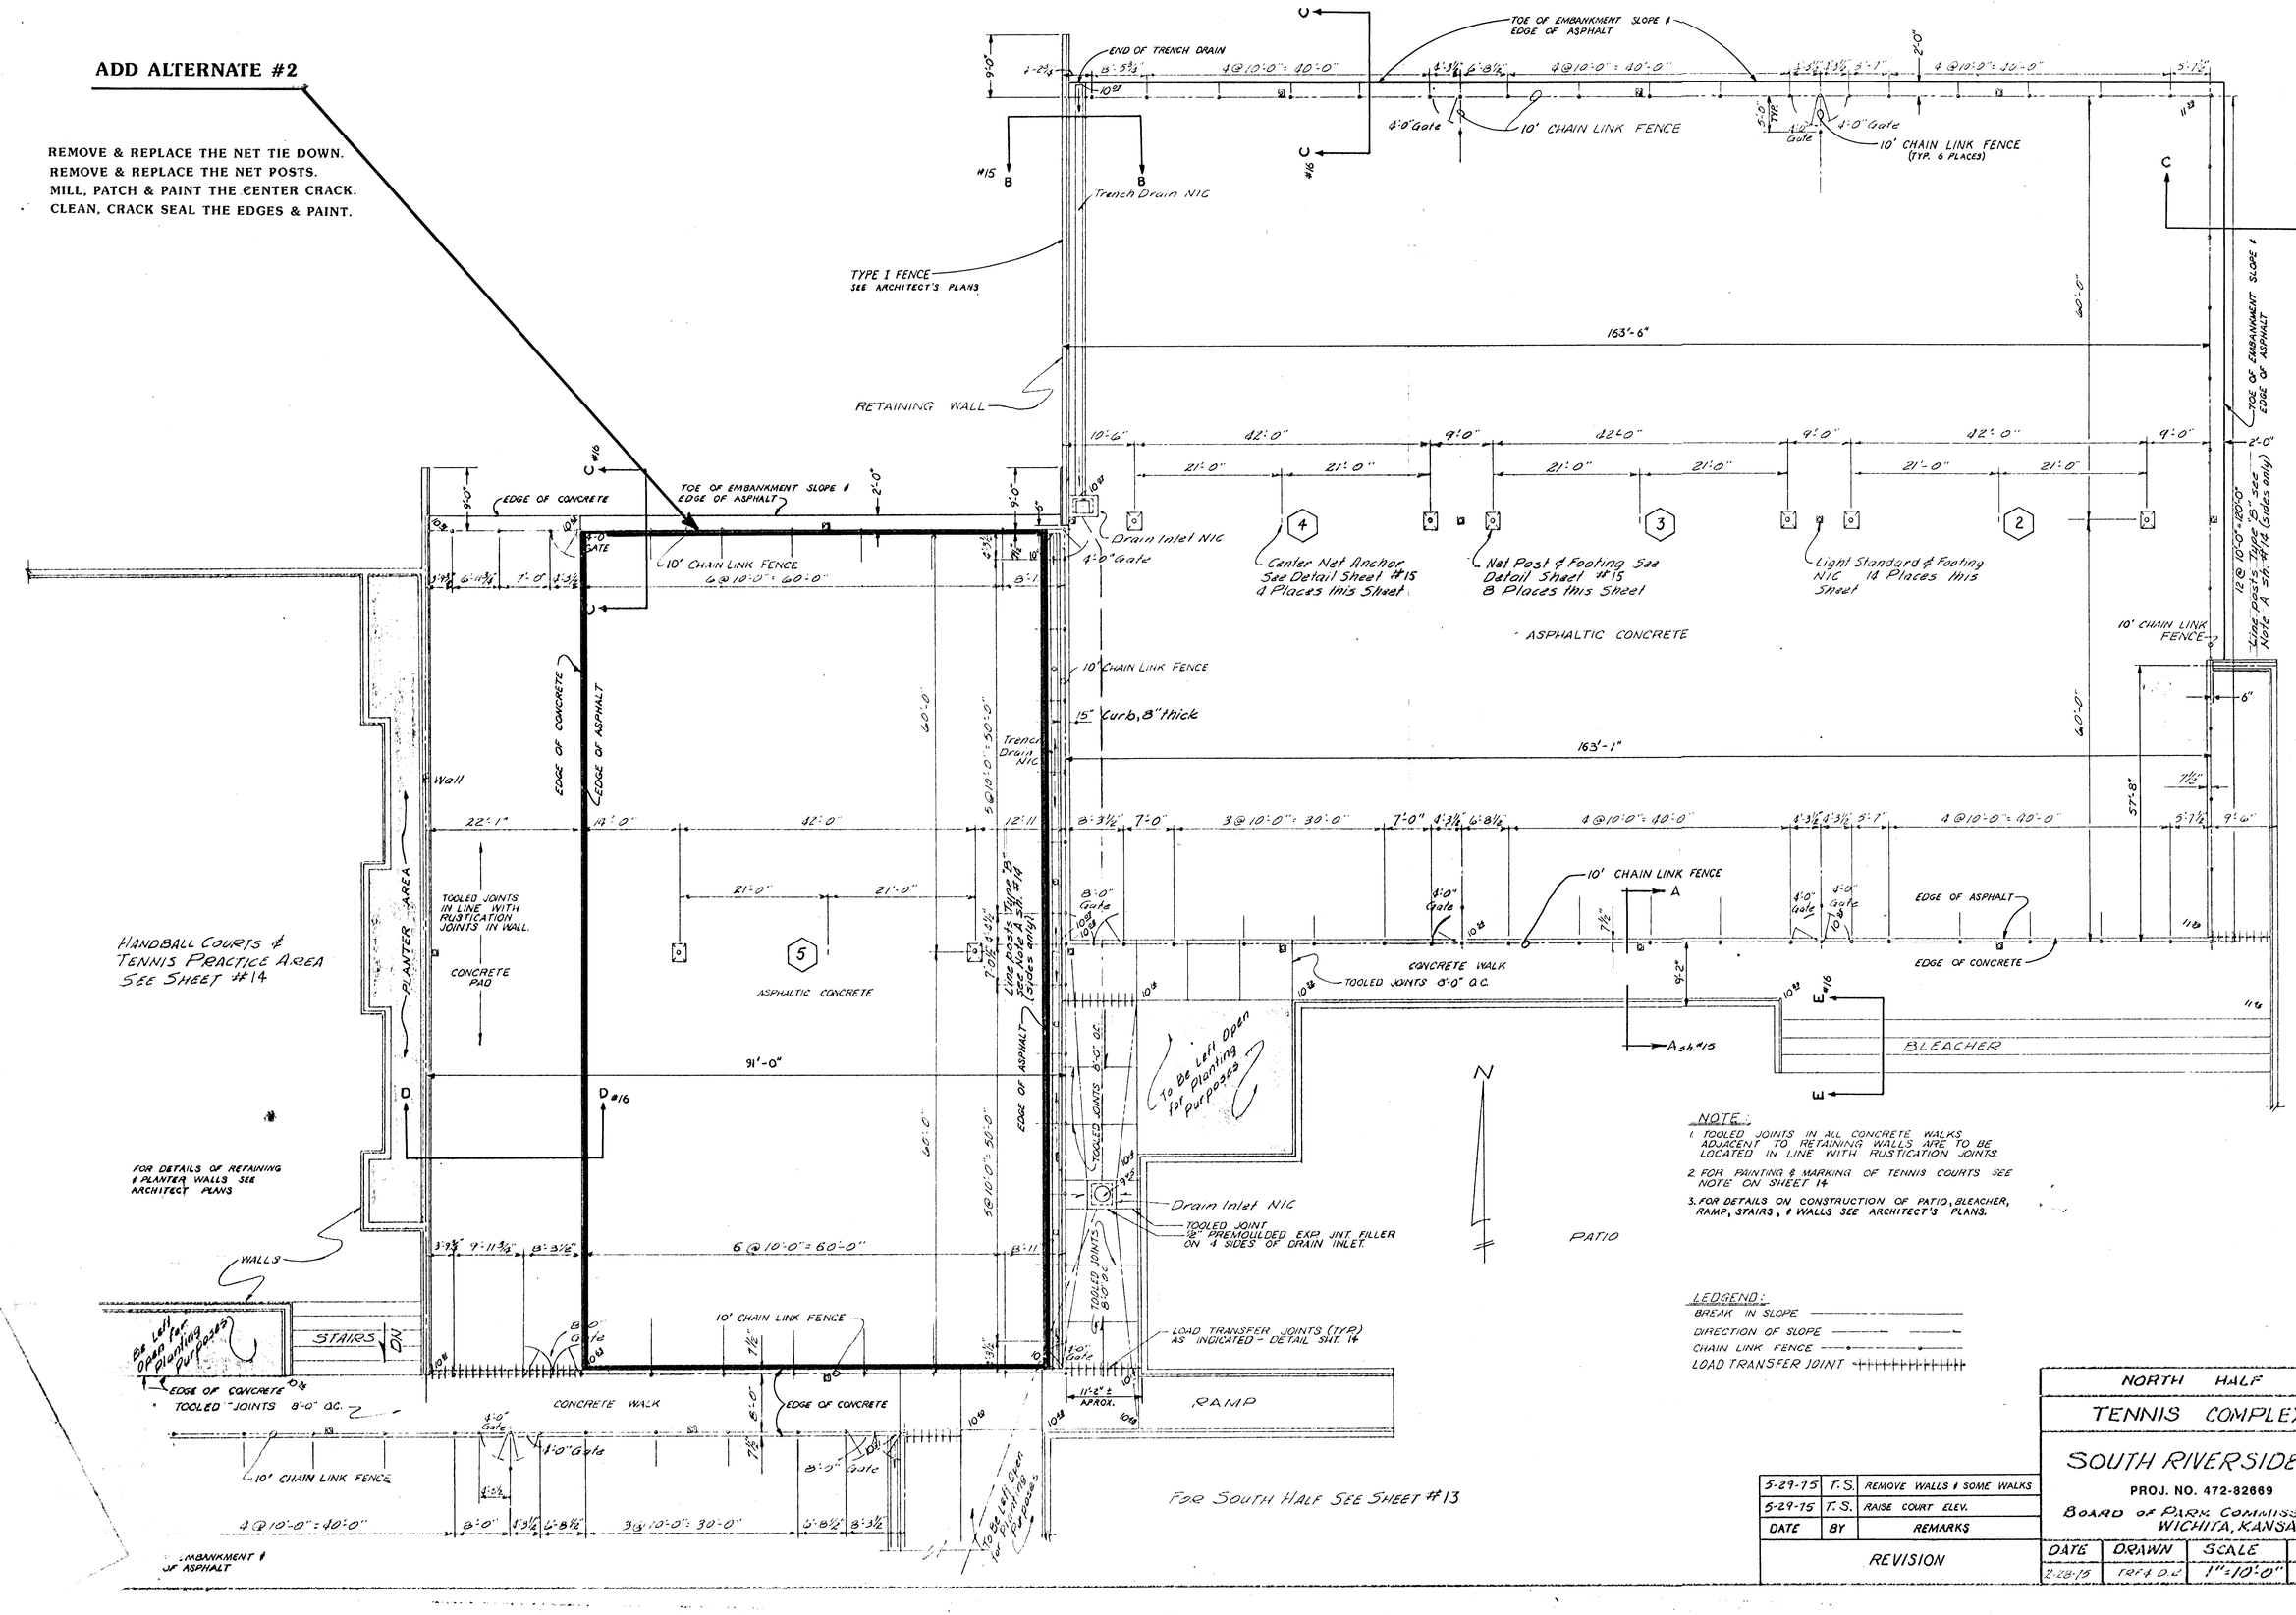

NOTE:

1. TOOLED JOINTS IN ALL CONCRETE WALKS ADJACENT TO RETAINING WALLS ARE TO BE LOCATED IN LINE WITH RUSTICATION JOINTS.
2. FOR PAINTING & MARKING OF TENNIS COURTS SEE NOTE ON SHEET 14
3. FOR DETAILS ON CONSTRUCTION OF PATIO, BLEACHER, RAMP, STAIRS, & WALLS SEE ARCHITECT'S PLANS.

LEGEND:

BREAK IN SLOPE
DIRECTION OF SLOPE
CHAIN LINK FENCE
LOAD TRANSFER JOINT

DATE	BY	REMARKS
5-29-15	T.S.	REMOVE WALLS & SOME WALKS
5-29-15	T.S.	RAISE COURT ELEV.

REVISION

NORTH HALF

TENNIS COMPLEX

SOUTH RIVERSIDE PARK

PROJ. NO. 472-82669

BOARD OF PARK COMMISSIONERS
WICHITA, KANSAS

DATE	DRAWN	SCALE	SHEET
2-28-13	TRF & D.L.	1"=10'-0"	4 of 6