

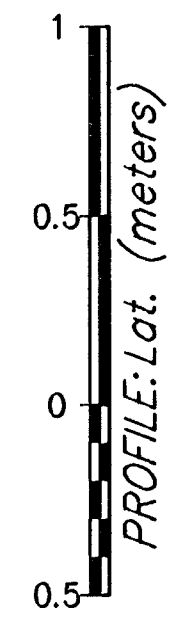
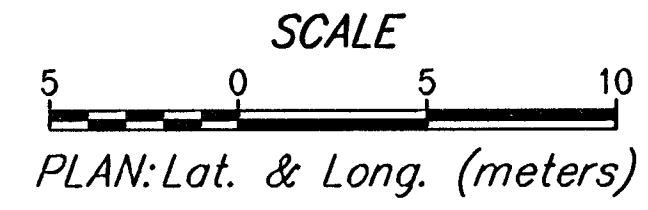
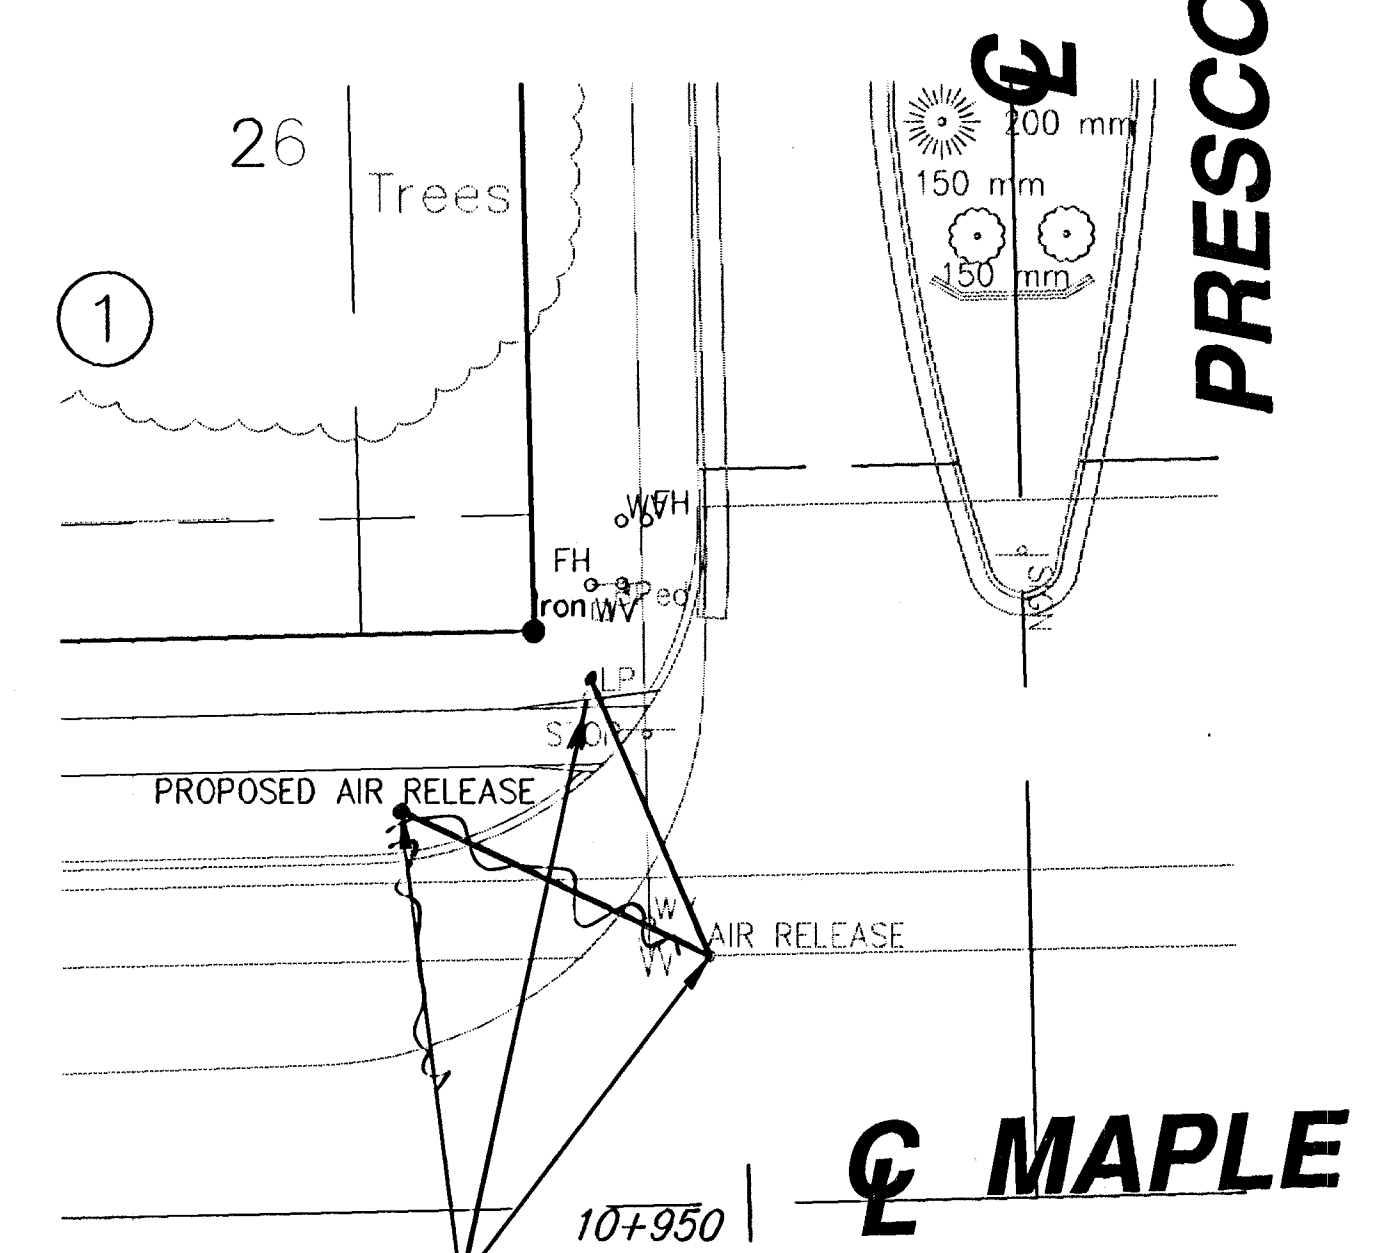
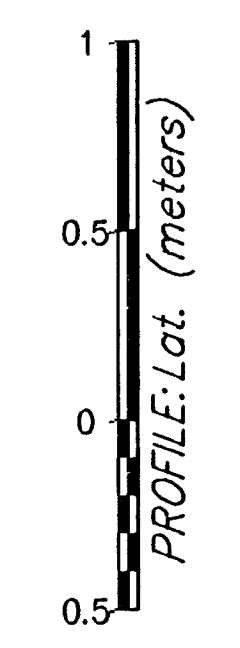
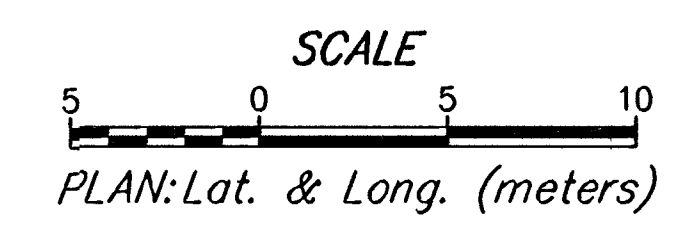
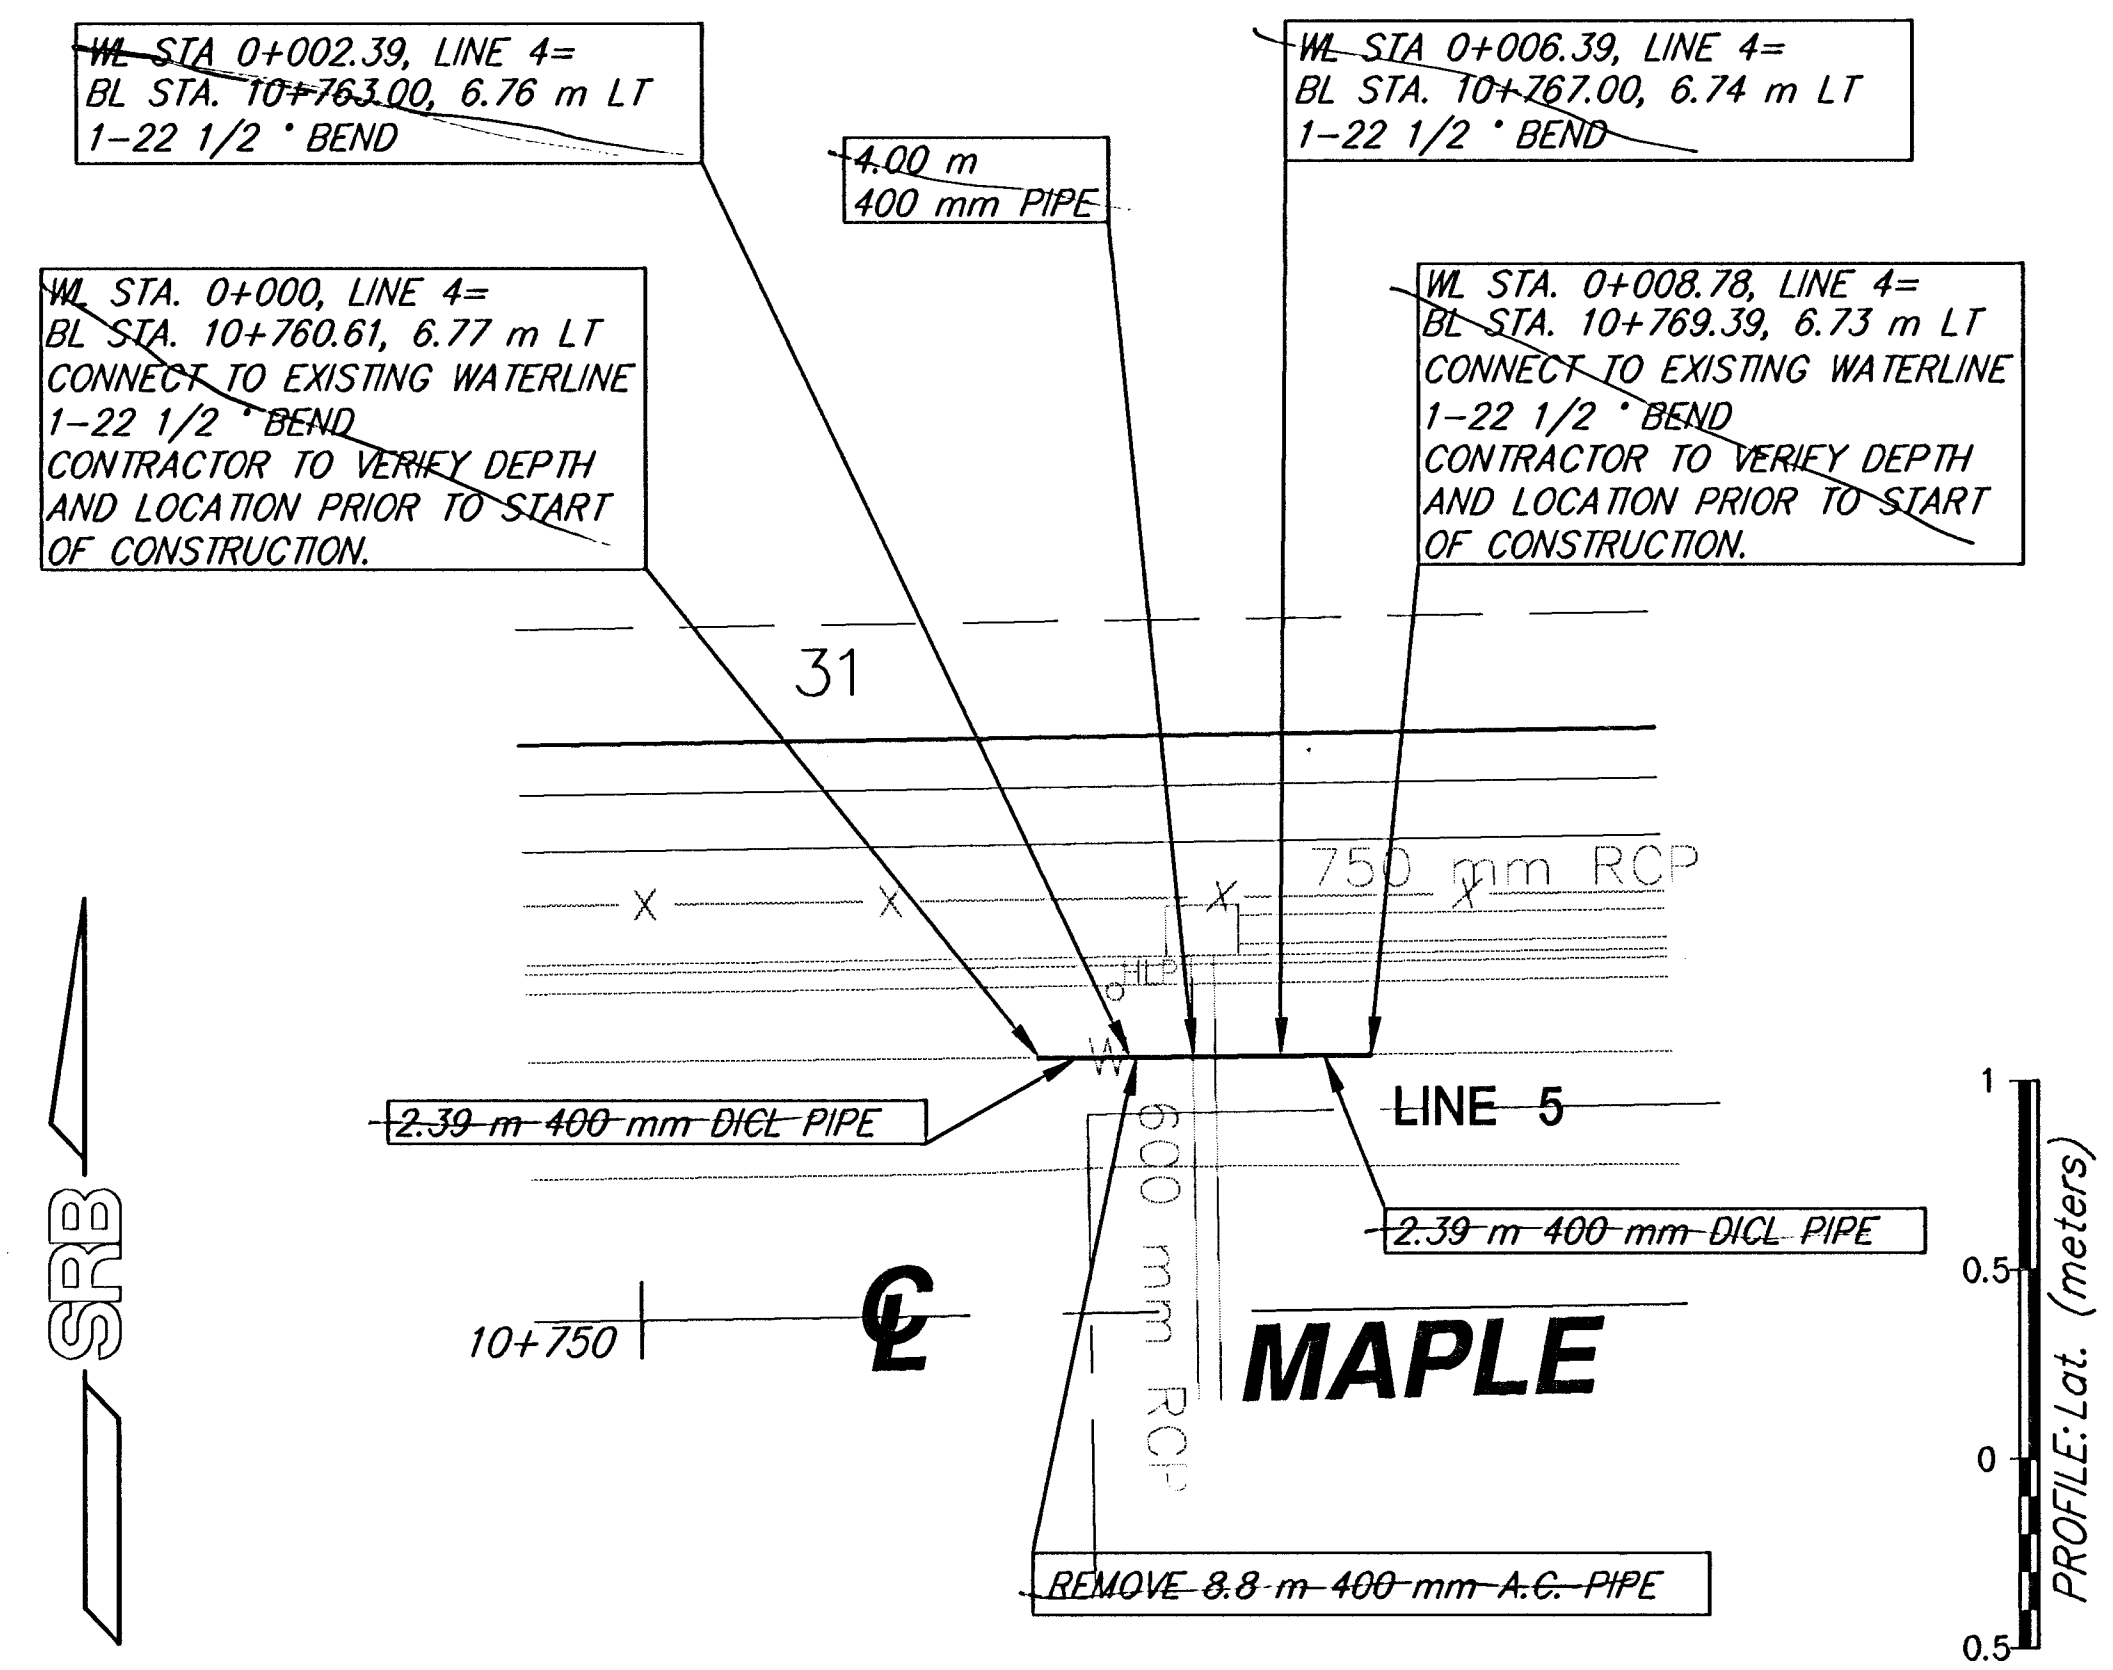


DATE	
BY	
REFERENCES NOTED	
REFERENCES CHECKED	

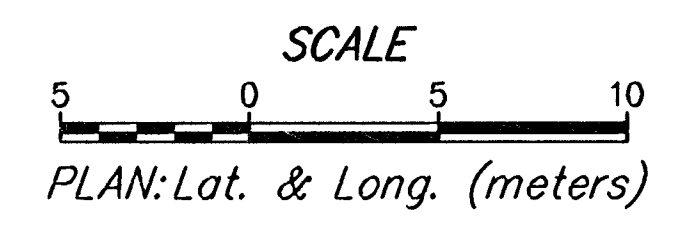

CLOW FH #5982
47 1/2' N + 29 1/2' E of Sheffield & Maple
6" CLOW V #18907
4' W FH
tapping sleeve
5' W FH


WL STA. 0+000, FH=
BL STA. 10+706.94, 14.43 m LT
ROTATE TEE 180° TO THE EAST
INSTALL 1-FH ASSEMBLY
LENGTH=1.37 m
BURY LINE ELEVATION=406.73
VALVE BOX ELEVATION=406.70
RETURN SALVAGED FH TO THE
CITY OF WICHITA WATER DEPT.

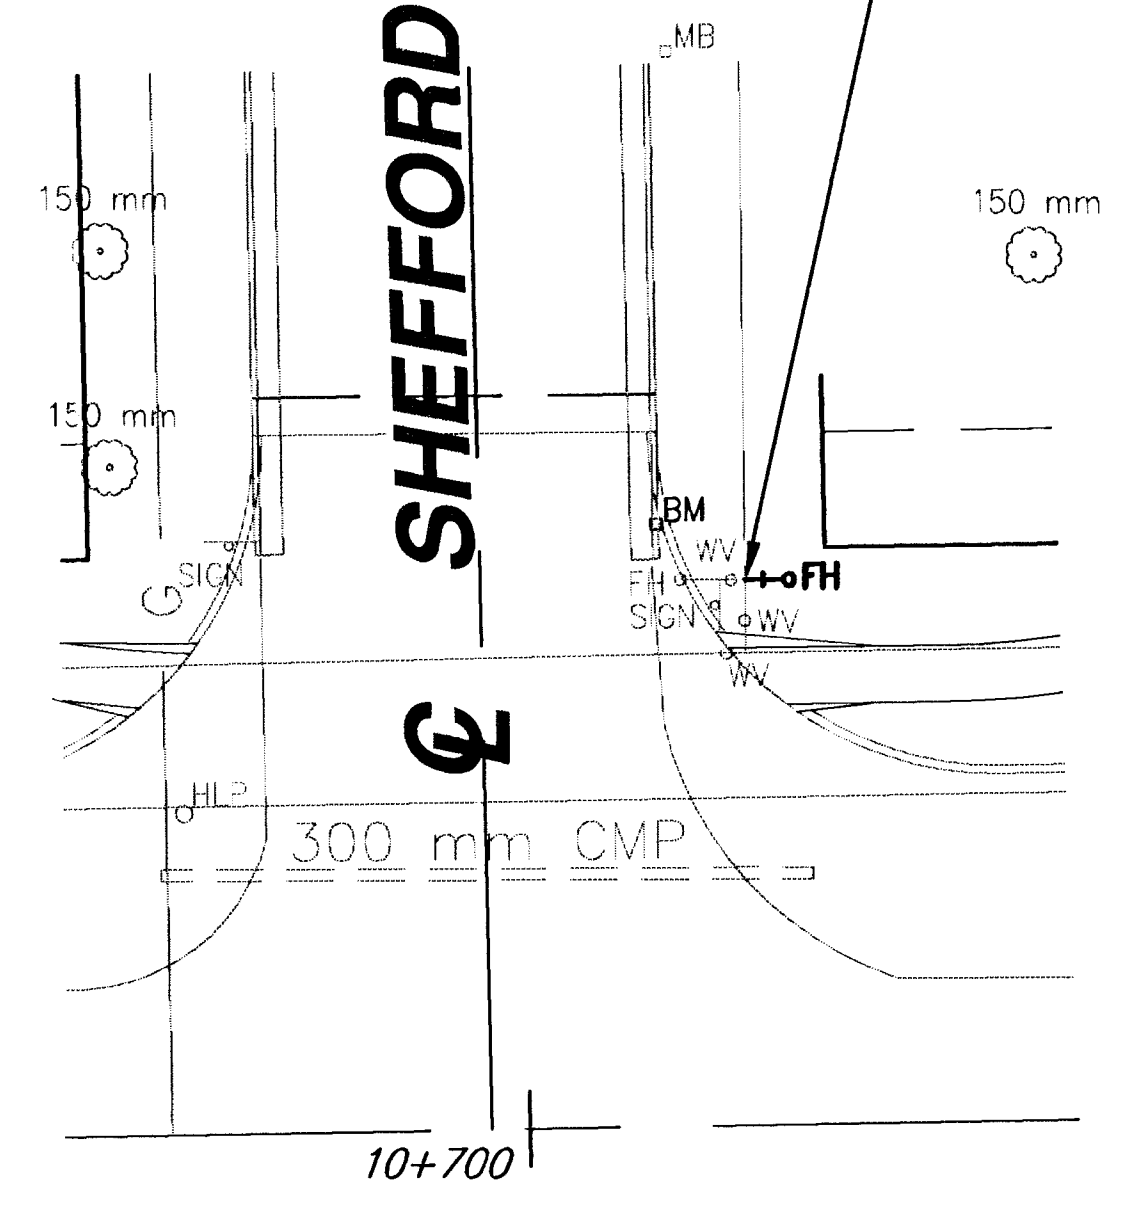

WL STA. 1+000.00
BL STA. 10+949.09, 6.56 m LT=
MOVE EXISTING AIR RELEASE TO
BL STA. 10+941.00, 10.55 LT=
WL STA. 0+990.98
TOP LID ELEVATION=406.62

14 1/2' S + 4 1/2' W FH #6763
1" cap 39 1/2' S + 14' E FH #6763
AR V #18249

*** UNLESS OTHERWISE NOTED, ALL ELEVATIONS SHOWN ARE TO TOP OF PIPE ***

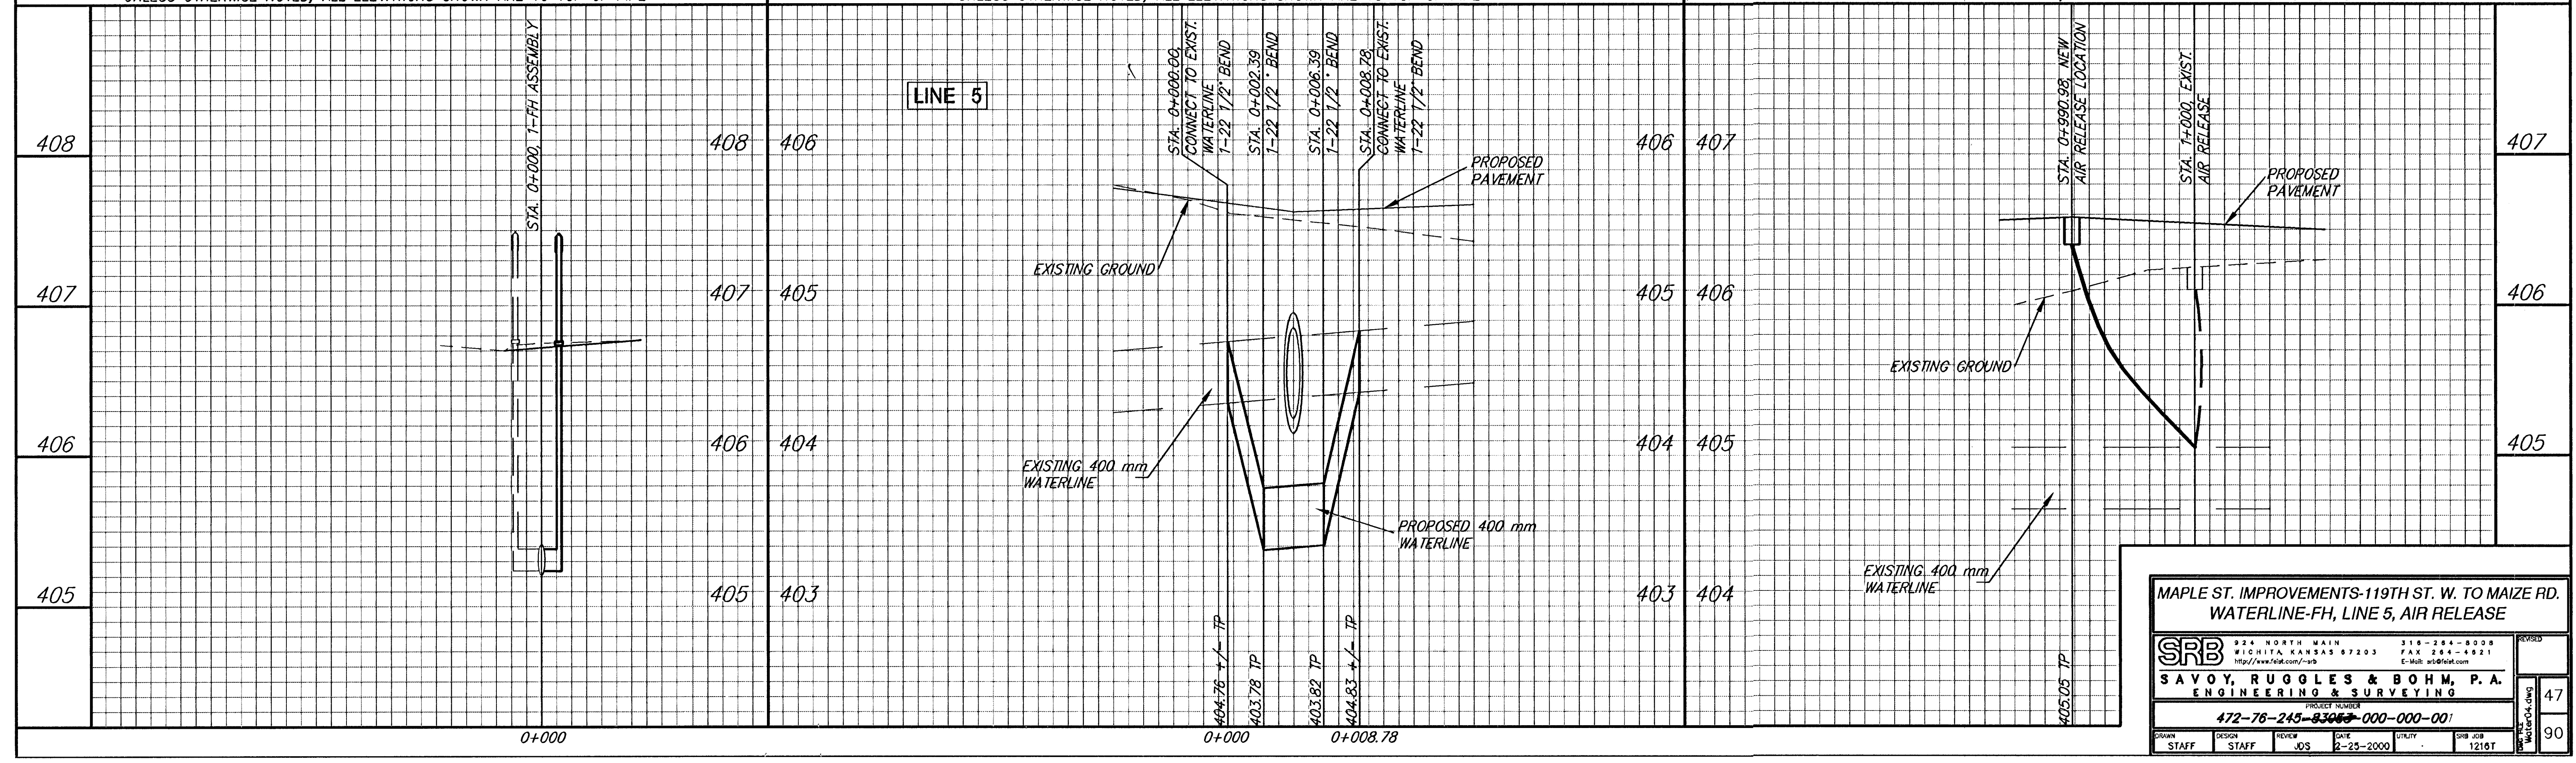

SRB

SAVOY, RUOLES & BOHM, P.A.
ENGINEERING & SURVEYING

472-76-245-8305-000-000-001

DESIGN STAFF

24 NORTH MAIN
WICHITA, KANSAS 67203


2-25-2000

UTILITY

SRB JOB 12167

PROJECT NUMBER

47

90