


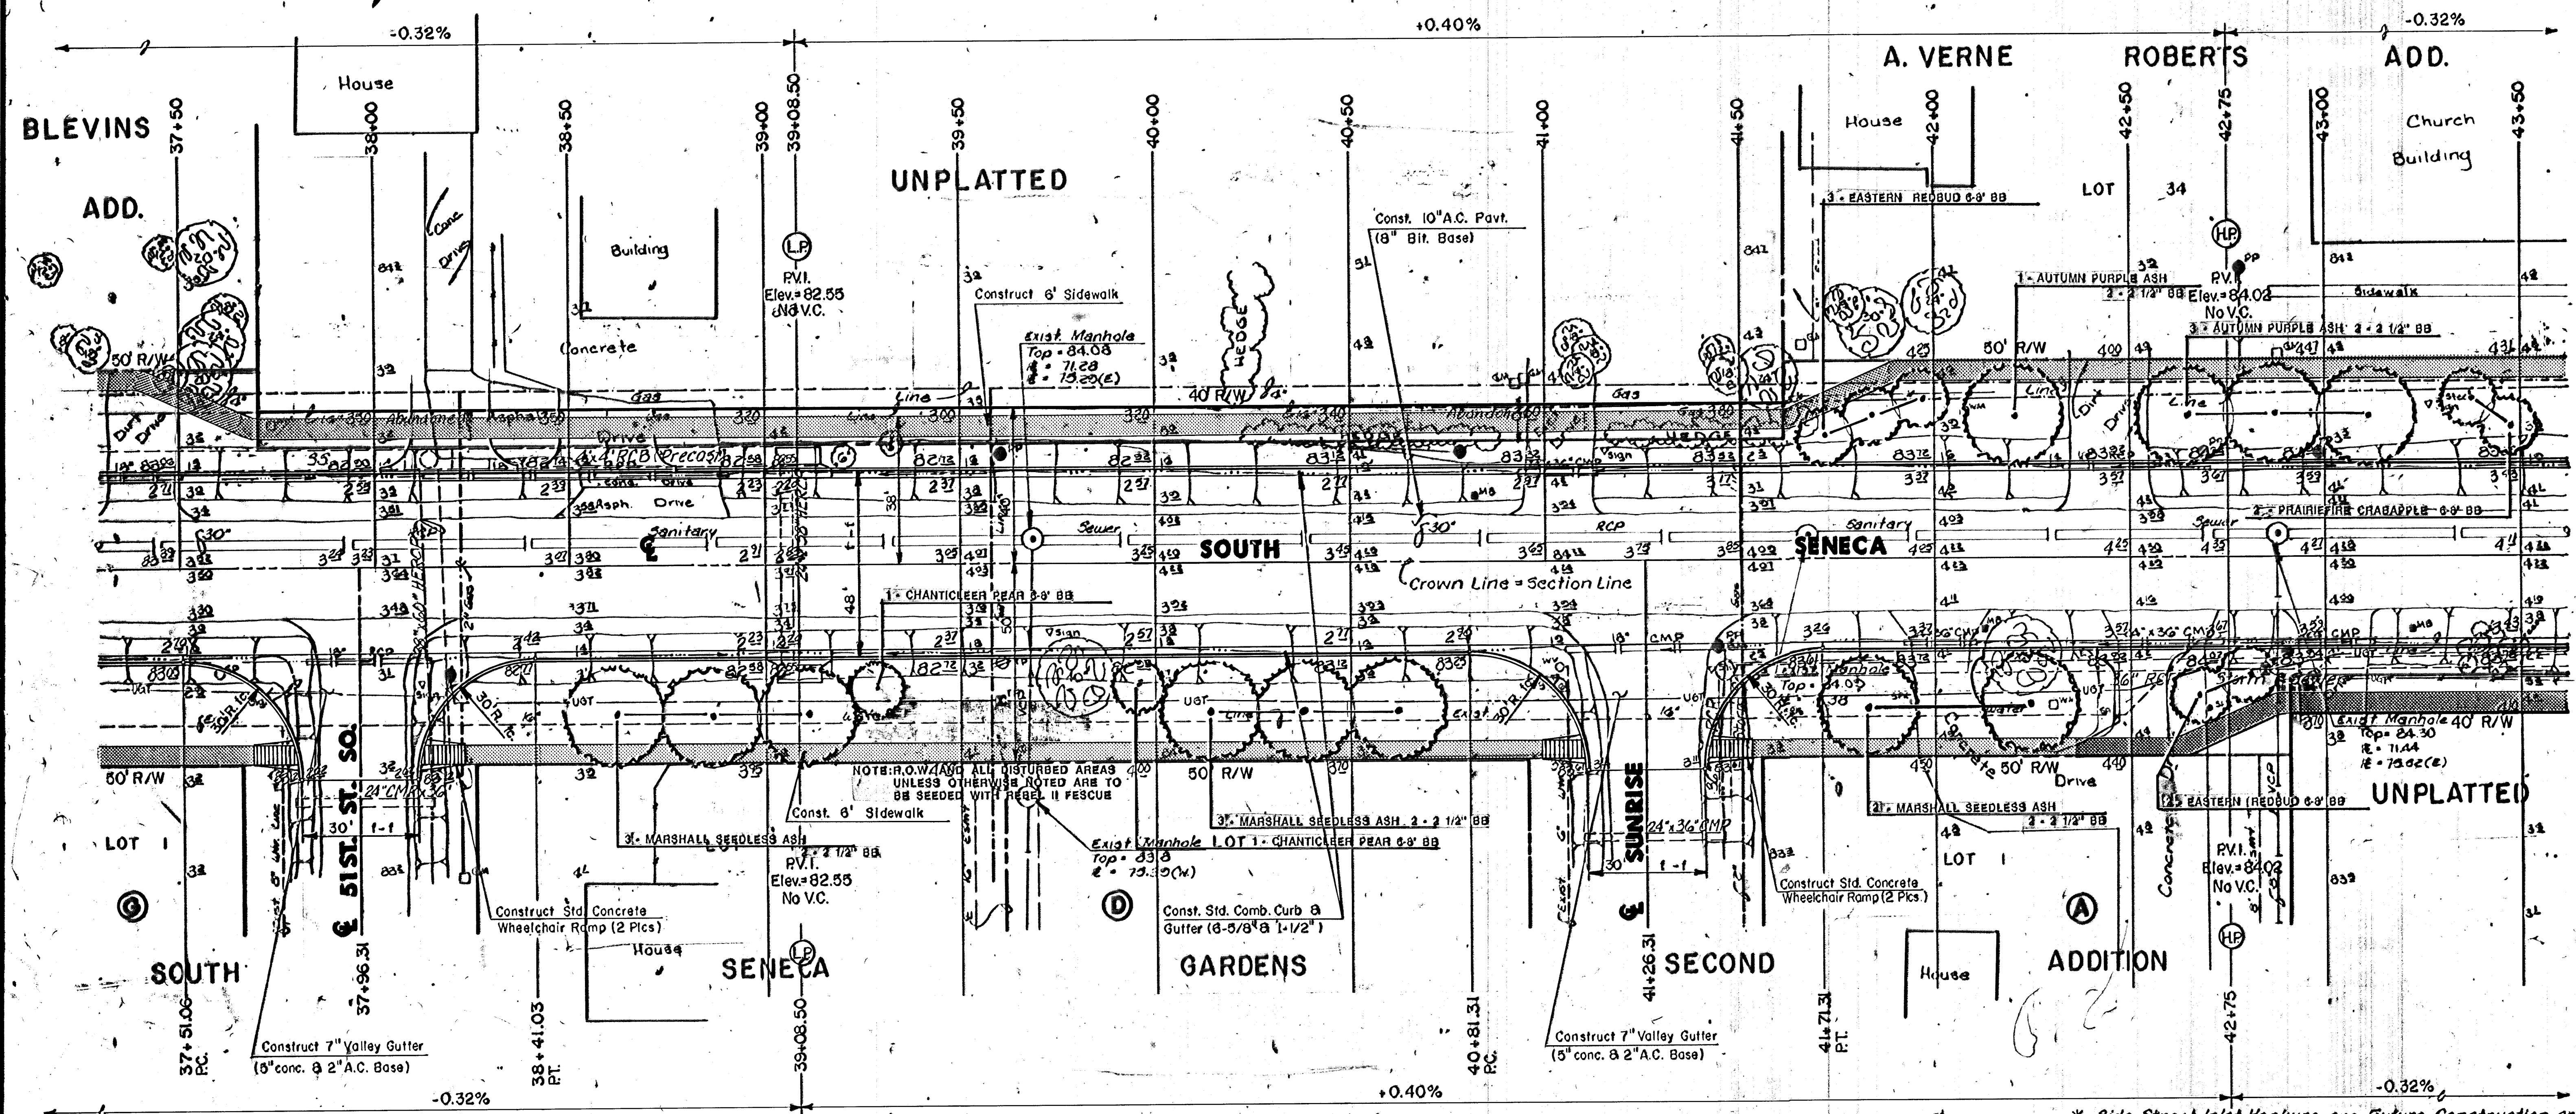

* Side Street Inlet Hookups are Future Construction and not a part of this project unless specifically stated.

	SOUTH SENECA IMPROVEMENTS		Design DCH Drawn by DLM Checked by Date OCT. 1989 108 no
	PAVING PLAN		Sheet 7
	55TH ST. SO. TO 48TH ST. SO.		MID-KANSAS ENGINEERING CONSULTANTS PA 3500 NORTH ROCK ROAD BUILDING #800 WICHITA, KANSAS 67226 636-6666