


SOUTH SENECA 48TH. TO MAC ARTHUR
IMPROVEMENTS
PAVING CROSS SECTIONS

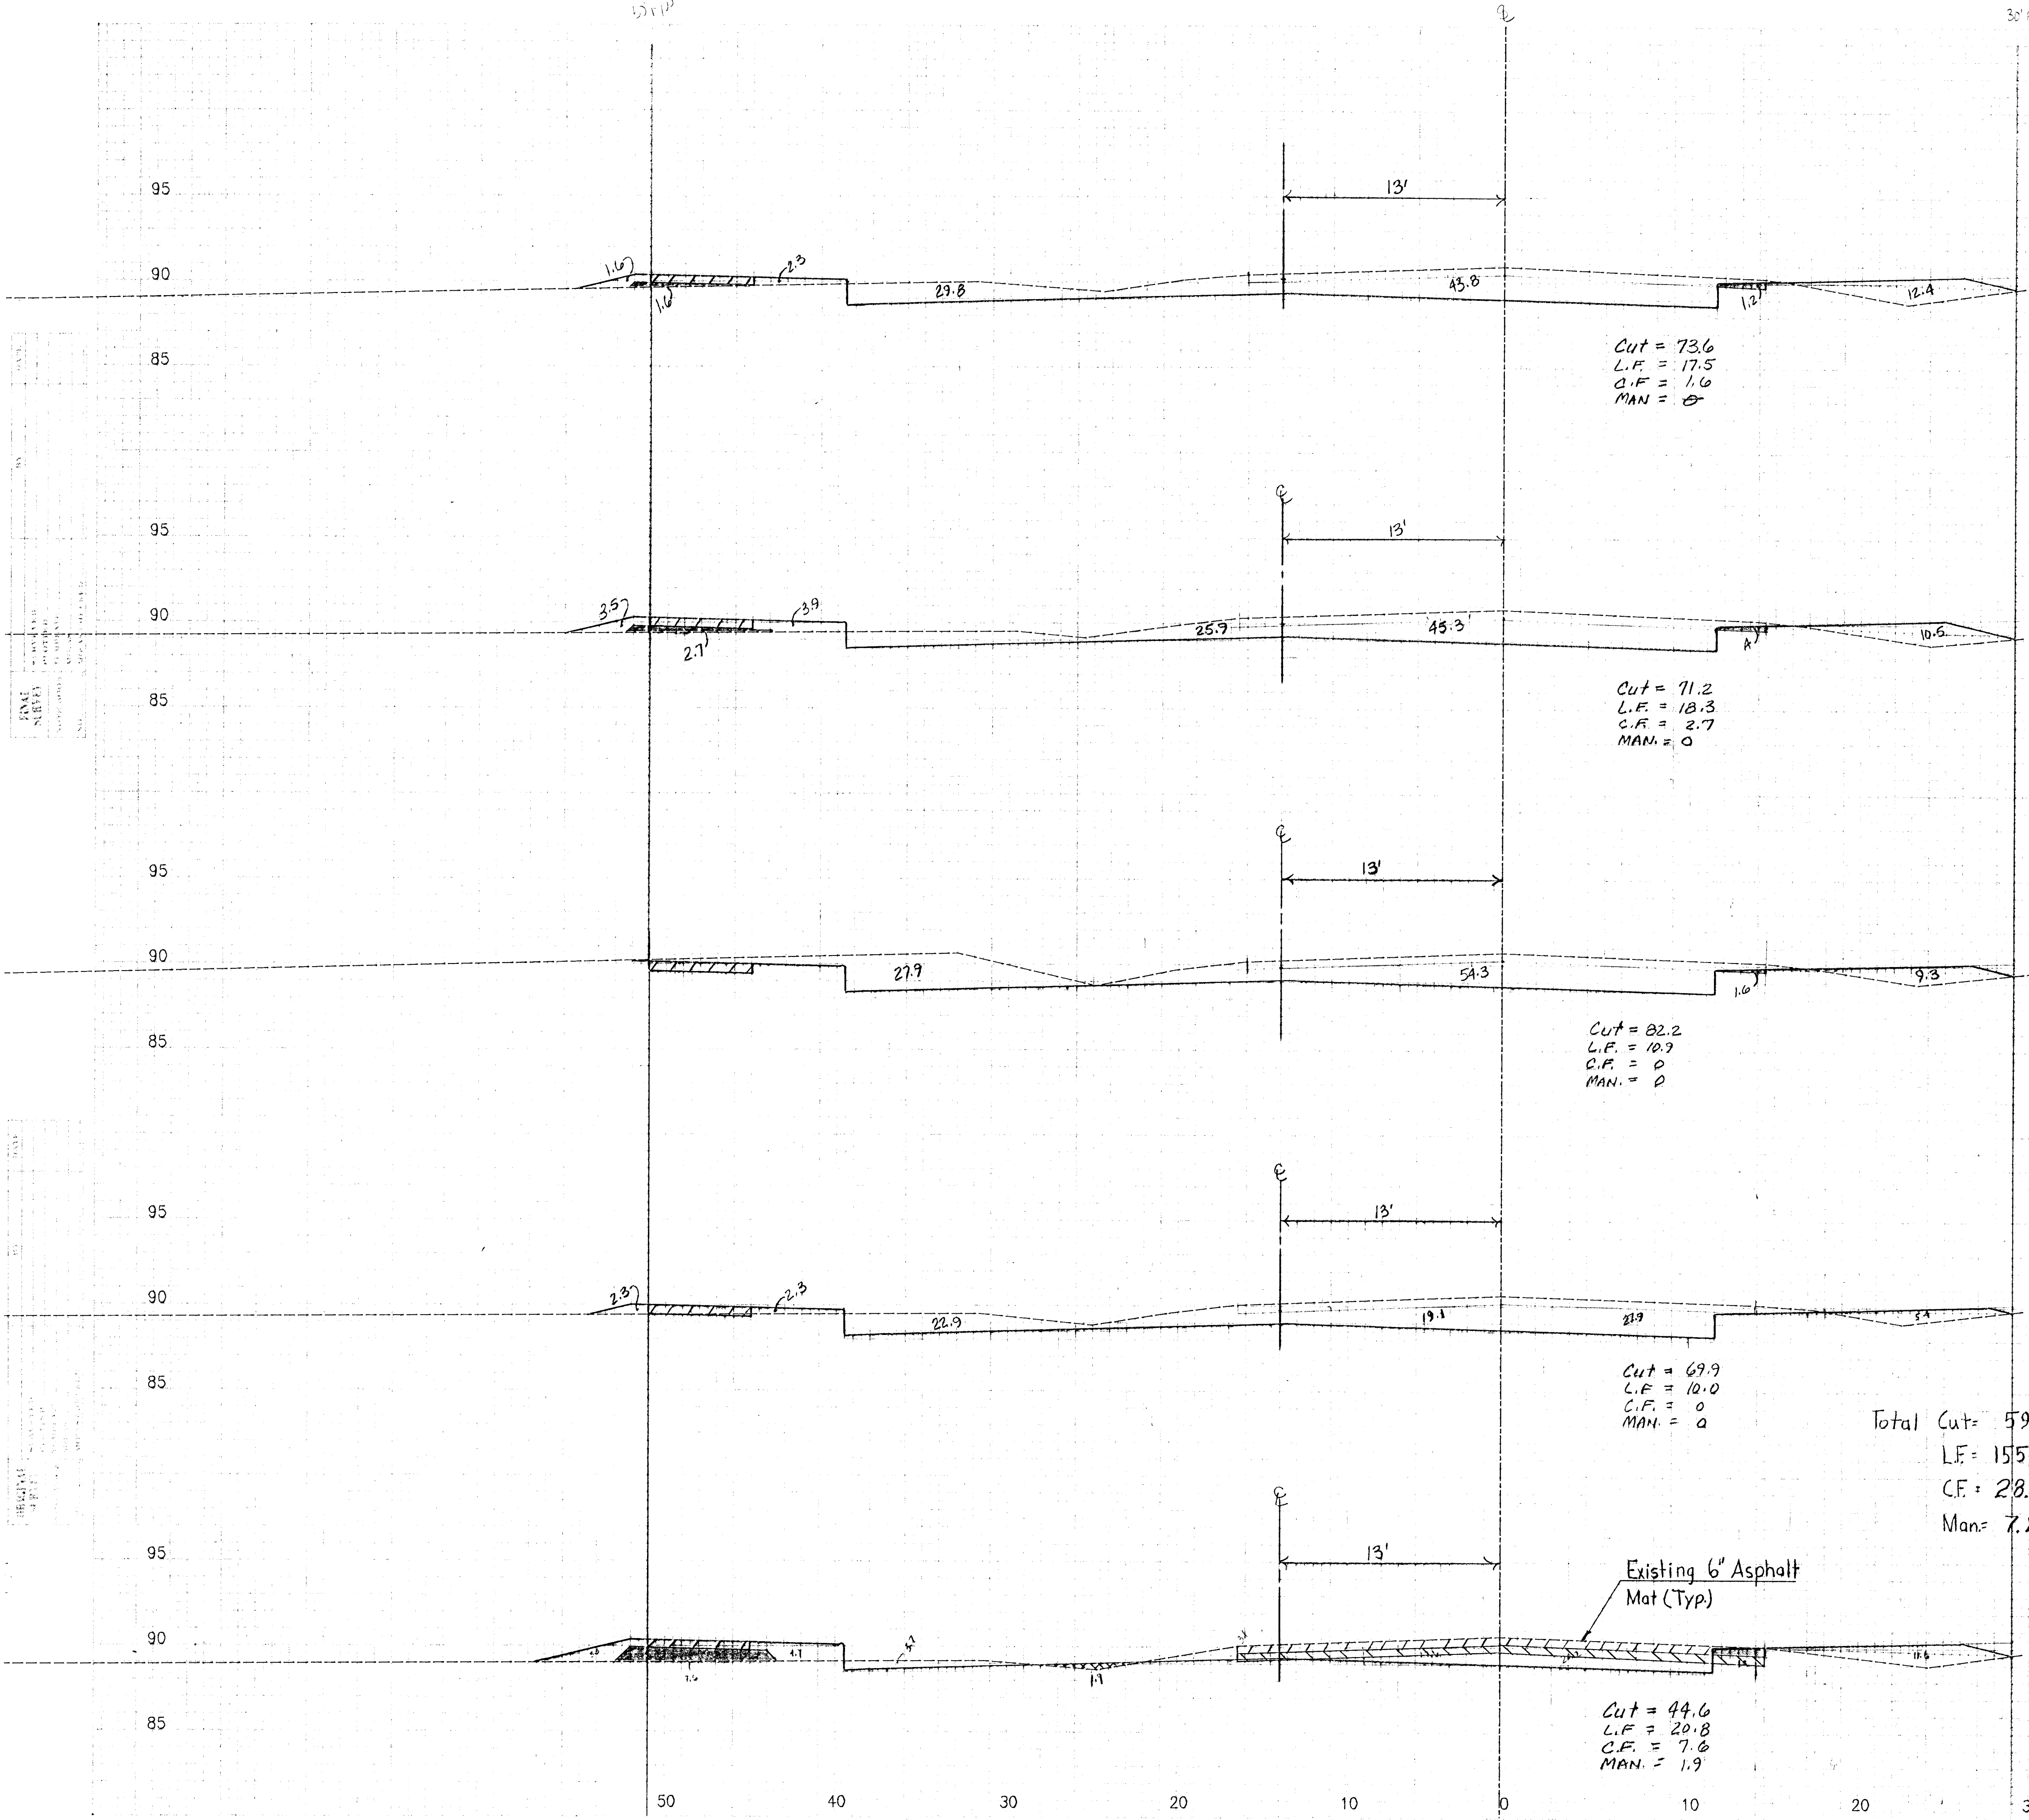

Cut = 134.1 cy
 LF = 33.1 cy
 CF = 4.0 cy

Sta. 106+00.00

Cut = 142.0 cy
 LF = 27.0 cy
 CF = 2.5 cy

Sta. 105+50.00

Cut = 140.8 cy
 LF = 19.4 cy

Sta. 105+00.00

Cut = 106.0 cy
 LF = 28.5 cy
 CF = 7.0 cy
 Man = 1.8 cy

Sta. 104+50.00

Cut = 75.7 cy
 LF = 47.2 cy
 CF = 14.9 cy
 Man = 5.4 cy

Sta. 104+00.00

Sta. 104+00.00 to Sta. 106+00.00

SOUTH SENECA