


SOUTH SENECA 48TH. TO MAC ARTHUR  
IMPROVEMENTS  
PAVING CROSS SECTIONS

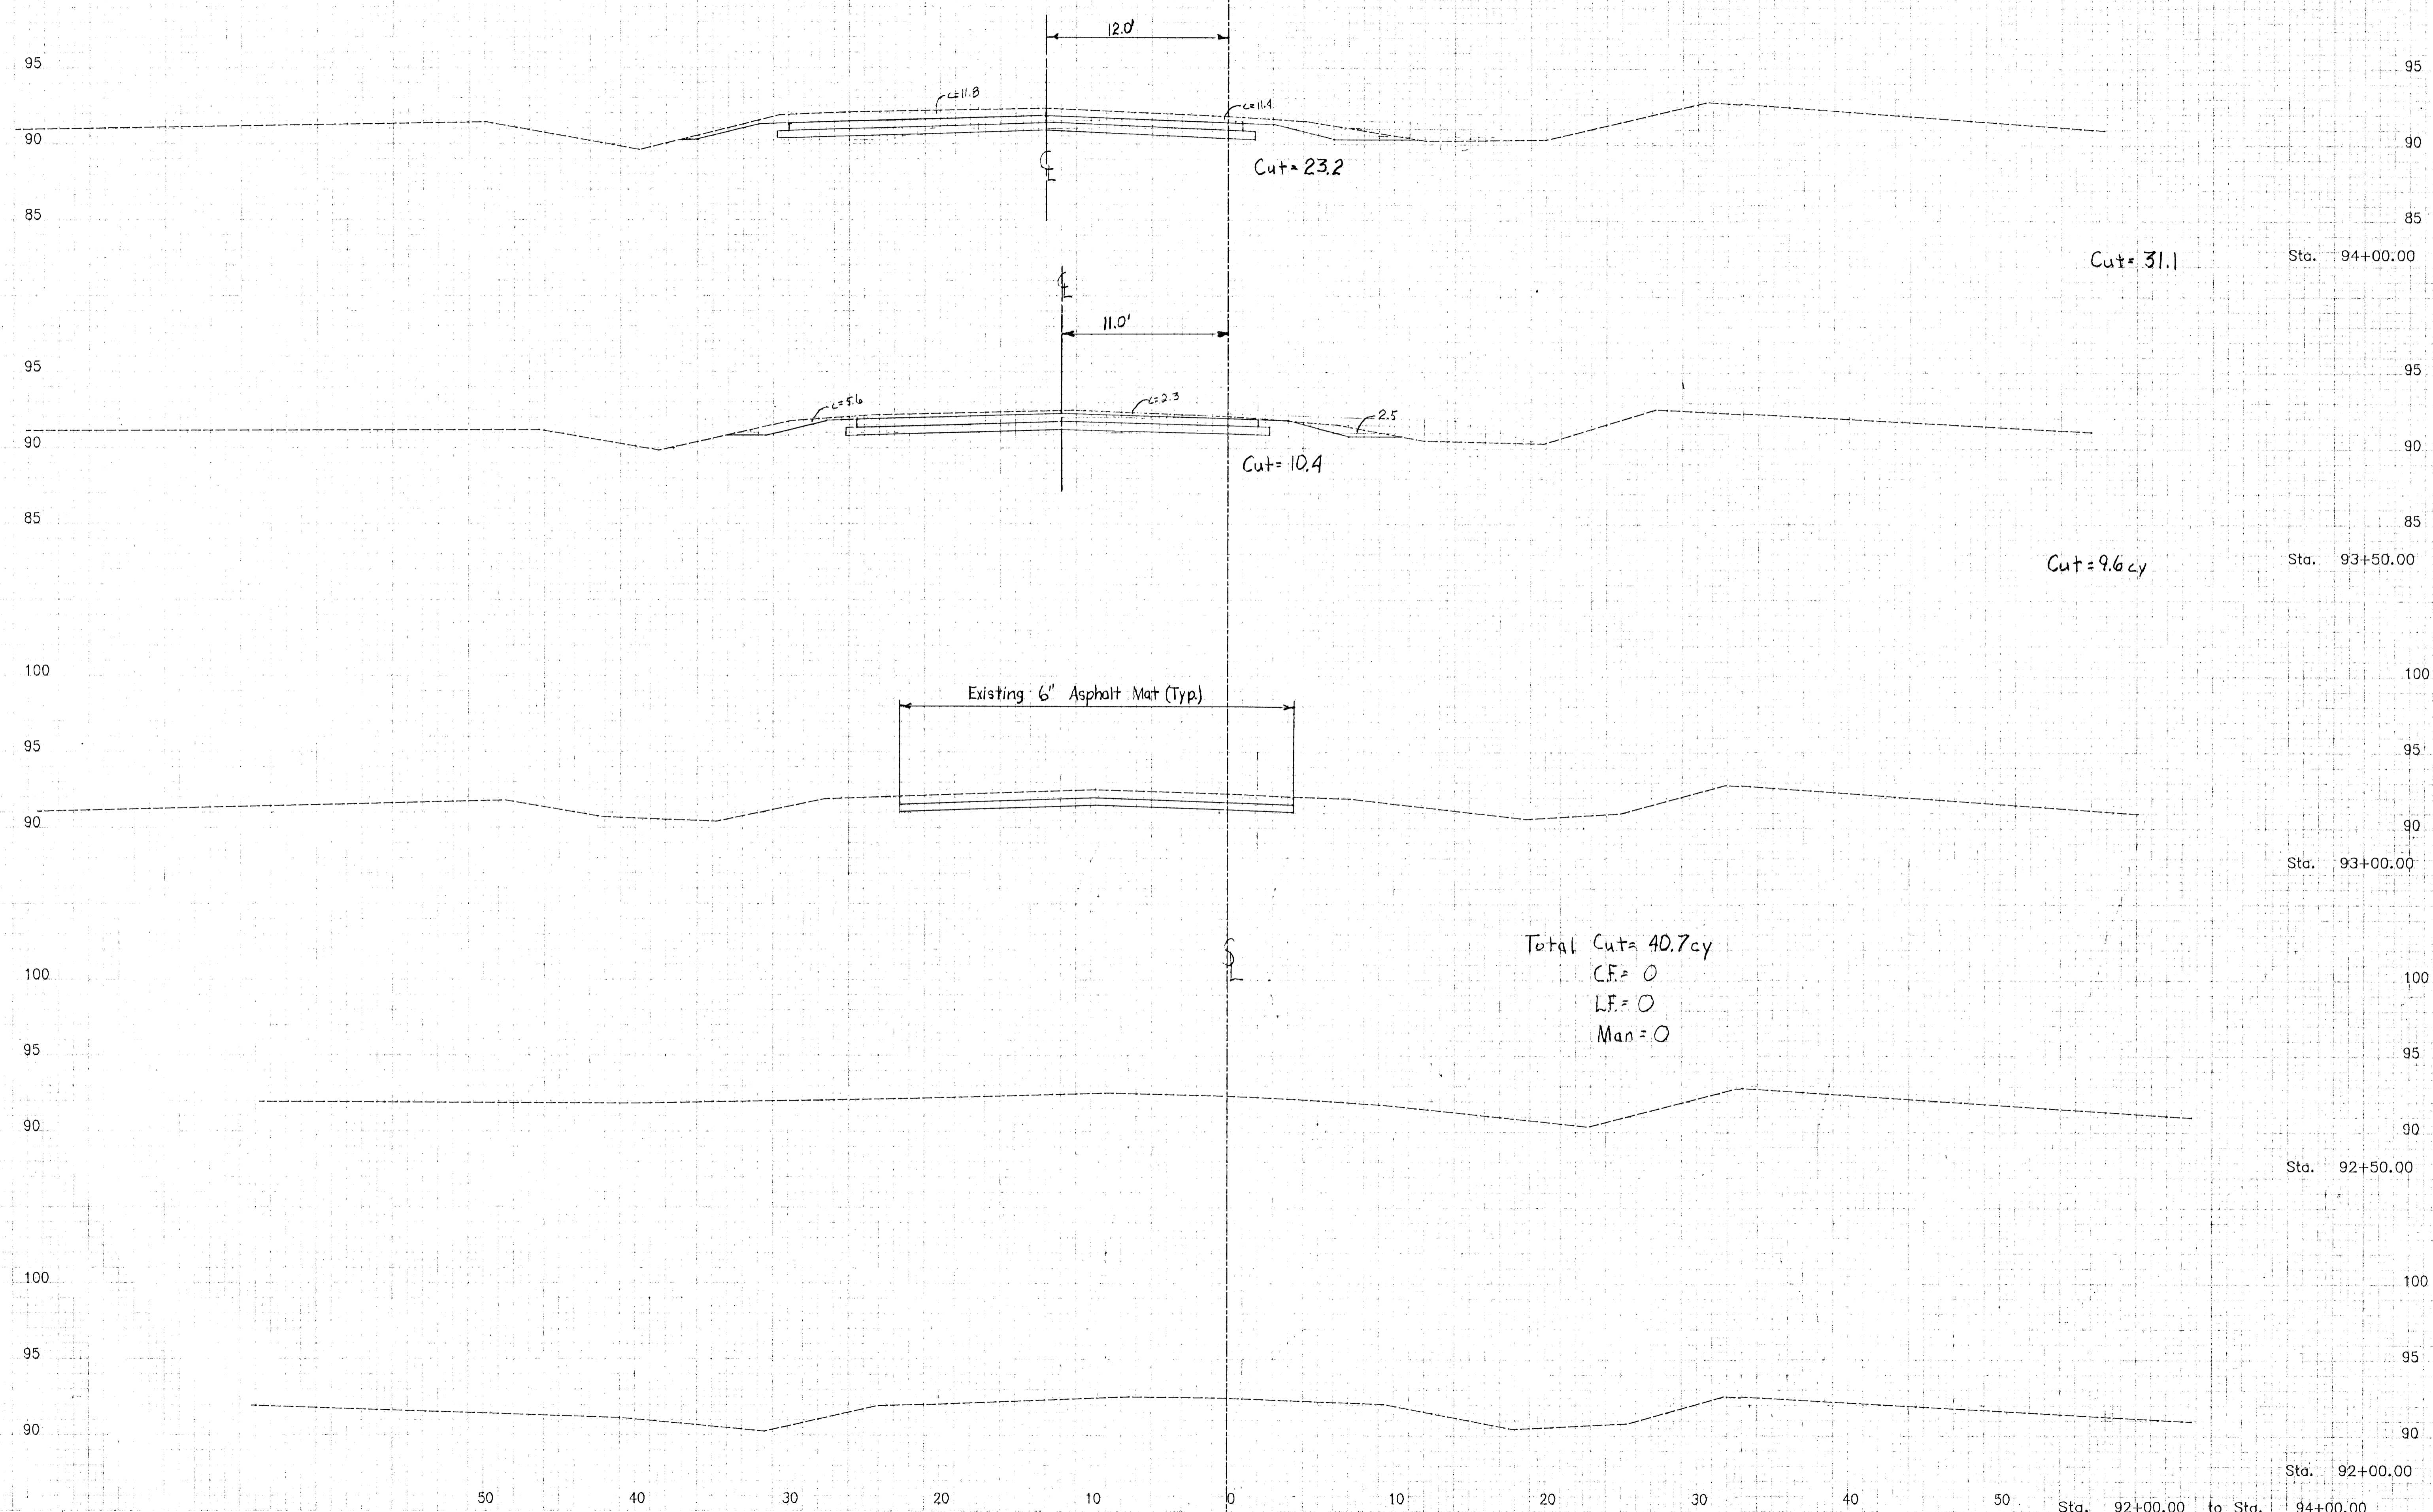

Cut = 31.1

Sta. 94+00.00

Cut = 23.2

12.0'

L=11.8

L=11.4

Cut = 9.6 cy

Sta. 93+50.00

Cut = 10.4

11.0'

L=5.6

L=2.3

2.5

Existing 6' Asphalt Mat (Typ.)

Sta. 93+00.00

Total Cut = 40.7 cy  
C.F. = 0  
L.F. = 0  
Man = 0

Sta. 92+50.00

Sta. 92+00.00

Sta. 92+00.00 to Sta. 94+00.00

MAC ARTHUR WEST OF SENECA