


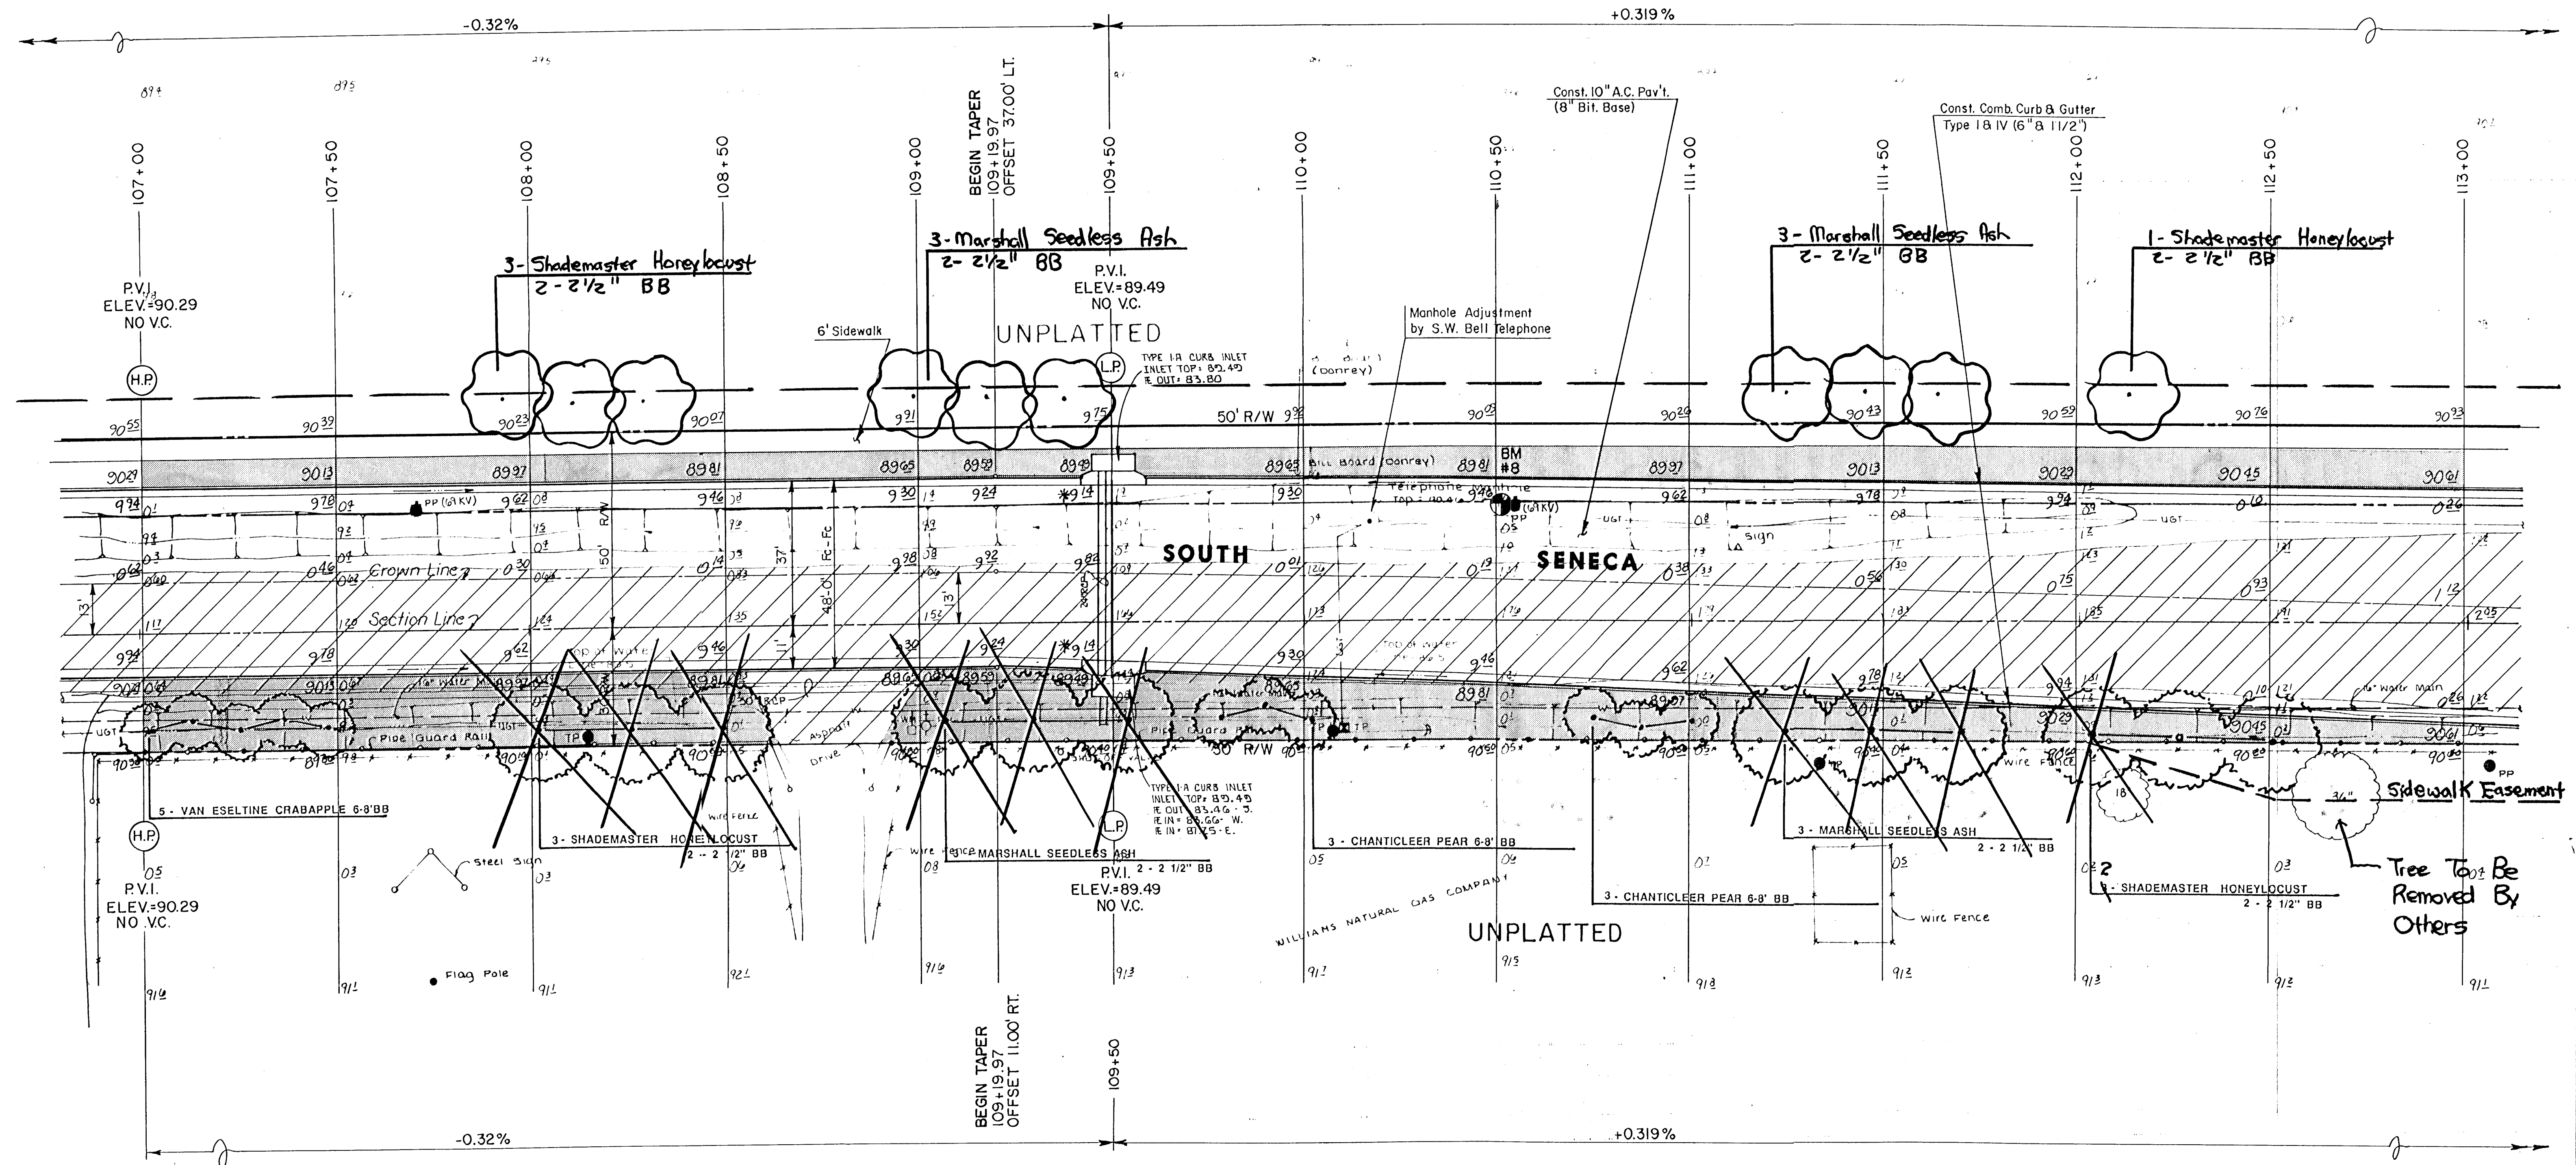

*For 2" depression, Subtract 0.31' from H.E. (0.17' from gutter H.E.)

	SOUTH SENECA IMPROVEMENTS	Design
	LANDSCAPE PLAN	Drawn by EAF
		Checked by
	48TH ST. SO. TO MACARTHUR RD.	Date
MID-KANSAS ENGINEERING CONSULTANTS PA 3500 NORTH ROCK ROAD BUILDING #800 WICHITA, KANSAS 67226		Job no.
636-5566		Sheet 4 of 8

89-33-113E