
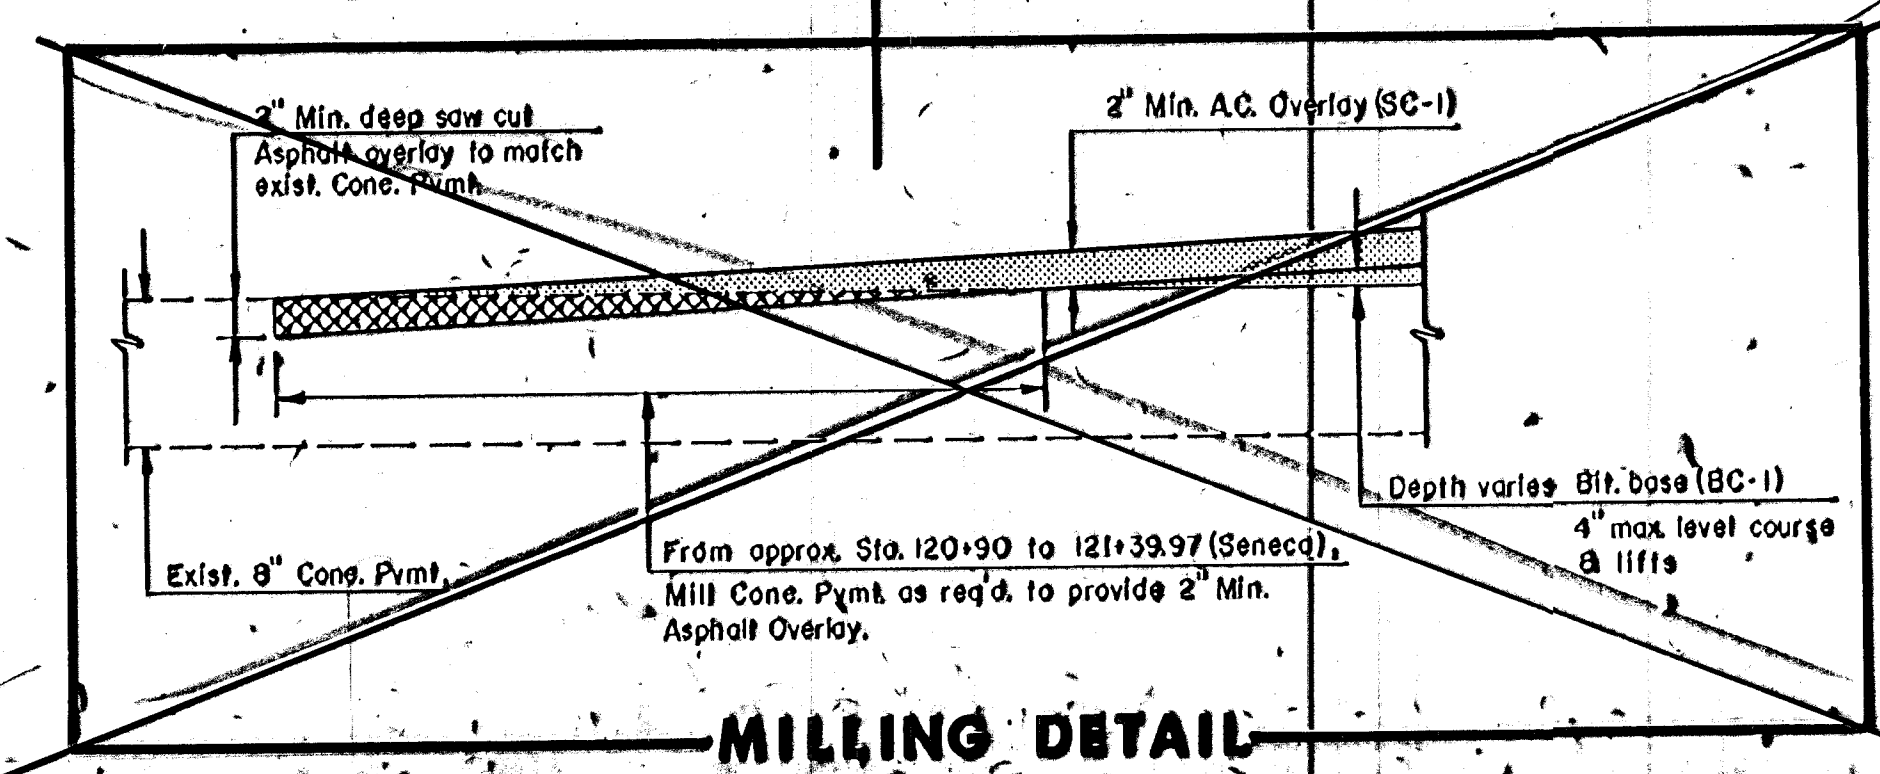
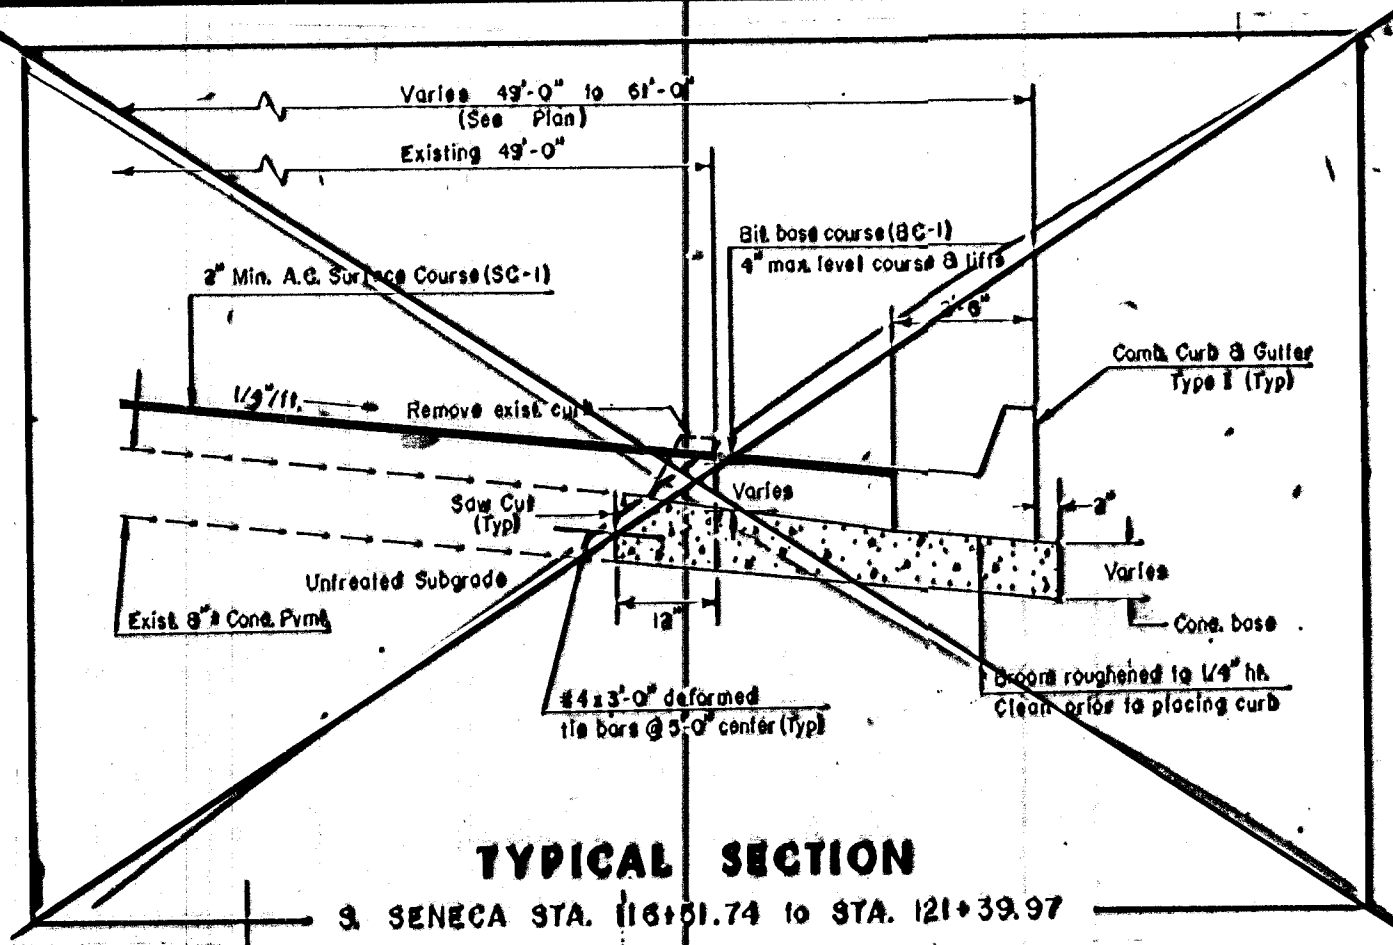


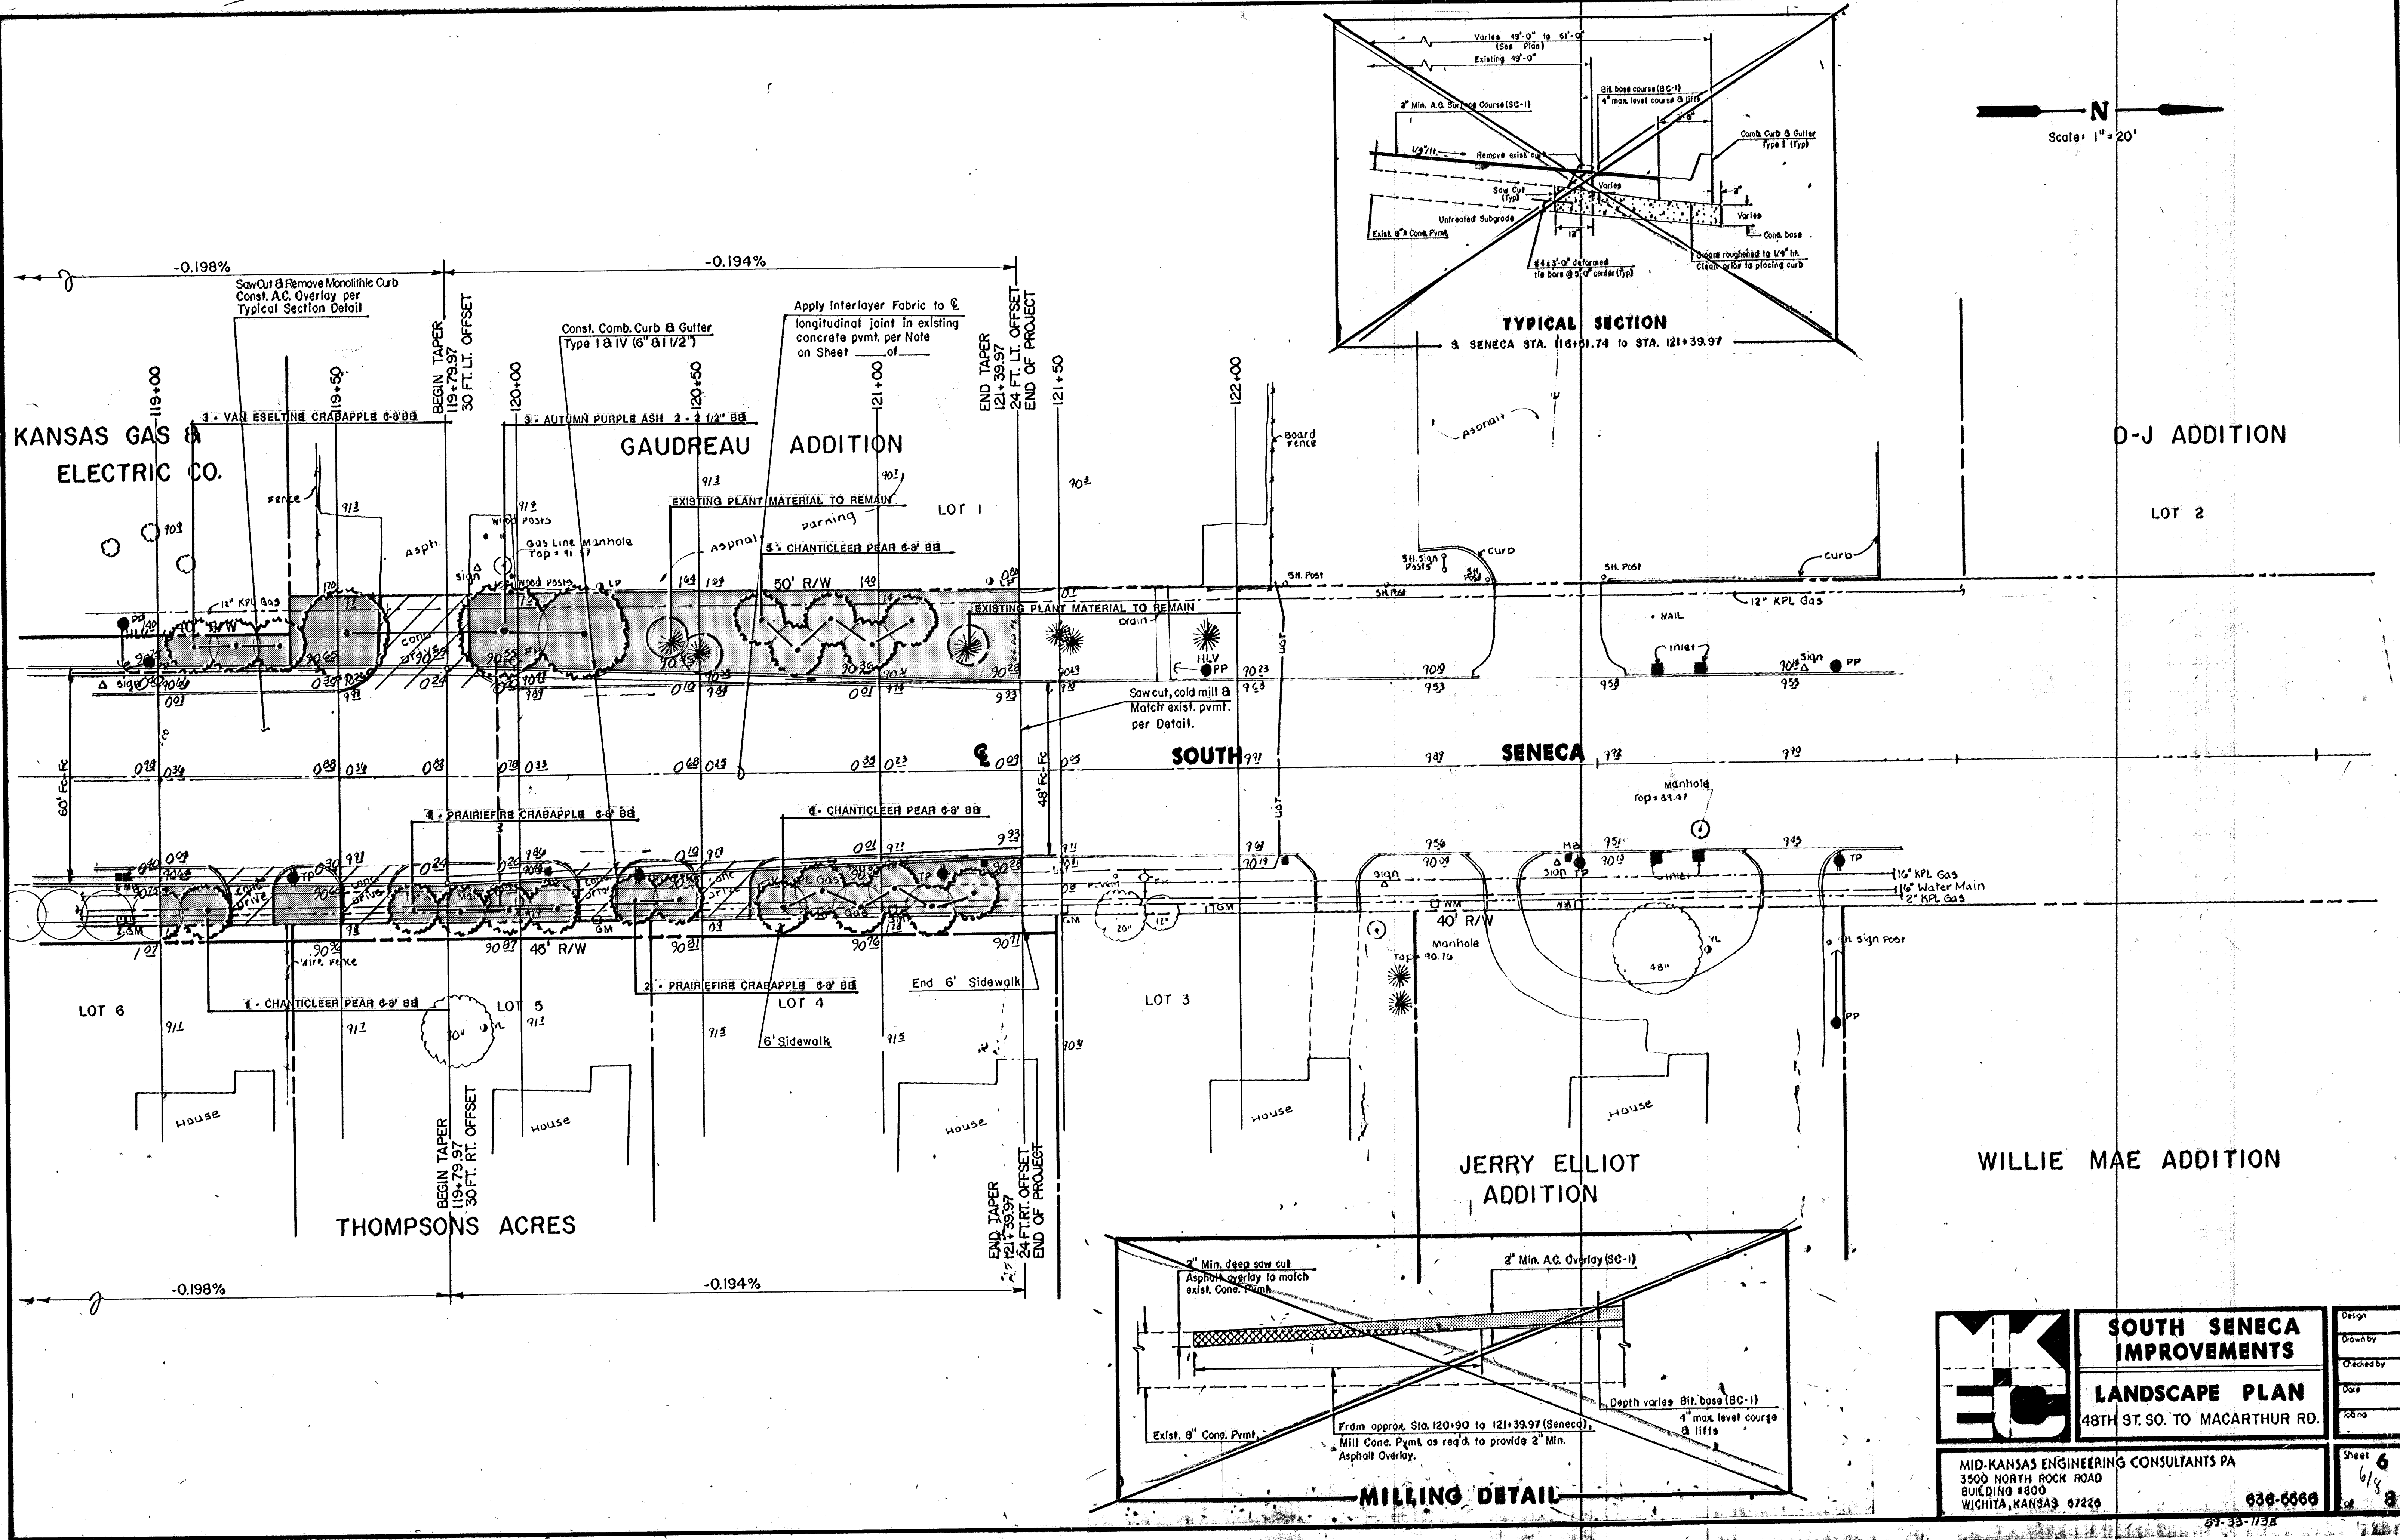

N
Scale: 1" = 20'

	SOUTH SENECA IMPROVEMENTS	Design
	LANDSCAPE PLAN 48TH ST. SO. TO MACARTHUR RD.	Drawn by
		Checked by
		Date
MID-KANSAS ENGINEERING CONSULTANTS PA 3500 NORTH ROCK ROAD BUILDING #800 WICHITA, KANSAS 67220		Job no.
83-33-113A		Sheet 6 6/8