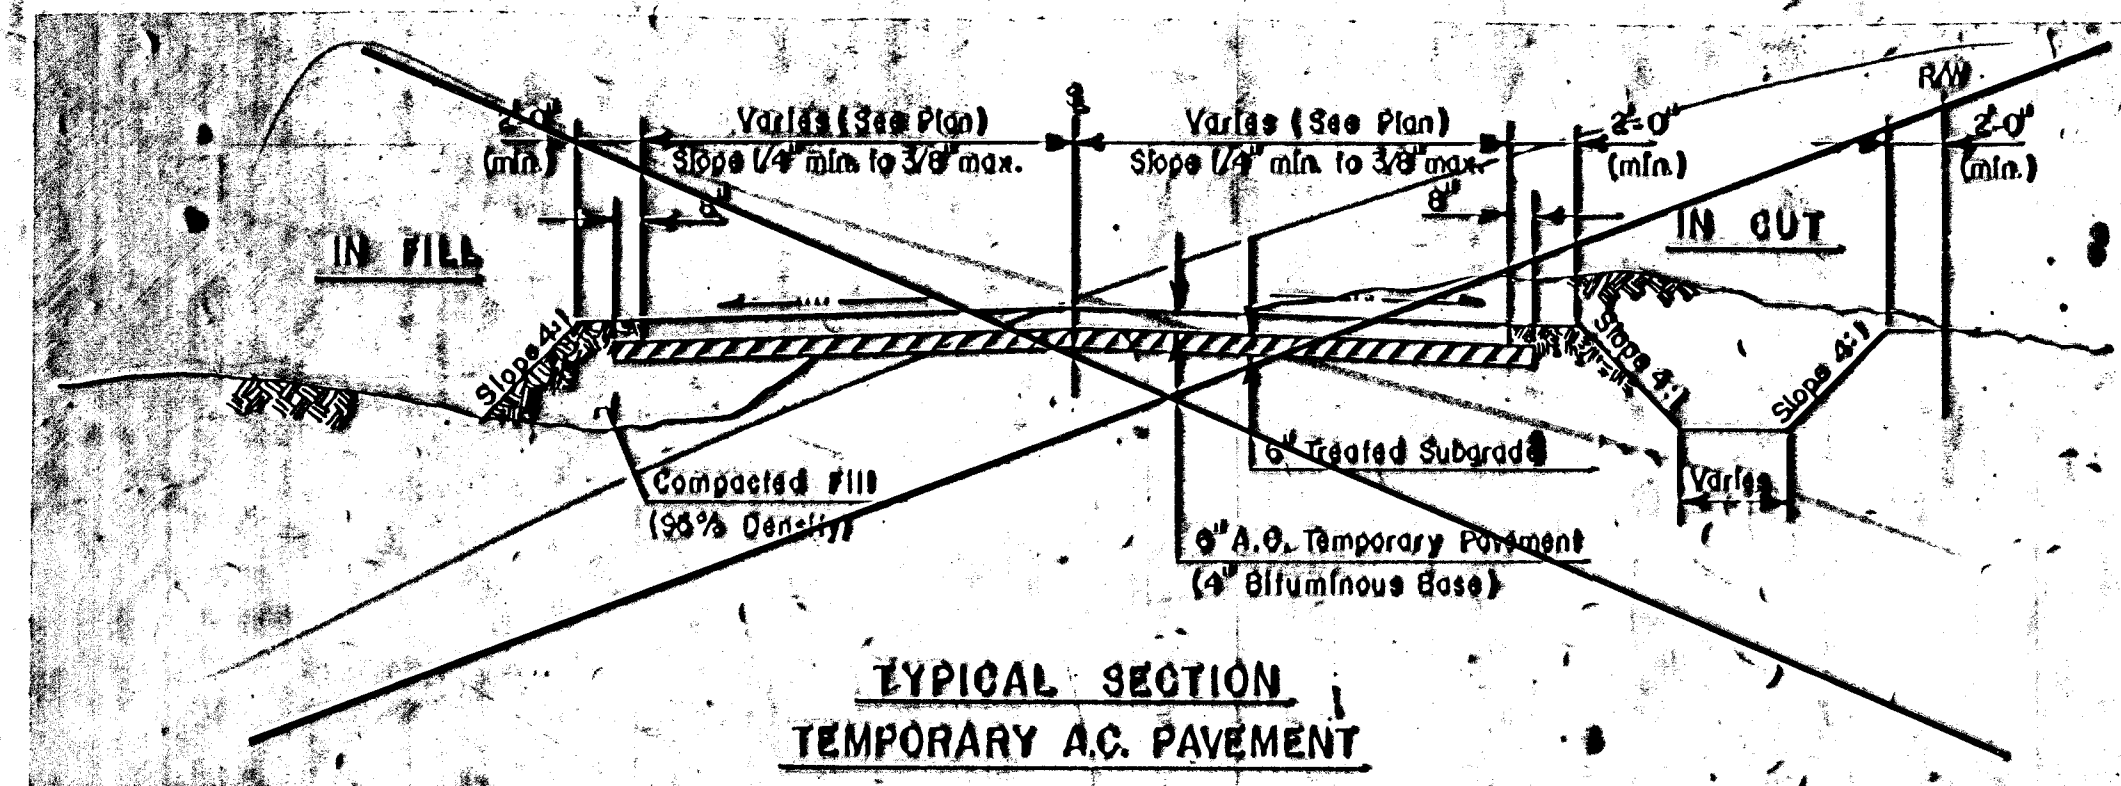
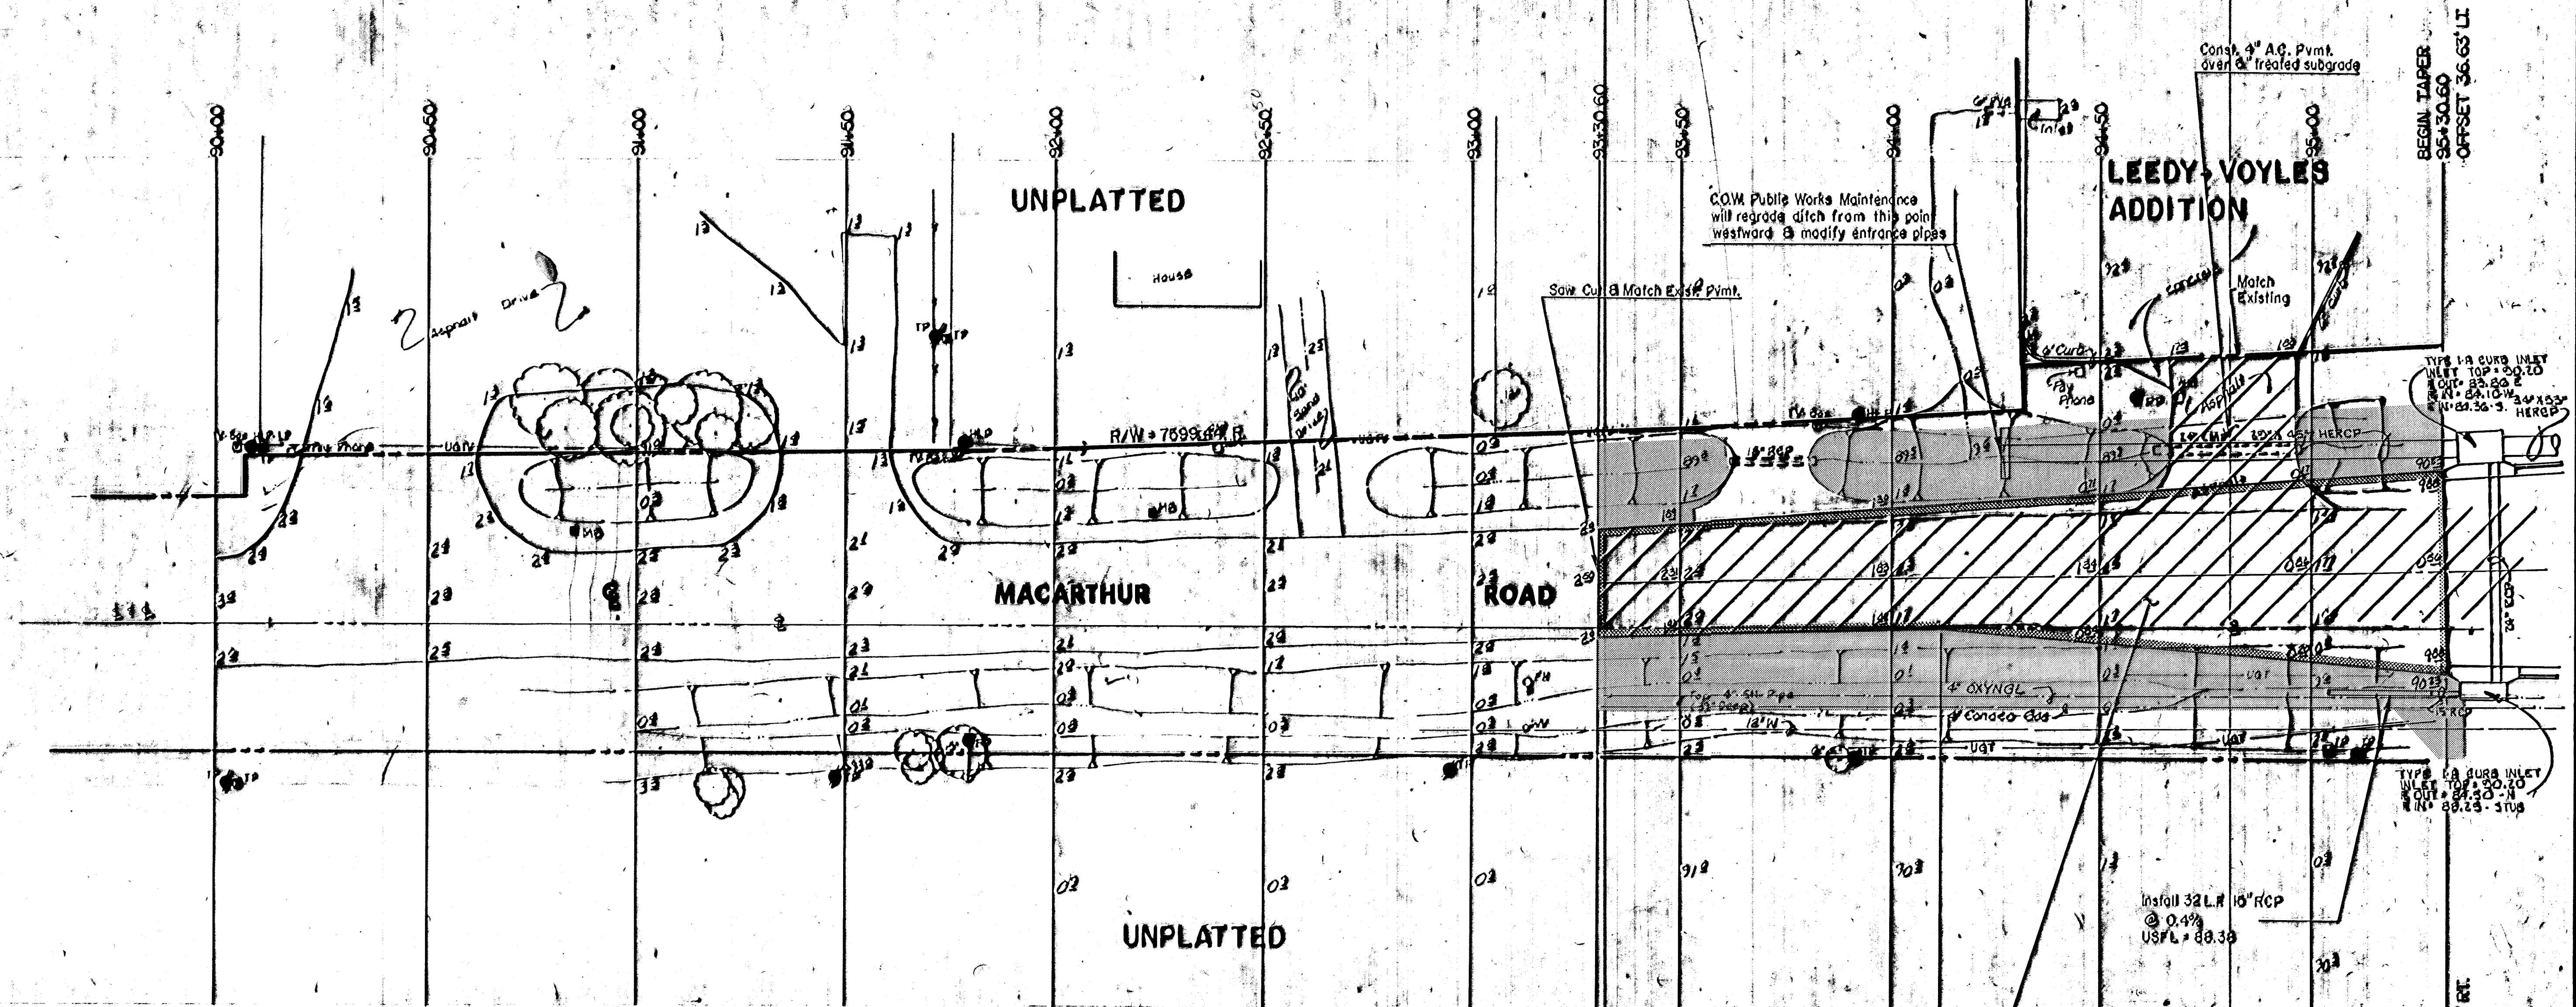


	SOUTH SENECA IMPROVEMENTS		Design Drawn by Checked by Date Title
	LANDSCAPE PLAN		Sheet 7 of 8
	48TH ST. SQ. TO MACARTHUR RD.		
MID-KANSAS ENGINEERING CONSULTANTS PA 3500 NORTH ROCK ROAD BUILDING 1800 WICHITA, KANSAS 67229			636-6666