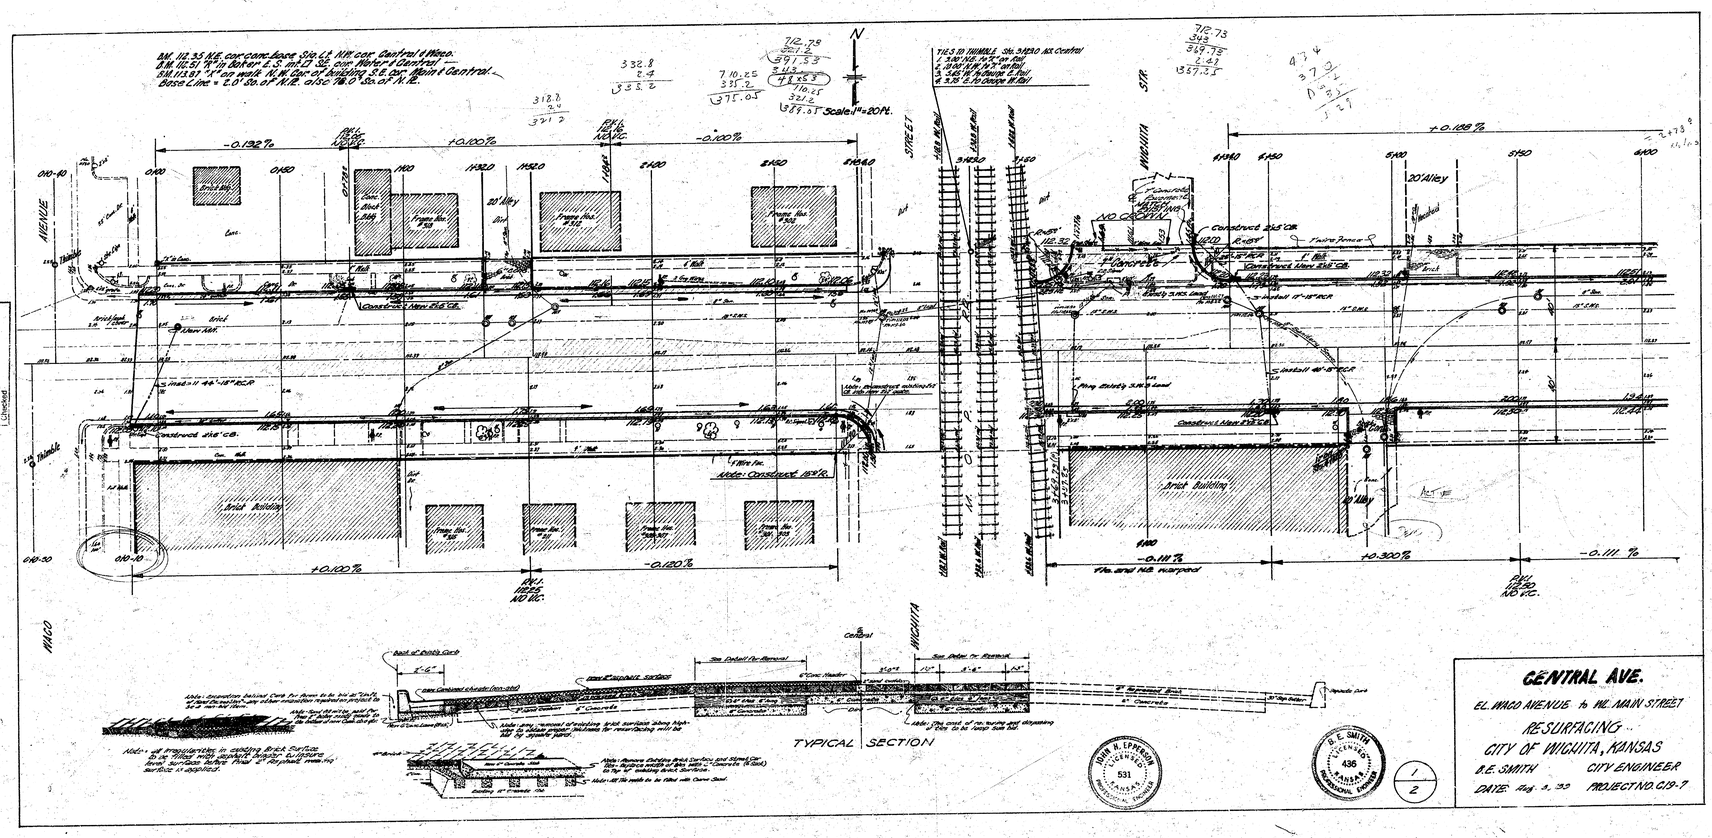
Scale 1" = 20 ft.
TYPICAL SECTION
CENTRAL AVE.
EL. WACO AVENUE to WE. MAIN STREET
RESURFACING
CITY OF WICHITA, KANSAS
B.E. SMITH CITY ENGINEER
DATE: Aug. 1, 20 PROJECT NO. C19-7
1/2

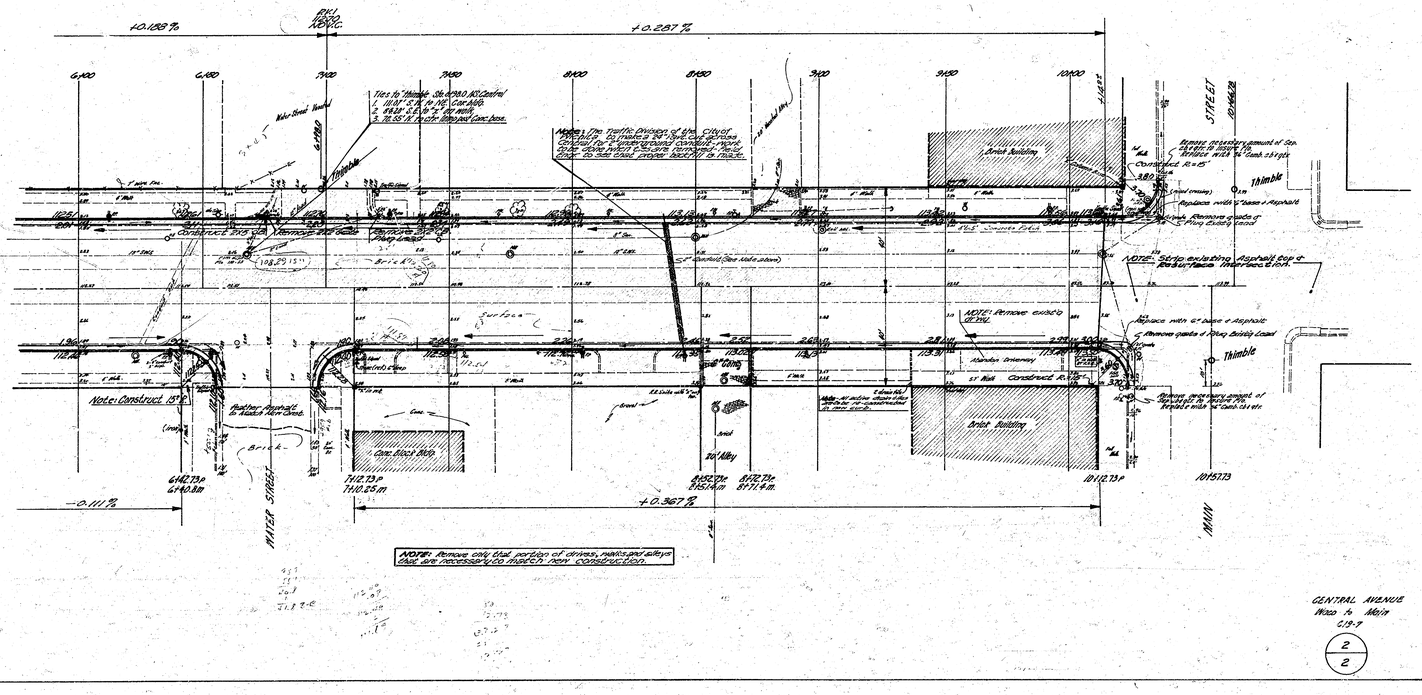
+0.188 %
+0.287 %
6+00
6+50
7+00
7+50
8+00
8+50
9+00
9+50
10+00
Thimble
Brick Building
Concrete Block Bldg.
Alley
Note: Construct 15' R.
Patter Asphalt to Match New Conc.
Brick
Remove existing asphalt
Replace with 6" base & Asphalt
Remove gutter & Poley Bitlitic Load
NOTE: Remove only that portion of drives, walks and alleys that are necessary for match in new construction.
WATER STREET
MAIN
STREET
GENTRAL AVENUE
Wood to Main
C.19-7
2
2

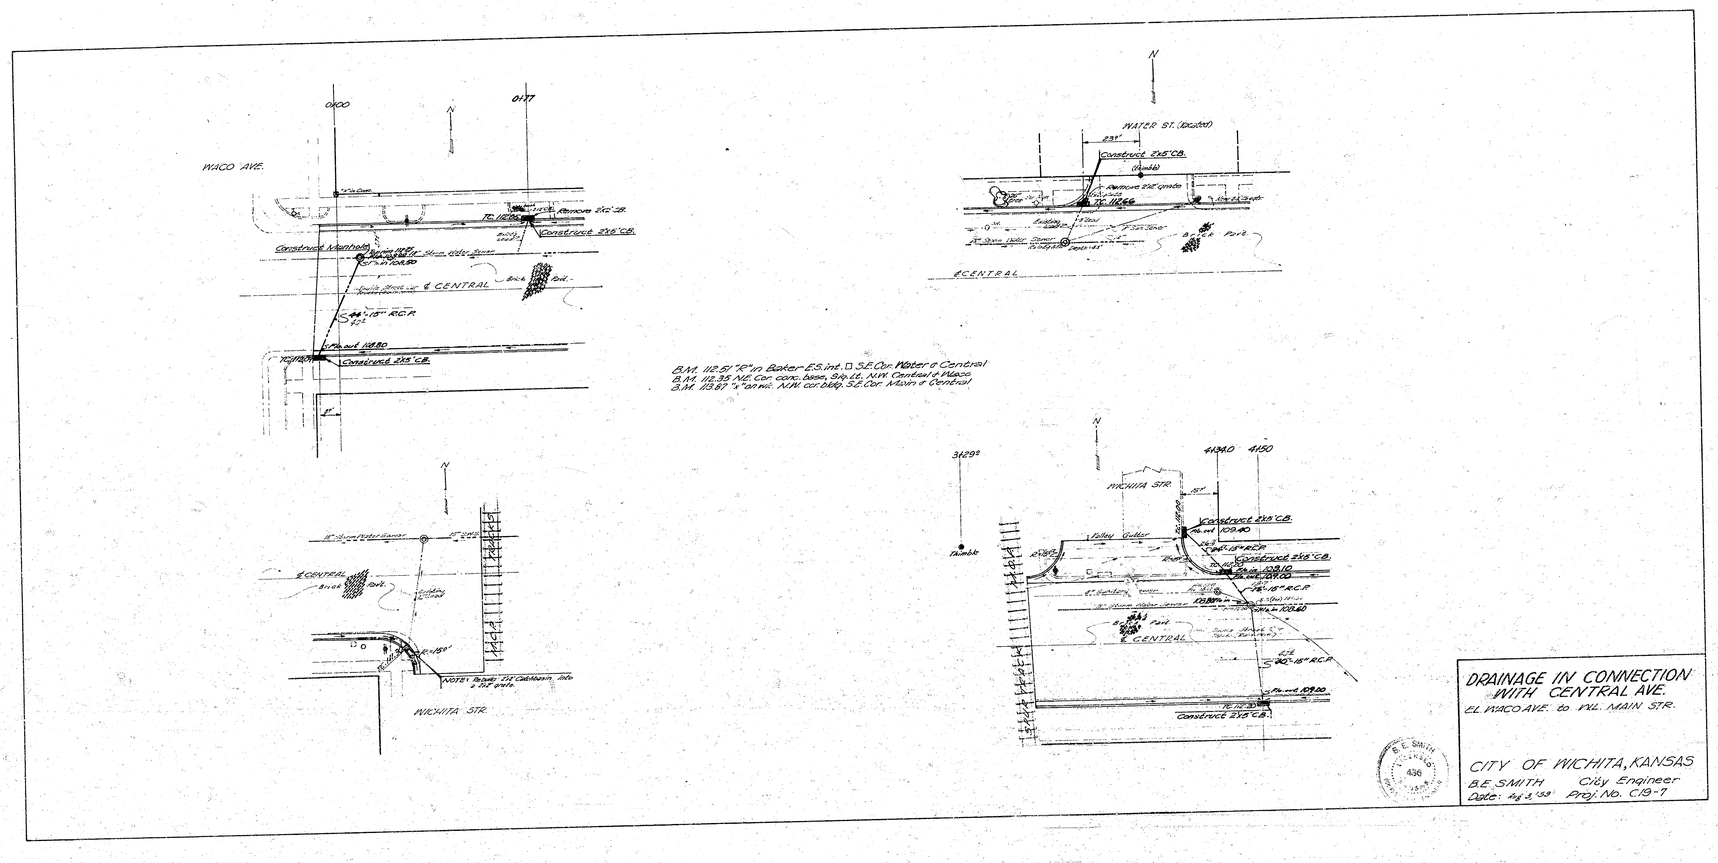

DRAINAGE IN CONNECTION WITH CENTRAL AVE.
EL. WACO AVE. to WL. MAIN STR.

CITY OF WICHITA, KANSAS
B.E. SMITH City Engineer
Date: Aug 3, '39 Proj. No. C19-7