


WHEATLAND ADDITION
SEDGWICK COUNTY, KANSAS

N.W. Cor., E. 1/2,
N.E. 1/4, Sec. 15

N.E. Cor., Sec. 15,
T.28S., R.1W.

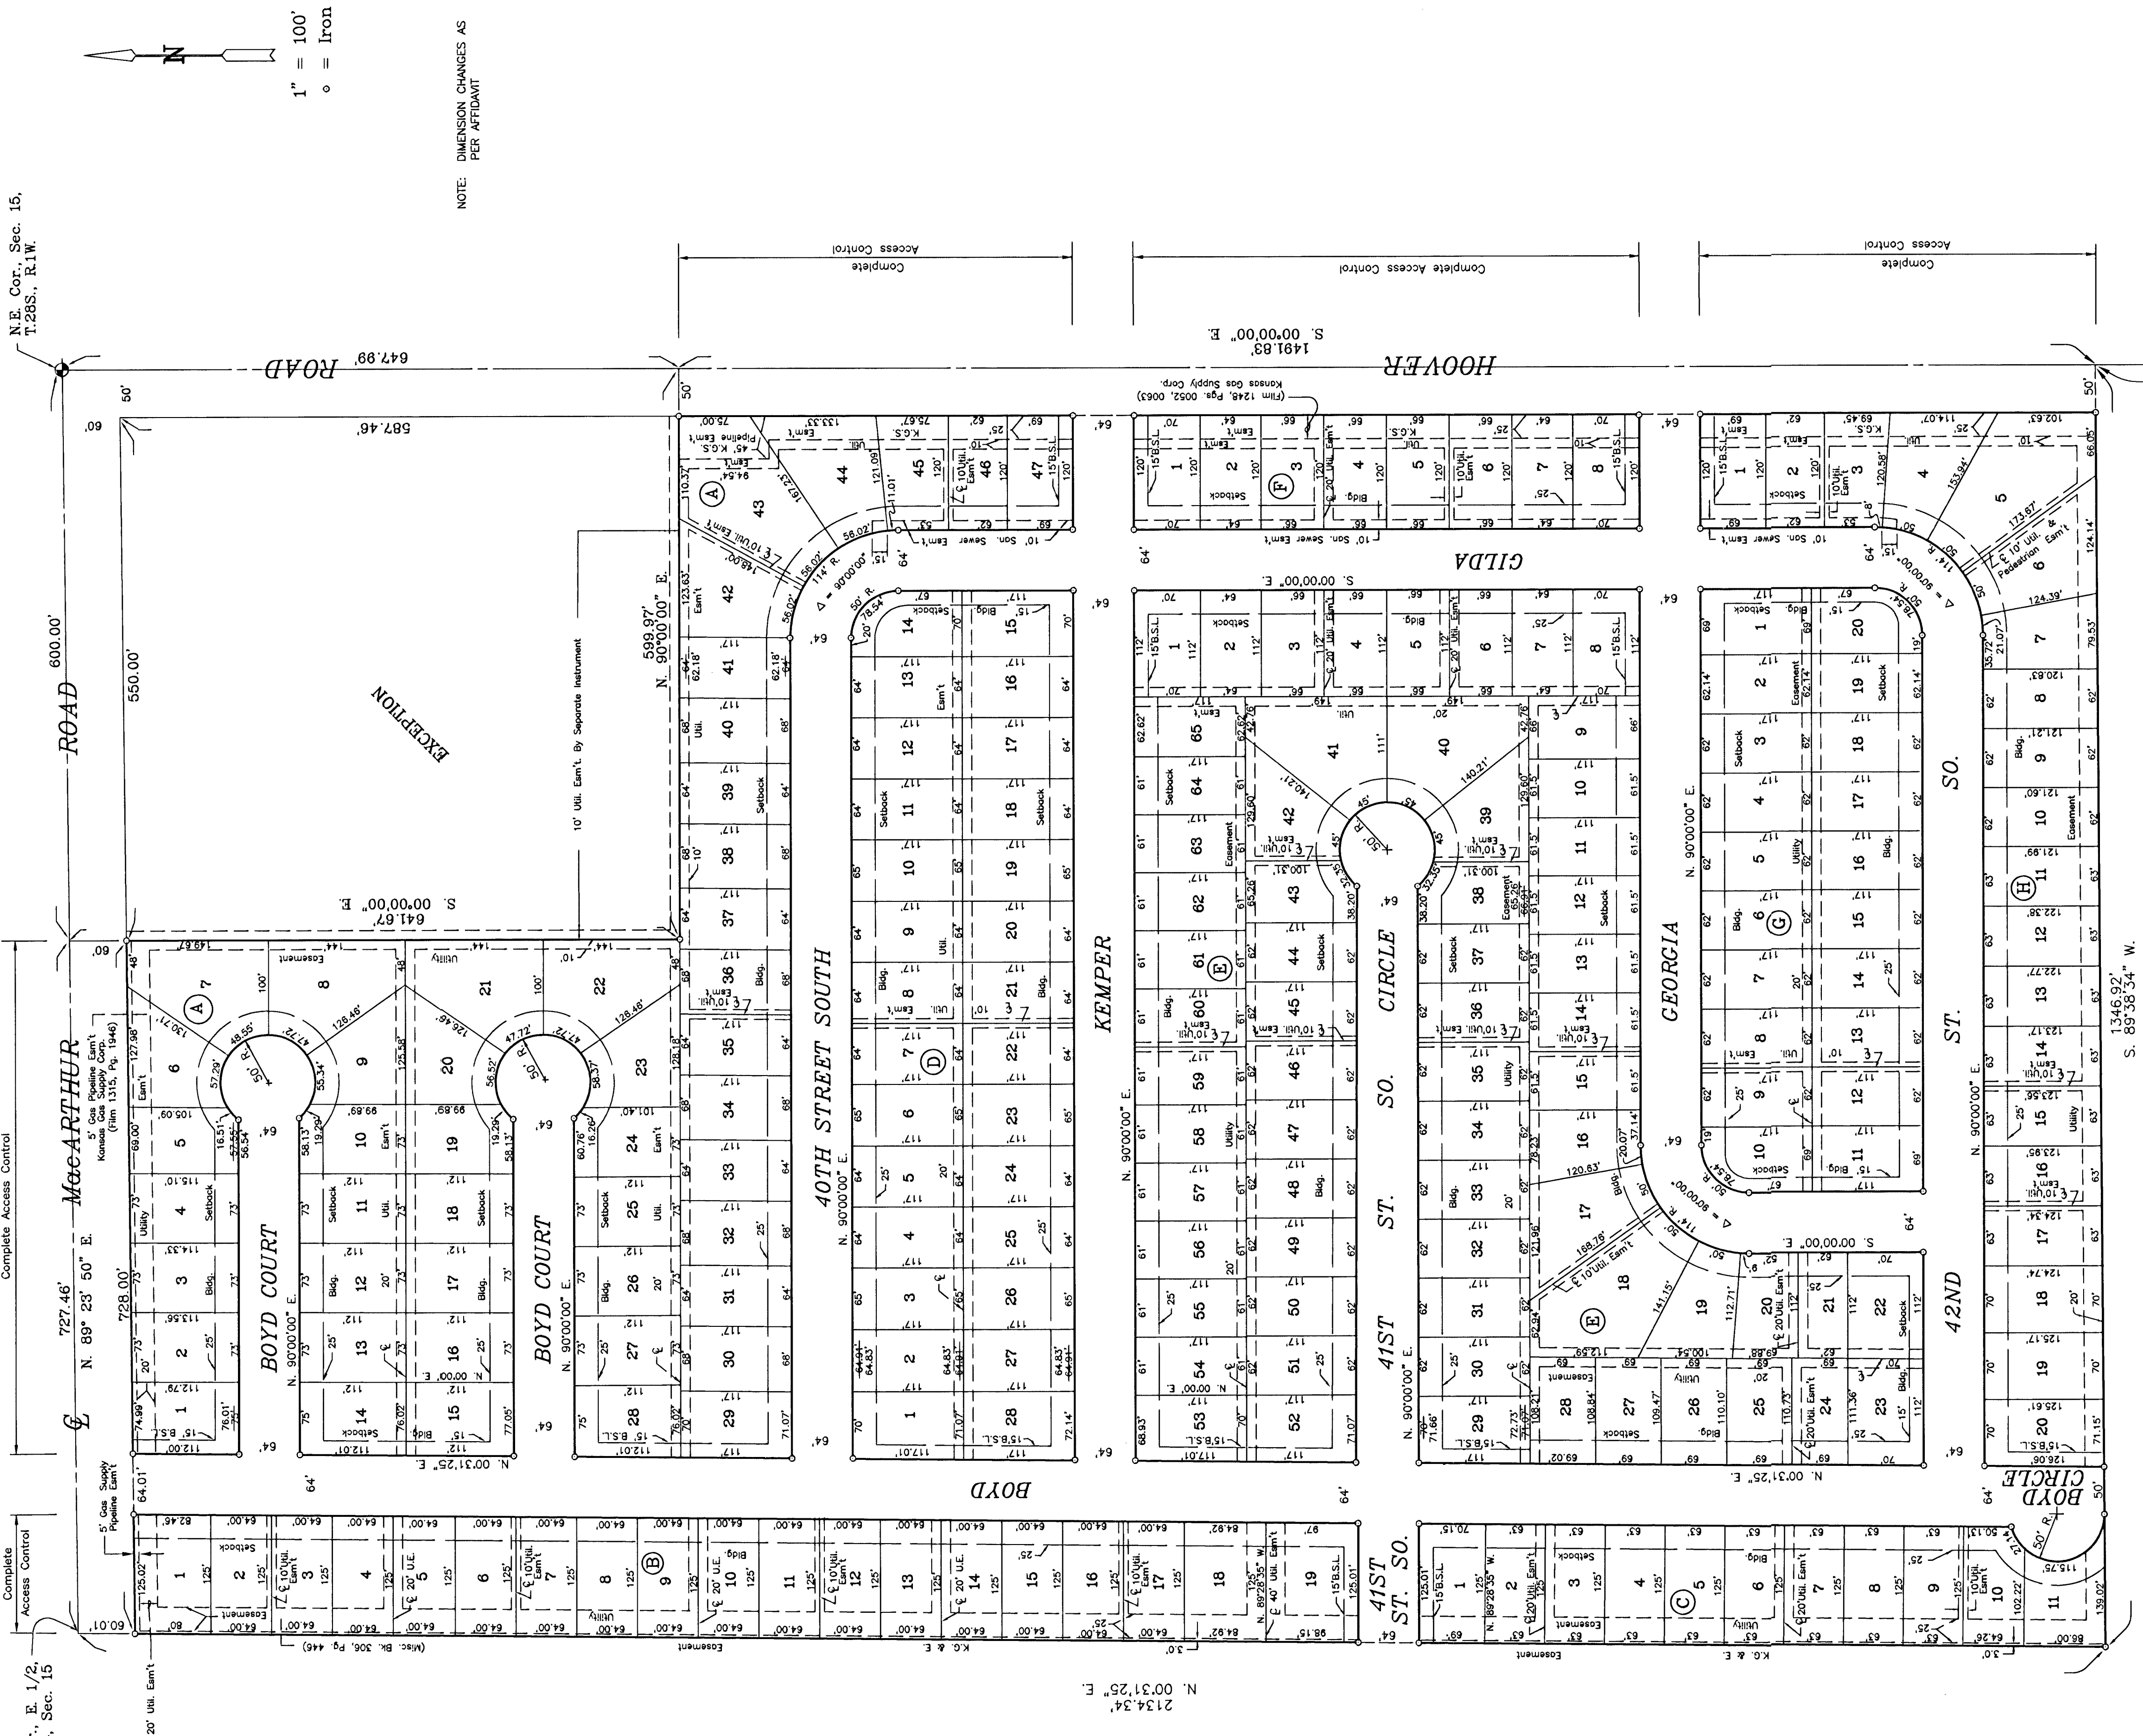

S.E. Cor. 15
N.E. 1/4, Sec. 15

FINAL PLAT - WHEATLAND ADDITION

MOEHRING & ASSOCIATES
CONSULTING ENGINEERS - SURVEYORS
433 S. HYDRAULIC WICHITA, KS.
(316) 263-8291

DATE: February 2000

SHEET 3 of 10