


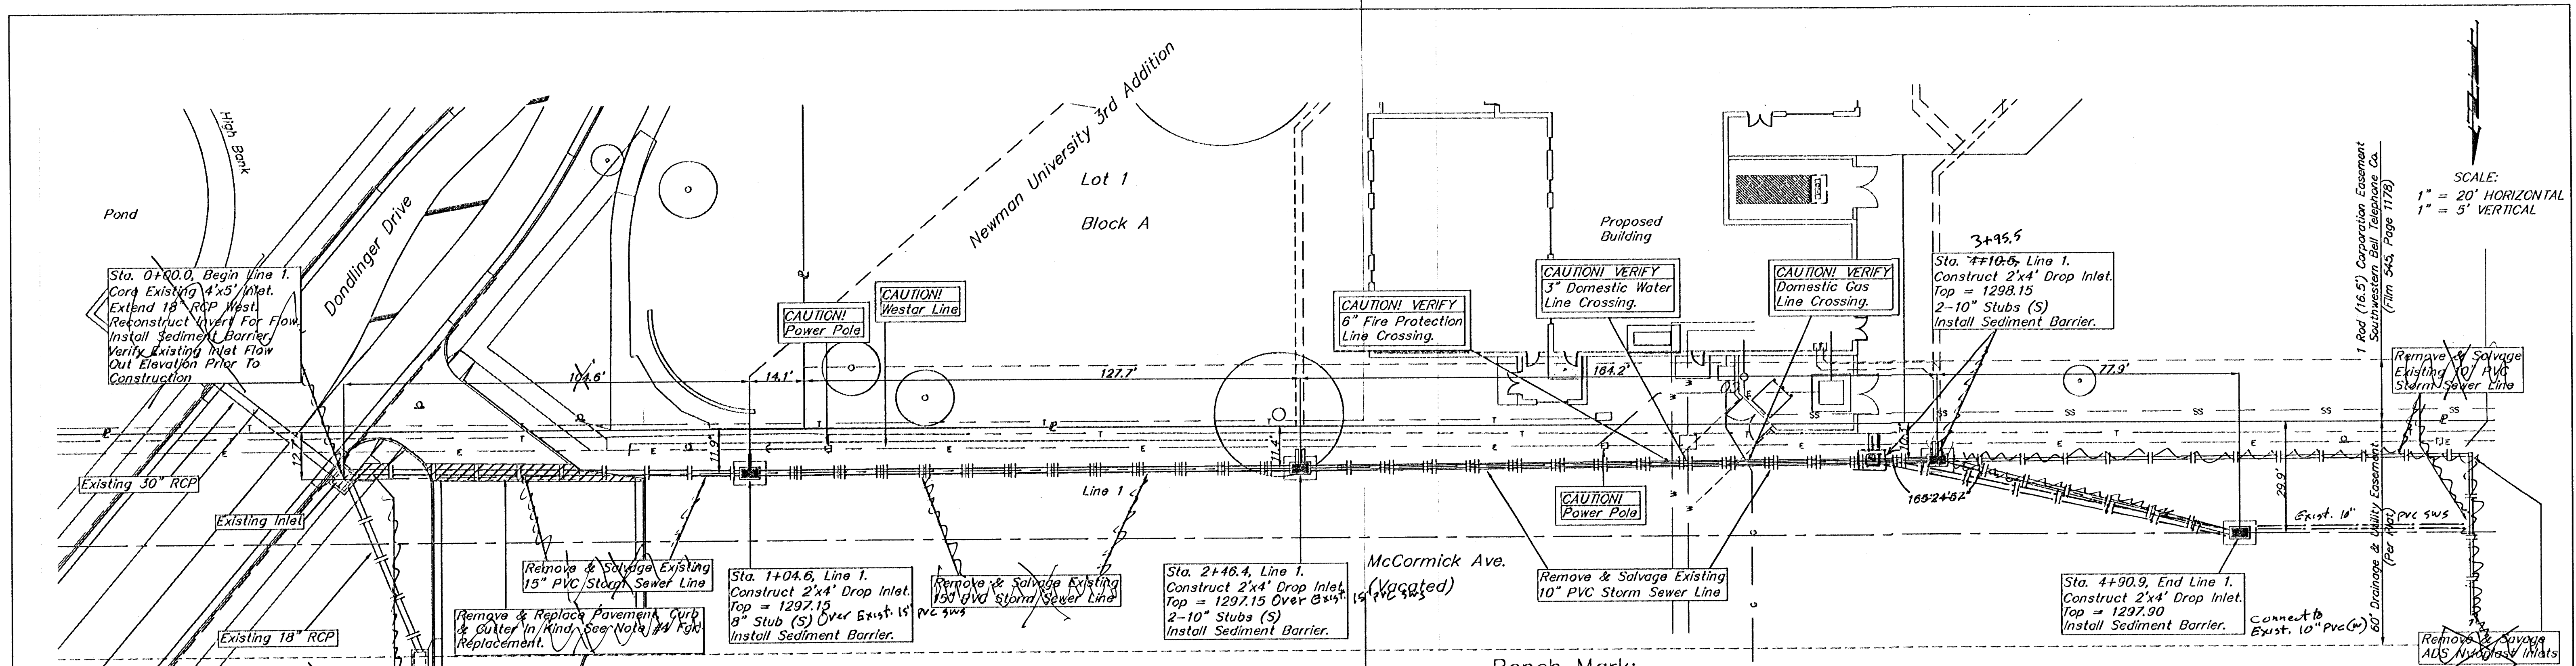


SCALE:
1" = 20' HORIZONTAL
1" = 5' VERTICAL

Bench Mark:
Sheridan and McCormick
City of Wichita Bench Mark, Southeast corner of intersection.
24.00 Ft. East of center line
48.30 Ft. South of center line
Elevation = 1299.76 (MSL)

Contractor To Use Extreme Caution
When Excavating Near Utility Lines.
Contractor To Hand Dig To Expose All
Utility Lines Prior To Construction.
Verify Depth To Determine Conflict If Any.

Contractor Shall Follow All Applicable
Best Management Practices (BMP)
For Erosion Control.

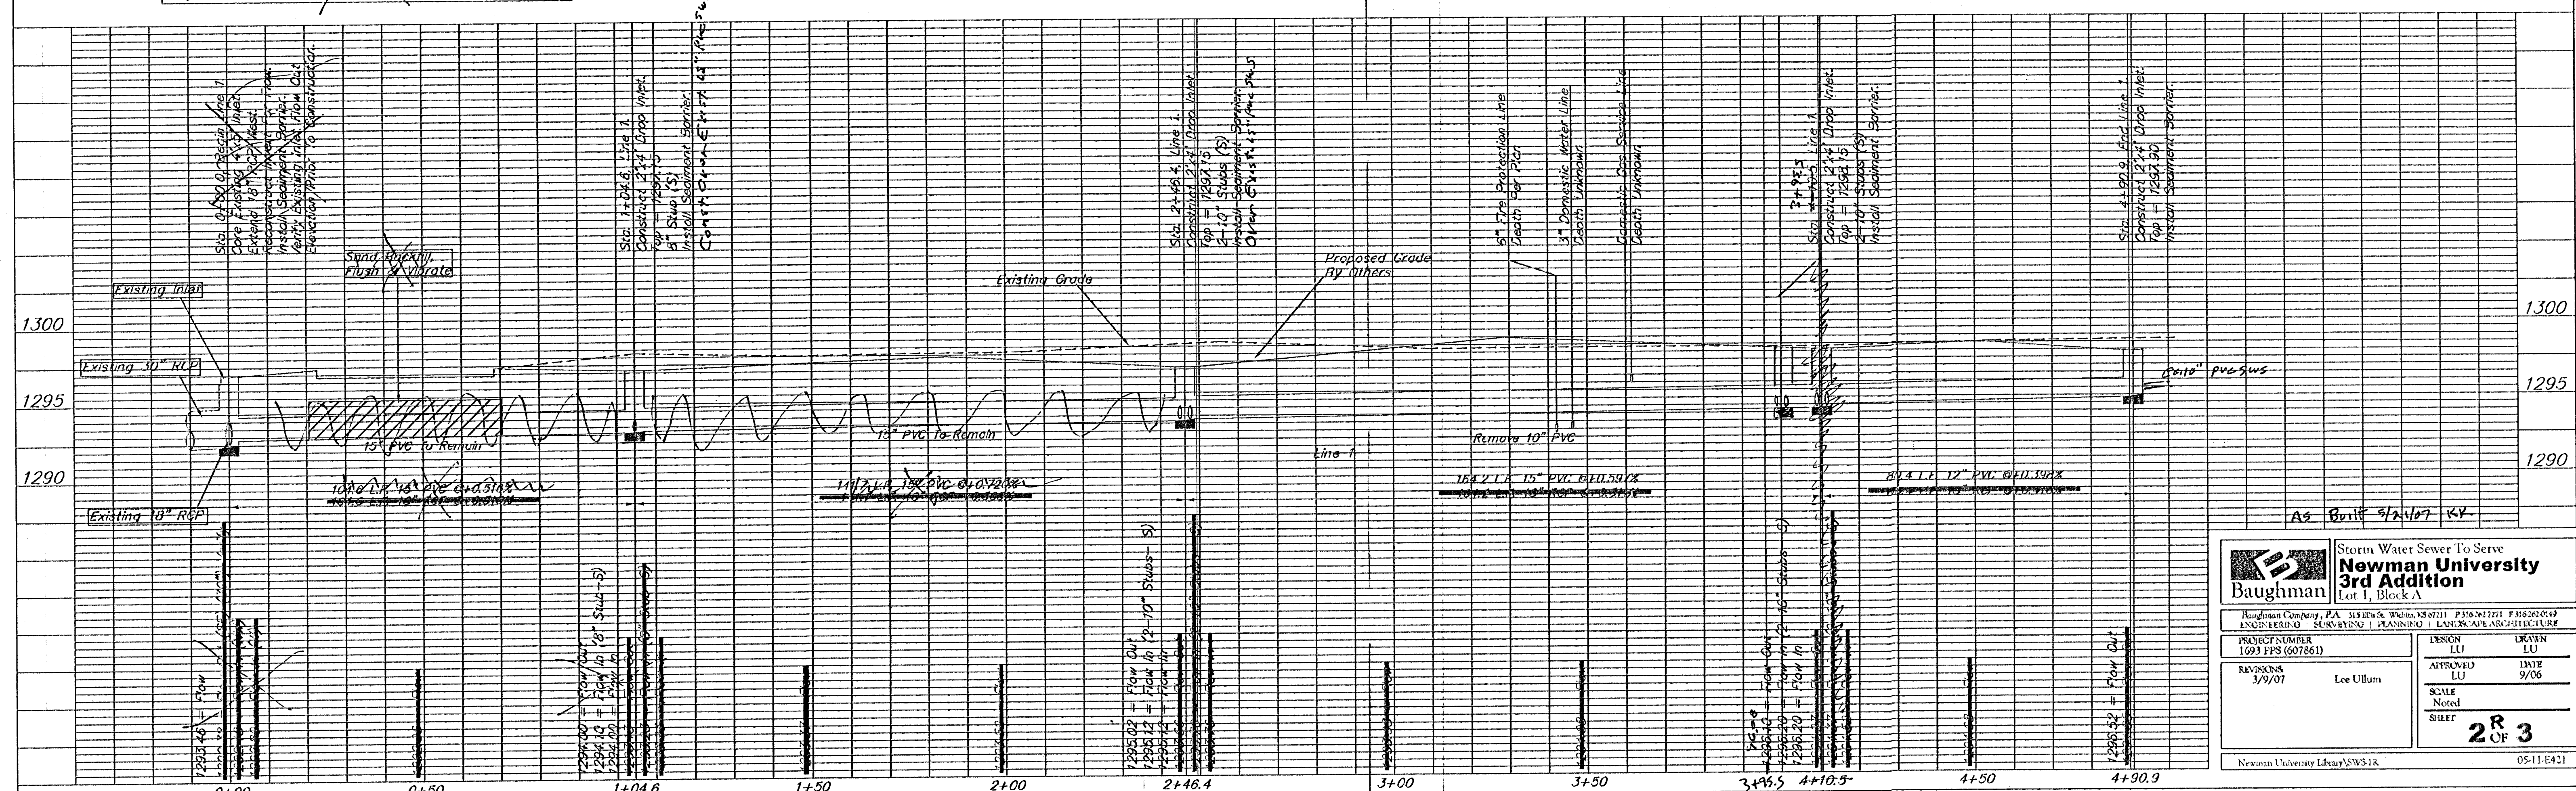

Baughman Storm Water Sewer To Serve
Newman University
3rd Addition
Lot 1, Block A

Revised: 3/9/07
Lee Ullum

PROJECT NUMBER
1693 FFS (607861)

DESIGN
LU

APPROVED
LU

DATE
9/06

SCALE
Noted

SHEET
2 OF 3

Newman University Library/SWS1R 05-11-E421