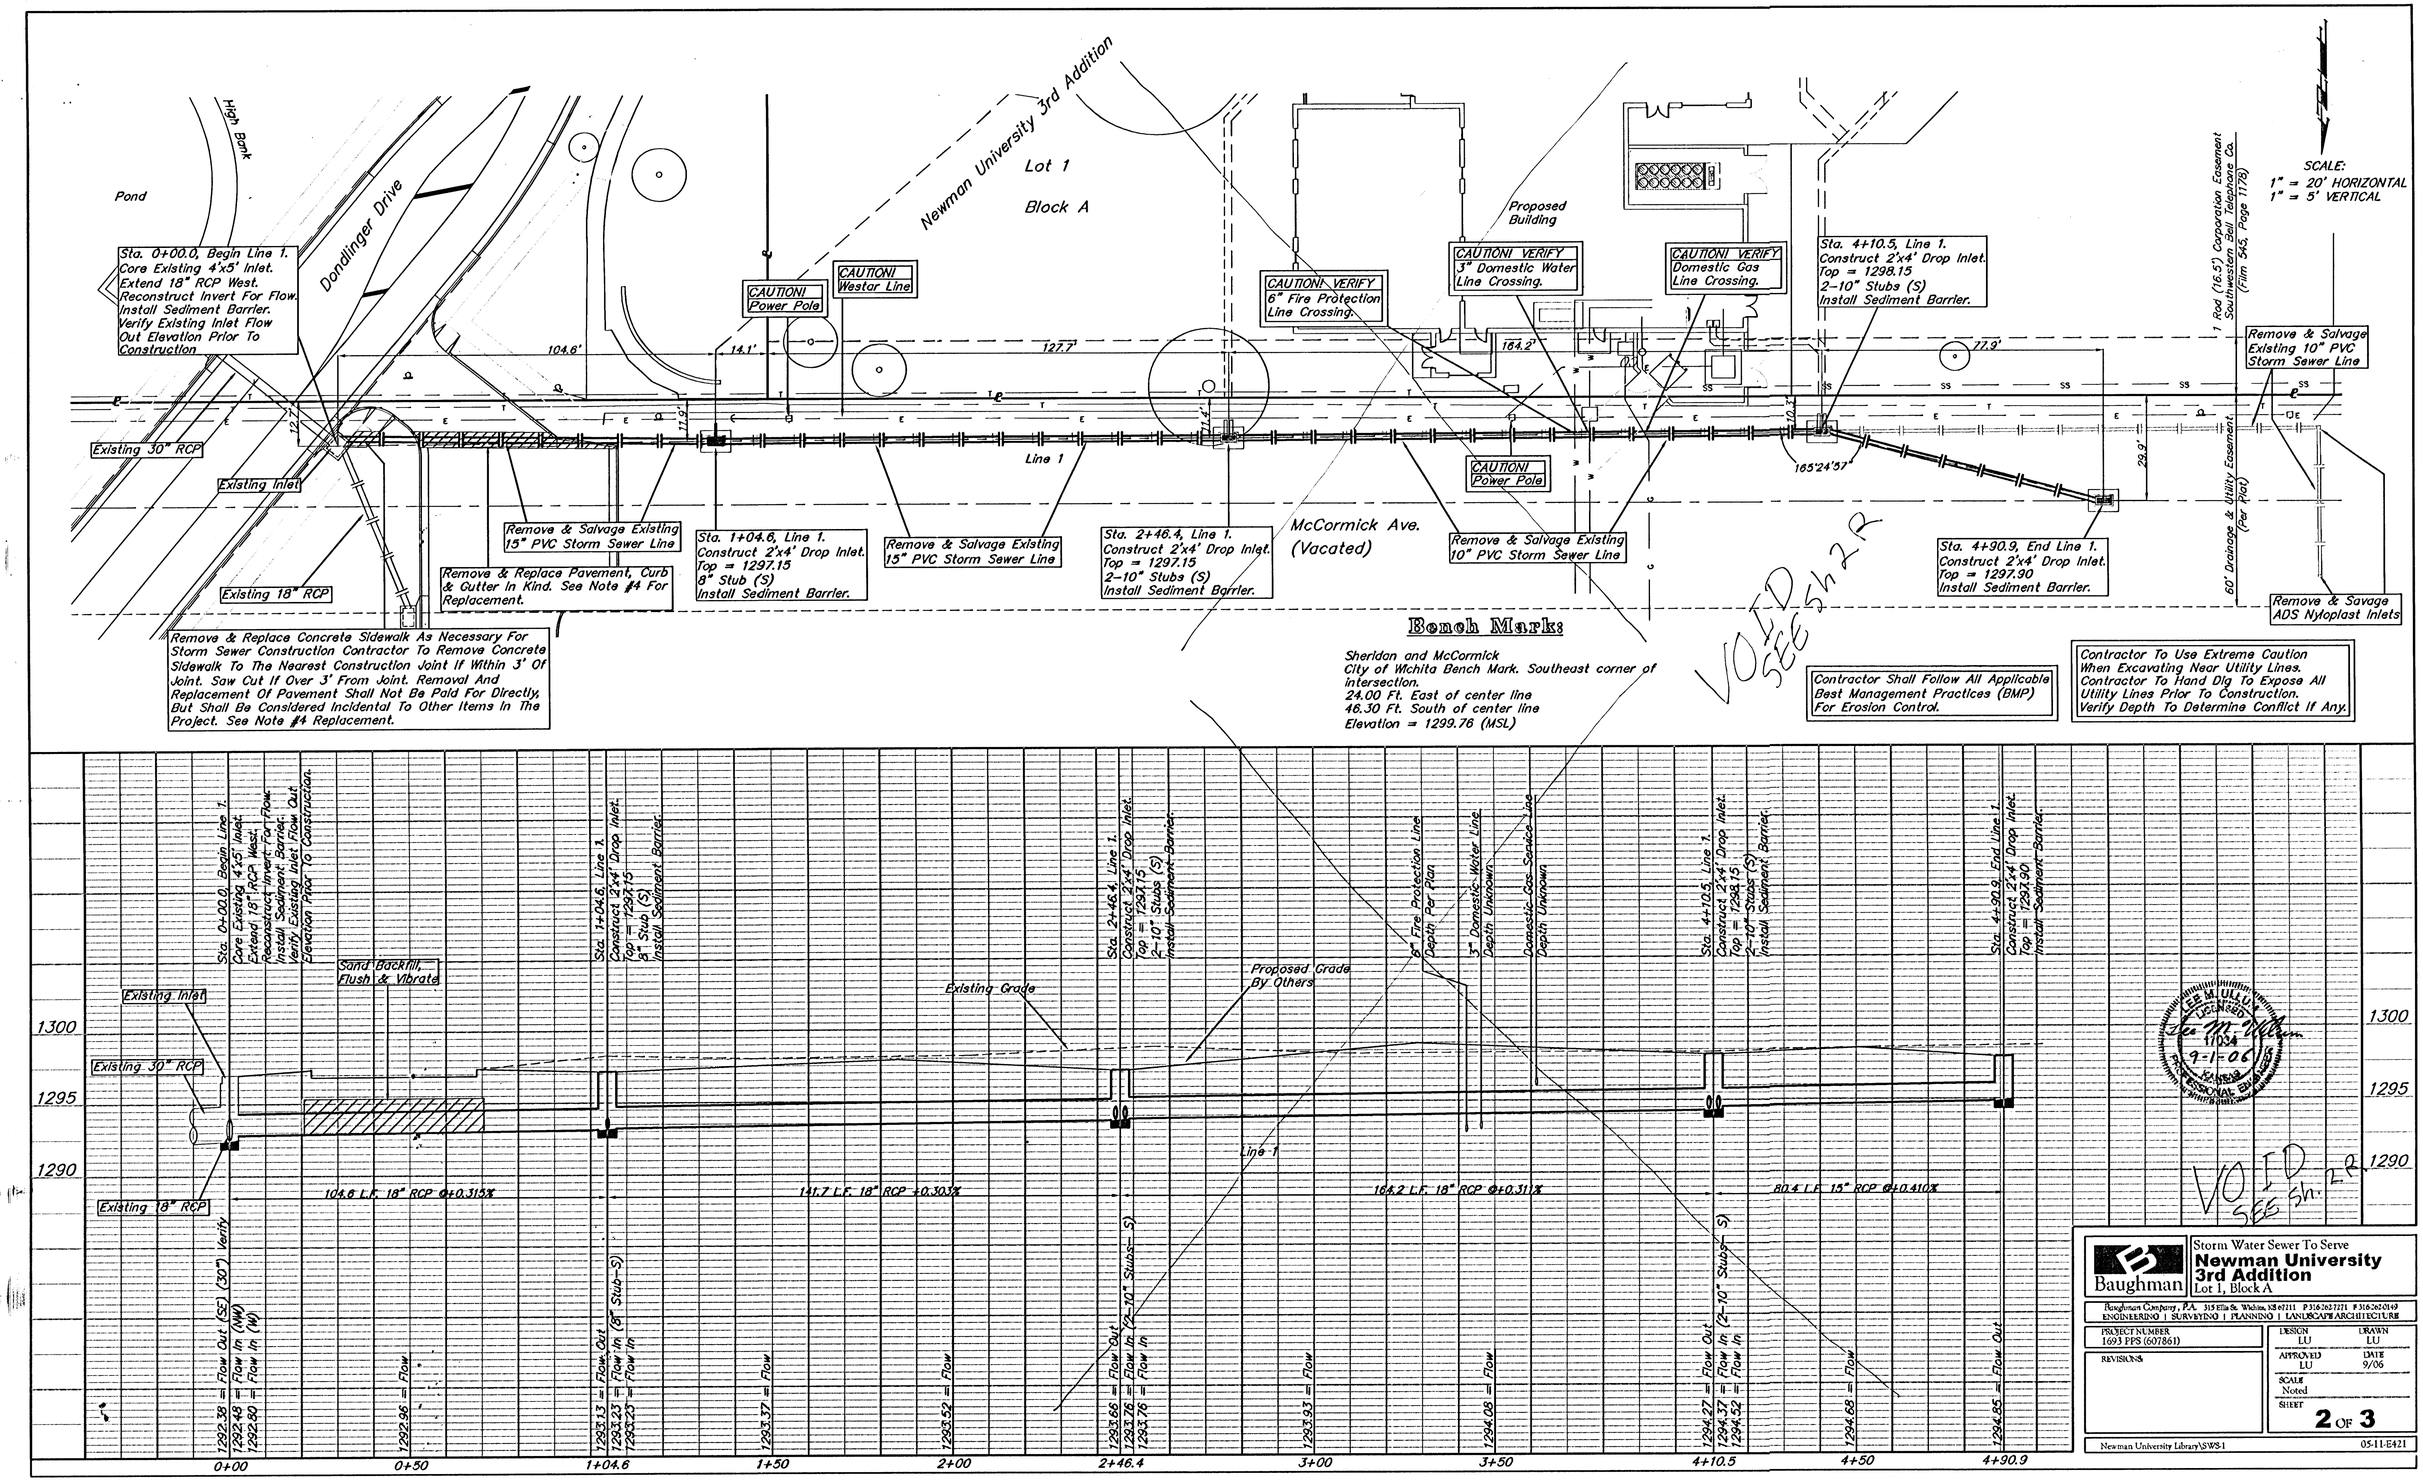

Baughman

Storm Water Sewer To Serve
Newman University 3rd Addition
Lot 1, Block A

Baughman Company, P.A. 315 Ellis St. Wichita, KS 67211 P 316.263.7271 F 316.262.0149
ENGINEERING | SURVEYING | PLANNING | LANDSCAPE ARCHITECTURE

PROJECT NUMBER 1693 PPS (607861)	DESIGN LU / DRAWN LU
REVISIONS	APPROVED LU / DATE 9/06
	SCALE Noted
	SHEET 2 OF 3

Newman University Library\SWS-1

05-11-E421