
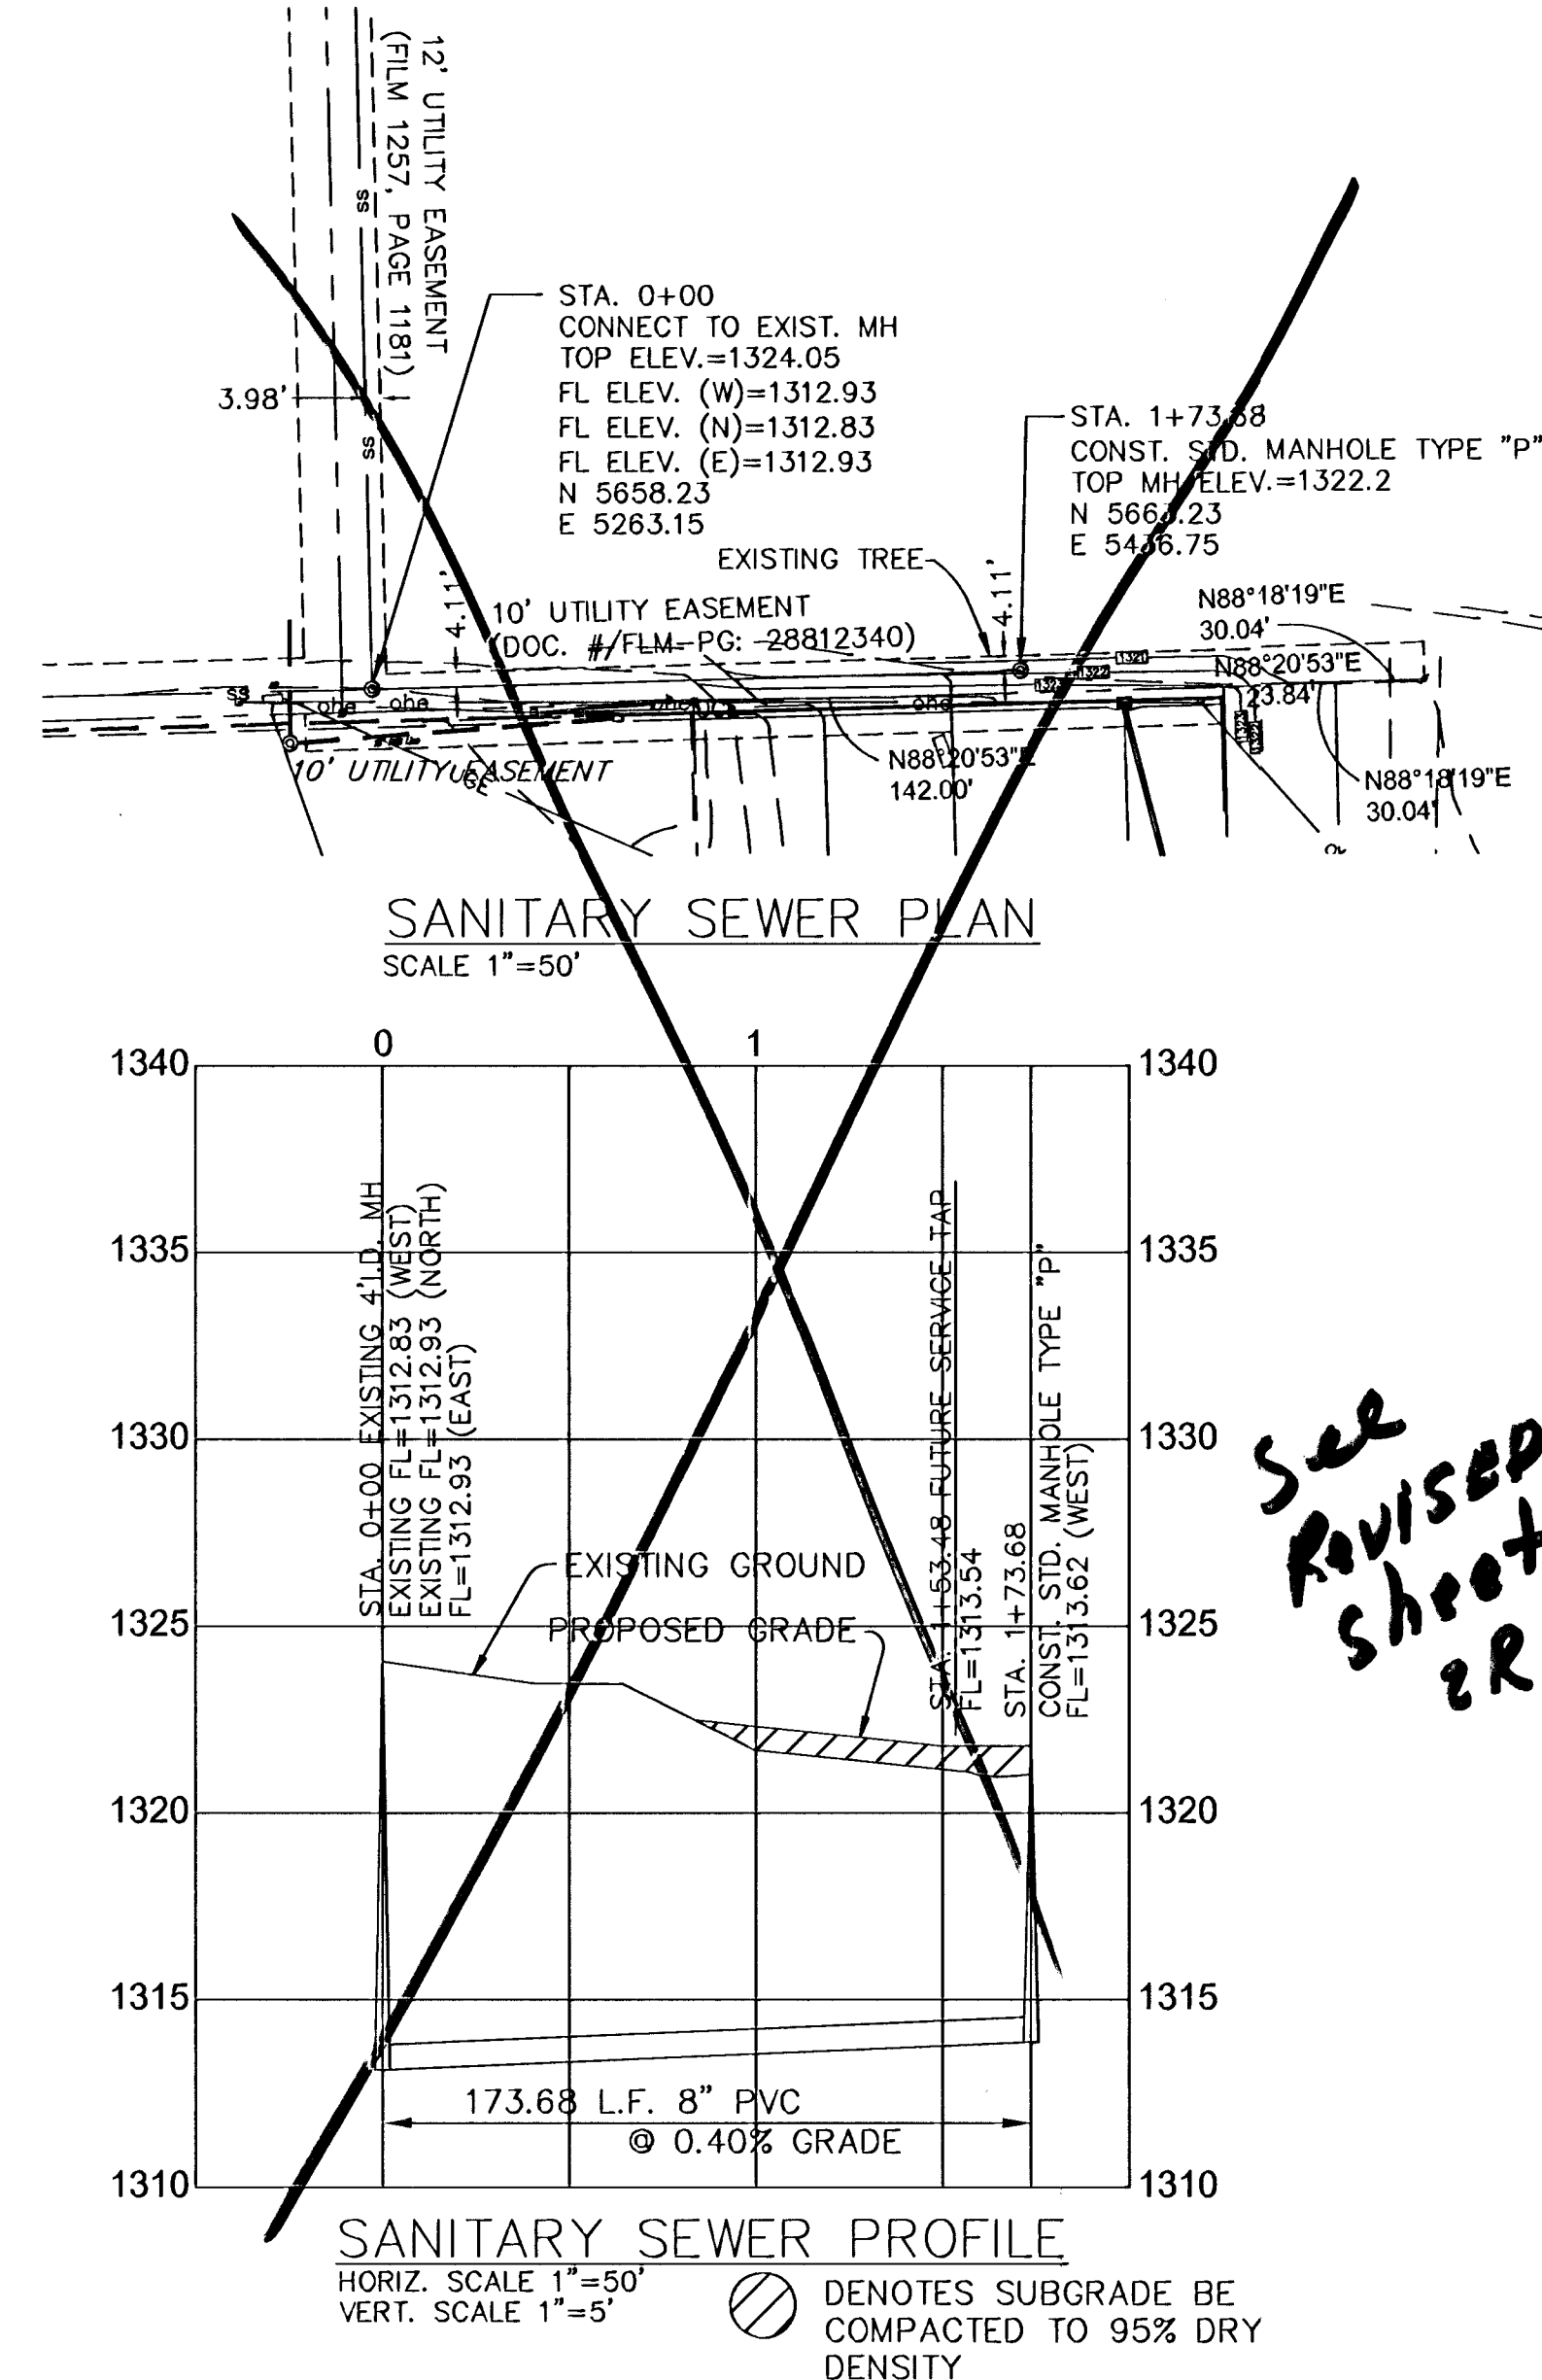


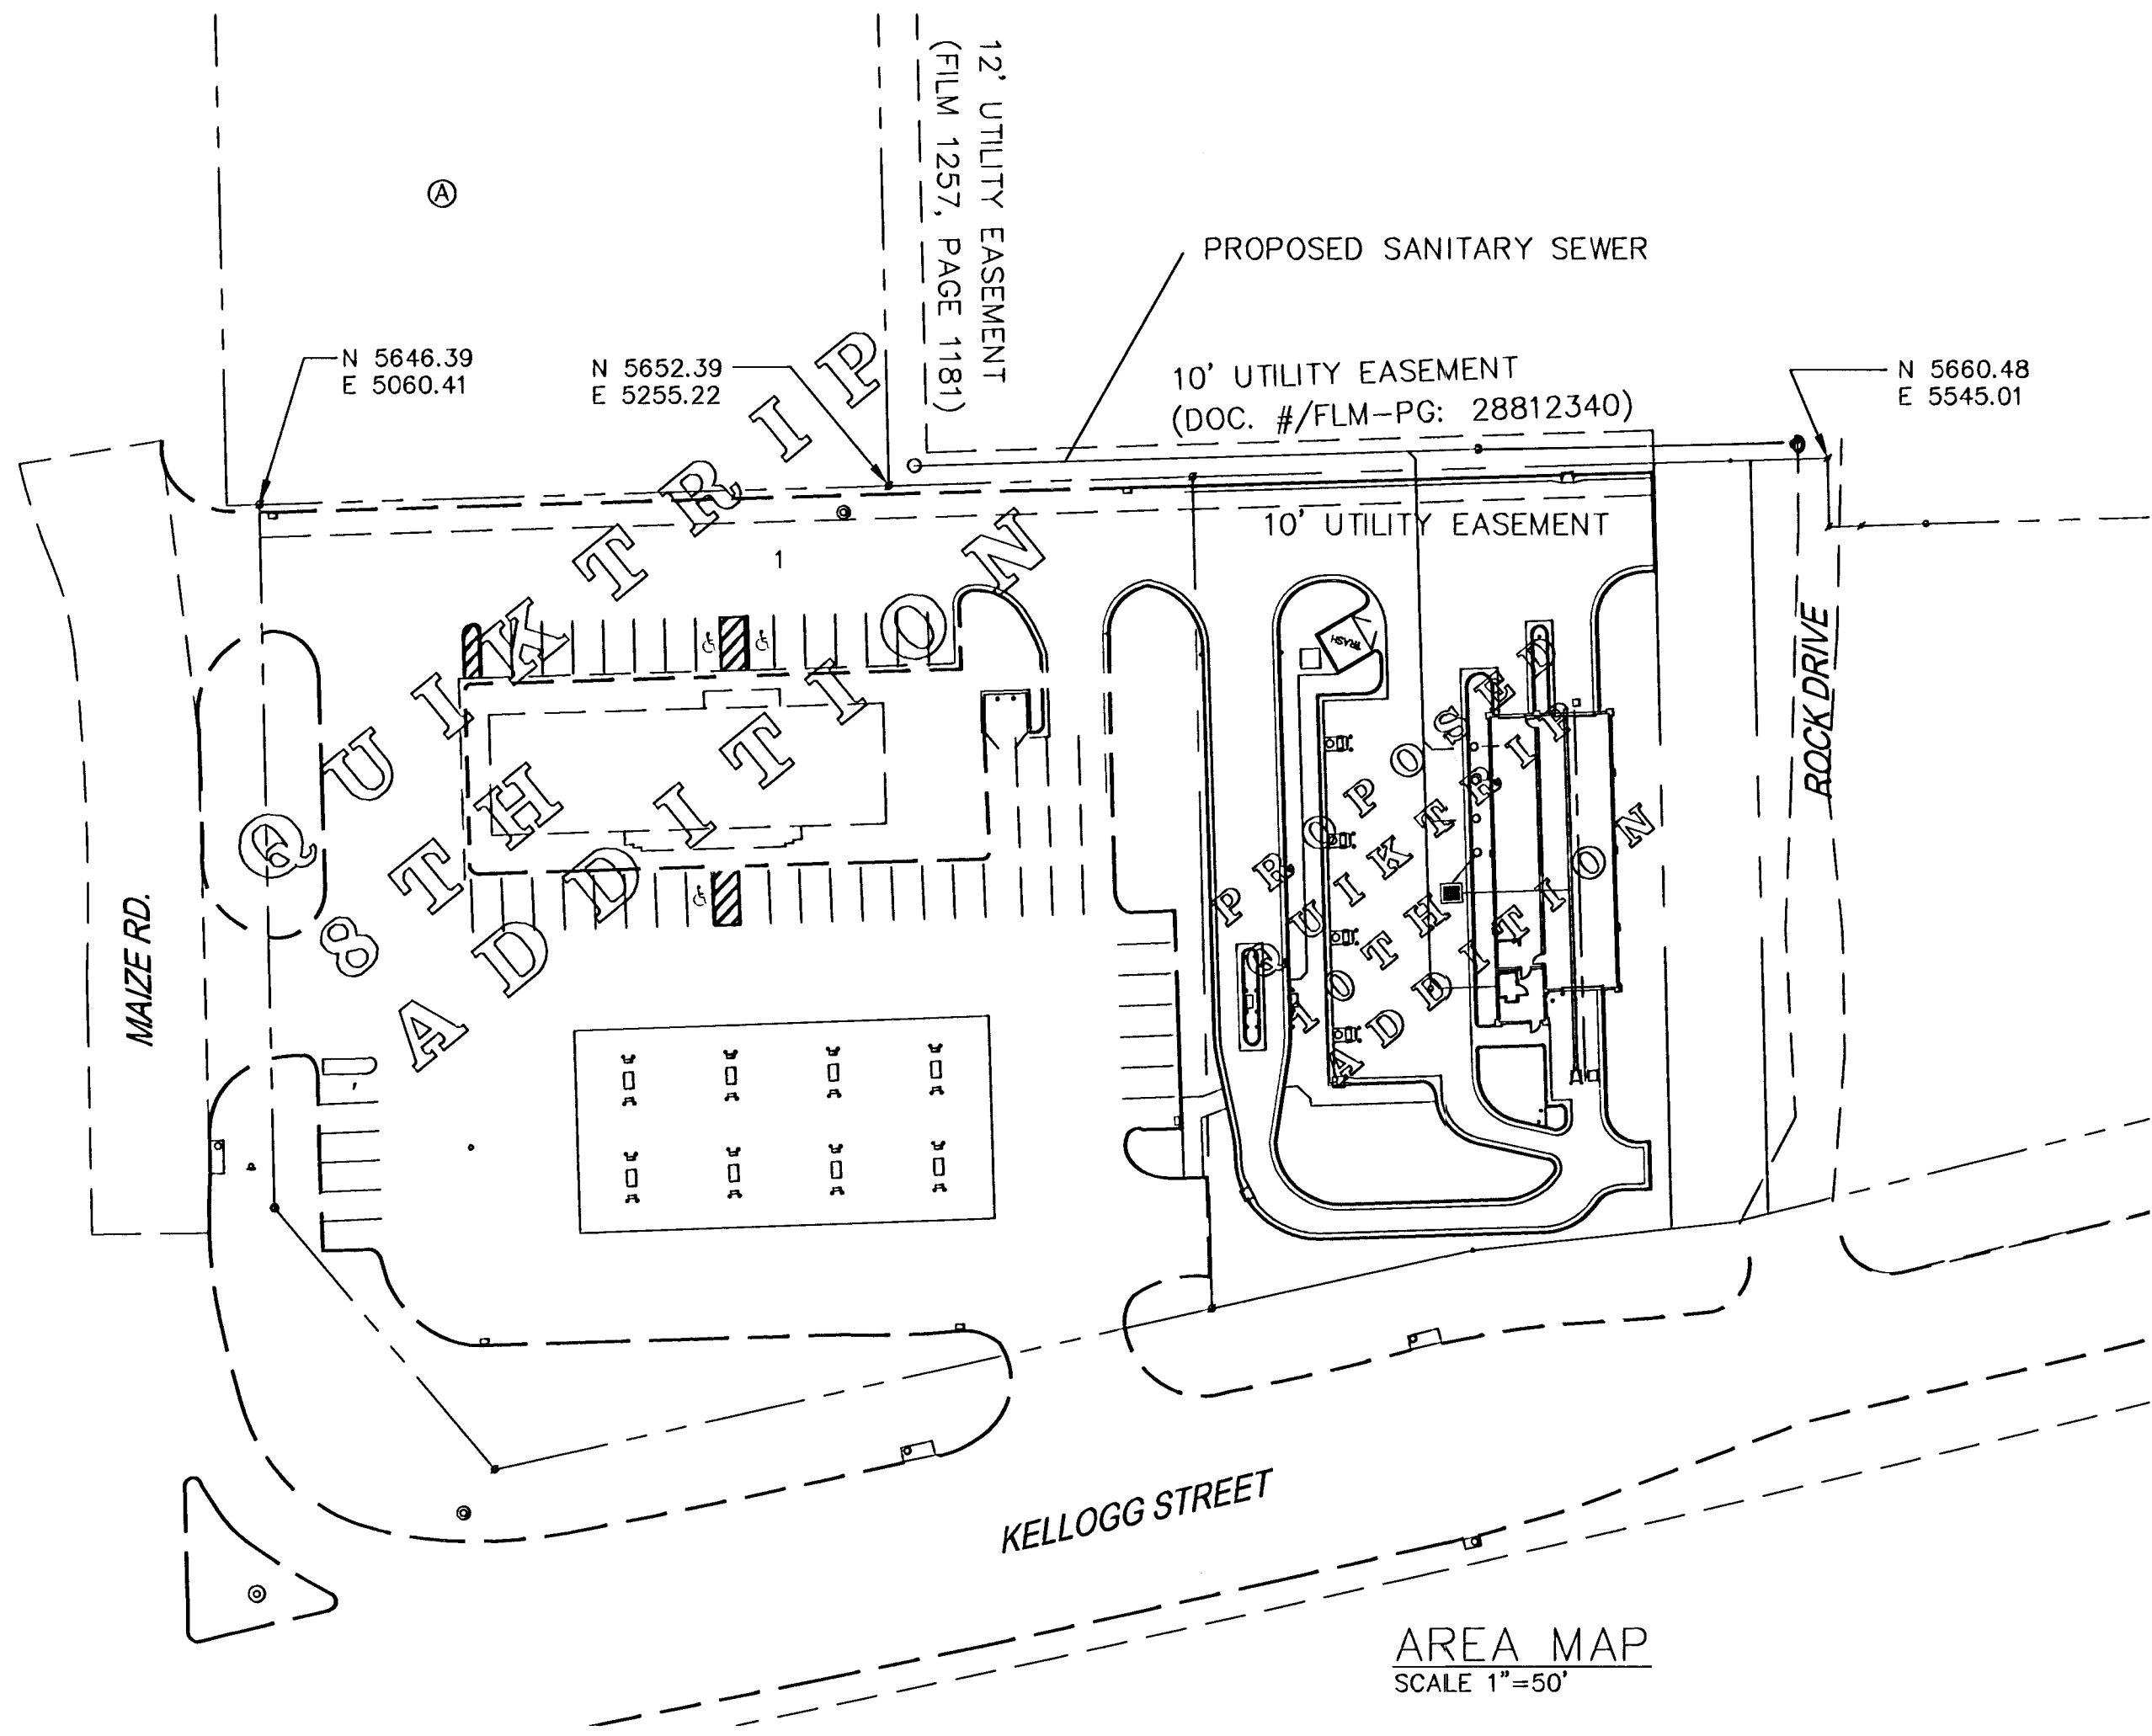

Original Signed

10-18-06

FINAL		 POE & ASSOCIATES, INC. CONSULTING ENGINEERS 5940 E. Central, Suite 200 Wichita, KS 67208-5427 Phone 316/685-4114 ■ FAX 316/685-4444	QUICKTRIP #315 SANITARY & STORM SEWER IMPROVEMENTS SANITARY SEWER PLAN & PROFILE CITY OF WICHITA, KANSAS JAMES ARMOUR, P.E. - CITY ENGINEER 1711 PPS (607861)	No.	Date	Revision
Designed By: D. Trout	△					
Drawn By: D. Trout \ A. Moss	△					
Poe Job No: 1894-02	△					
Date: 10/18/2006	△					
Sheet 2 of 6						