
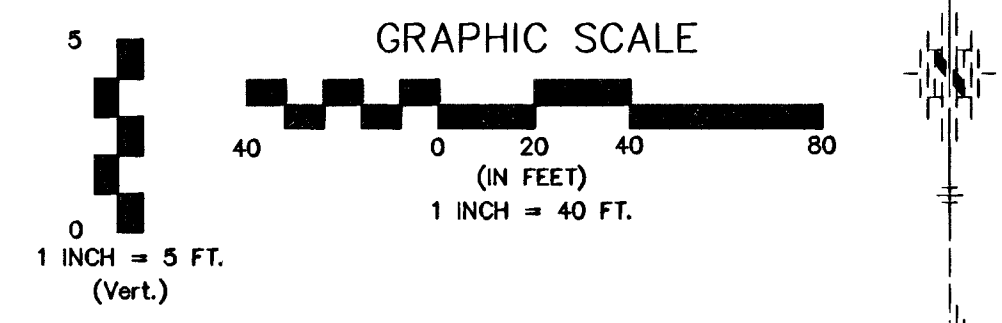
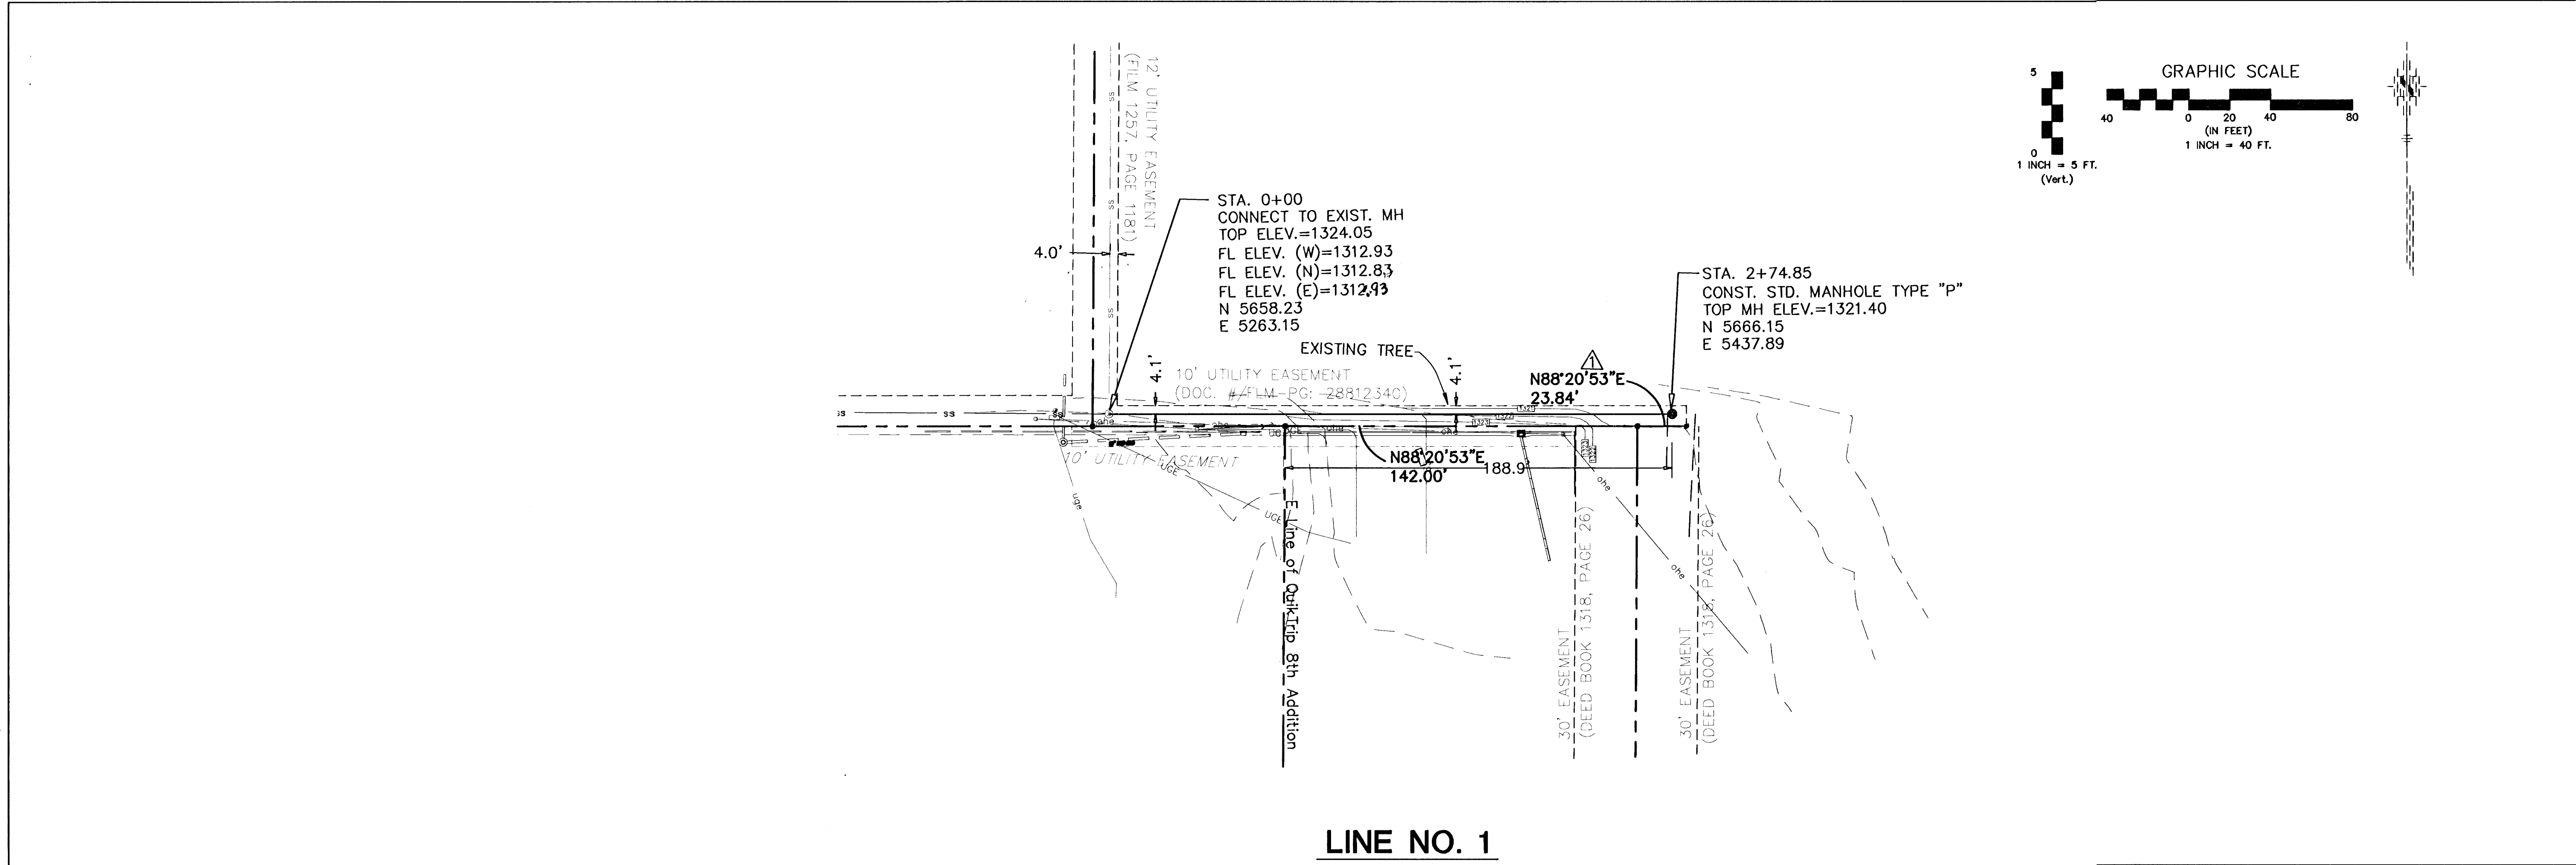


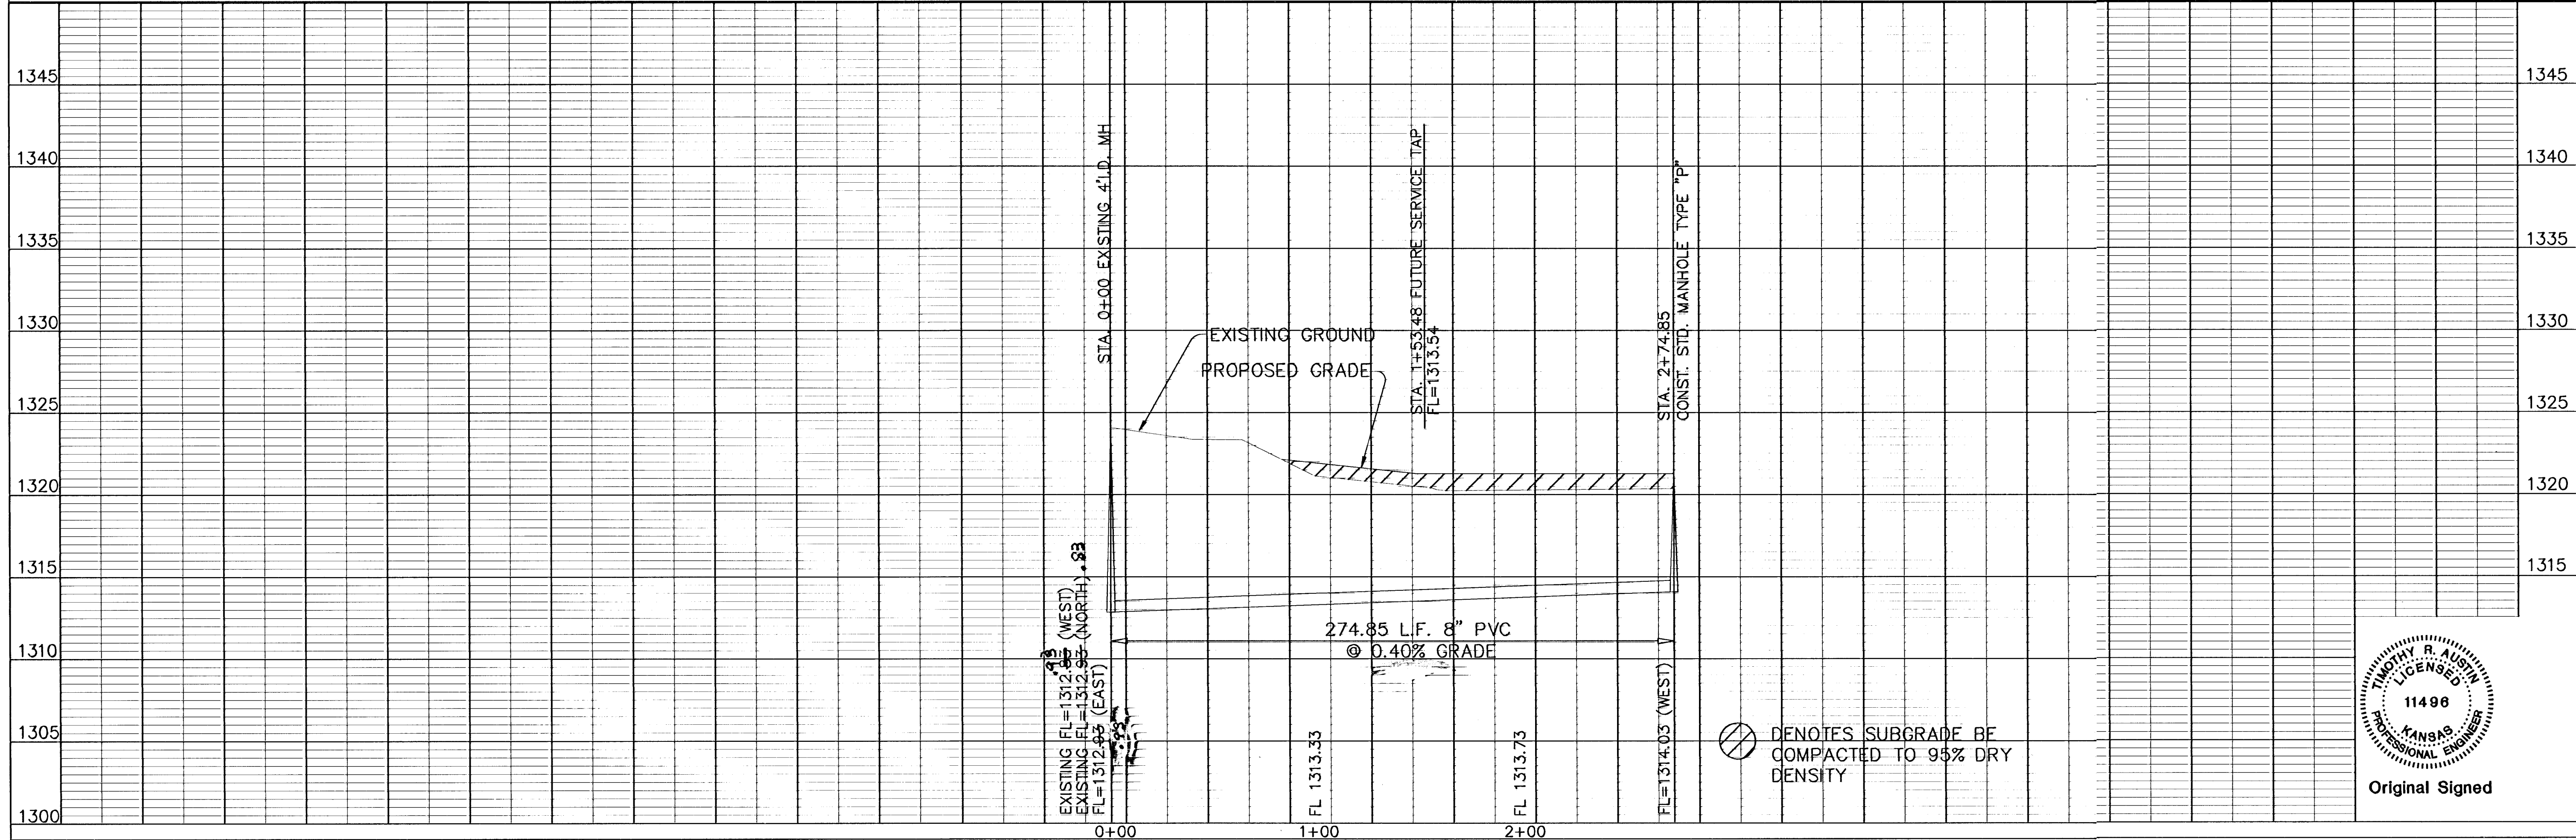

QUICKTRIP #315 SANITARY & STORM SEWER IMPROVEMENTS SANITARY SEWER PLAN & PROFILE CITY OF WICHITA, KANSAS JAMES ARMOUR, P.E. - CITY ENGINEER 1711 PPS (607861)		POE & ASSOCIATES, INC. CONSULTING ENGINEERS 5940 E. Central, Suite 200, Wichita, KS 67208-4422 Phone 316/685-4114 FAX 316/685-4444	
Designed By: D. Trout Drawn By: D. Trout / A. Moss Poe Job No.: 1894-02 Date: 10/27/2006		Sheet 28 of 6	
Revision No. 1 Date 10/26/06		Extended Pipe 100' East & Relocated MH	