

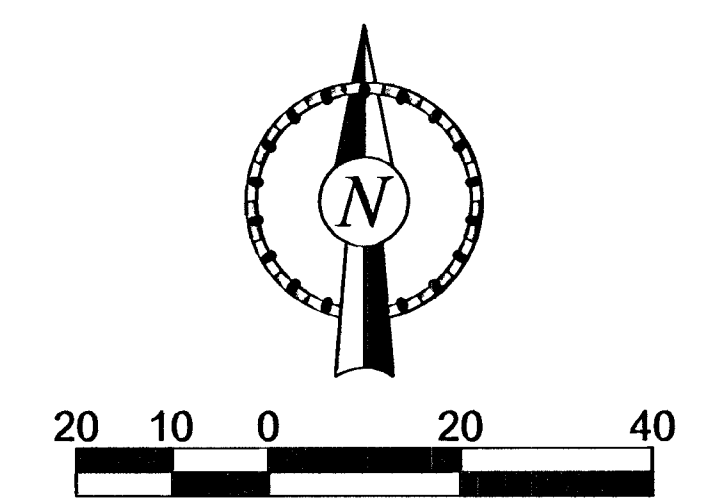
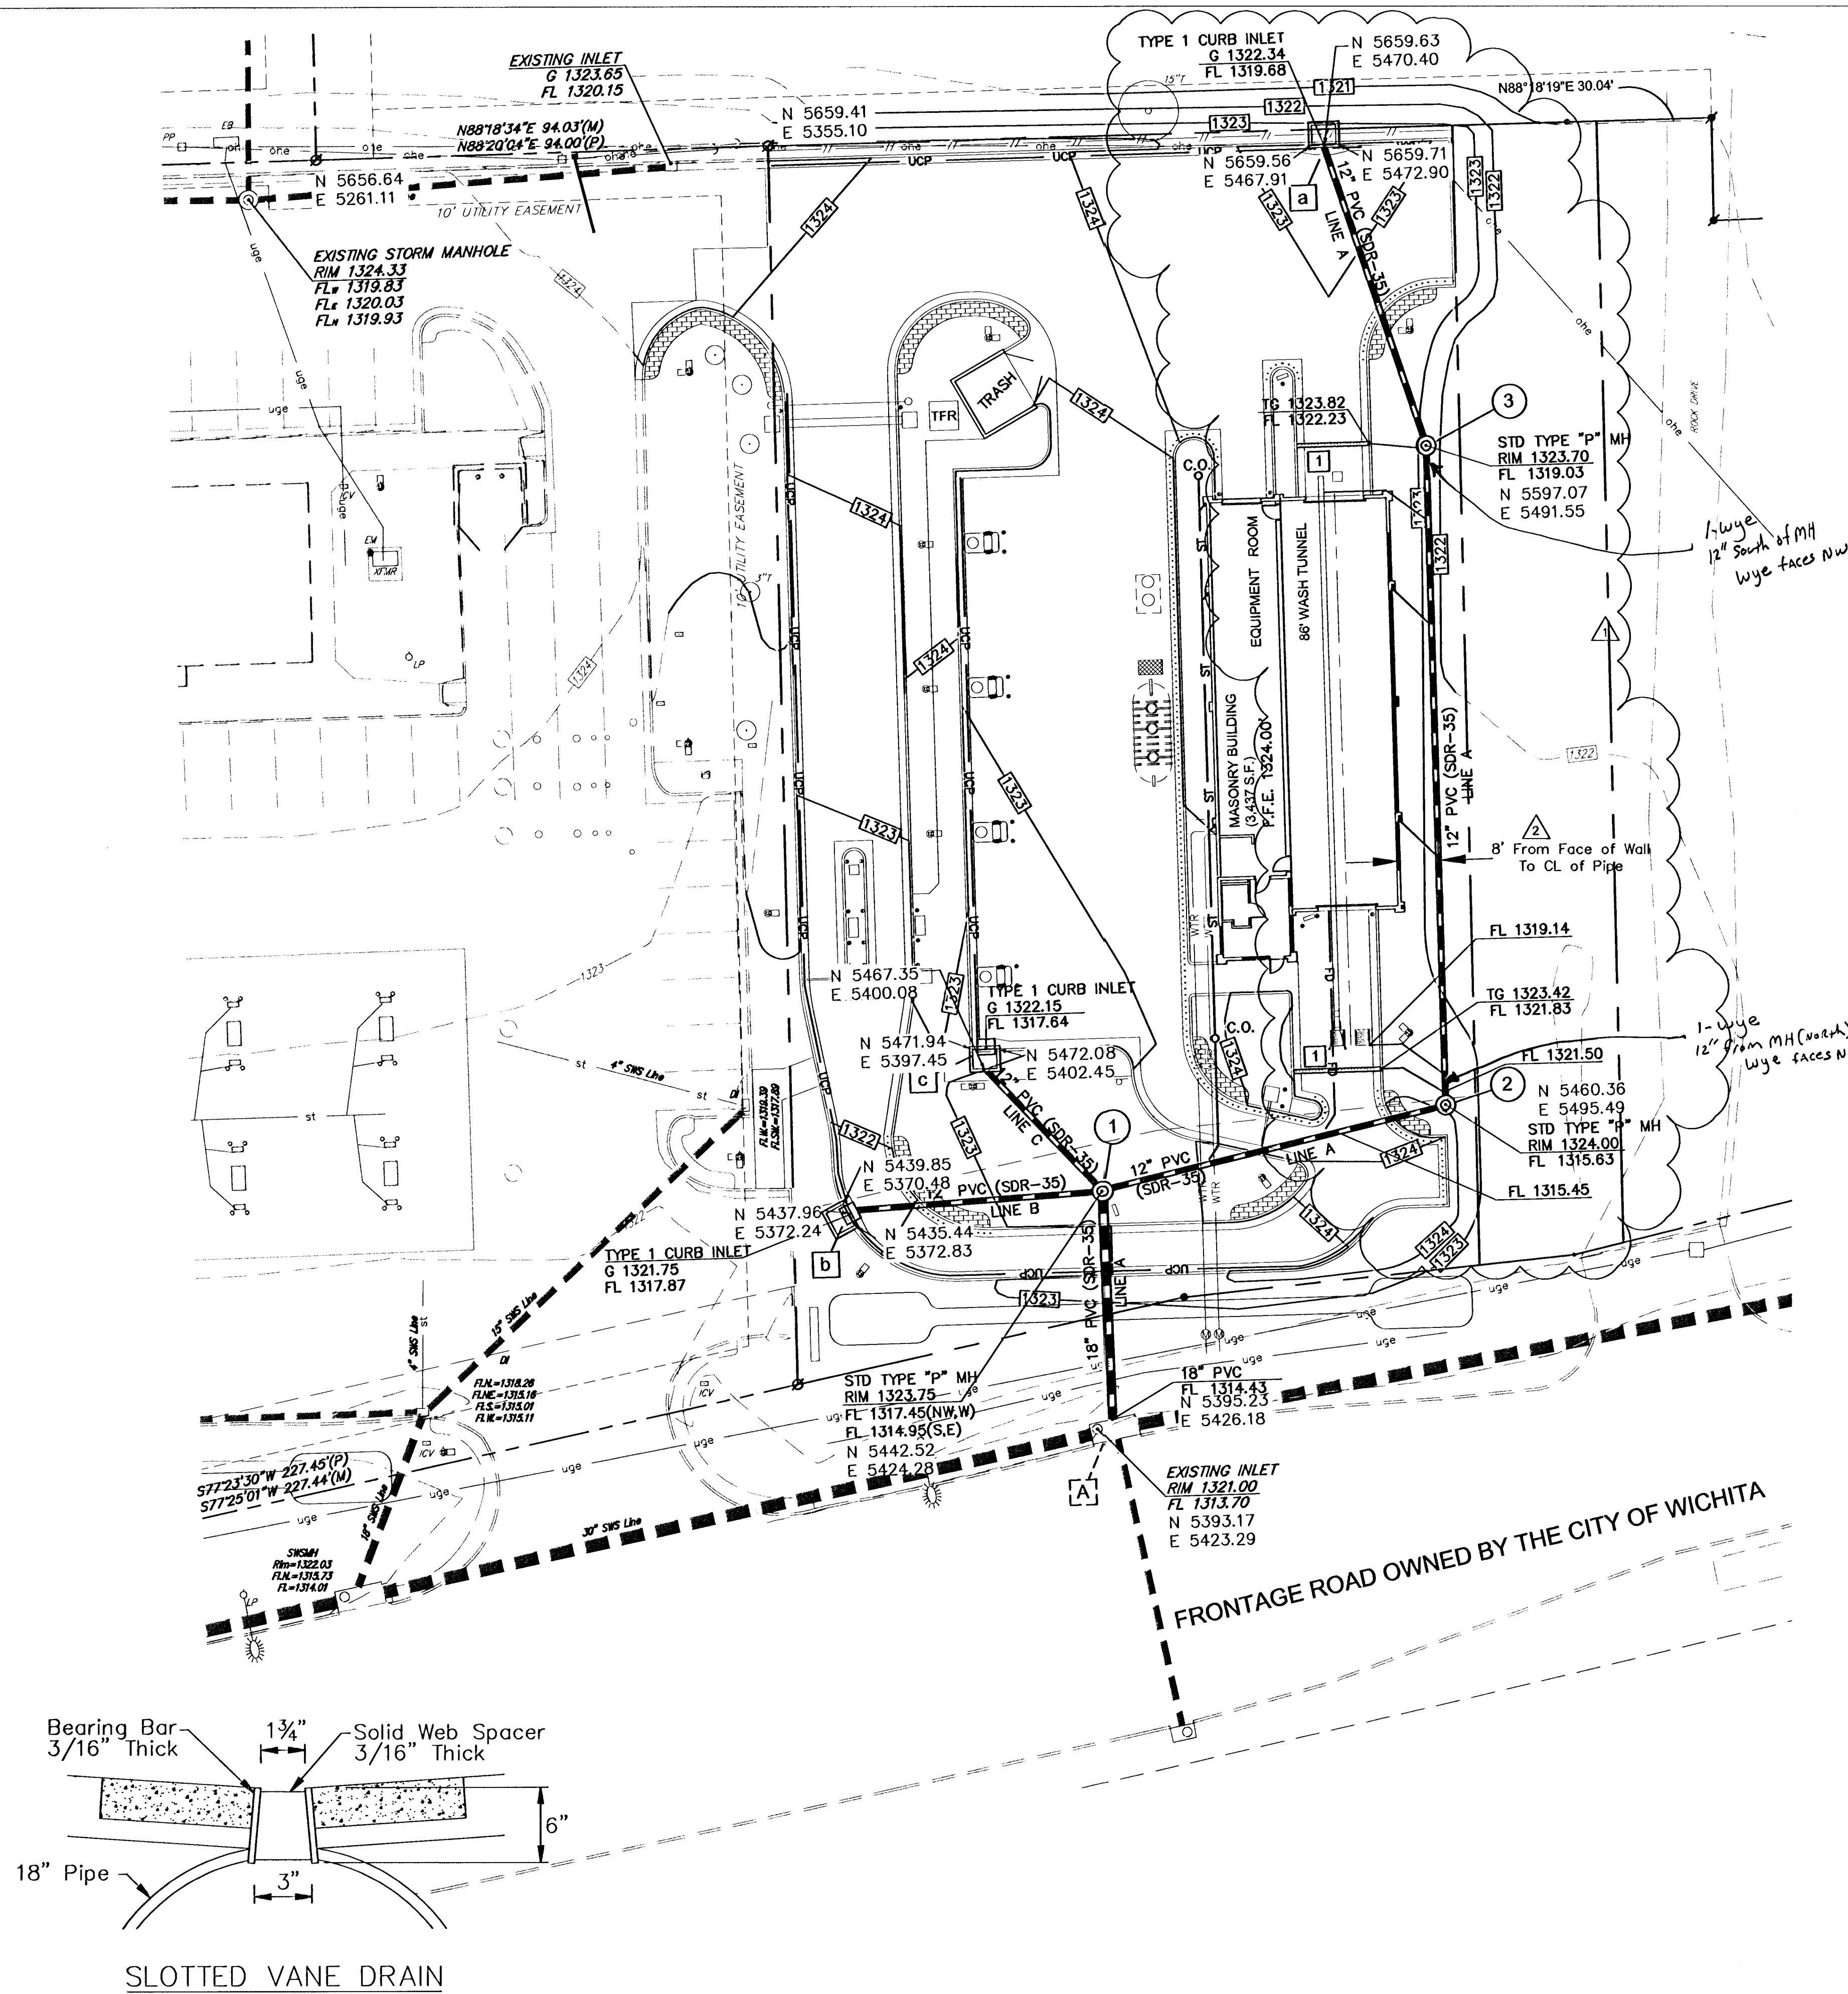
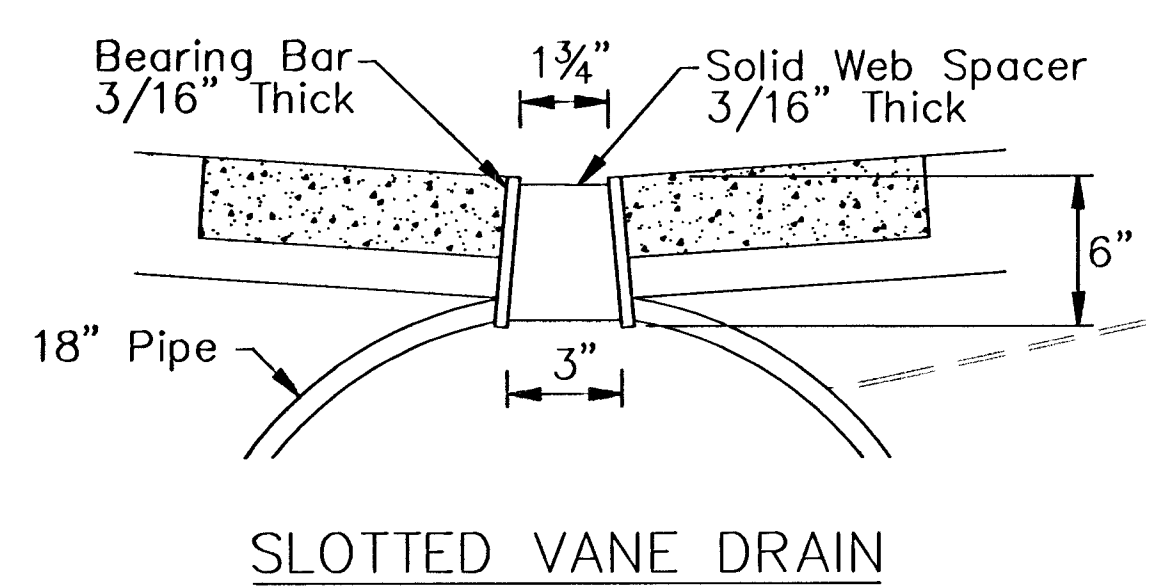
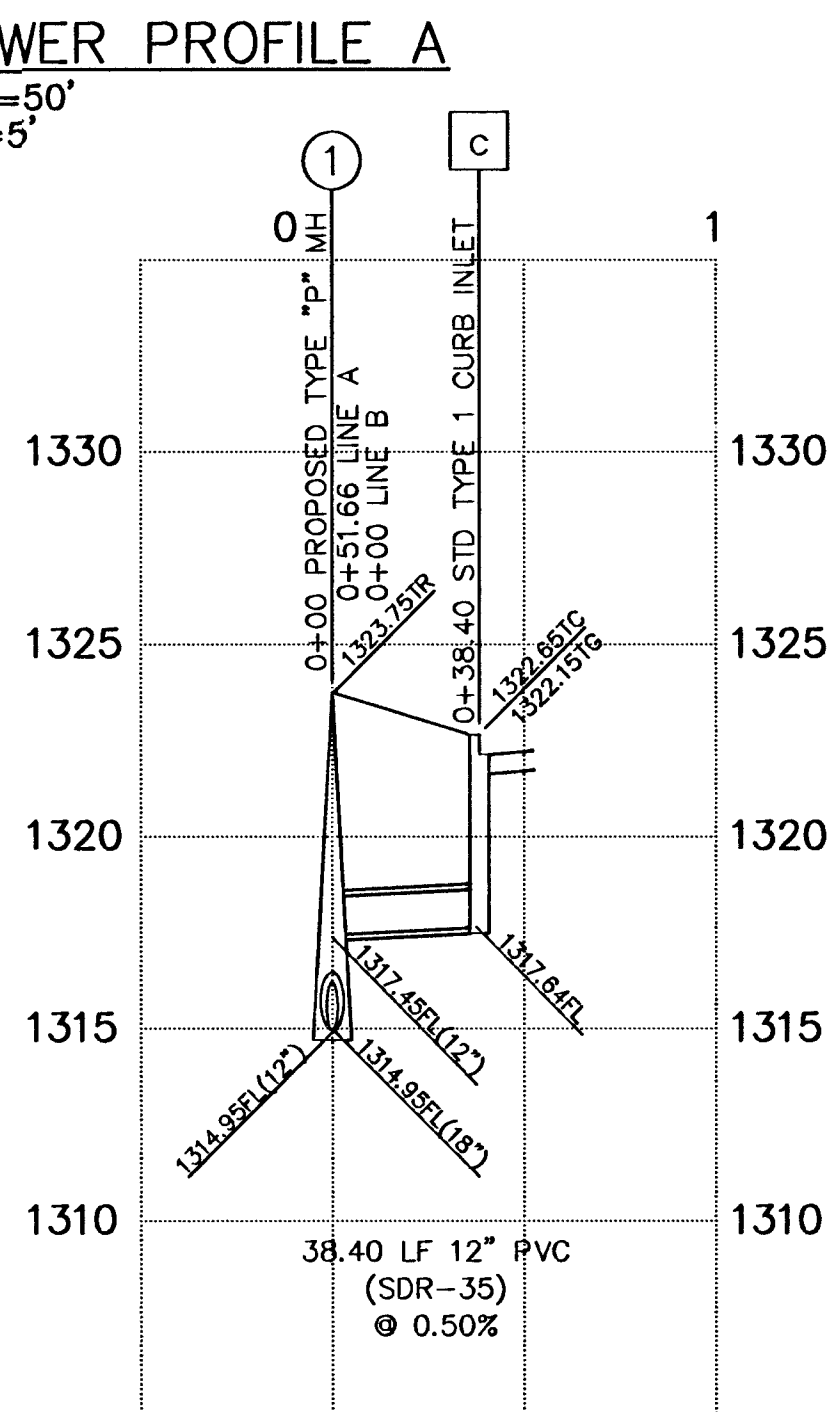


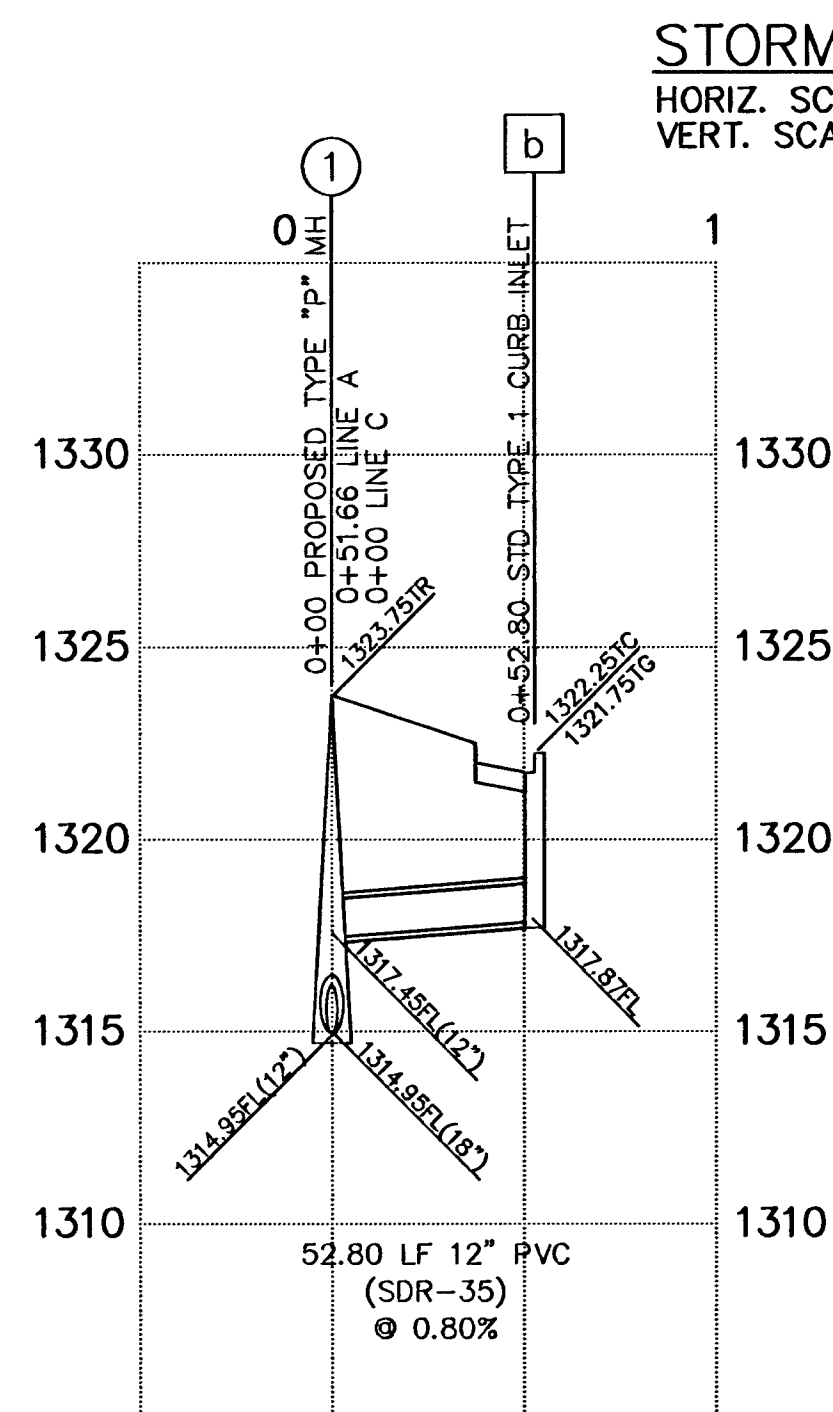

- LEGEND**
- STORM PIPE (10" AND SMALLER)
 - STORM PIPE (12" AND LARGER)
 - FD FRENCH DRAIN
 - UCP DRAIN UNDER CURB OR PAVEMENT
 - MAJOR CONTOUR (NEW)
 - MINOR CONTOUR (NEW)
 - MAJOR CONTOUR (EXISTING)
 - MINOR CONTOUR (EXISTING)
- KEY NOTES:**
- 1 SLOTTED VANE DRAIN (SEE DETAIL THIS SHEET)

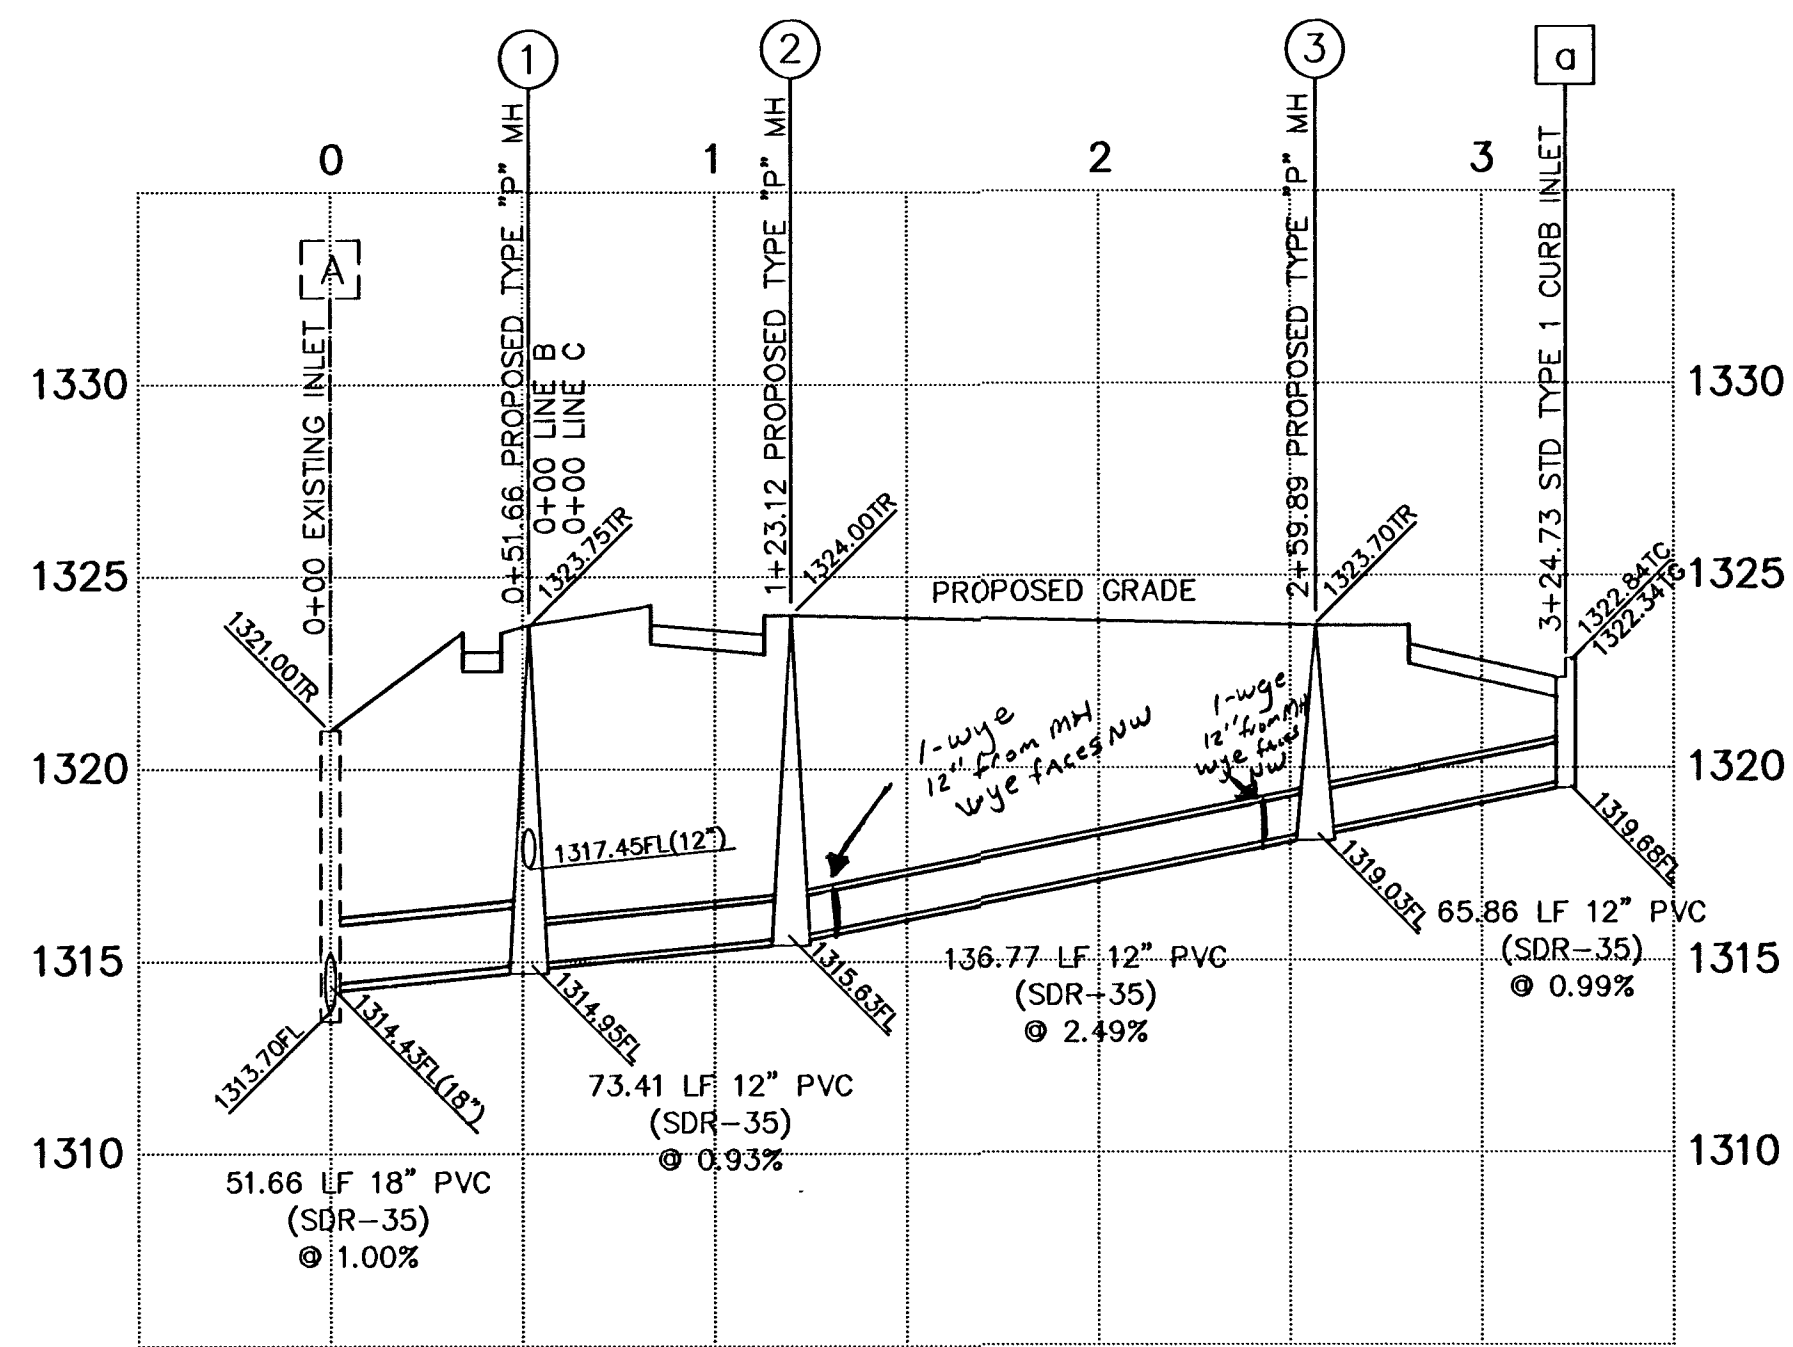

REVISED 01/25/2007

FINAL Designed By: HRA Drawn By: JRB/A. Moss/S. Schmitt Pw Job No.: 1894/02-315/storm-rev.dwg Date: 01/19/2007	POE & ASSOCIATES, INC. CONSULTING ENGINEERS 5940 E. Central, Suite 200 • Wichita, KS 67208-4242 Phone 316/685-4114 • FAX 316/685-4444	QUICKTRIP #315 SANITARY & STORM SEWER IMPROVEMENTS STORM SEWER PLAN AND PROFILES CITY OF WICHITA, KANSAS JAMES ARMOUR, P.E. - CITY ENGINEER 1711 PPS (60786)	Revision Relocated East Line & Manholes to 6' East of Proposed Building Face and added coordinates Relocated East Line & Manholes to 6' East of Proposed Building Face and added coordinates Relocated East Line & Manholes to 6' East of Proposed Building Face and added coordinates
		Approved By: SS Date: 01/19/07 No. 1	Approved By: SS Date: 01/25/07 No. 2
		Approved By: SS Date: 01/25/07 No. 3	Approved By: SS Date: 01/25/07 No. 4
		Approved By: SS Date: 01/25/07 No. 5	Approved By: SS Date: 01/25/07 No. 6