
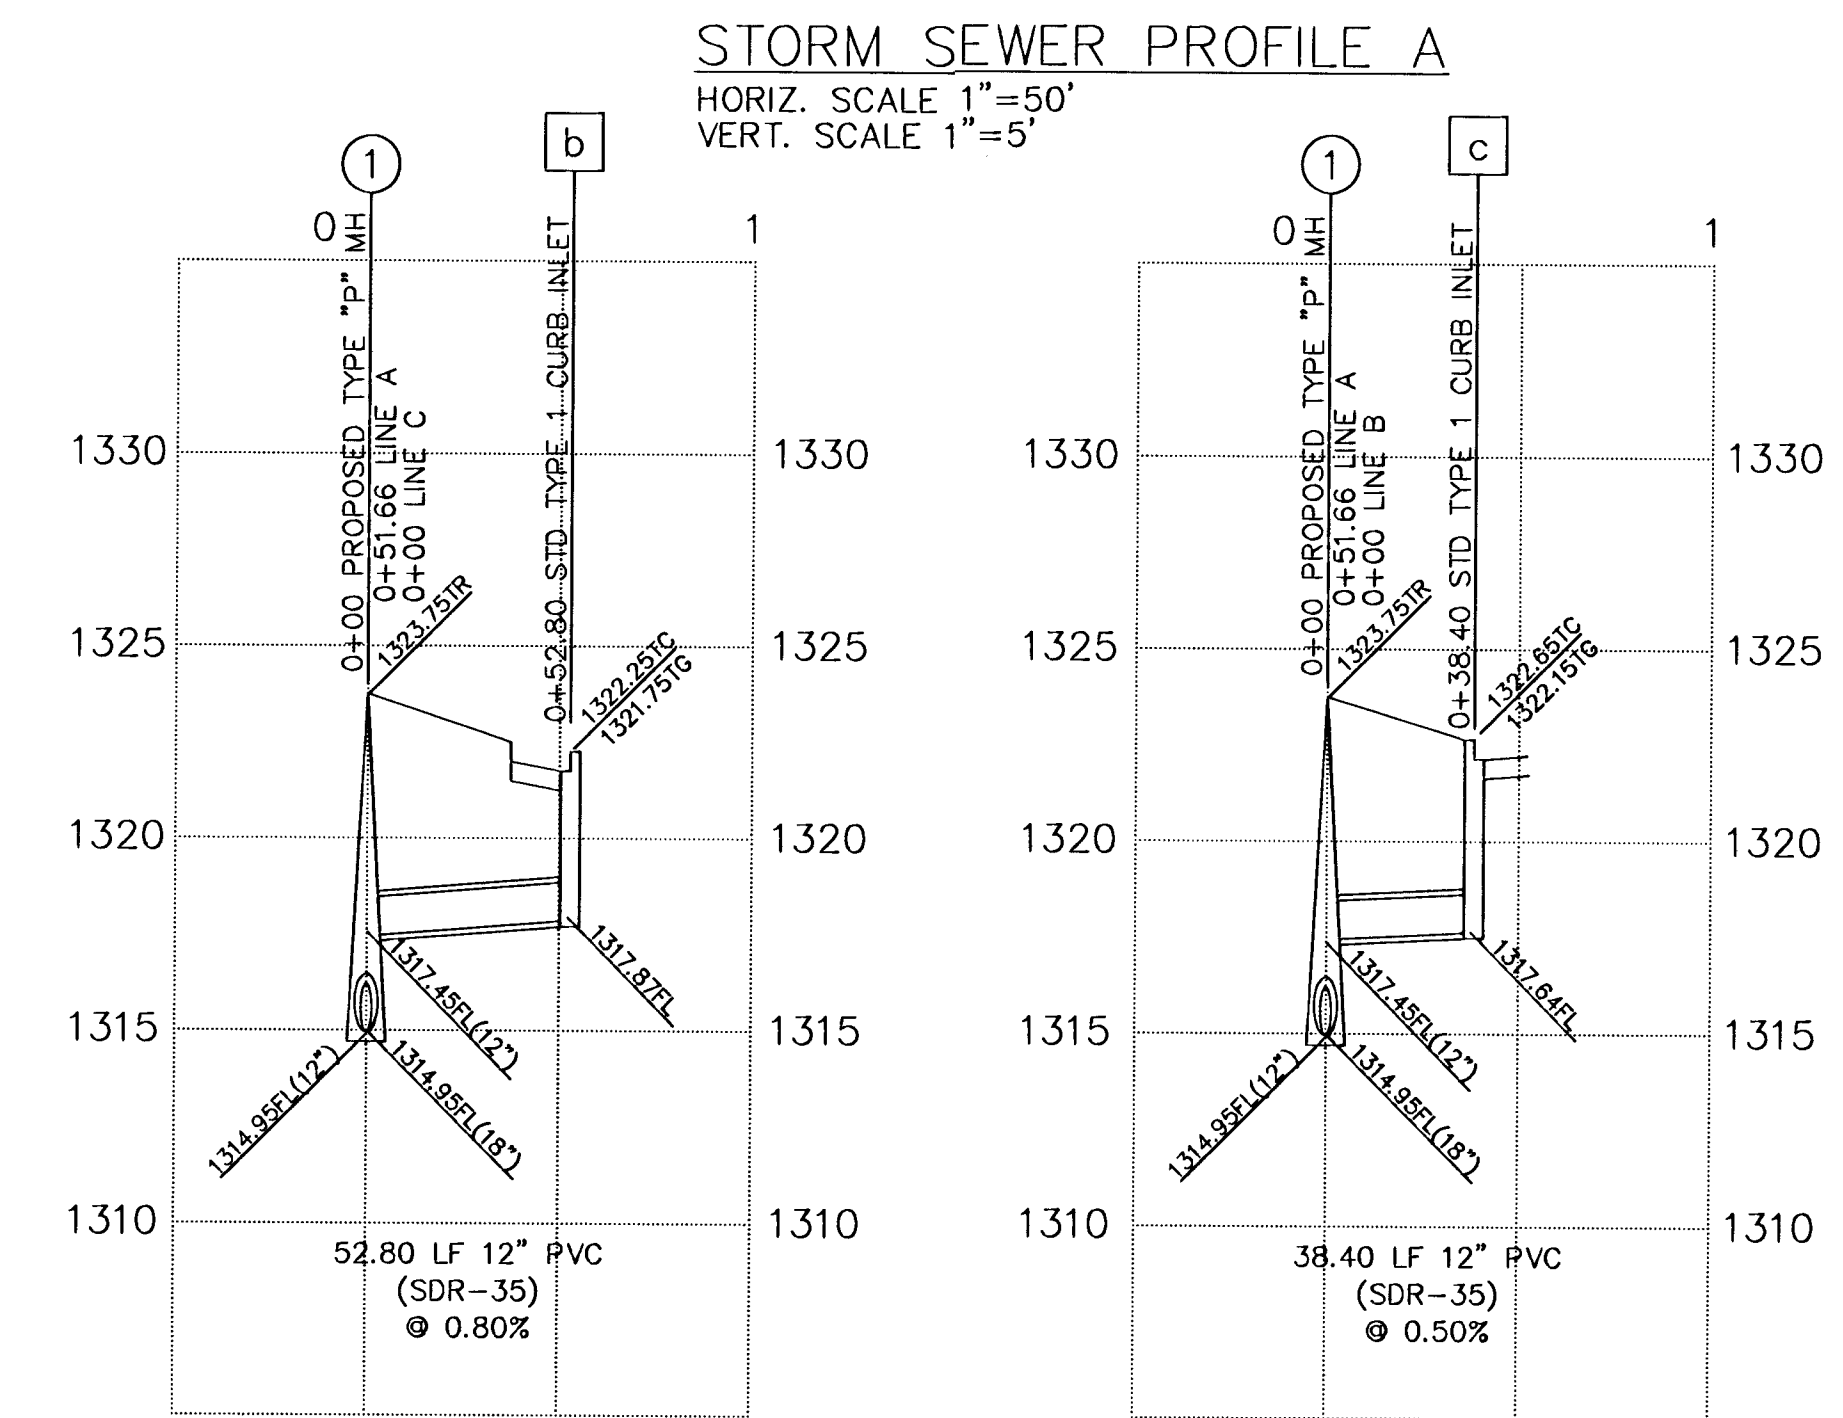
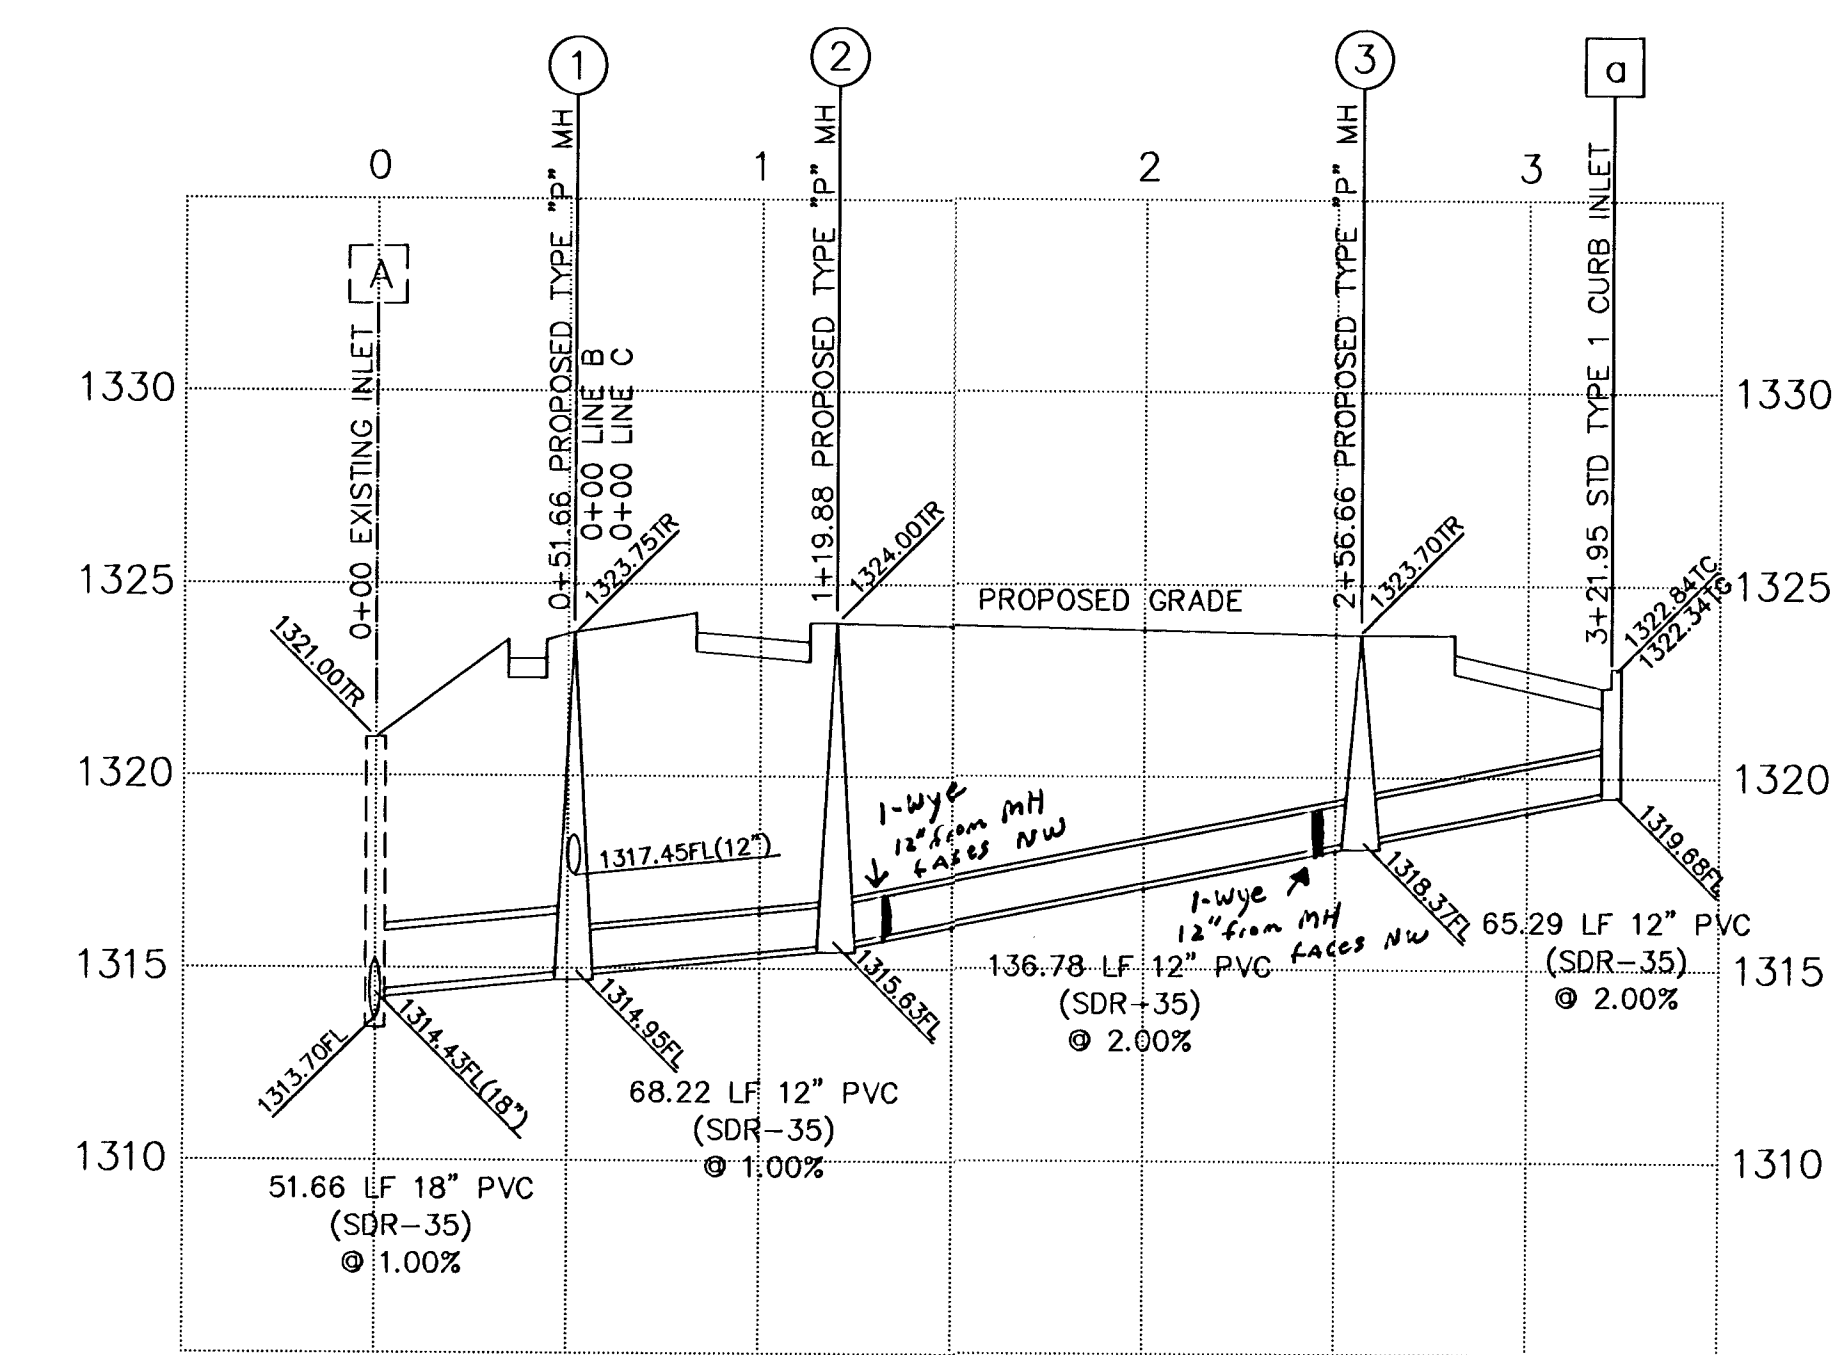
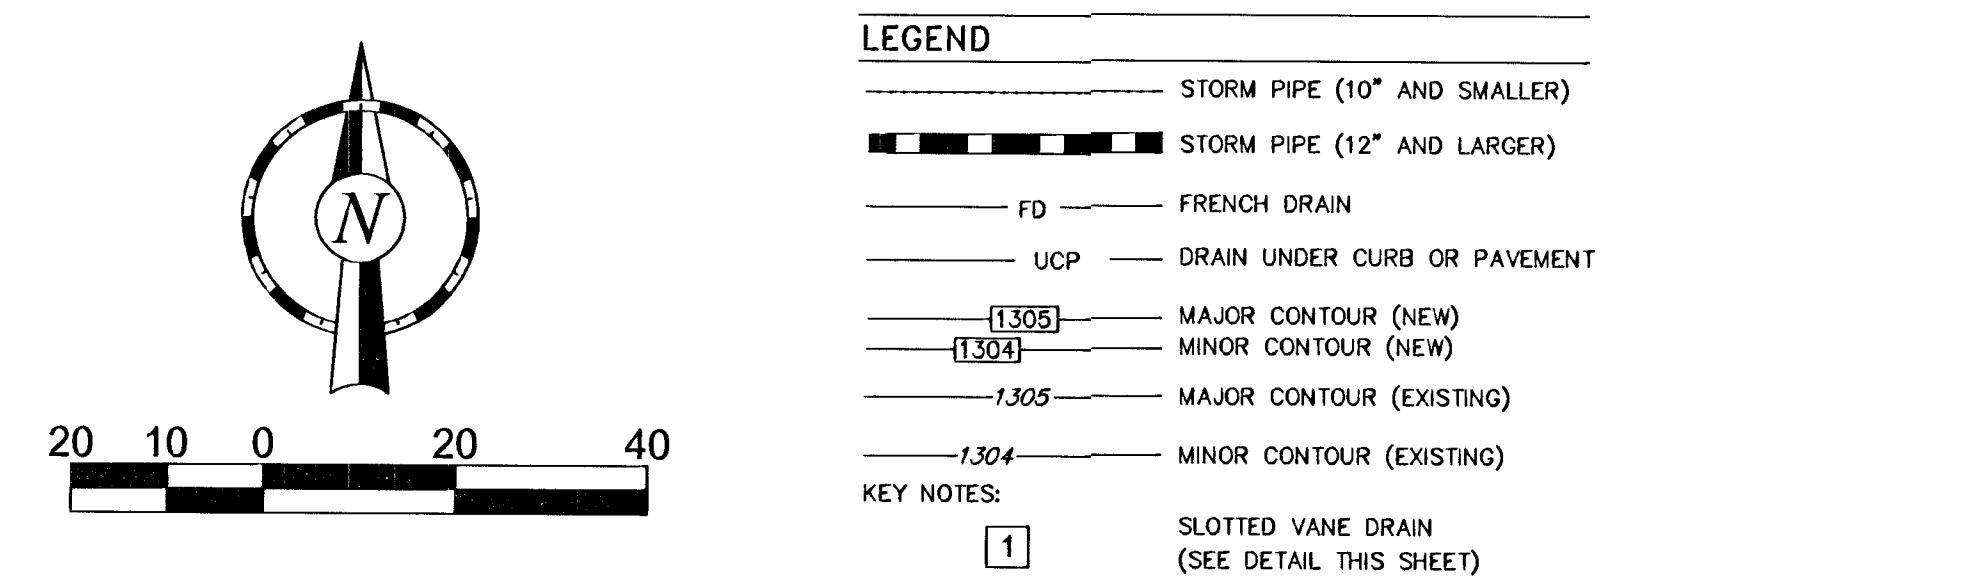


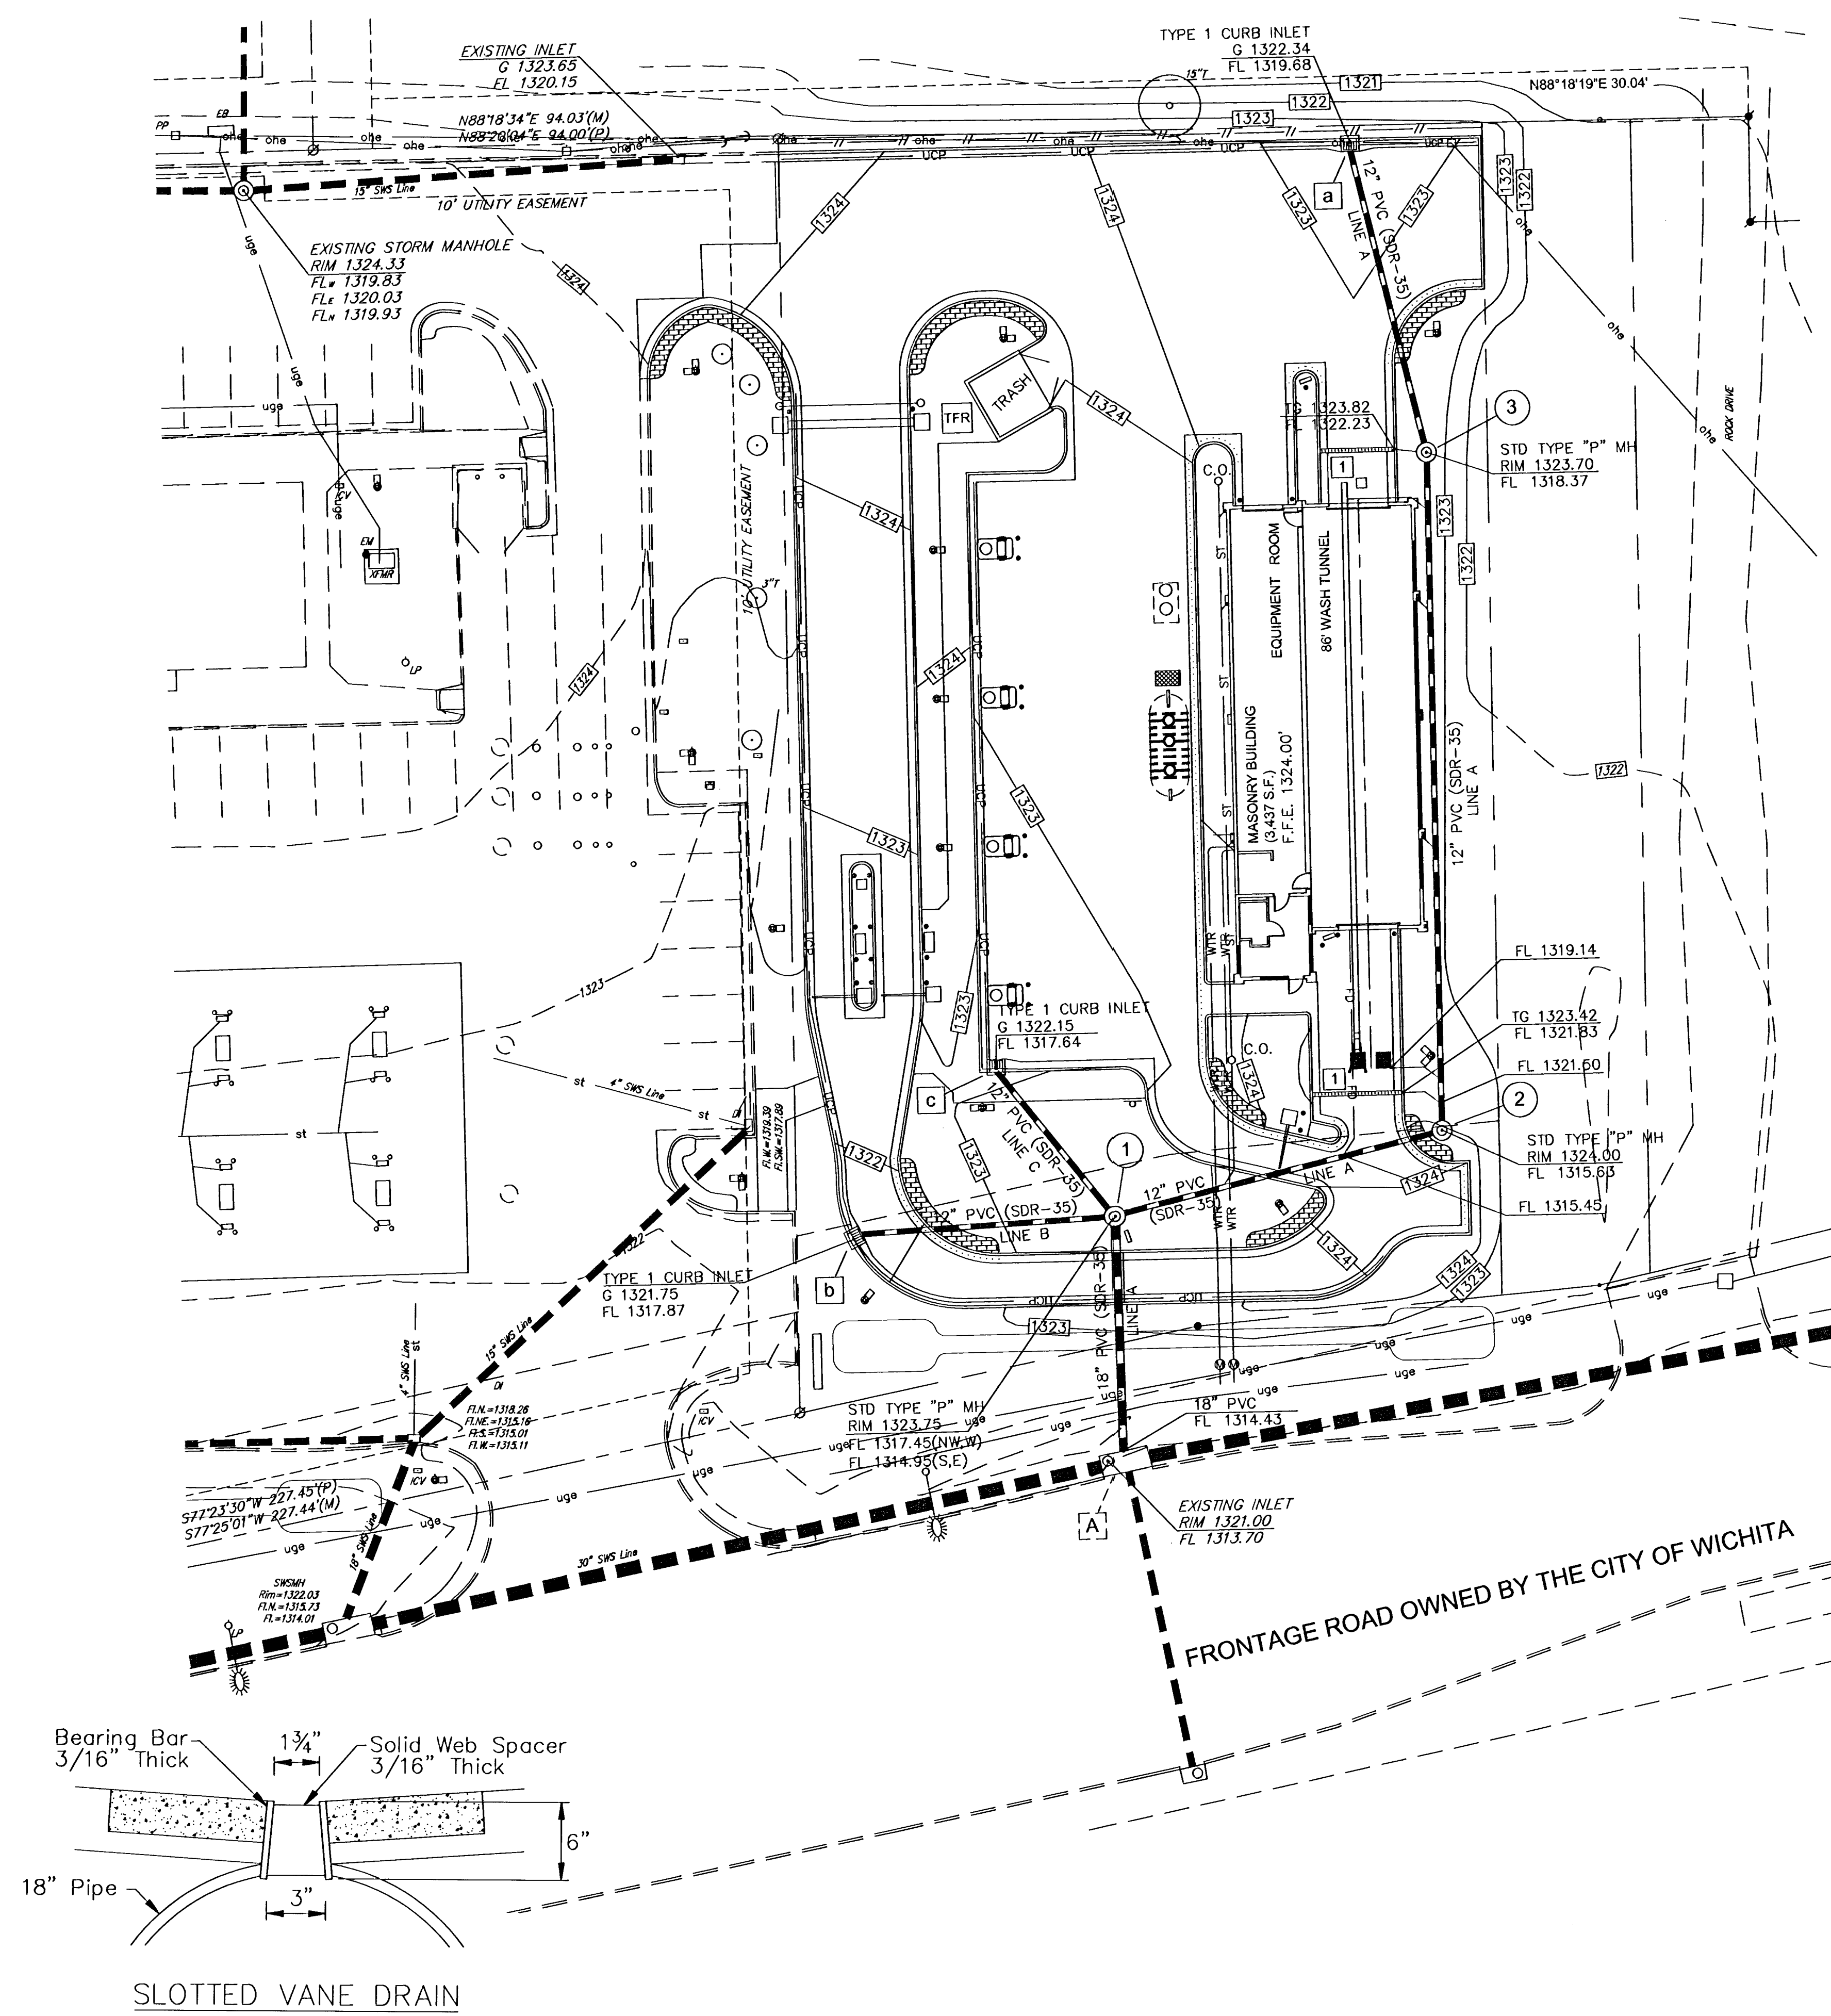

STORM SEWER PROFILE B
HORIZ. SCALE 1"=50'
VERT. SCALE 1"=5'

STORM SEWER PROFILE C
HORIZ. SCALE 1"=50'
VERT. SCALE 1"=5'

QUICKTRIP #315 SANITARY & STORM SEWER IMPROVEMENTS STORM SEWER PLAN AND PROFILES CITY OF WICHITA, KANSAS JAMES ARMOUR, P.E. - CITY ENGINEER 1711 PPS (60786)	No.	Date	By	Approved	Revision

POE & ASSOCIATES, INC. CONSULTING ENGINEERS 5940 E. Central, Suite 200 ■ Wichita, KS 67208-4242 Phone 316/685-4114 ■ FAX 316/685-4444	

FINAL	Designed By: HRA
	Drawn By: JRB/A. Moss
	Poe Job No.: 1894-02
	Date: 10/20/2006