

BENCHMARK:
Railroad Spike in East Face of
Power Pole, East of the NE Corner
of Lot 3, Northridge Plaza Addition
on East Side of Ridge Road
Elev. = 1335.05 M.S.L.



NORTHRIDGE
PLAZA
ADDITION
LOT #4

LOT #2

NORTHRIDGE
PLAZA
ADDITION
LOT #3



Scale: 1" = 20' Horizontal
1" = 5' Vertical
● = Iron

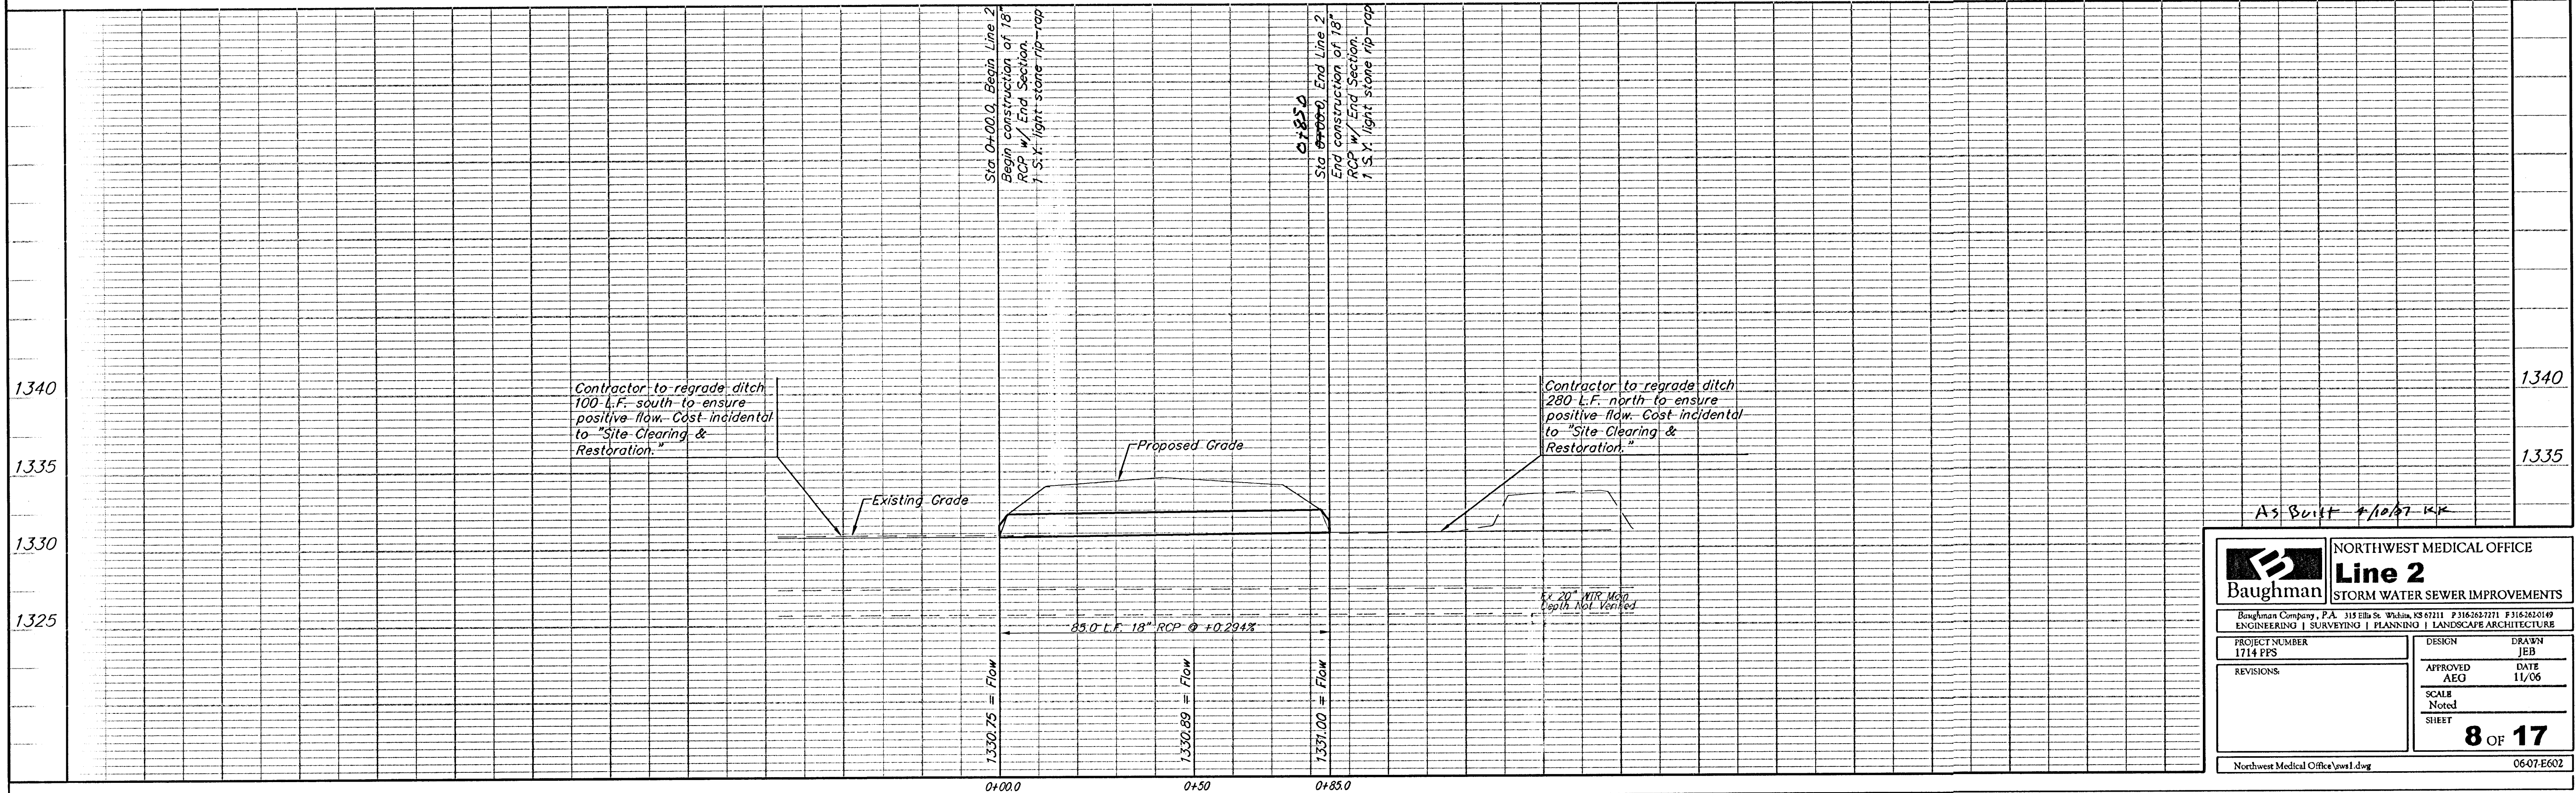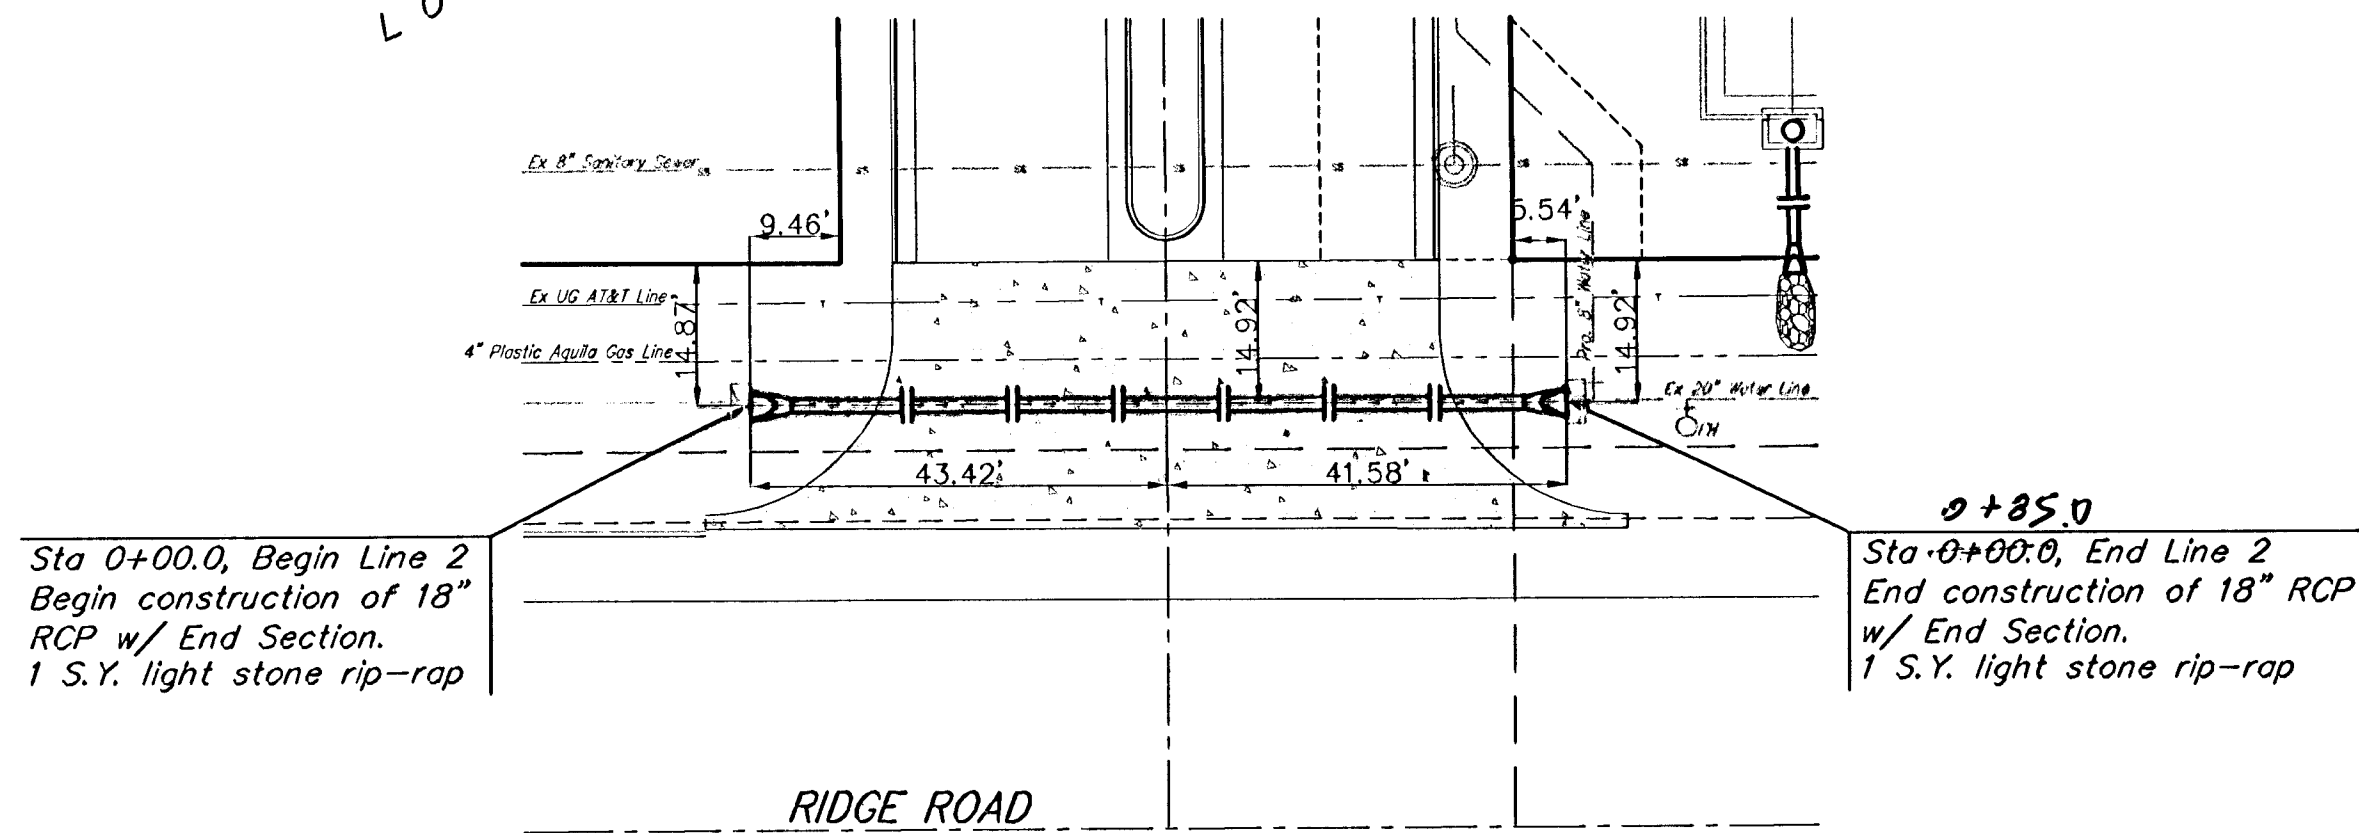

Baughman		NORTHWEST MEDICAL OFFICE	
ENGINEERING SURVEYING PLANNING LANDSCAPE ARCHITECTURE		STORM WATER SEWER IMPROVEMENTS	
PROJECT NUMBER 1714 PFS	DESIGN AEO	DRAWN JEB	DATE 11/06
REVISIONS	SCALE Noted	SHEET 8 OF 17	
Northwest Medical Office\pwn1.dwg		06-07-E602	