

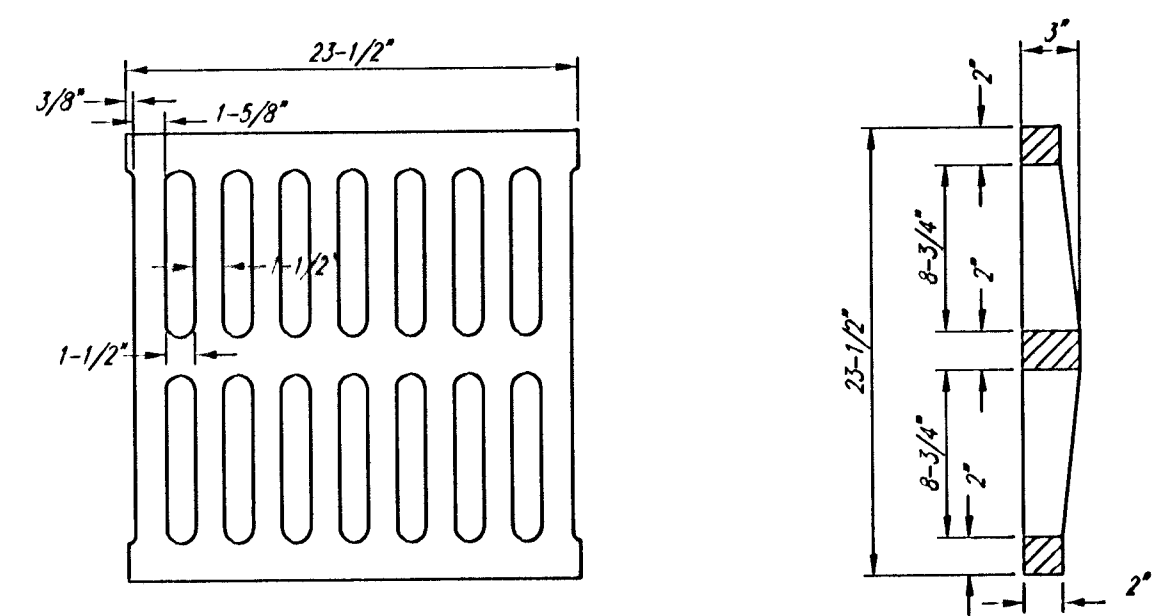


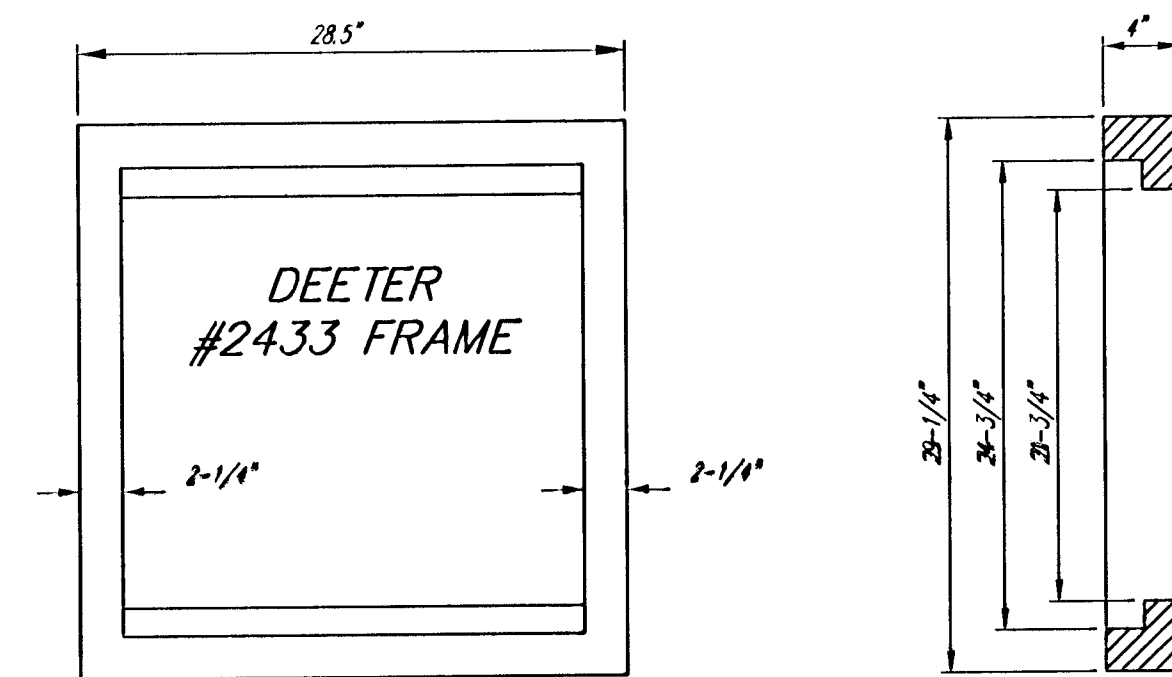



DEETER #2433 GRATE

24" x 24" Frame and Grate Detail

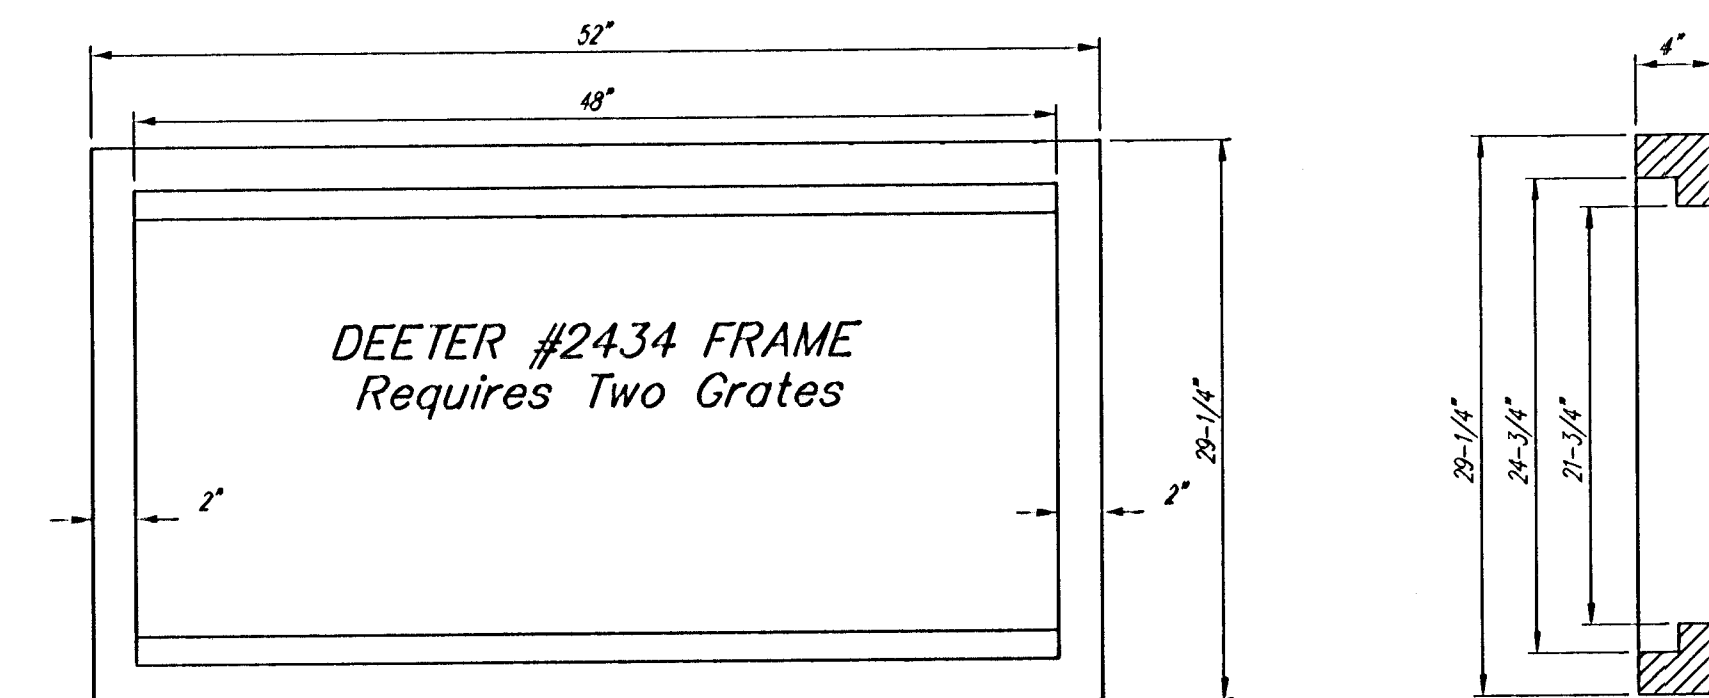


Double 24" x 24" Frame Detail

NOTE: Grates shall be imprinted on the top surface with "CITY OF WICHITA" using letters at least 1" in height. Other marking methods may be approved by the engineer.

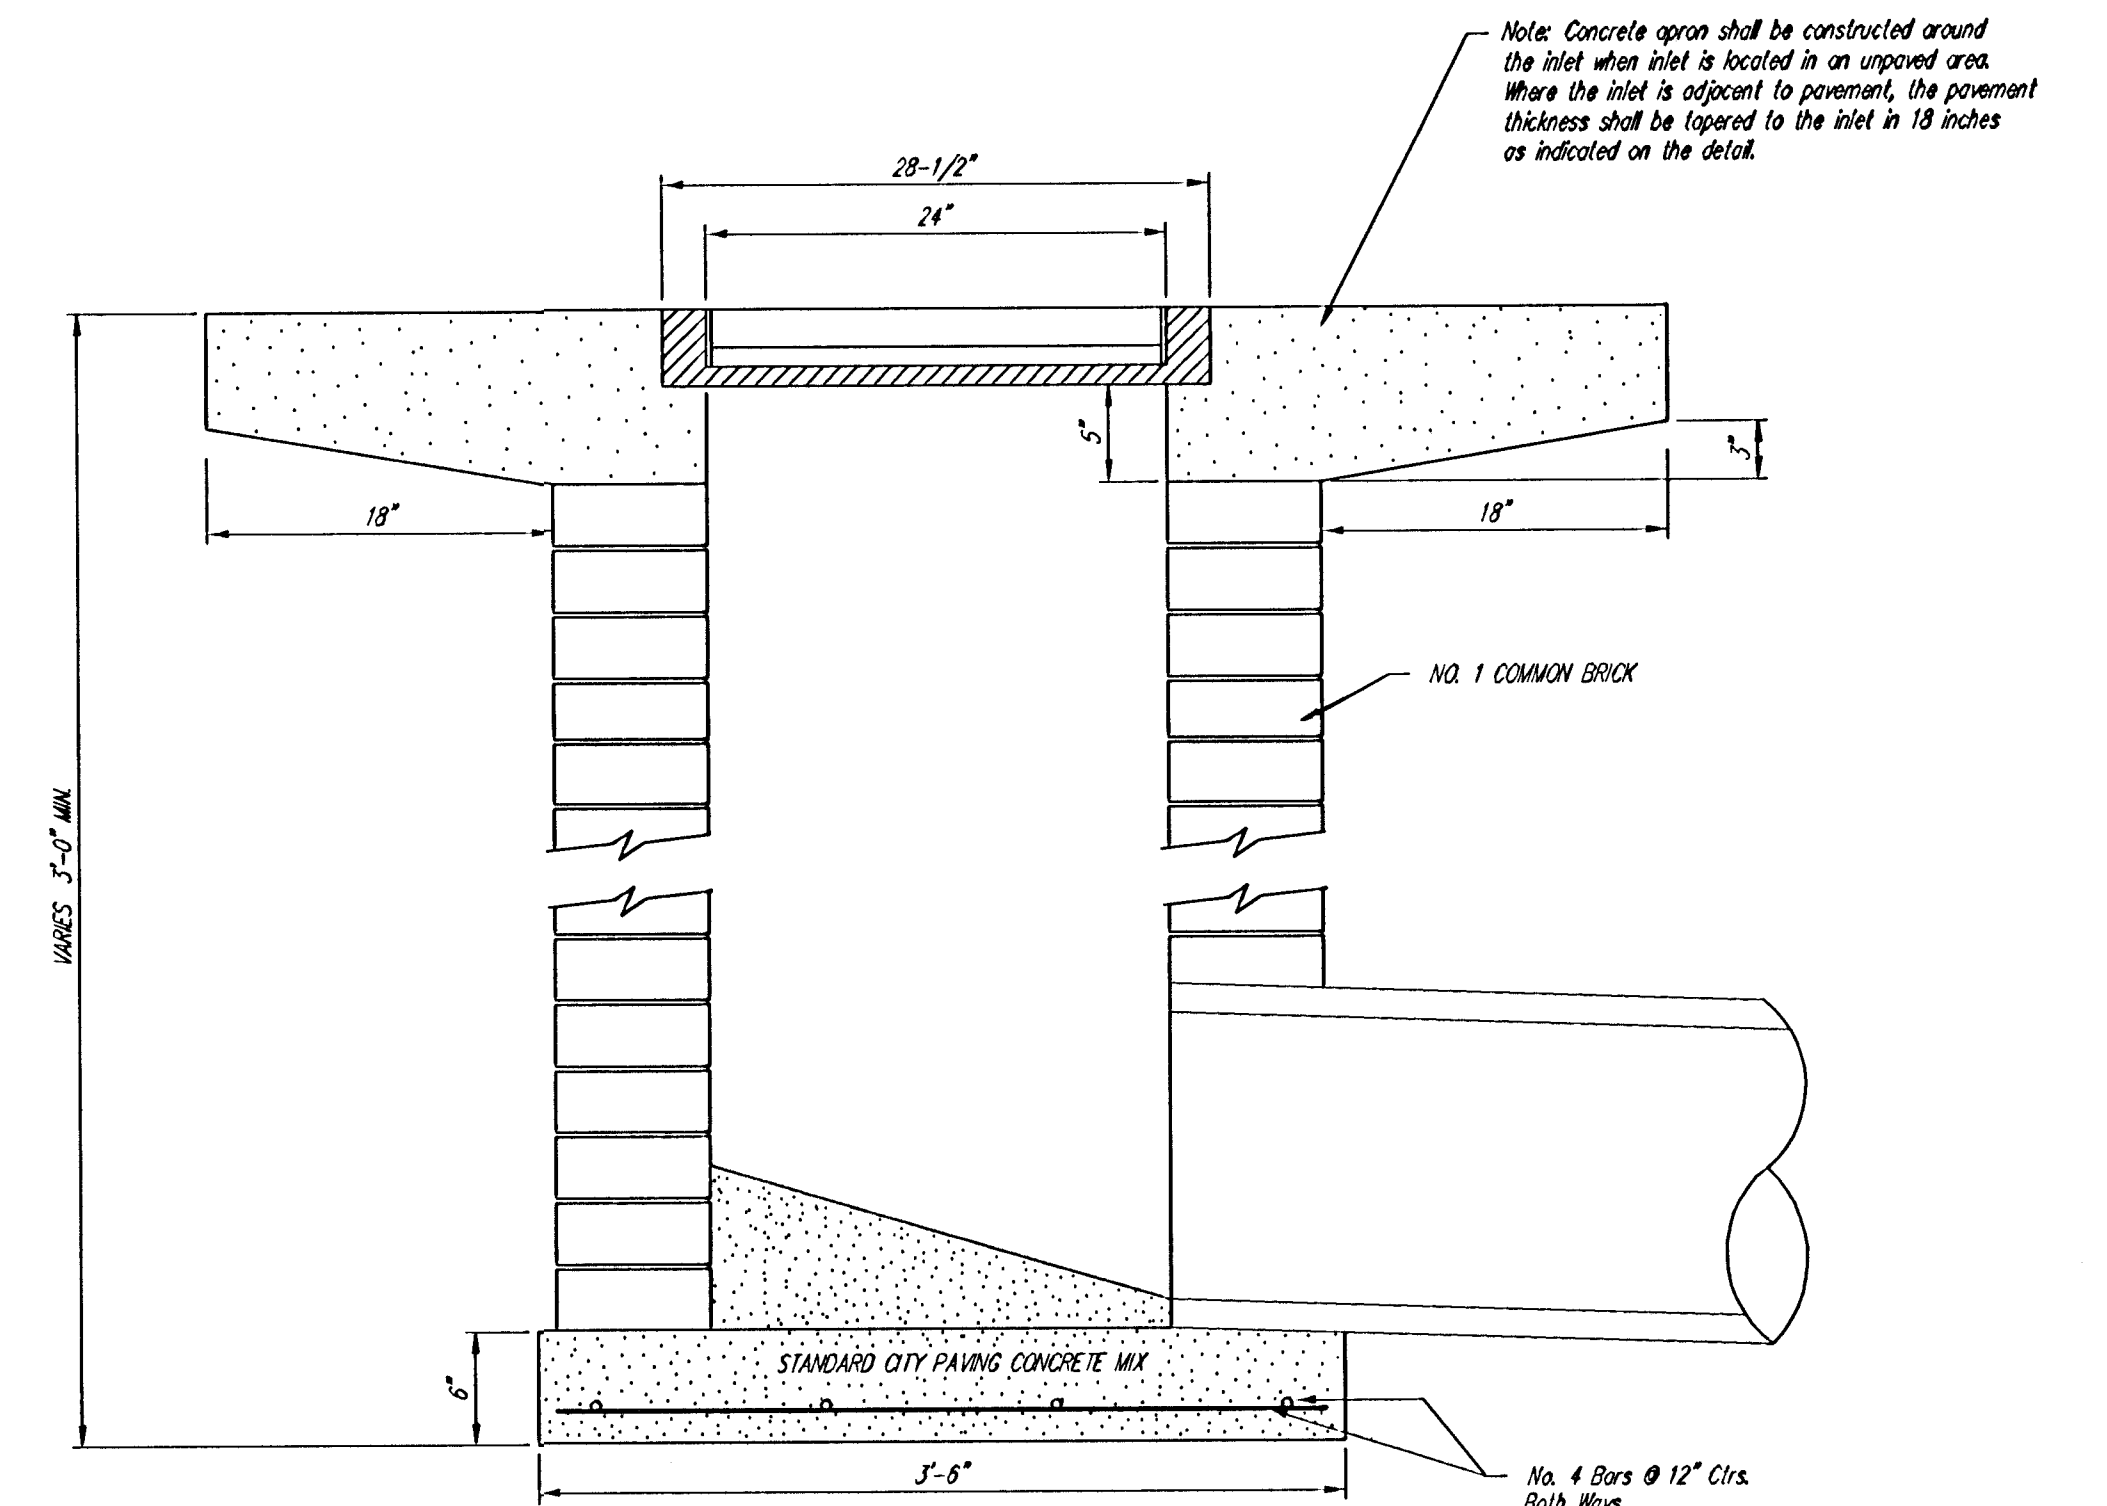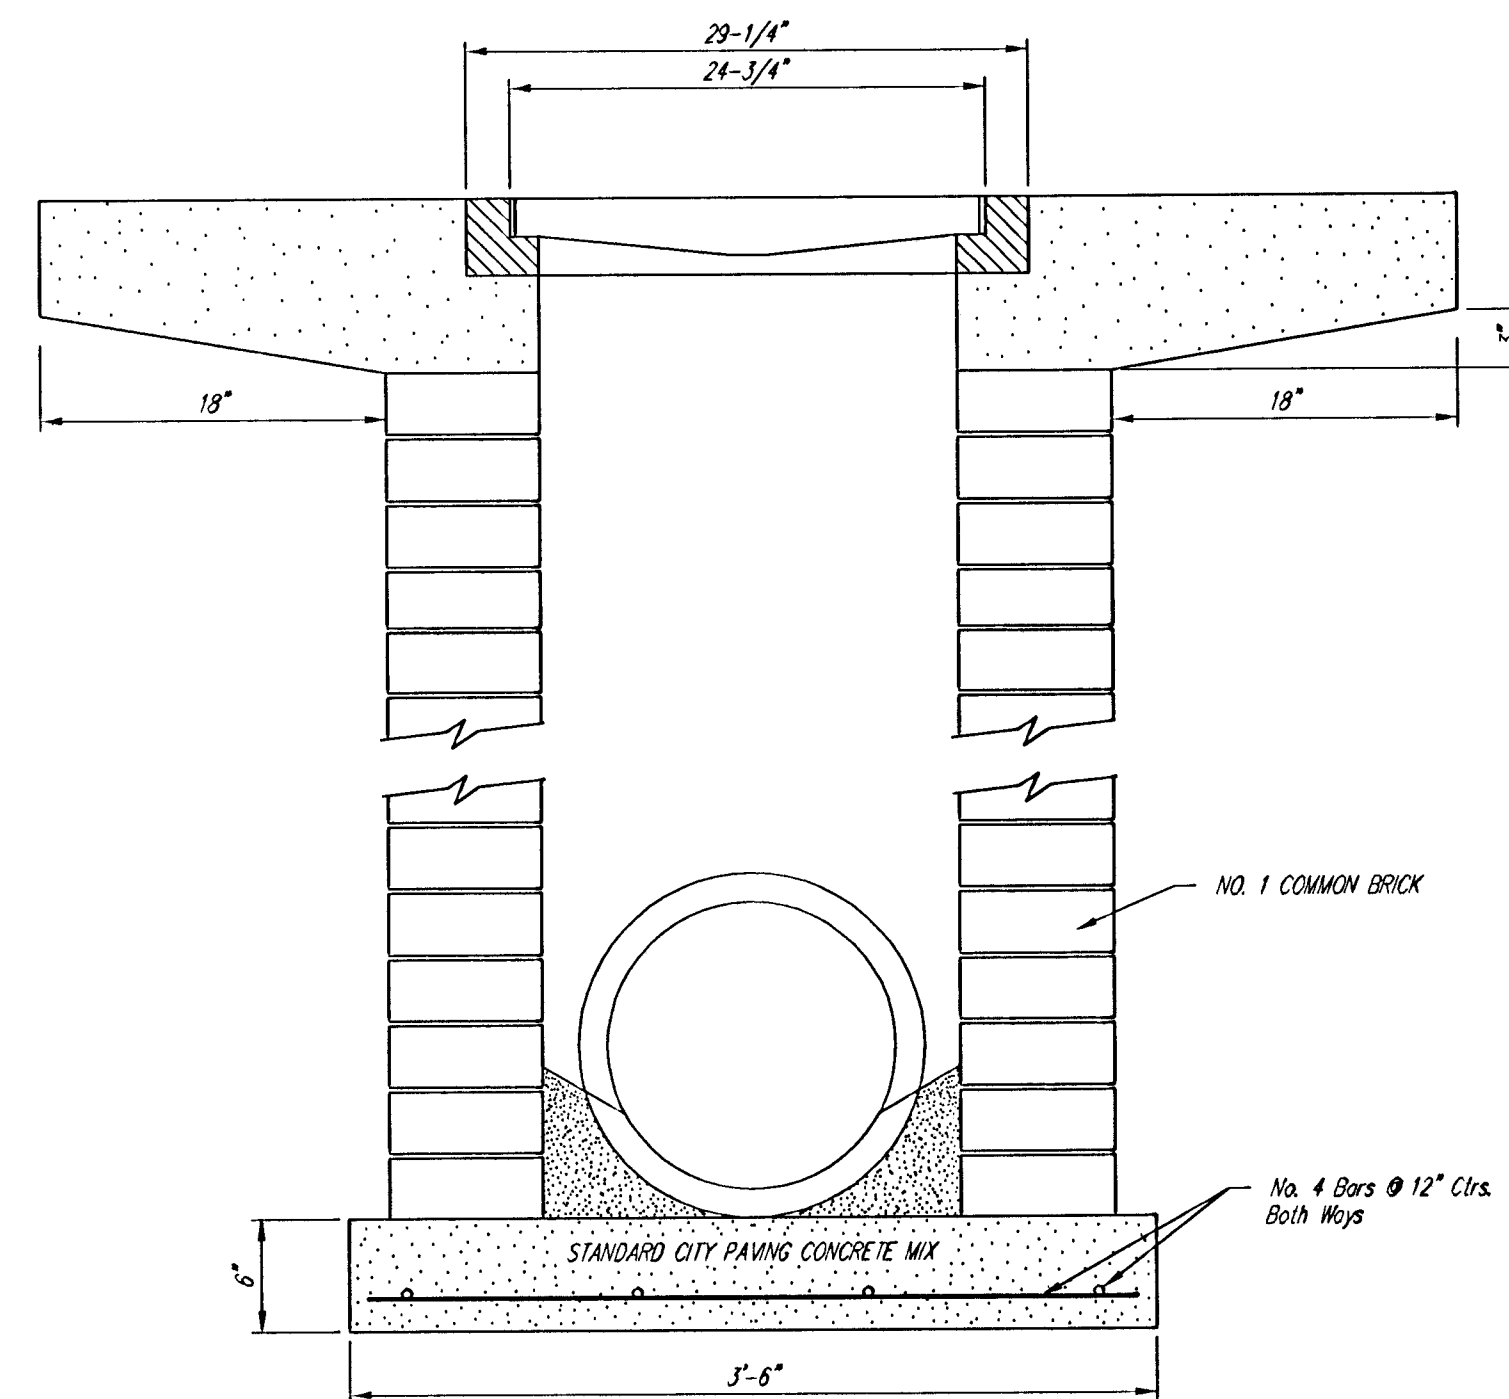

Note: Concrete apron shall be constructed around the inlet when inlet is located in an unpaved area. Where the inlet is adjacent to pavement, the pavement thickness shall be tapered to the inlet in 18 inches as indicated on the detail.

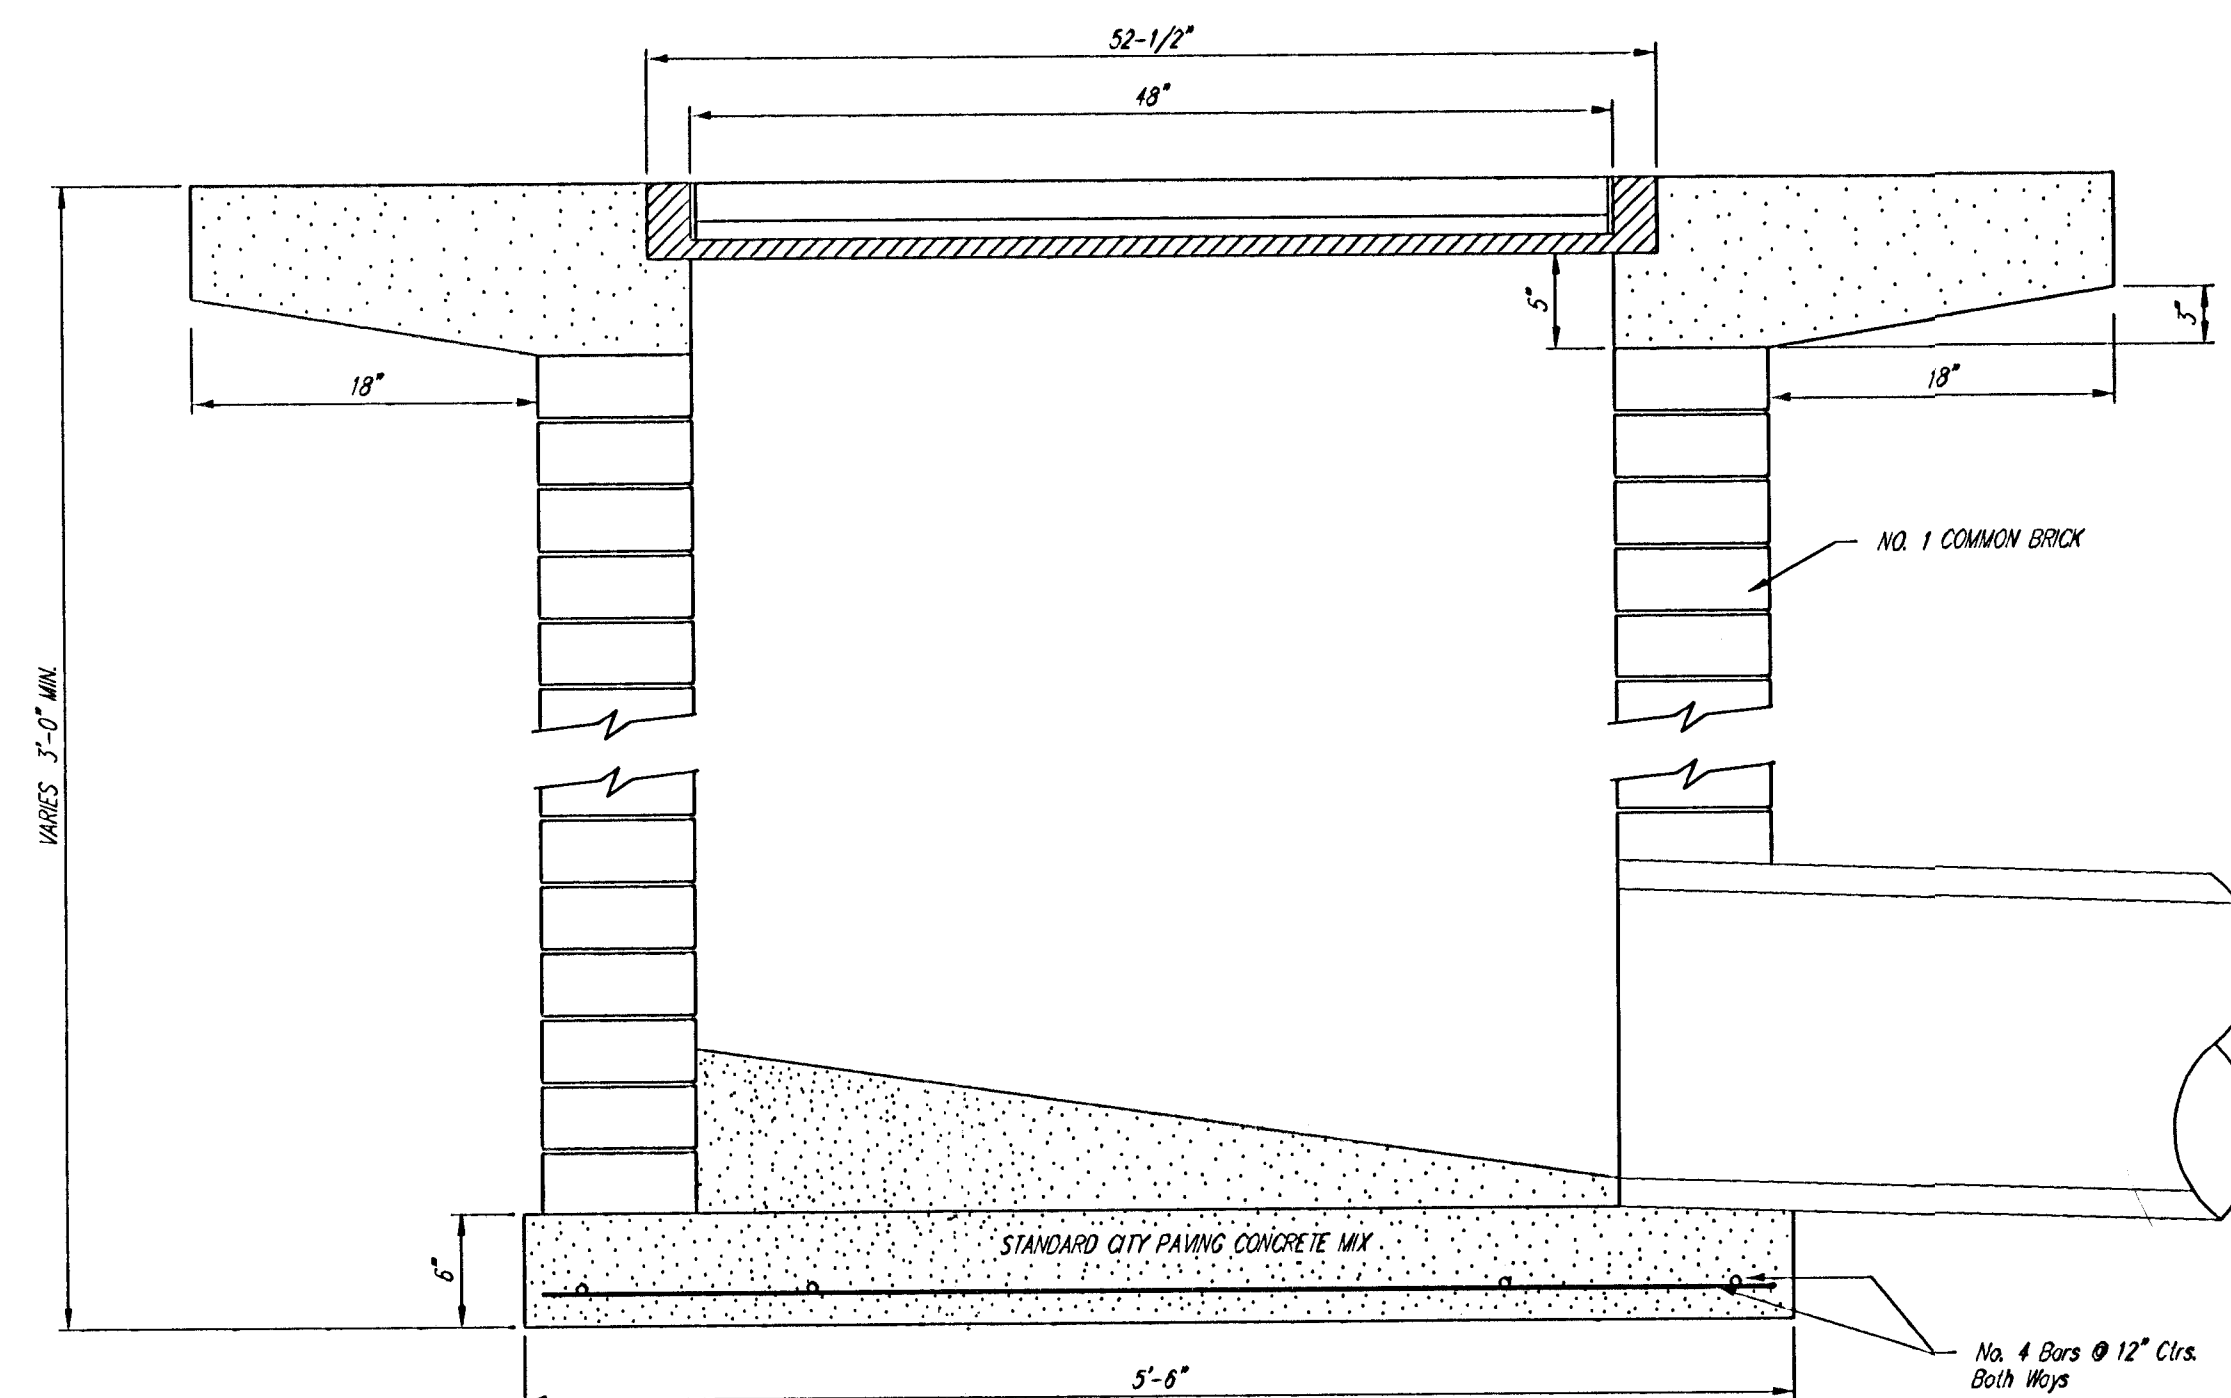

	City of Wichita Standard	
	Drop Inlet Detail	
Baughman Company, P.A. 3151 Lila St. Wichita, KS 67211 F 316-363-7271 F 316-363-8149 ENGINEERING SURVEYING PLANNING LANDSCAPE ARCHITECTURE		
PROJECT NUMBER 1713 FPS	DESIGN C.O.W.	DRAWN Staff
REVISIONS:	APPROVED	DATE 11/06
	SCALE None	SHEET
	6 OF 12	
F:\Eng\Details\Sewer\DROPINT2.dwg 06-07-E602		

NORTHWEST MEDICAL OFFICE AS-BUILTS
T.H./C.E.D 5-7-07