



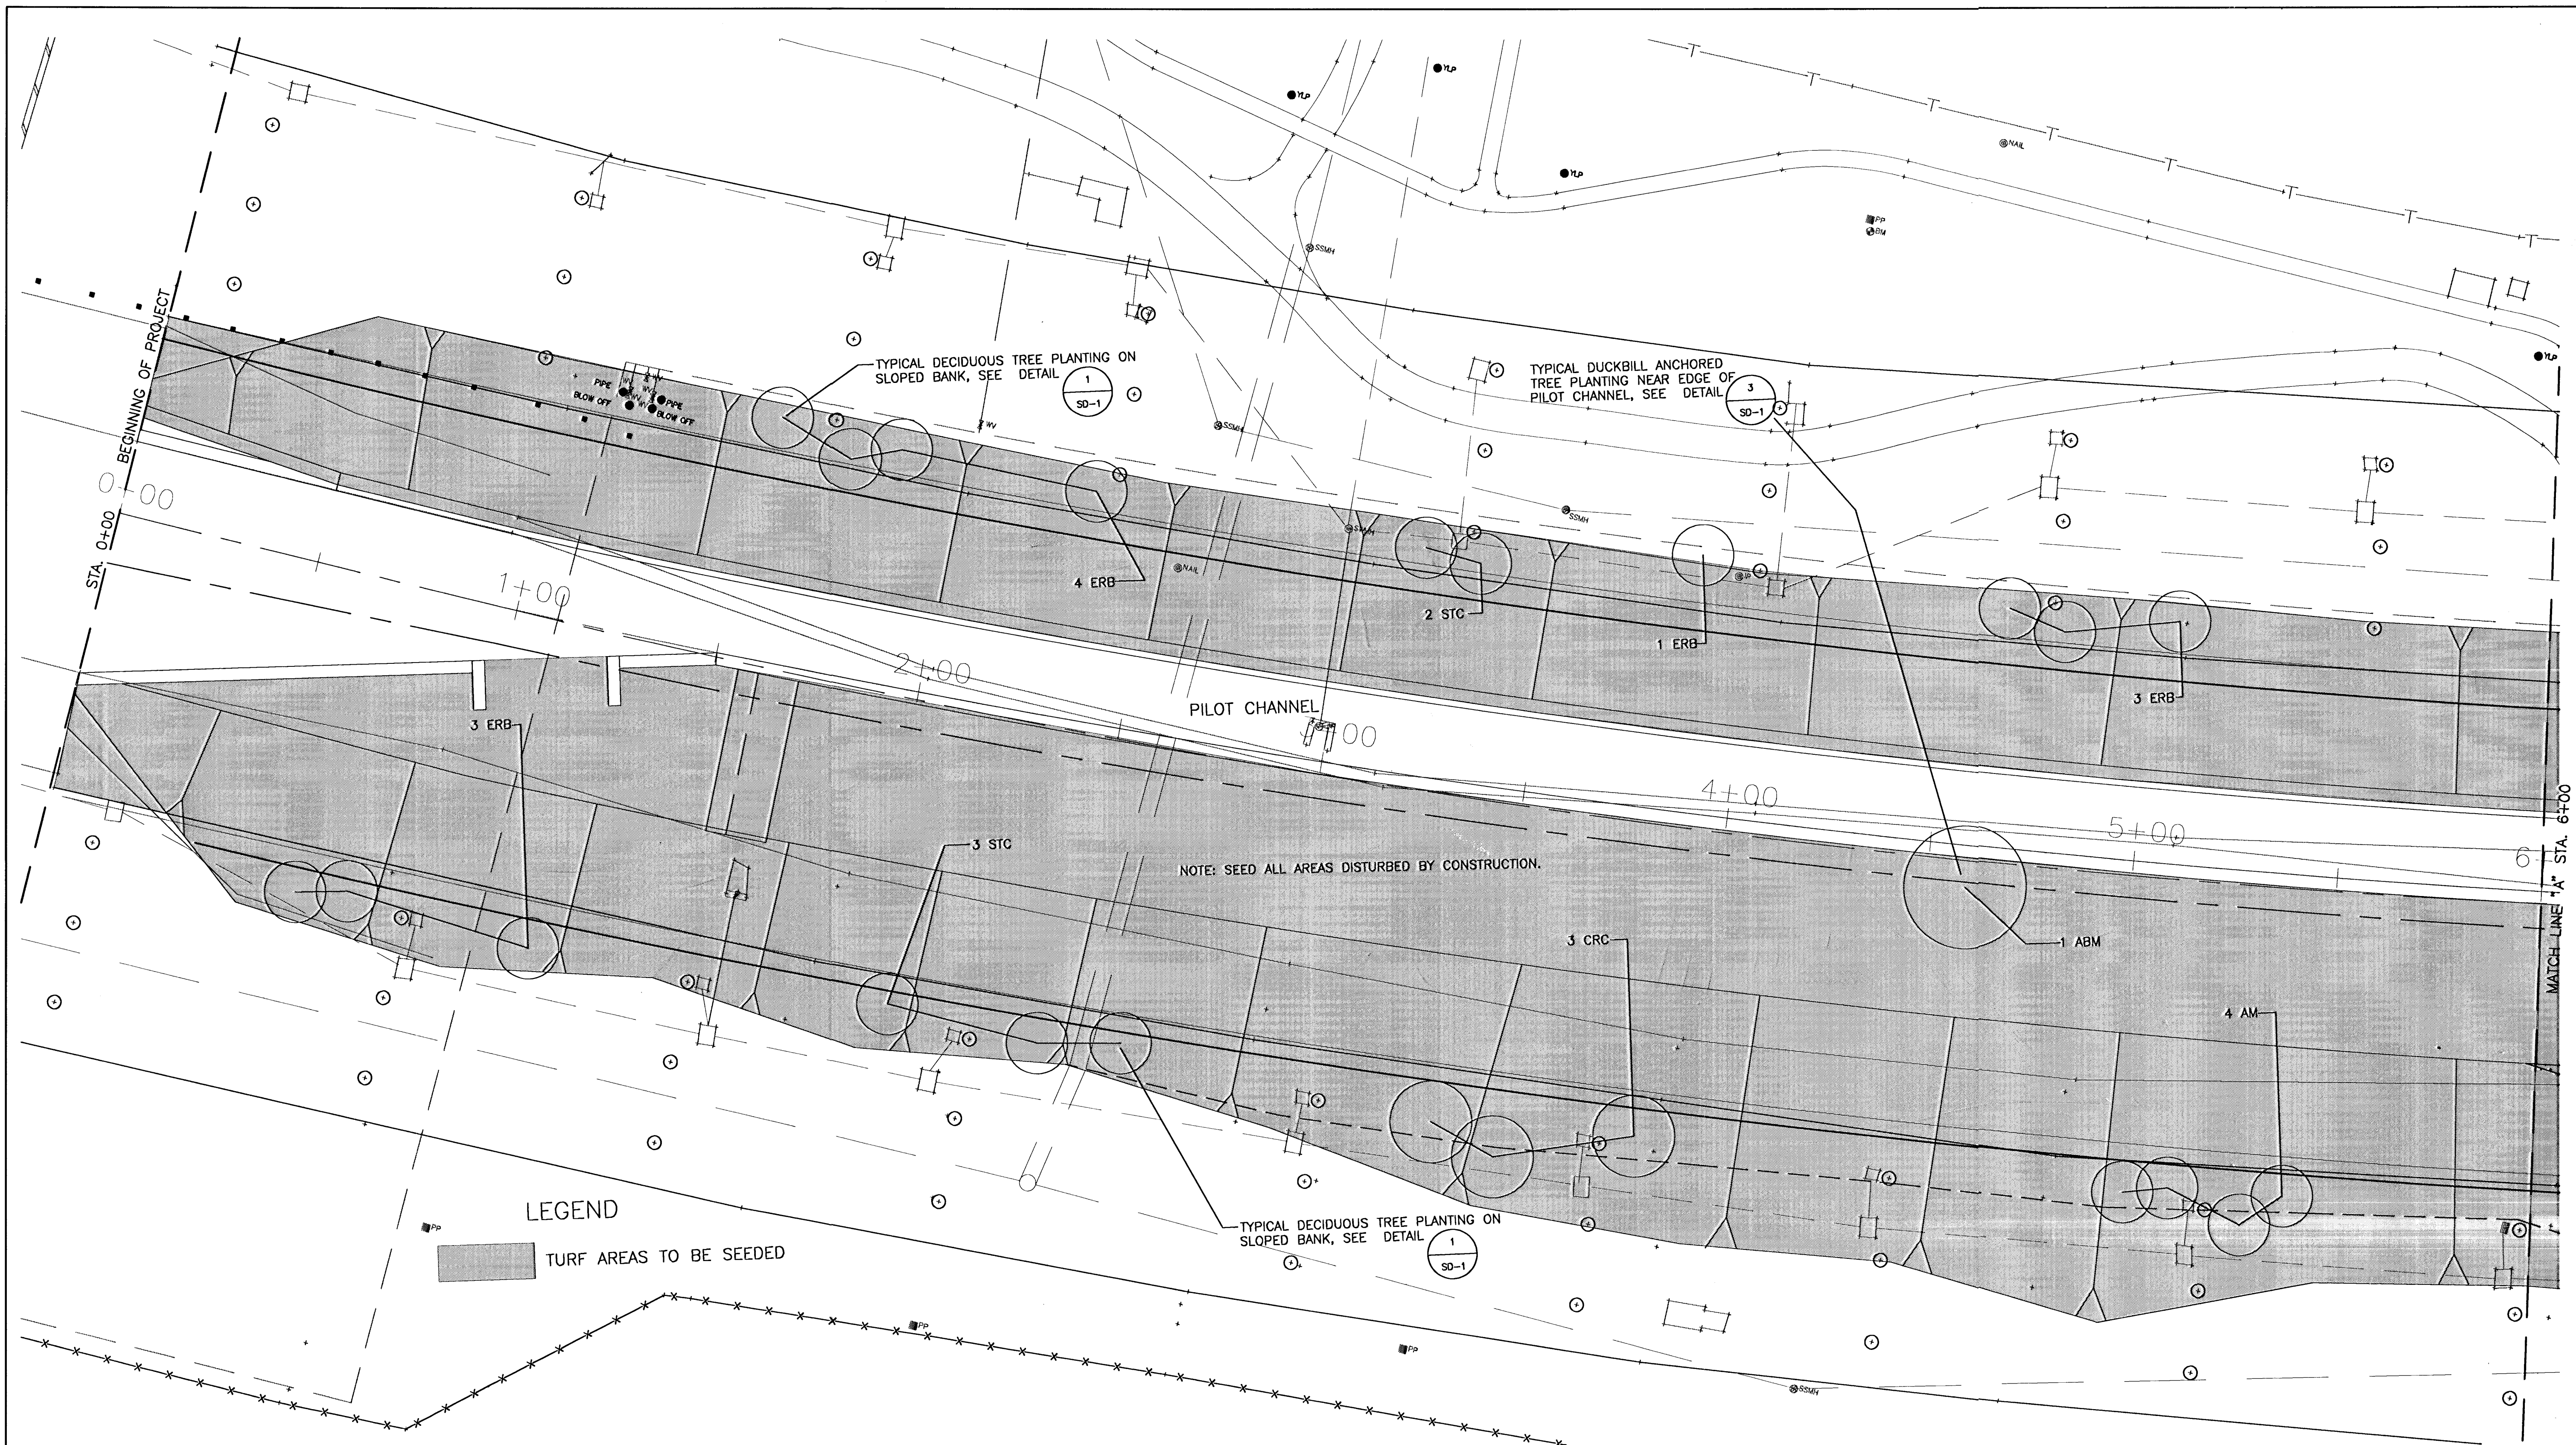


LEGEND

TURF AREAS TO BE SEED

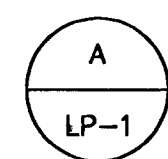


CANAL ROUTE IMPROVEMENT LANDSCAPE PLAN NO. 1

0' 10' 20' 1"=20'-0"

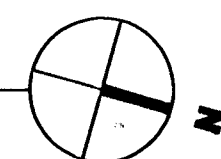

Not Built!

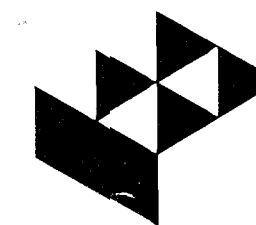

3					
2					
1					
NO.	DATE	REVISIONS	BY	APP'D	
CITY OF WICHITA					
LANDSCAPE PLAN					
LP-1					
SHEET NO.	OF	SCALE	APP'D		
DESIGNED		QUANTITIES	TRACED		
DESIGN CK.		QUAN. CK.	TRACE CK.		