

BENCHMARKS:
BM#1: "□" Cut in top of curb, east return of SE corner of Lotus & Parkridge.
Elev. = 145.99 (City Datum)

BM #2: "X" Cut on walk at NW corner of Lot 1, Block F, Flat Creek Addition
Elev. = 146.22 (City Datum)


BM #3: "□" Cut in top of curb at the NW corner of Lot 1, Block B, Hunter's Ridge Addition.
Elev. = 146.63 (City Datum)

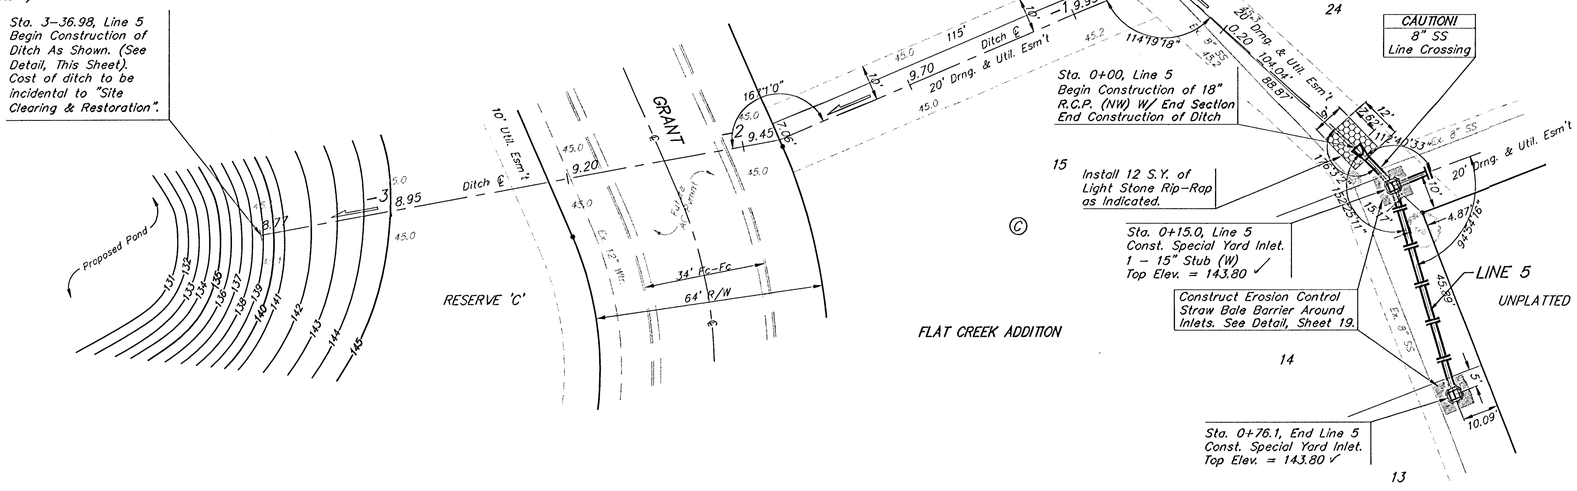

SCALE:
1" = 20' HORIZONTAL
1" = 5' VERTICAL
• = IRON

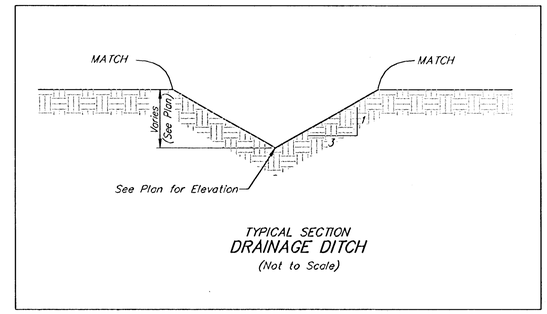

TYPICAL SECTION
DRAINAGE DITCH
(Not to Scale)

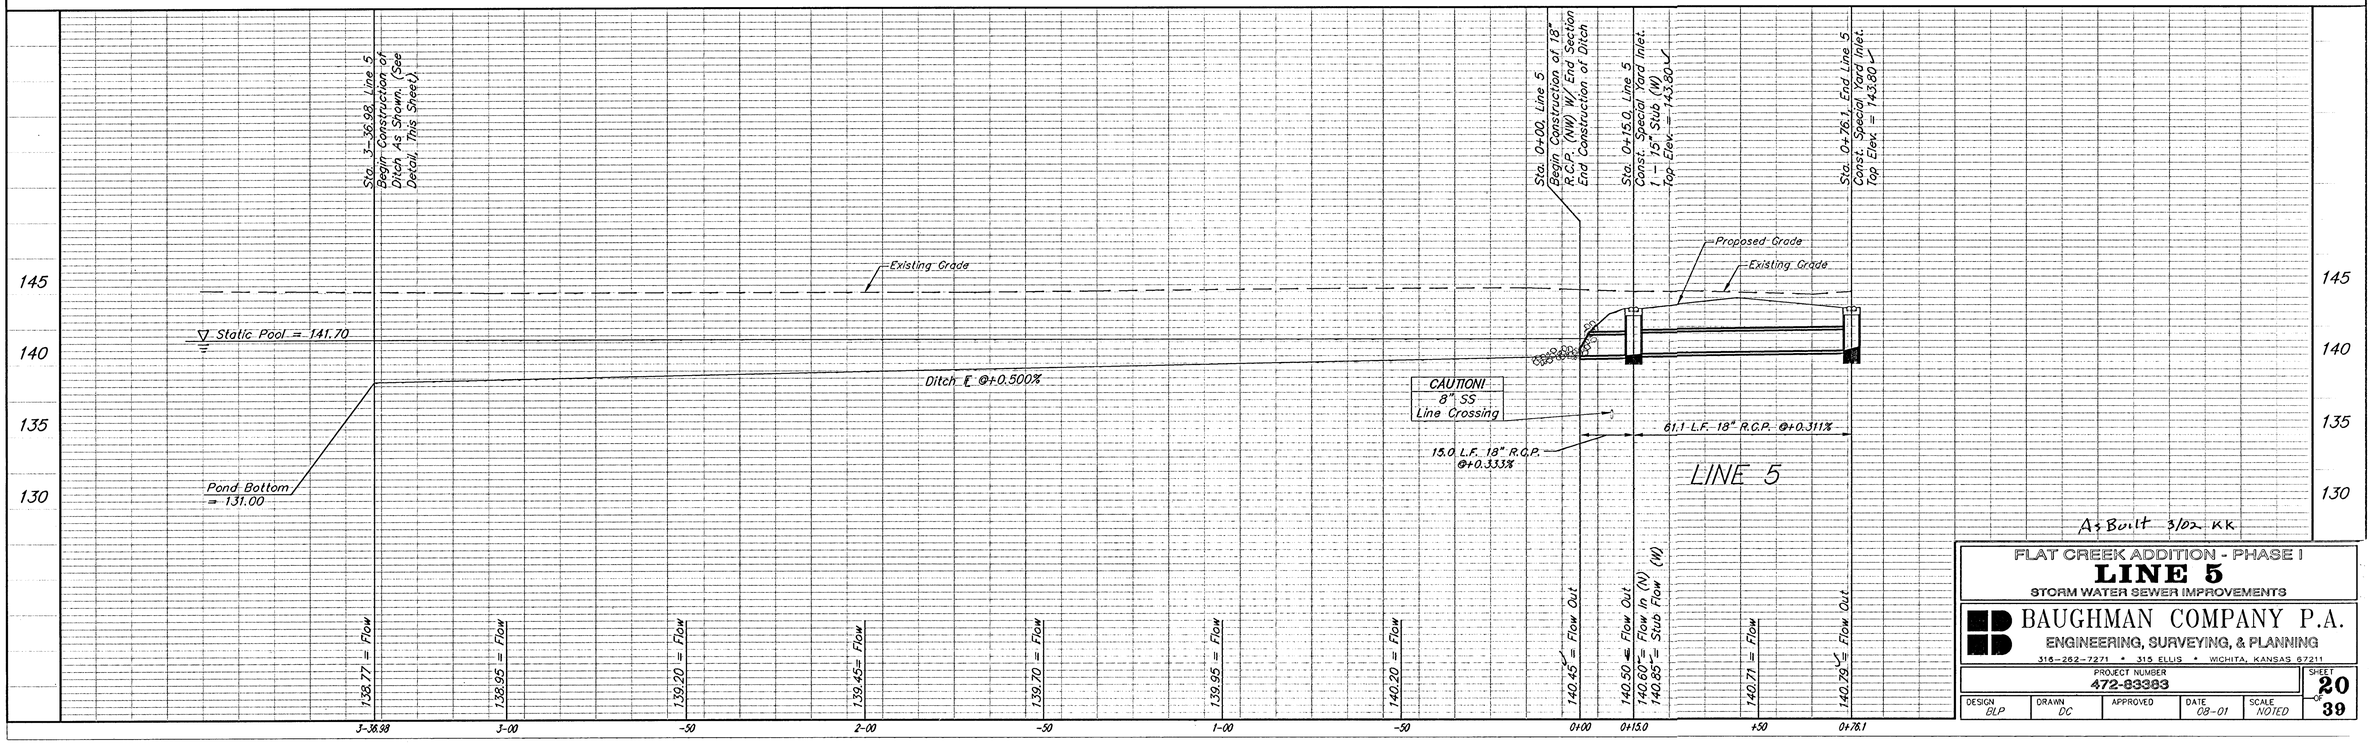

As Built 3/02 KK

FLAT CREEK ADDITION - PHASE I
LINE 5
STORM WATER SEWER IMPROVEMENTS

BAUGHMAN COMPANY P.A.
ENGINEERING, SURVEYING, & PLANNING
316-262-7271 • 315 ELLIS • WICHITA, KANSAS 67211

PROJECT NUMBER	SHEET
472-83383	20 of 39

DESIGN	DRAWN	APPROVED	DATE	SCALE
BLP	DC		08-01	NOTED