


**GREATER WICHITA YMCA
NORTHWEST BRANCH YMCA
SANITARY SEWER PLANS**

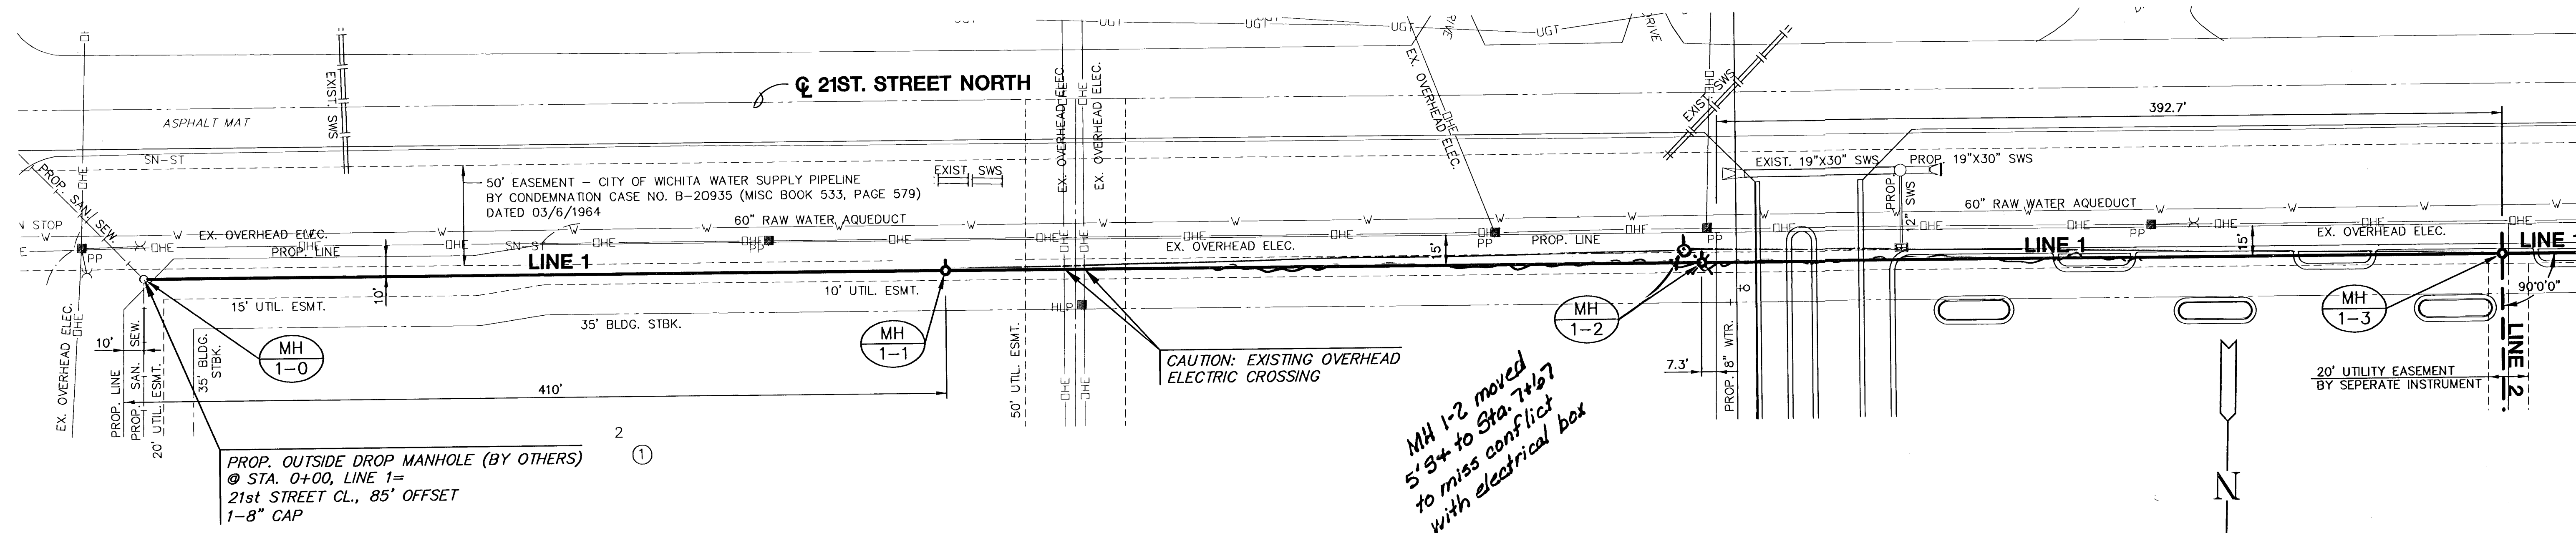

PLAN LINE 1

SCALE: 1"=40'

