



PLAN LINE 1

SCALE: 1"=40'

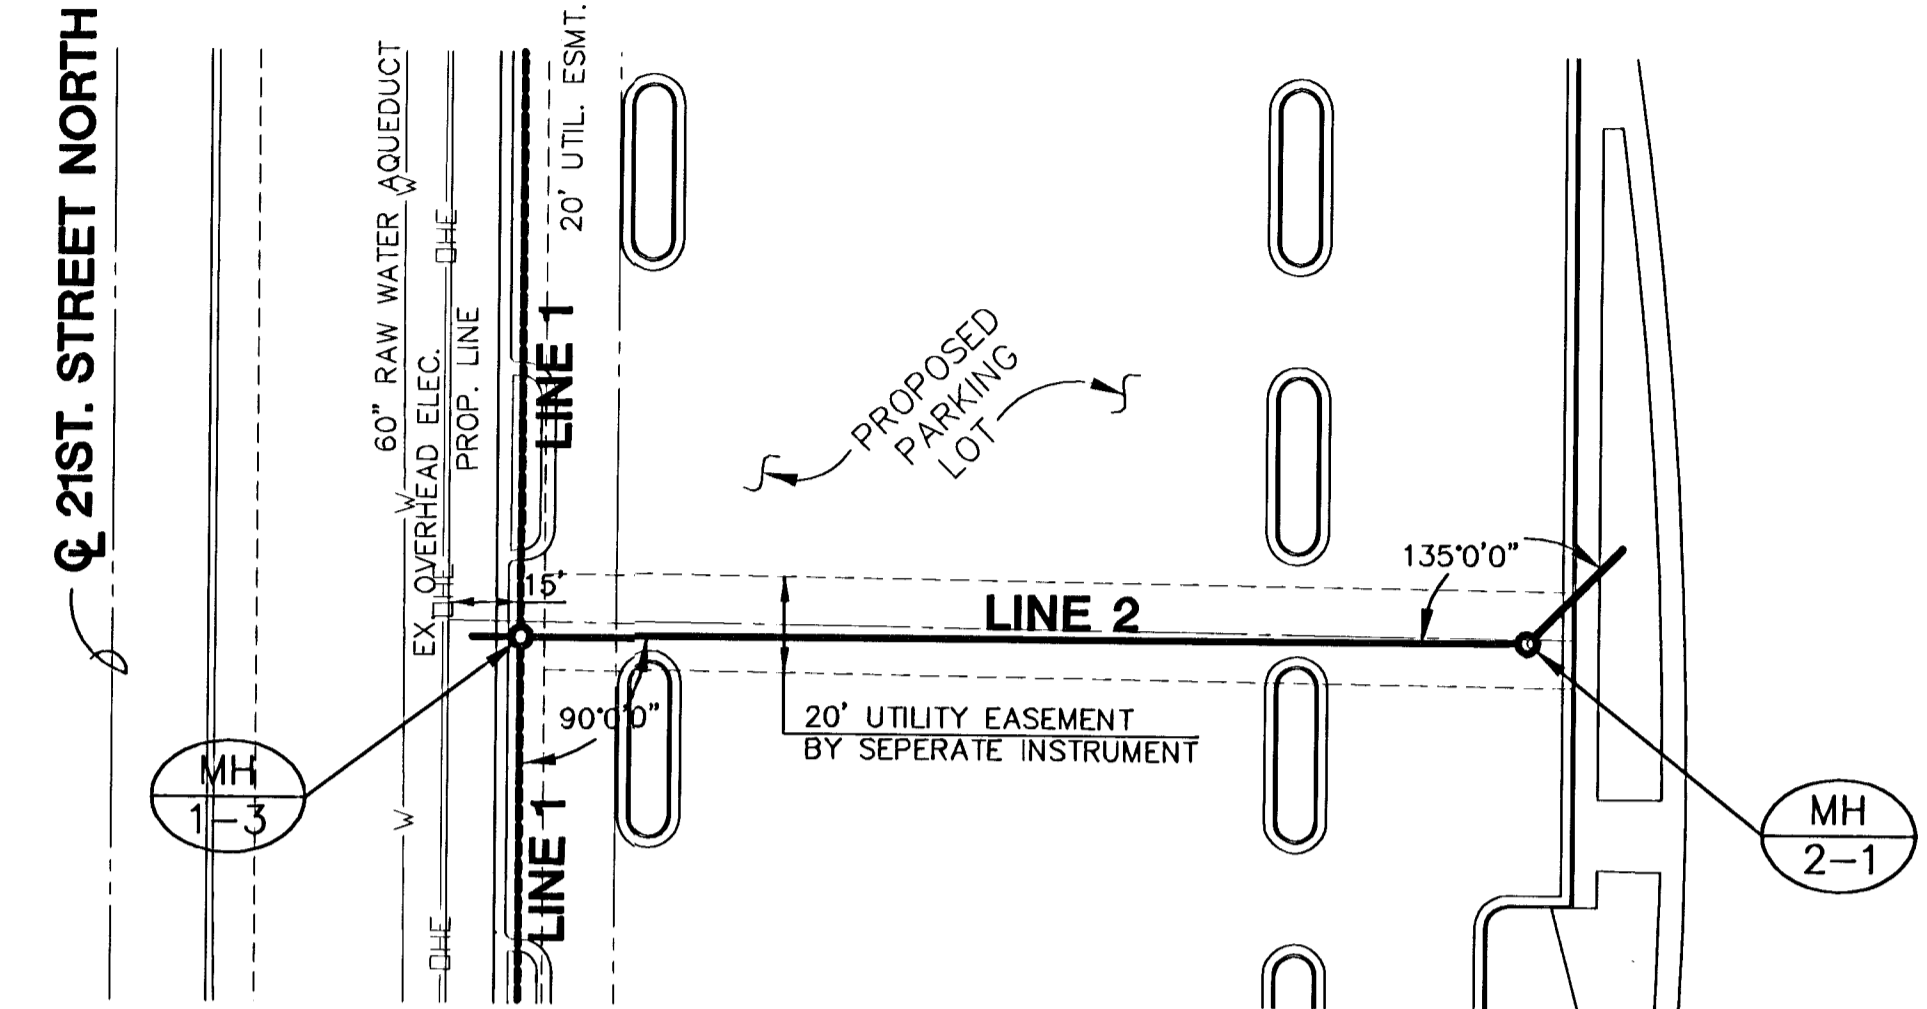


PLAN LINE 2

SCALE: 1"=40'

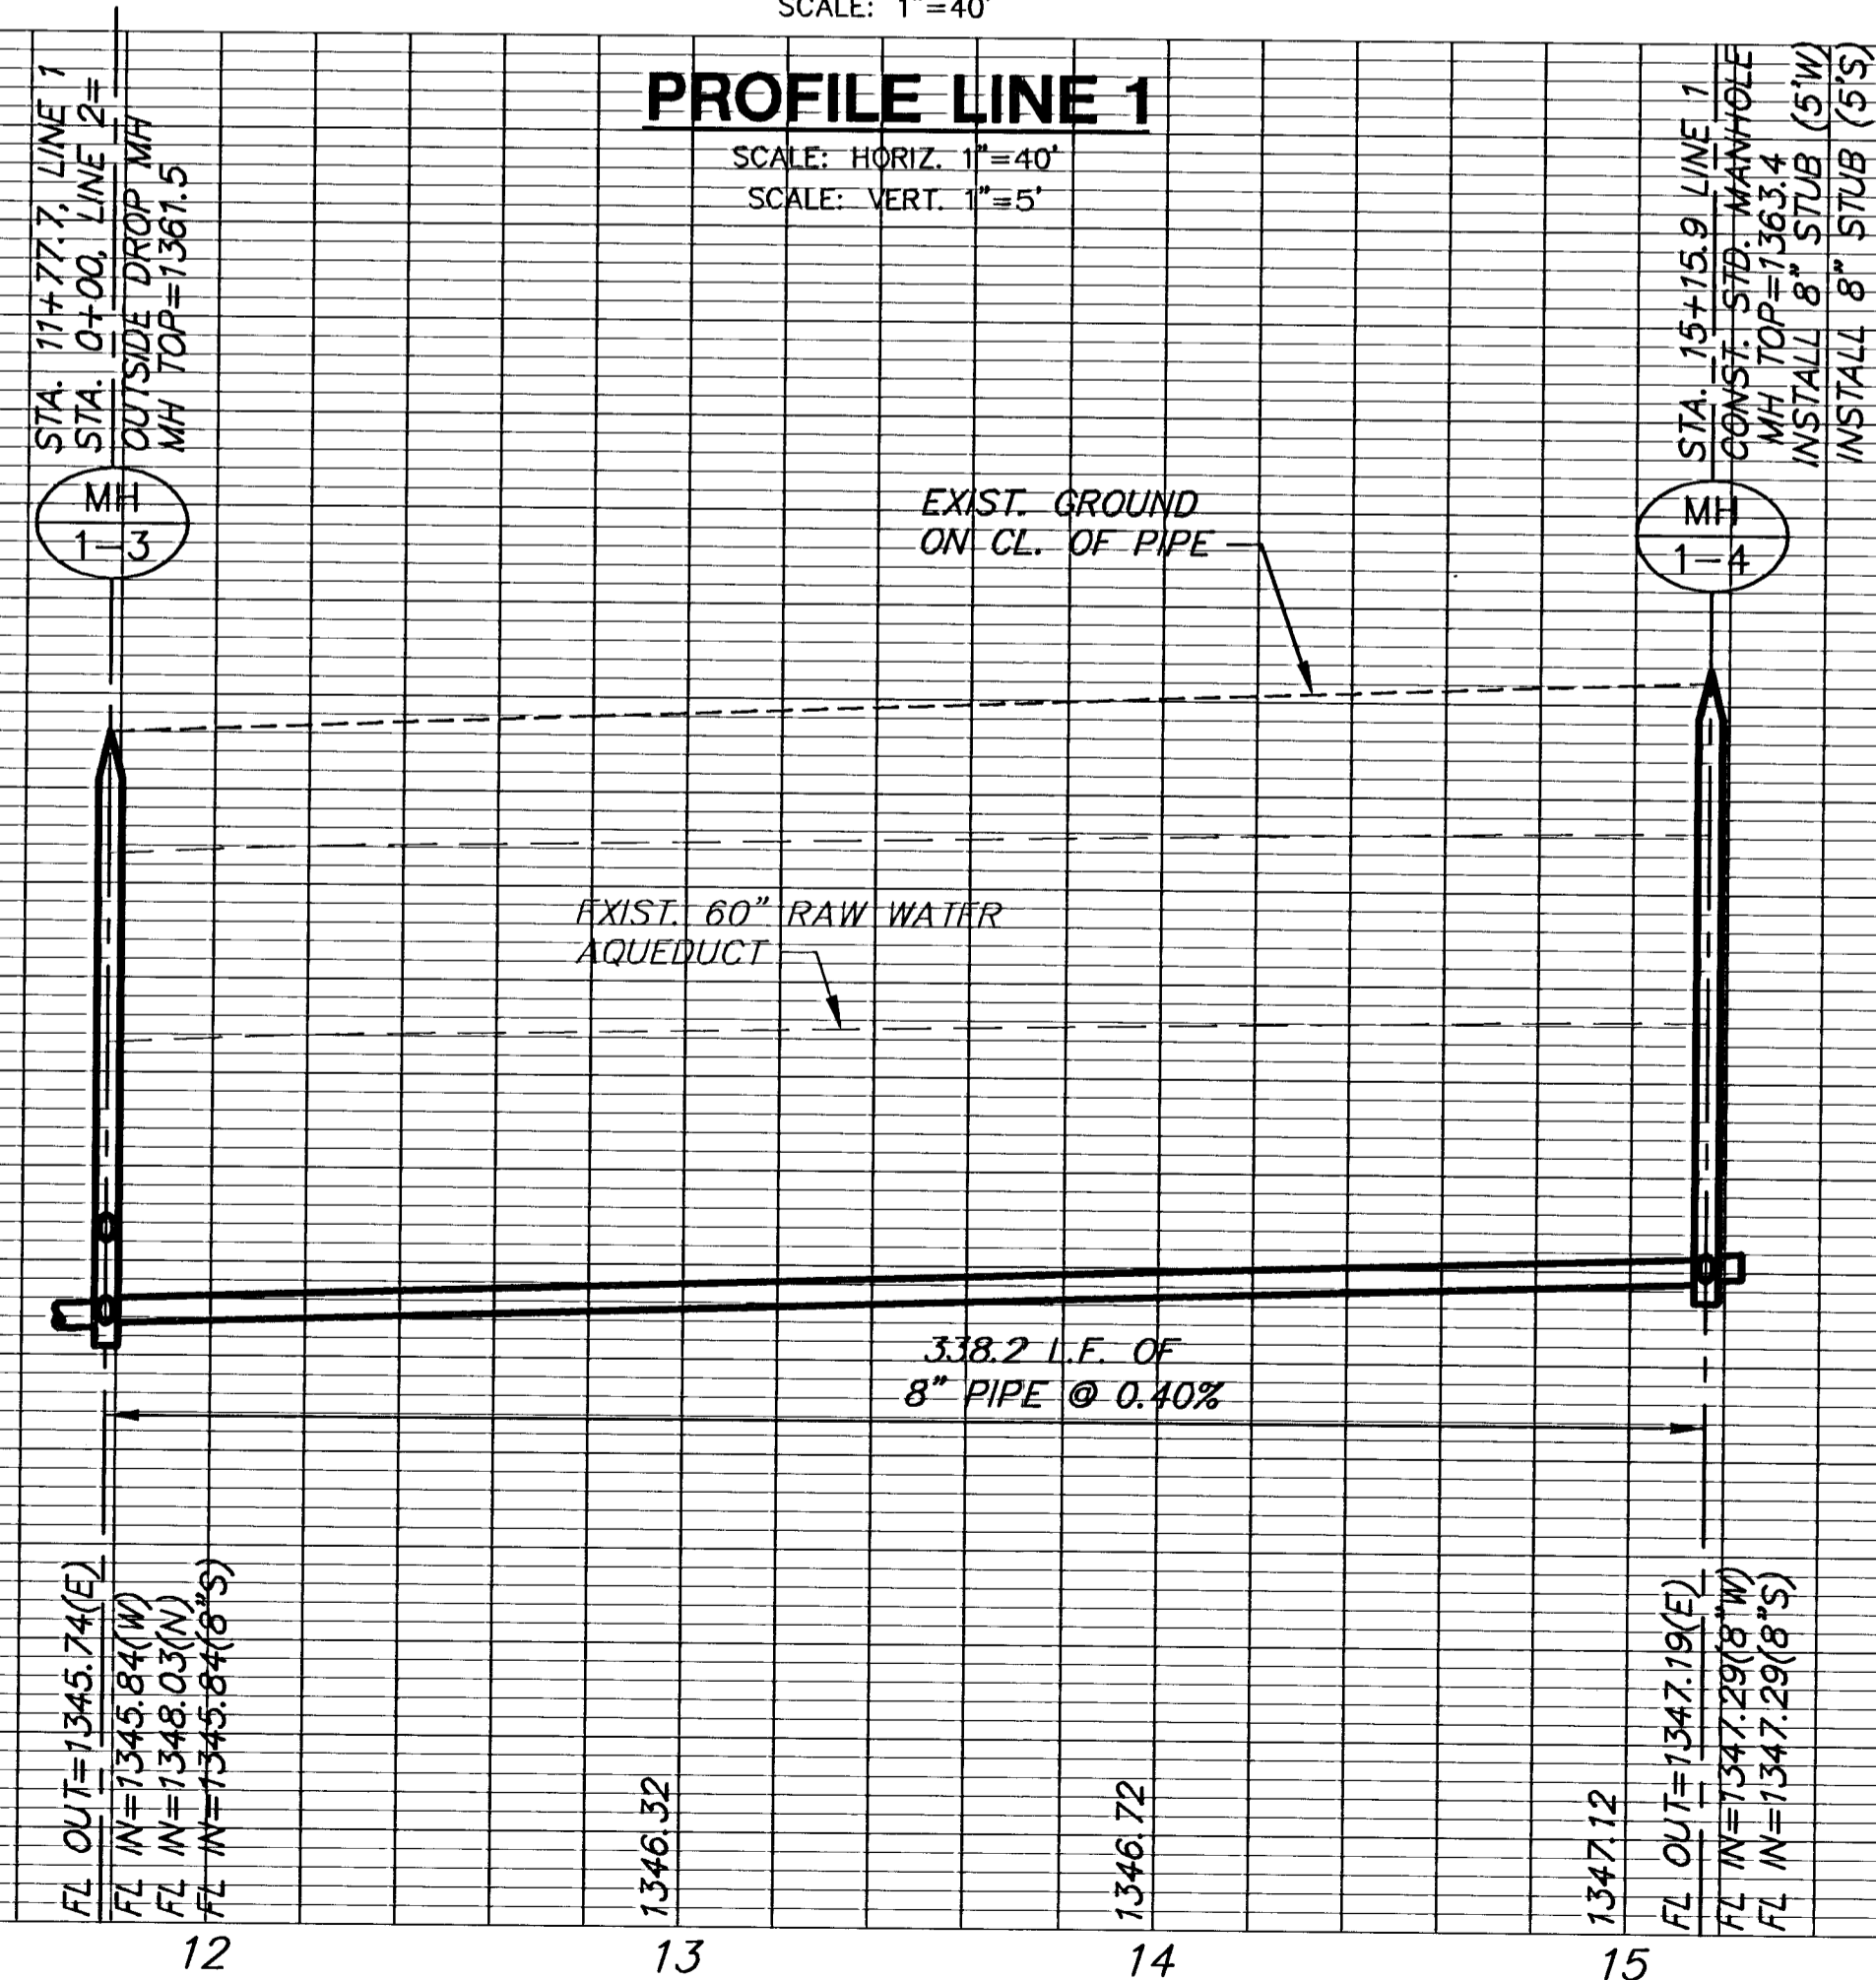

PROFILE LINE 1

SCALE: HORIZ. 1"=40'  
SCALE: VERT. 1"=5'

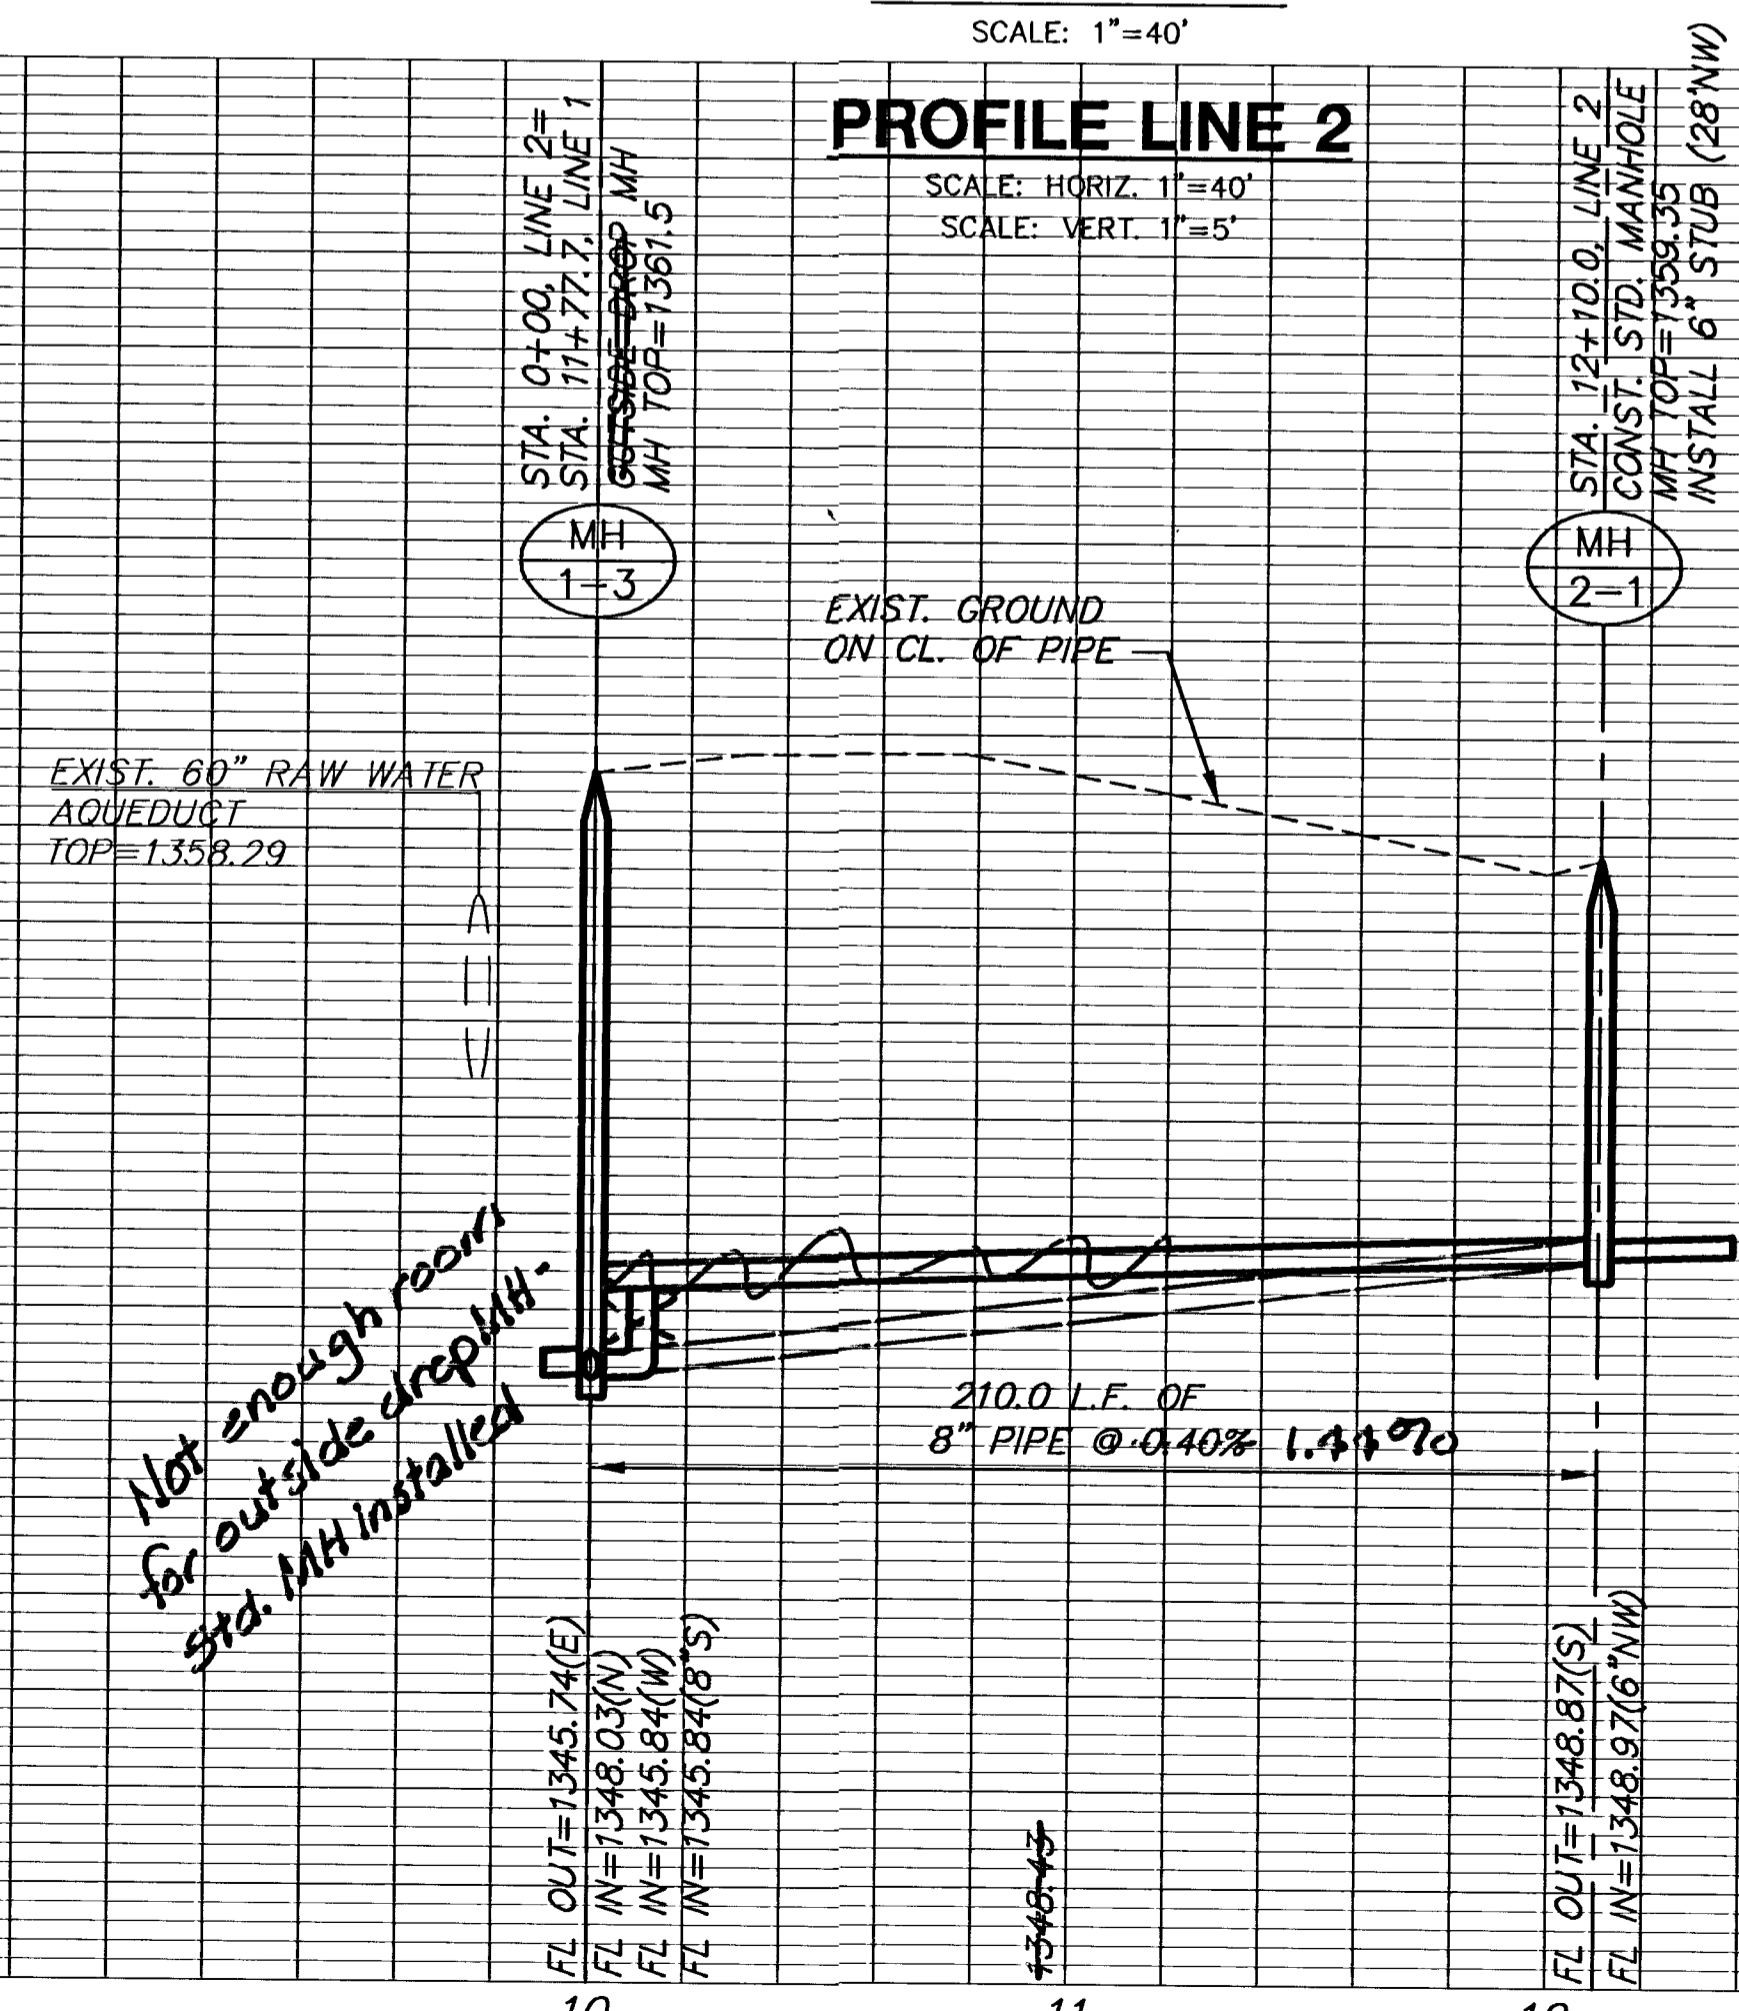

PROFILE LINE 2

SCALE: HORIZ. 1"=40'  
SCALE: VERT. 1"=5'

*Not enough room for outside drop. Std. MH installed*