


SCALE 1" = 40'
IRON = •

SEWER SERVICE TABLE

NUMBER	TYPE	LOCATION			STATION\ DIRECTION	FOR INFORMATION ONLY	
		HOUSE NO.	BLOCK NO.	LINE NO.		APPROXIMATE LENGTH 4" PIPE	
1	8" X 4" Tee Saddle	242	2	1	0+07.0/Rt.	11.9'	4.9
2	8" X 4" Tee Saddle	241	2	1	0+59.0/Rt.	10.7'	4.7
3	8" X 4" Tee Saddle	240	2	1	1+09.0/Rt.	9.5'	4.5
4	8" X 4" Tee Saddle	239	2	1	1+62.0/Rt.	8.3'	5.1

NOTE: Vertical Riser Pipe shall be extended to 2' minimum above ground water elevation and 4' maximum below proposed ground elevation.

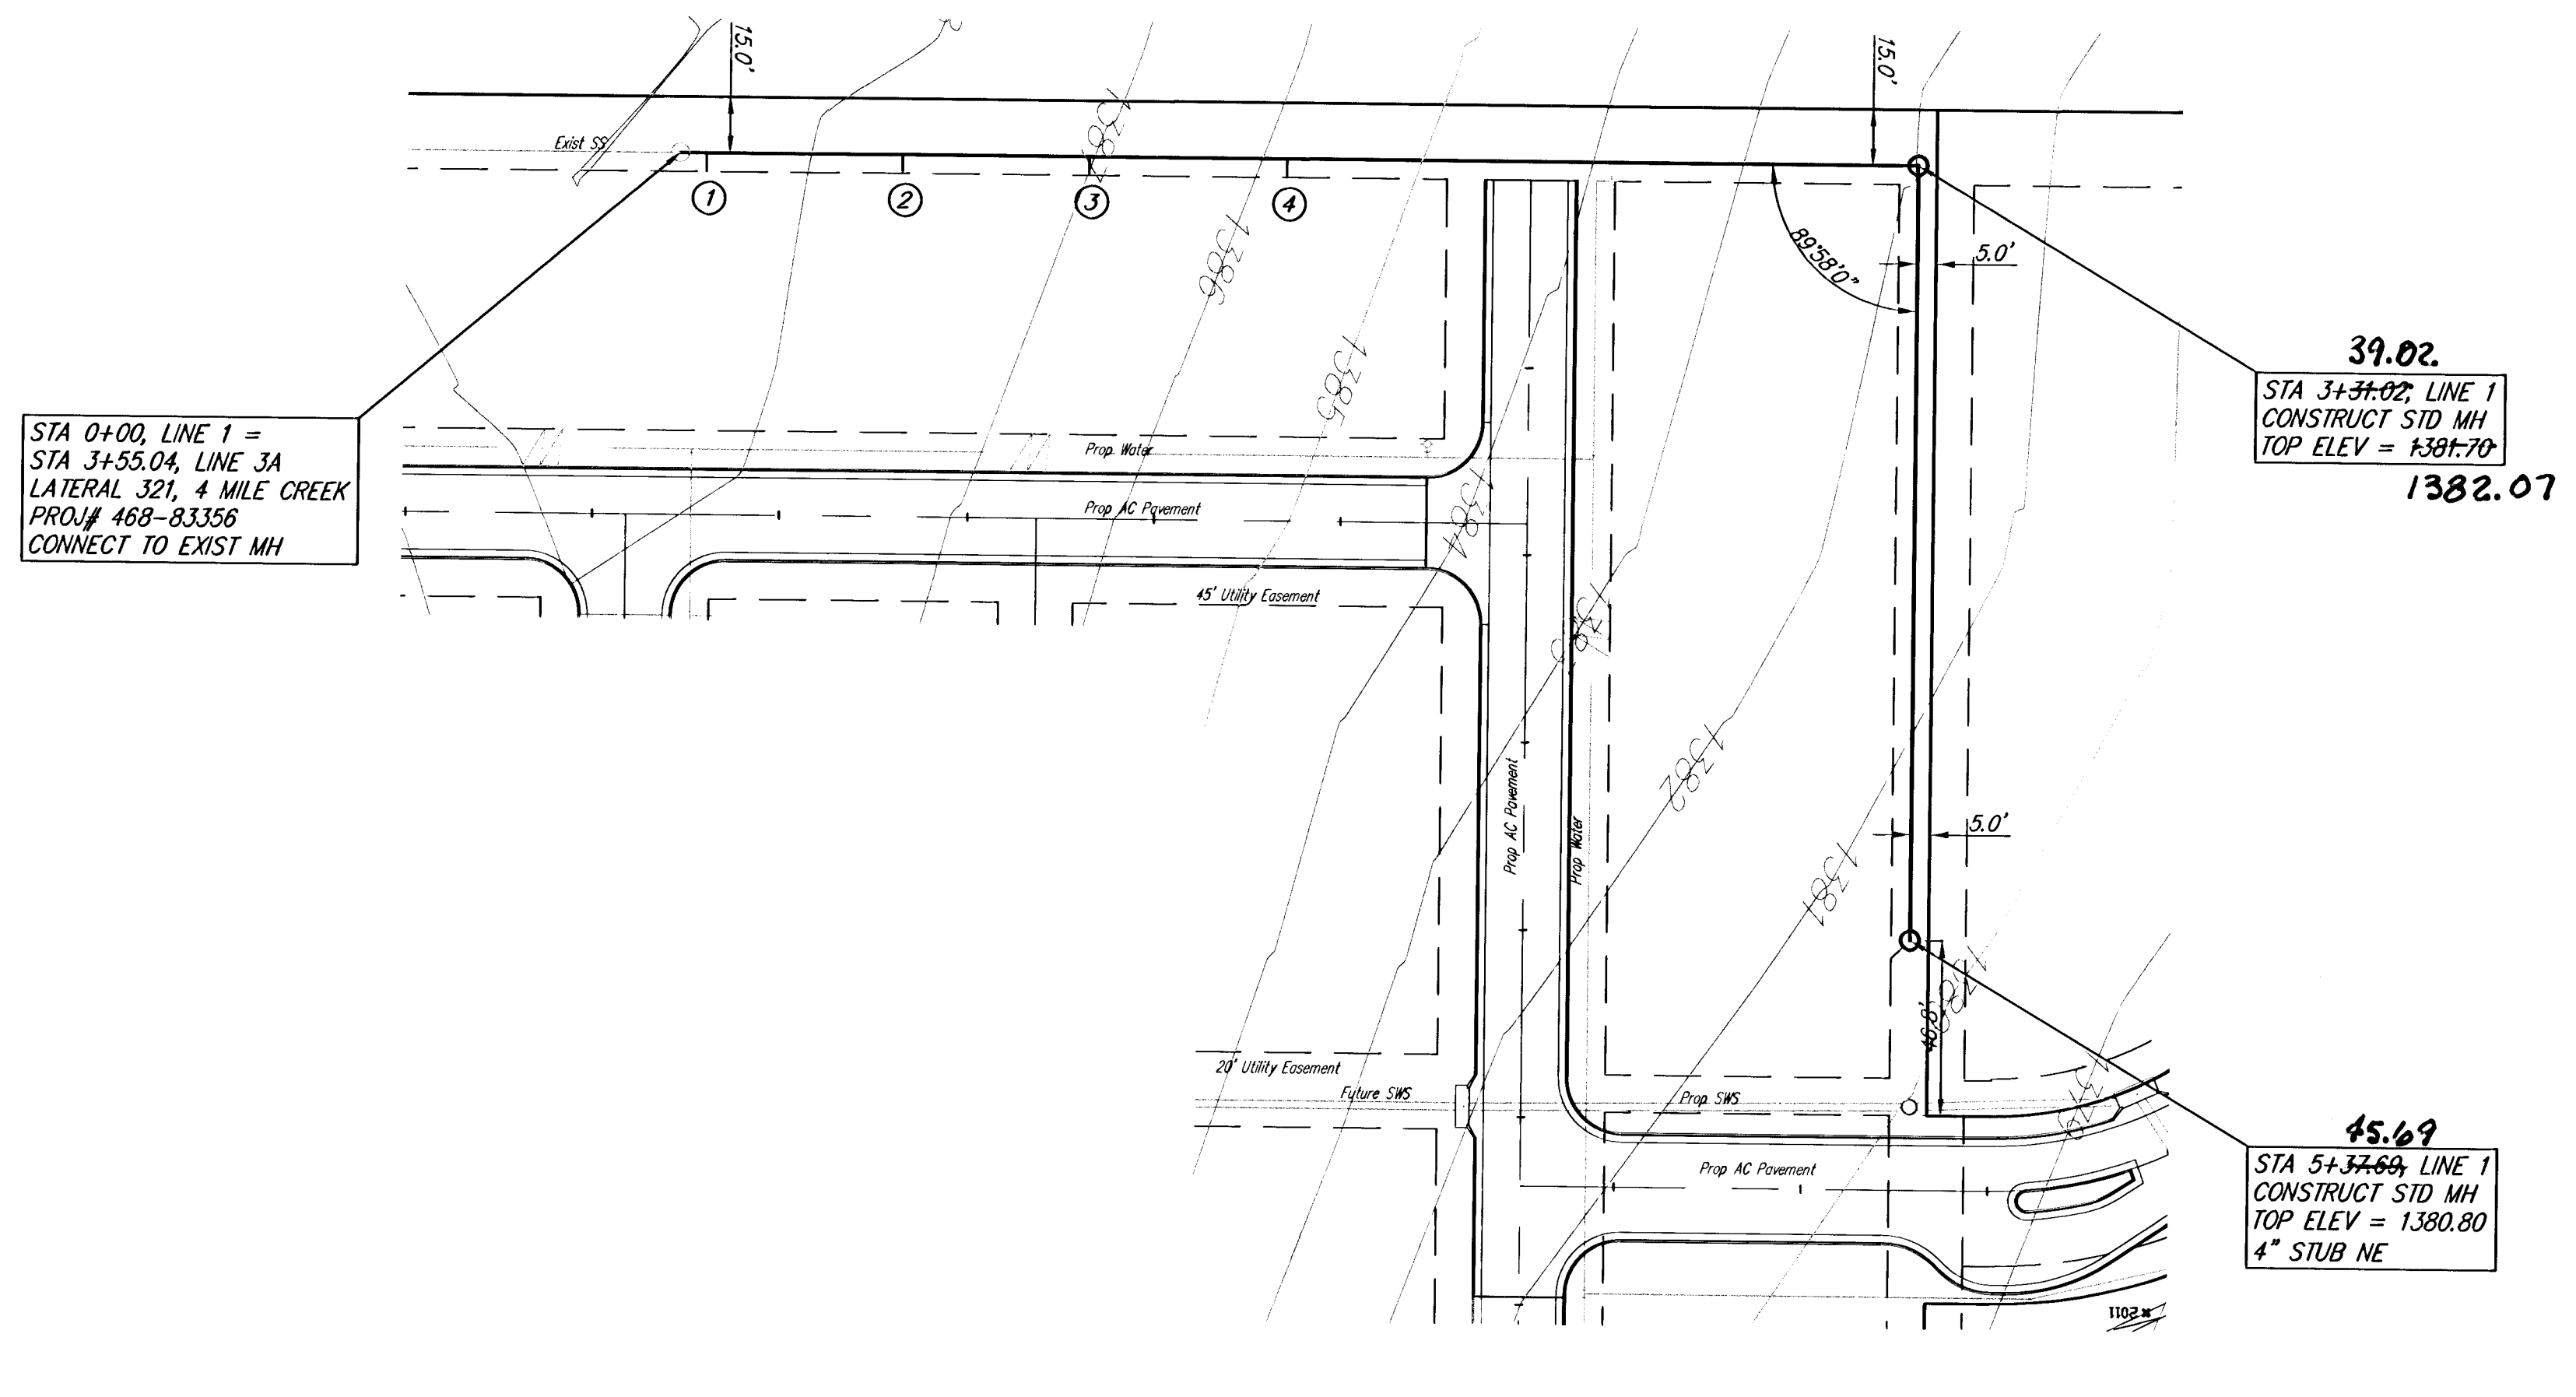