


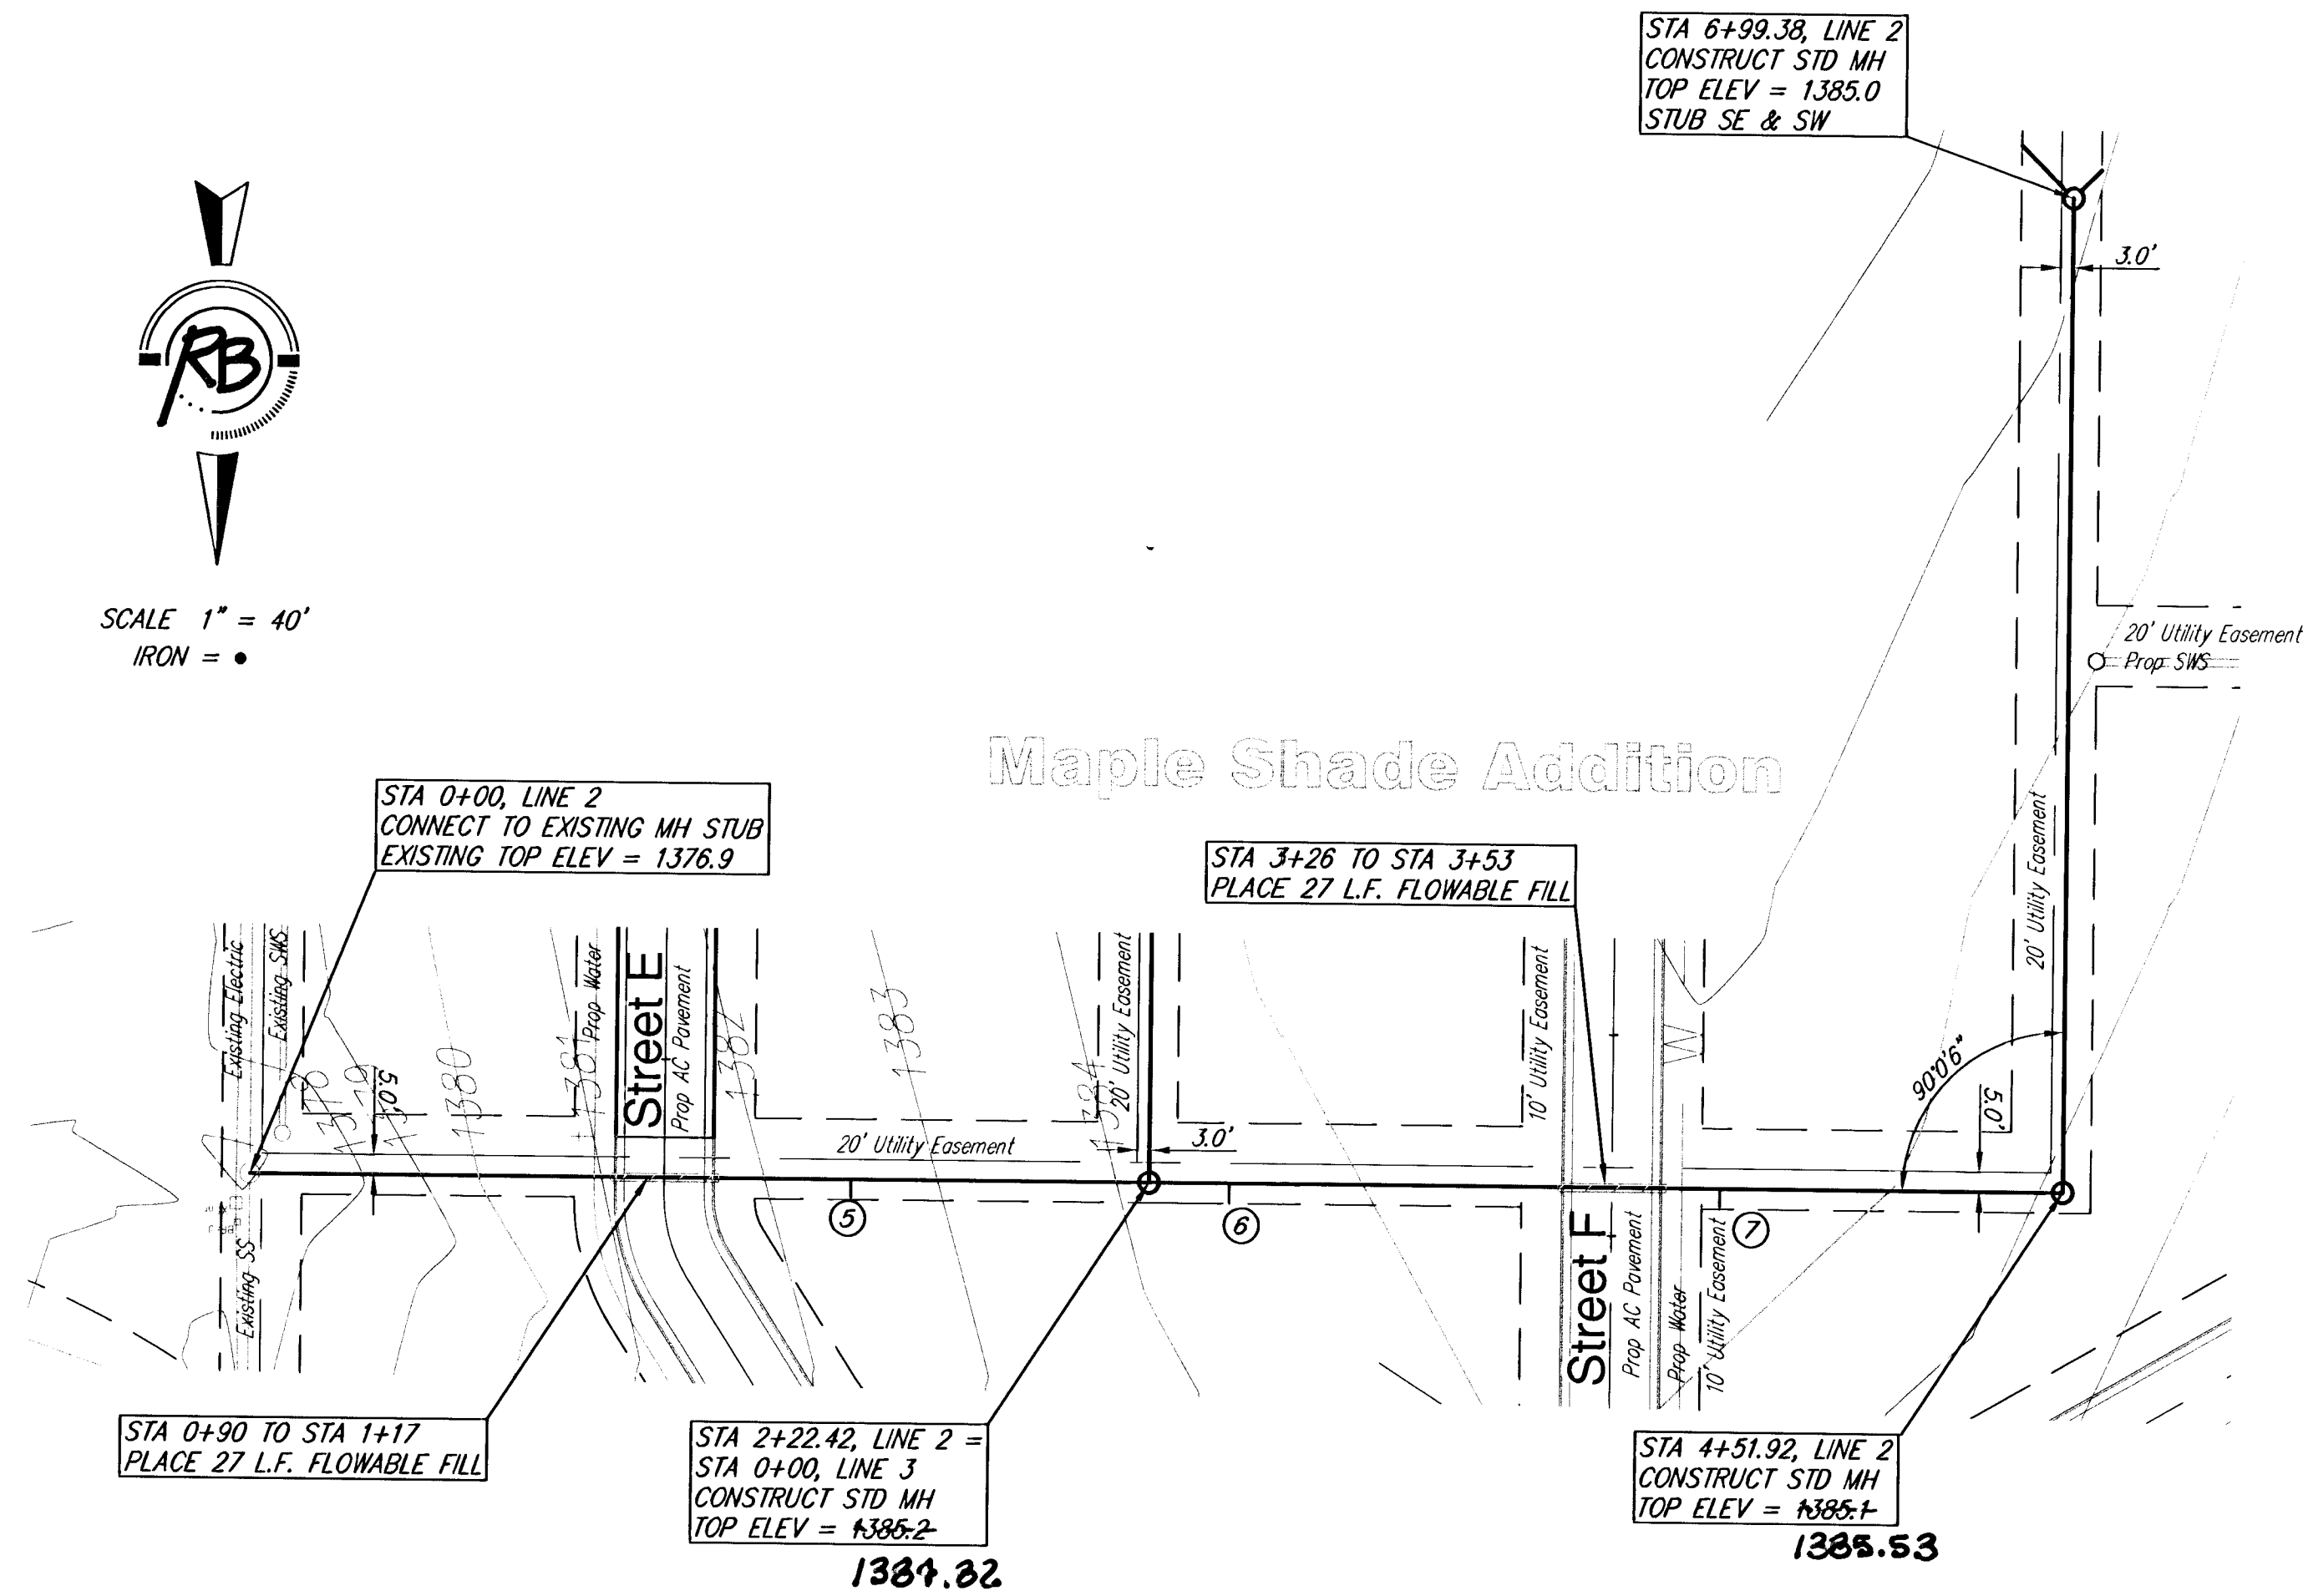


SCALE 1" = 40'  
IRON = •



STA 2+22.42, LINE 2 =  
STA 0+00, LINE 3  
CONSTRUCT STD MH  
SEE NOTE THIS SHEET

Maple Shade Addition

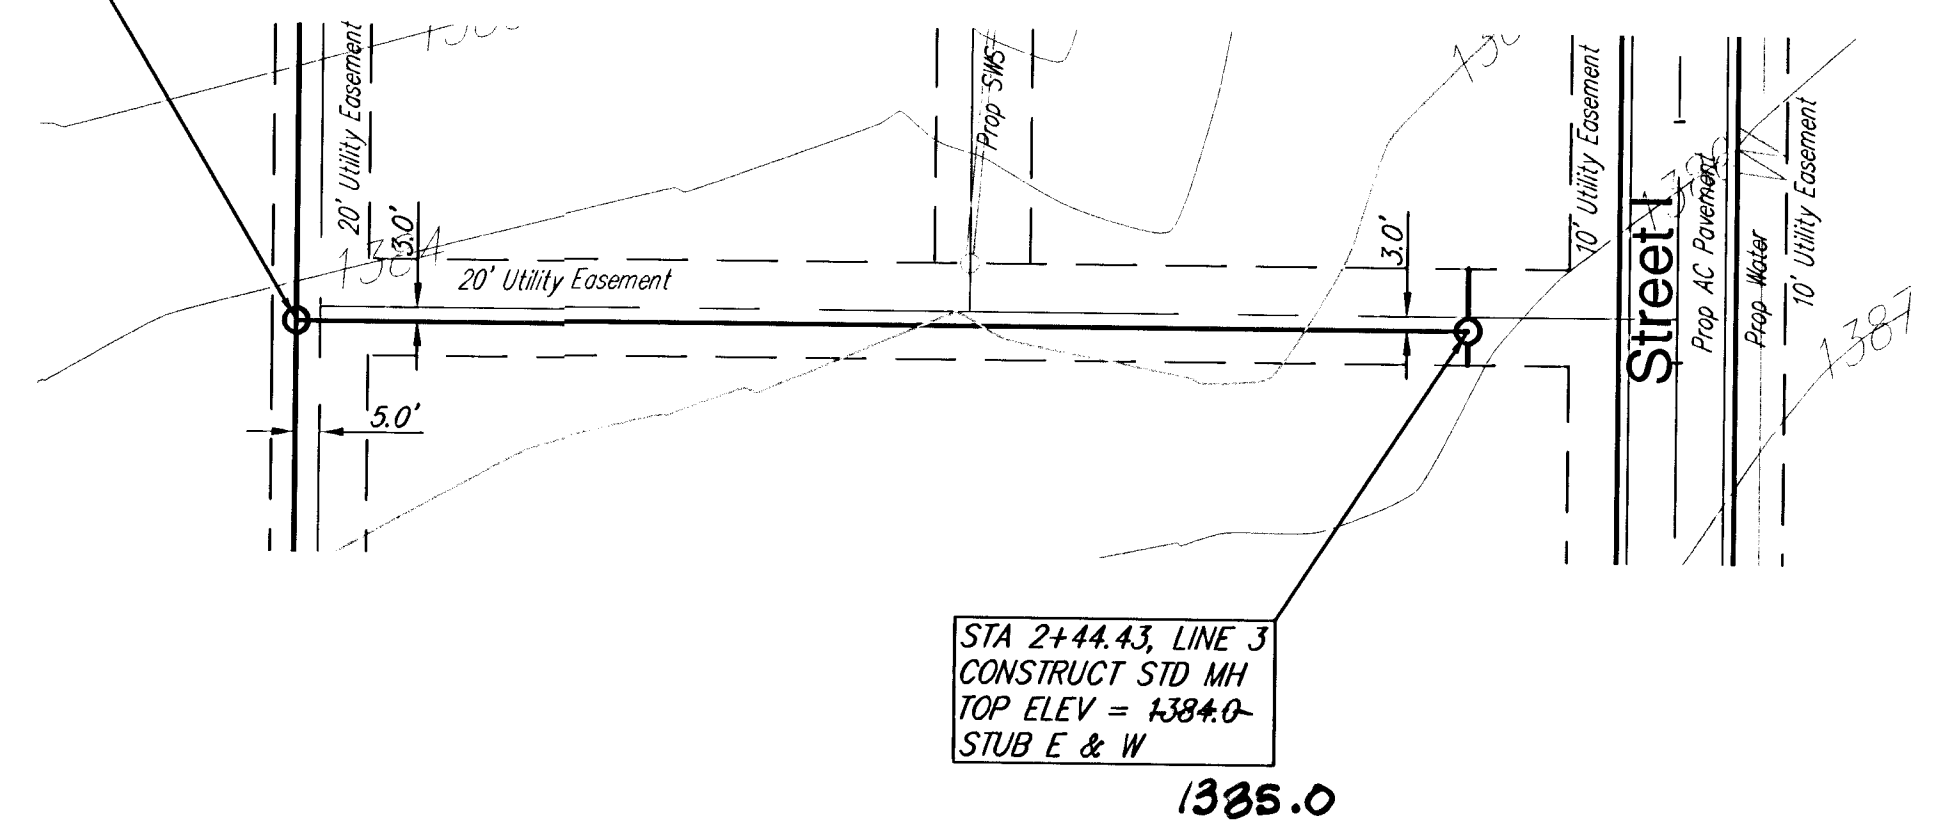



SEWER SERVICE TABLE

| NUMBER | TYPE               | LOCATION  |           |                            | FOR INFORMATION ONLY       |      |
|--------|--------------------|-----------|-----------|----------------------------|----------------------------|------|
|        |                    | HOUSE NO. | BLOCK NO. | LINE NO. STATION DIRECTION | APPROXIMATE LENGTH 4" PIPE |      |
| 5      | 8" X 4" Tee Saddle | 251       | 2         | 1 1+50.0/Rt.               | 11.9'                      | 84.7 |
| 6      | 8" X 4" Tee Saddle | 252       | 2         | 1 2+45.0/Rt.               | 9.1'                       | 77.0 |
| 7      | 8" X 4" Tee Saddle | 261       | 2         | 1 3+66.0/Rt.               | 11.8'                      | 5'   |

NOTE: Vertical Riser Pipe shall be extended to 2' minimum above ground water elevation and 4' maximum below proposed ground elevation.



SCALE 1" = 40'  
IRON = •

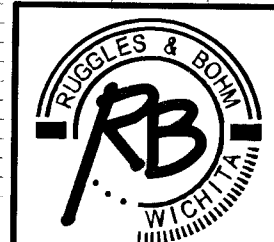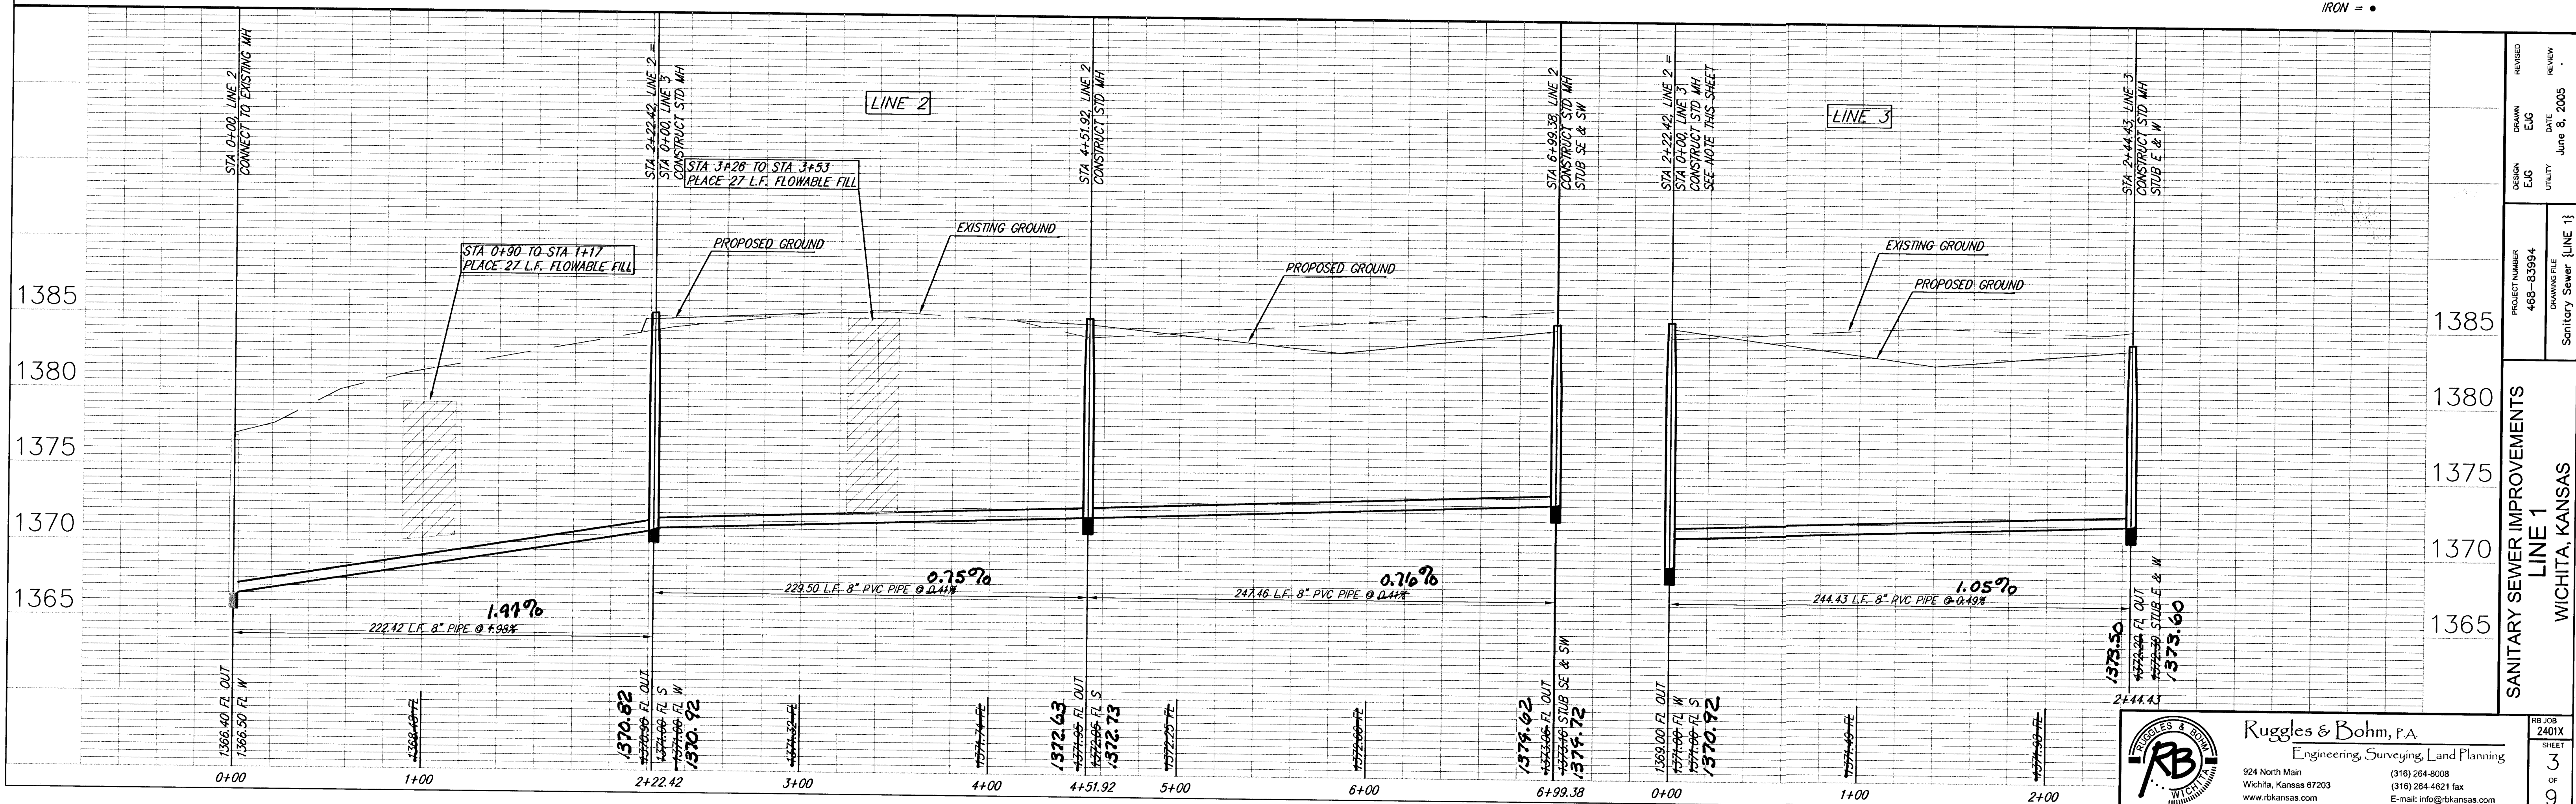

Ruggles & Bohm, P.A.  
Engineering, Surveying, Land Planning  
924 North Main  
Wichita, Kansas 67203  
www.rbkansas.com  
(316) 264-8008  
(316) 264-4621 fax  
E-mail: info@rbkansas.com