


PT. #	NORTHING	EASTING
600	8973.03	7540.20
601	8973.03	7540.20
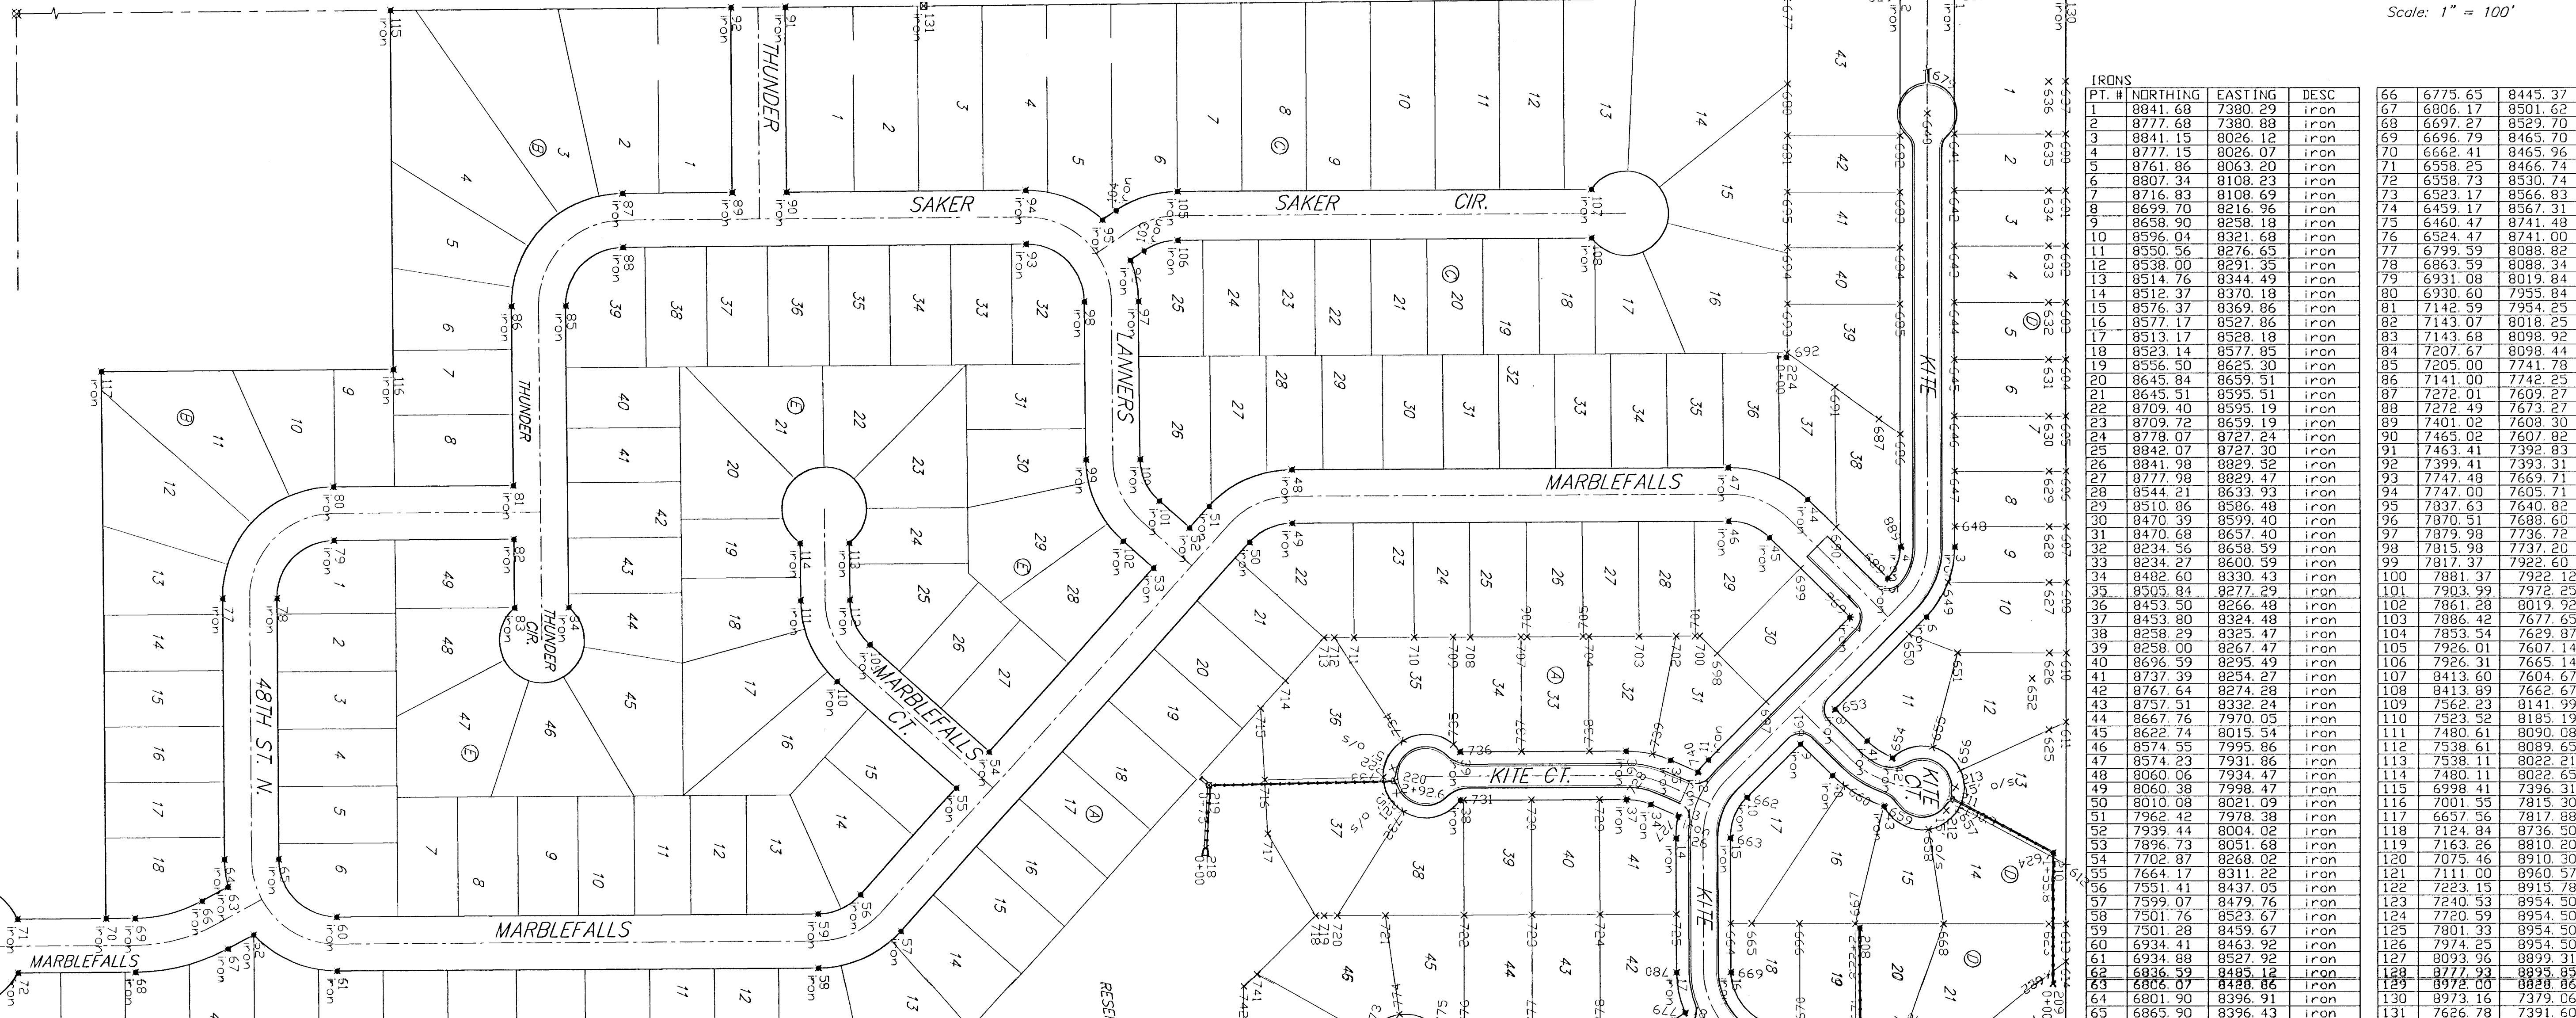

PT. #	NORTHING	EASTING	DESC
200	8700.33	8882.68	iron
201	8770.88	8674.66	1+62.7
202	8785.71	8661.78	normal
203	8795.89	8675.86	normal
204	8812.07	8666.18	2+07.5
205	8846.91	8649.40	2+44.7
206	8729.79	8649.02	0+47.5
207	8734.53	8630.23	normal
208	8728.91	8475.16	2+22.8
209	8957.21	8543.15	0+0
210	8957.34	8387.33	1+55.8
211	8836.62	8323.35	2+90.9
212	8831.25	8337.35	15' o/s
213	8841.99	8309.34	15' o/s
214	7950.62	8722.51	0+00
215	8163.89	8651.15	2+38.1
216	8172.63	8663.34	15' o/s
217	8155.15	8638.95	15' o/s
218	7958.15	8515.15	0+00
219	7962.14	8307.67	0+75.0
220	8181.16	8302.07	2+92.6
221	8183.37	8316.91	15' o/s
222	8178.95	8287.24	15' o/s
223	7999.24	8741.06	0+52
224	8643.18	7801.51	0+00