SE 1/4, SEC. 29, T 26 S, R 1 E

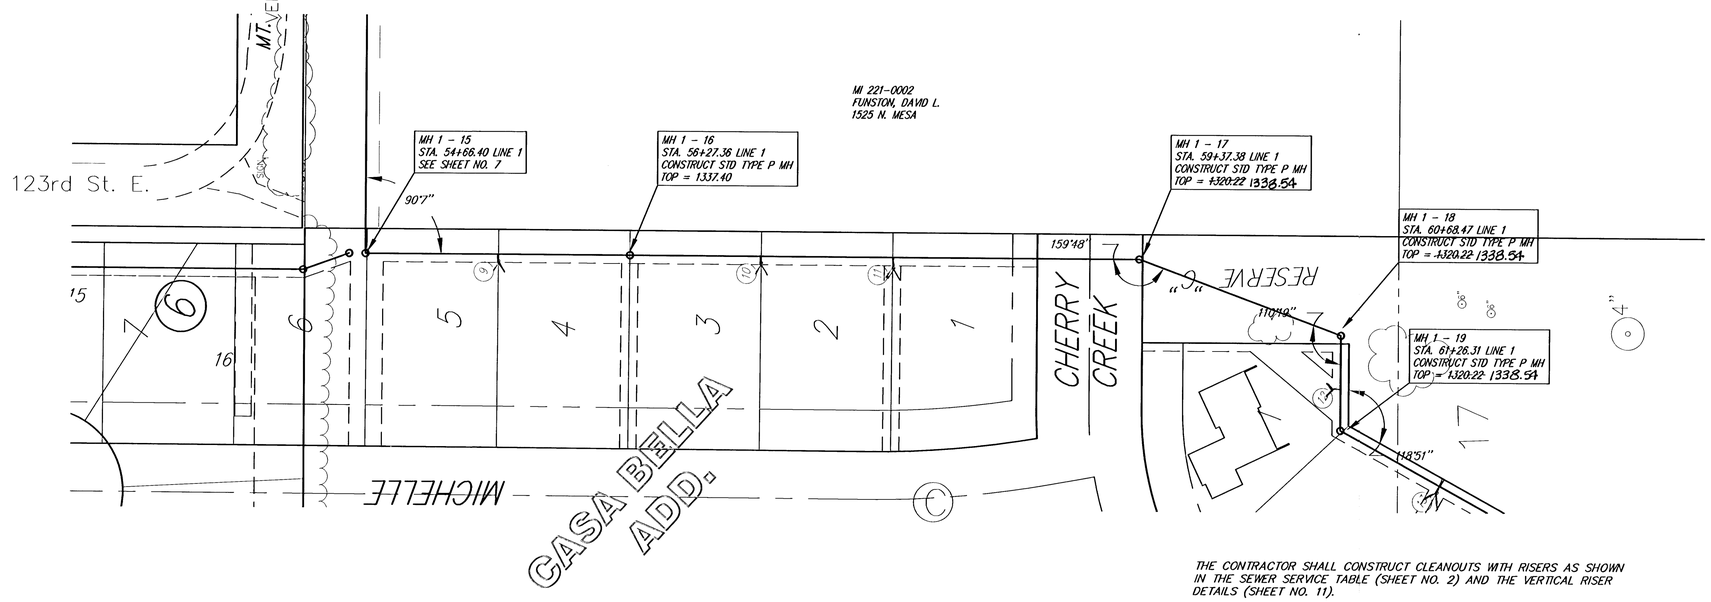

THE CONTRACTOR SHALL CONSTRUCT CLEANOUTS WITH RISERS AS SHOWN IN THE SEWER SERVICE TABLE (SHEET NO. 2) AND THE VERTICAL RISER DETAILS (SHEET NO. 11).

Scale 1" = 40' (Horiz.)
1" = 5' (Vert.)

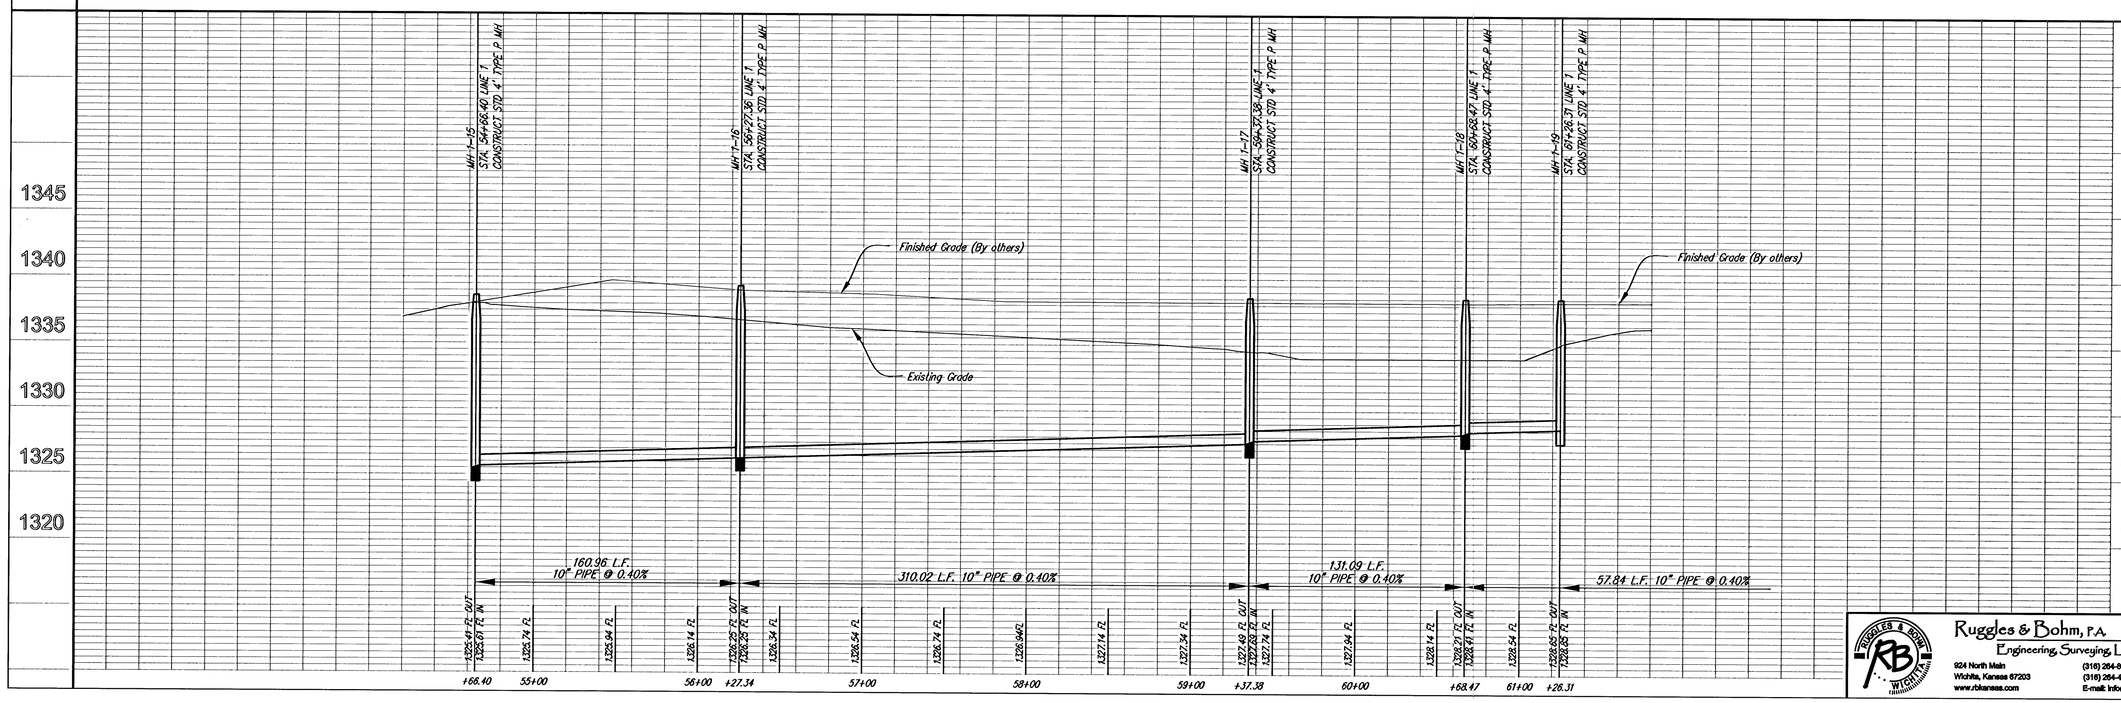

DESIGN	PDC
UTILITY	
DRAWN	PDC
DATE	9/27/05
REVISED	
REVIEW	11/17/05
PROJECT NUMBER	468-84026
DRAWING FILE	engg. base

SANITARY SEWER MAIN
LINE 1, MCEVOY
WICHITA, KANSAS

Ruggles & Bohm, P.A.
Engineering, Surveying, Land Planning
924 North Main
Wichita, Kansas 67203
www.rbkansas.com
(316) 264-8008
(316) 264-4621 fax
E-mail: info@rbkansas.com

RB JOB 2612X