

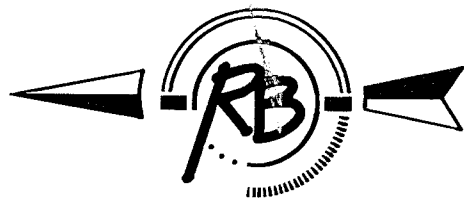


SE 1/4, SEC. 29, T 26 S, R 1 E

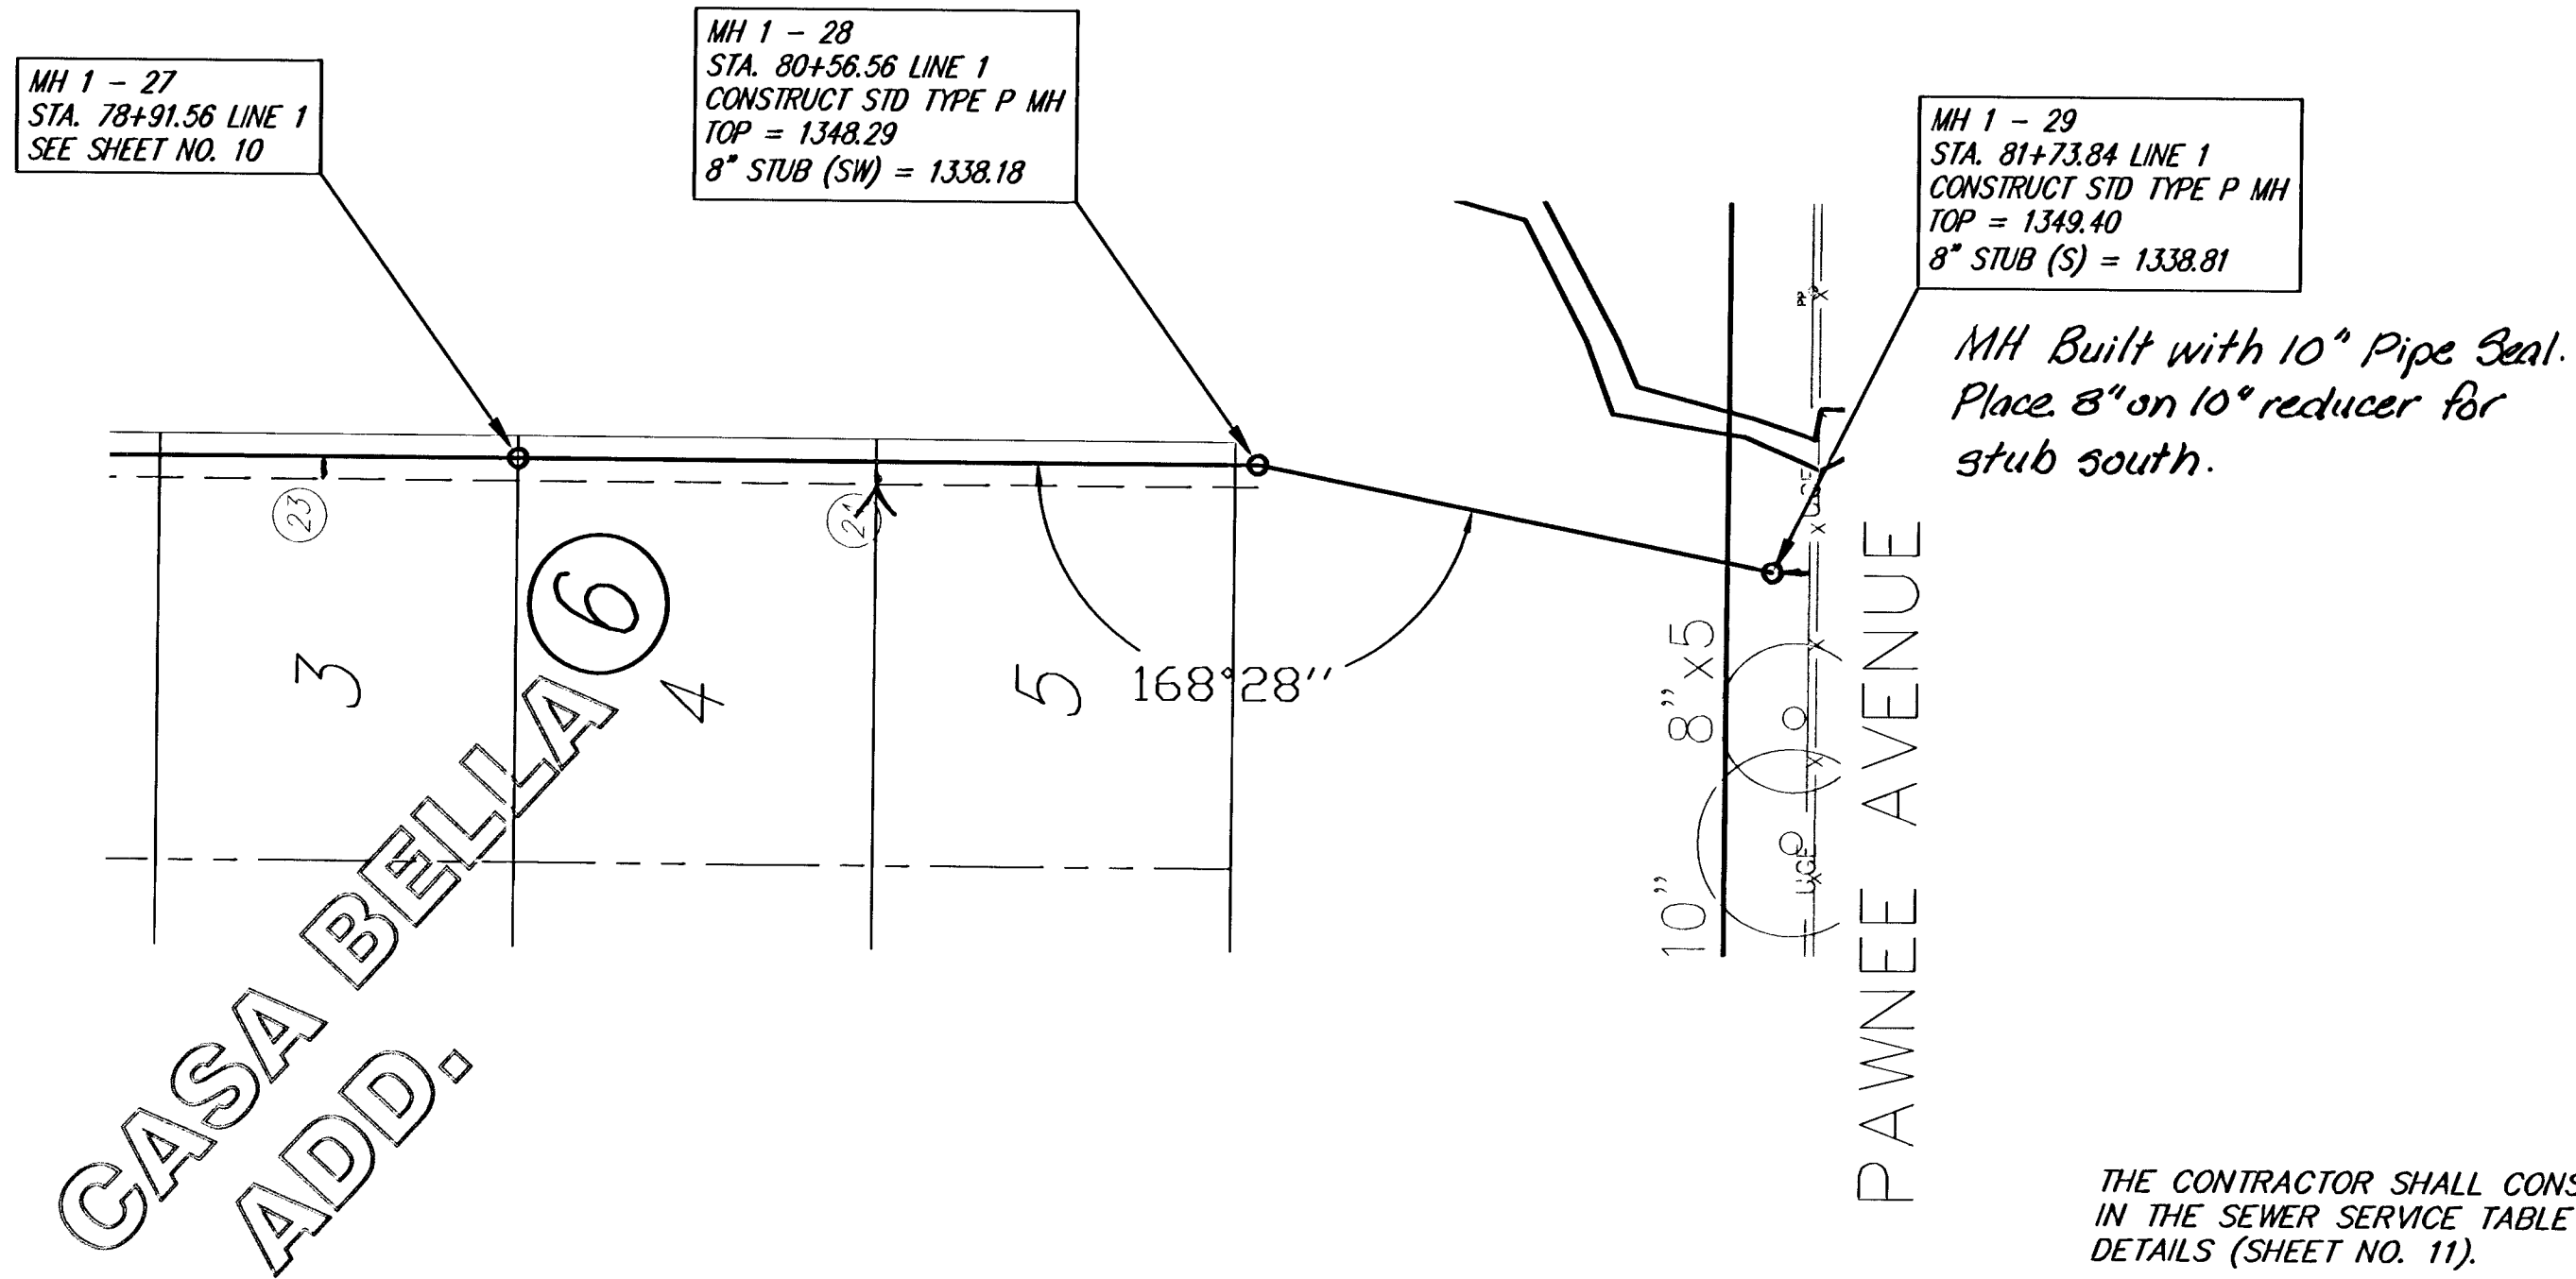

Scale 1" = 40' (Horiz.)
1" = 5' (Vert.)

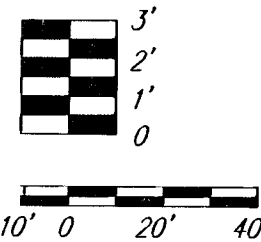

THE CONTRACTOR SHALL CONSTRUCT CLEANOUTS WITH RISERS AS SHOWN
IN THE SEWER SERVICE TABLE (SHEET NO. 2) AND THE VERTICAL RISER
DETAILS (SHEET NO. 11).


1350

1345

1340

1335

1330

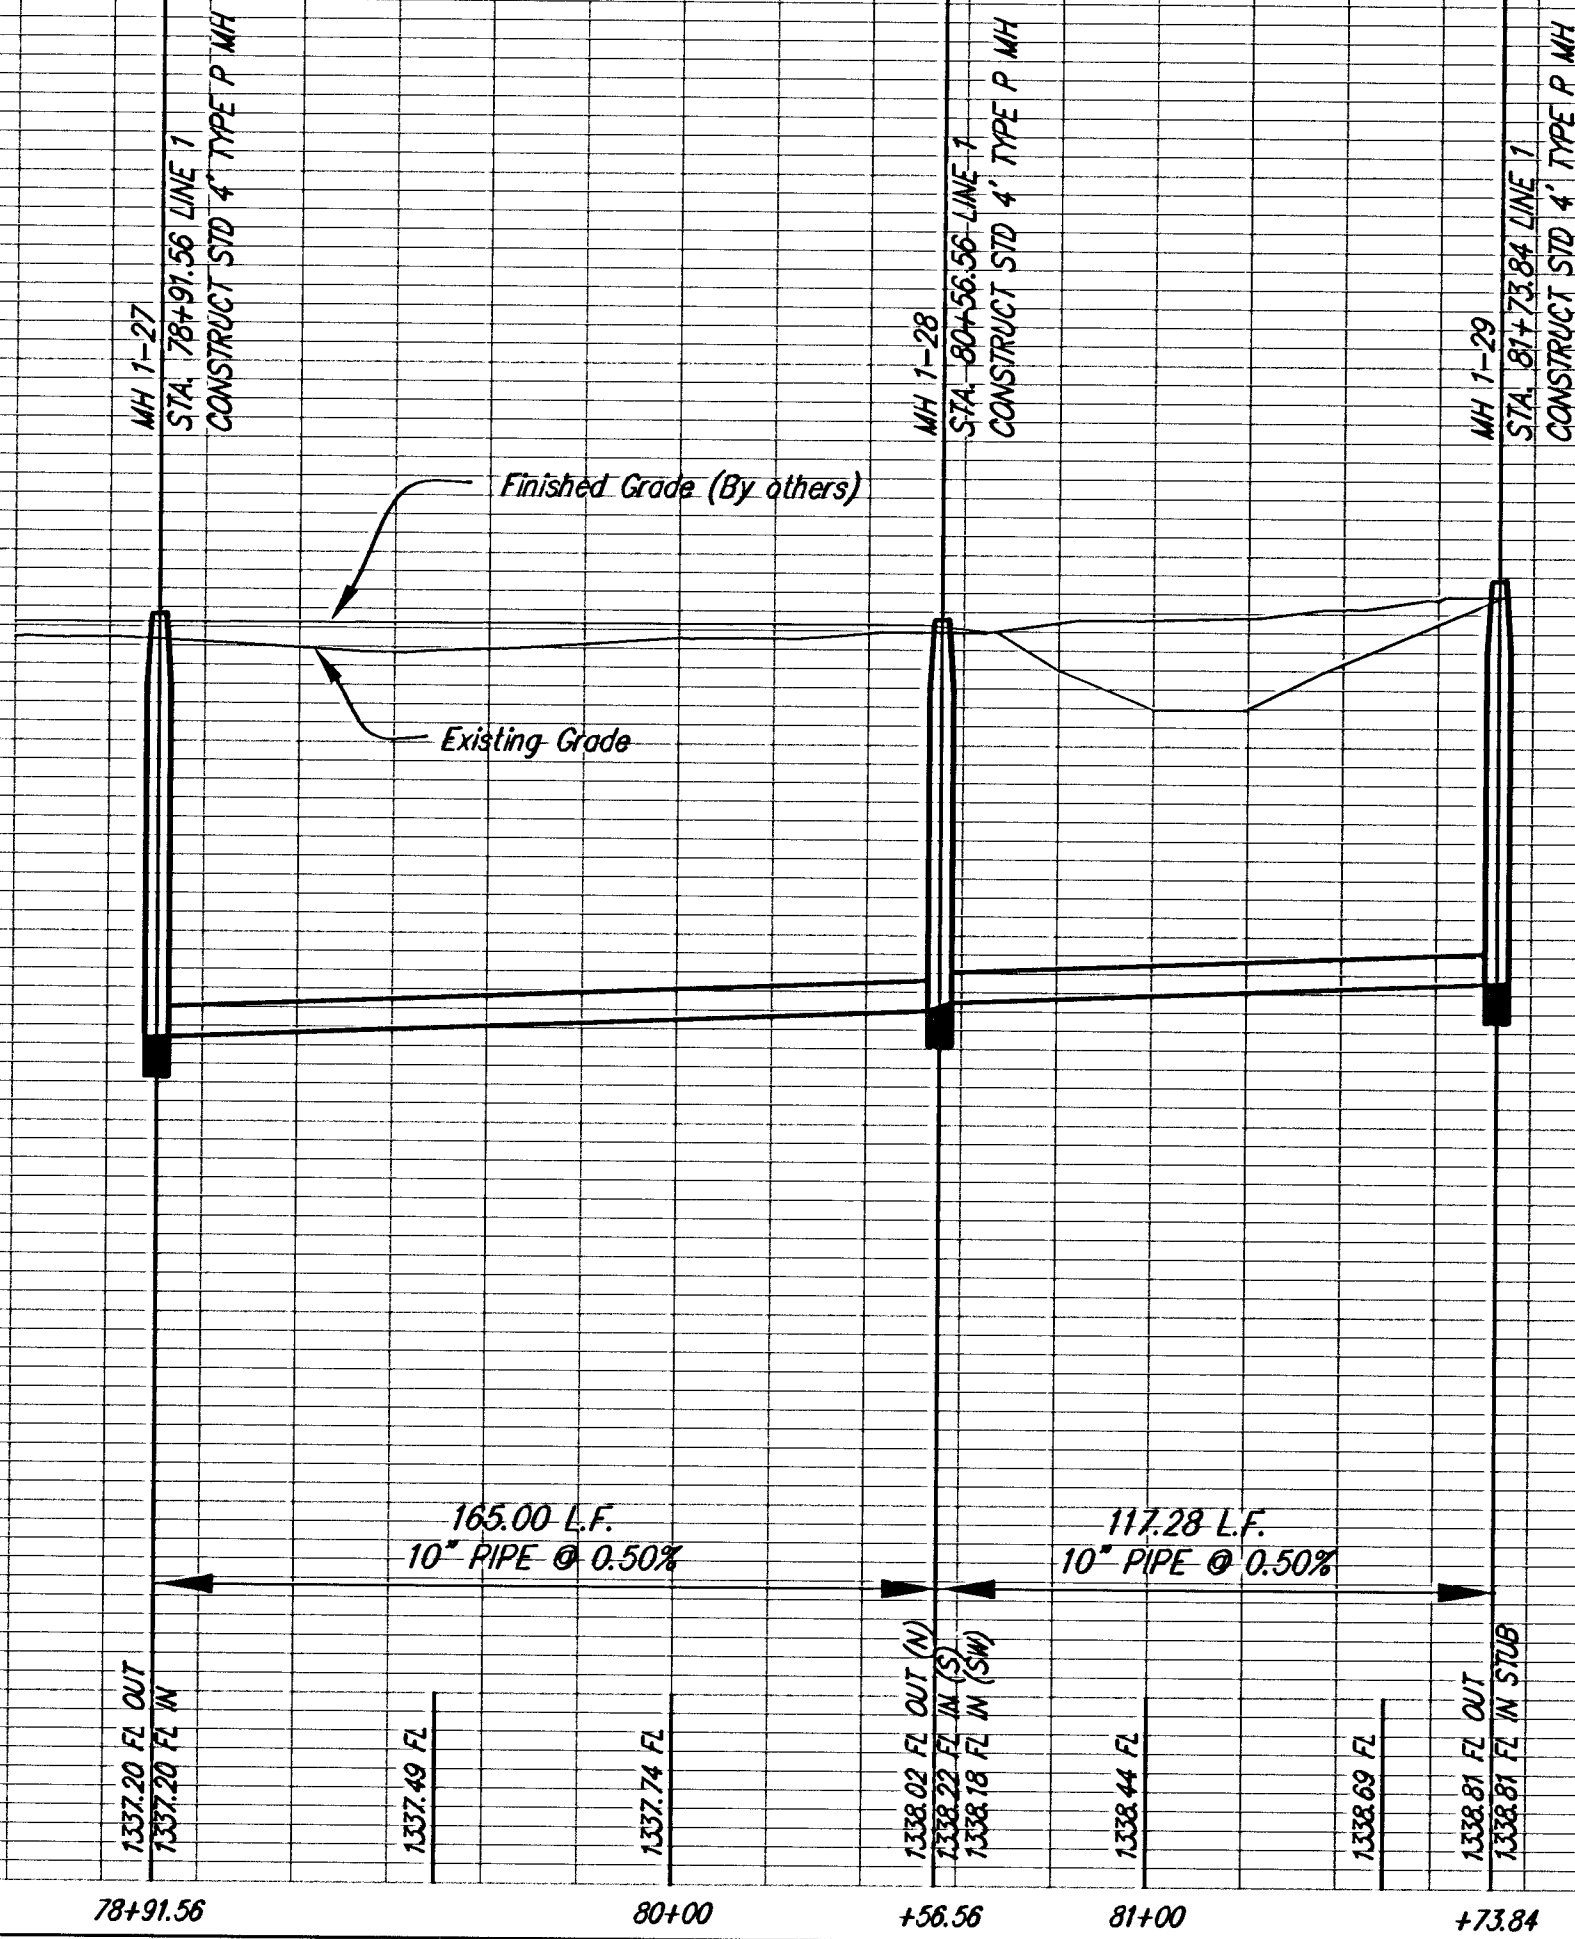

1350

1345

1340

1335

1330

SANITARY SEWER MAIN
LINE 1, MCEVOY
WICHITA, KANSAS



Ruggles & Bohm, P.A.
Engineering, Surveying, Land Planning
924 North Main
Wichita, Kansas 67203
(316) 264-8008
(316) 264-4821 fax
E-mail: info@rbkansas.com

PROJECT NUMBER	DESIGN	DATE	REVIEW
468-84026	PDC	9/27/05	12/14/05
PROJECT FILE	DESIGN	DATE	REVIEW
engg. base	PDC	9/27/05	12/14/05

RB JOB
2612X
SHEET
11
OF
17