


SWS LINE A

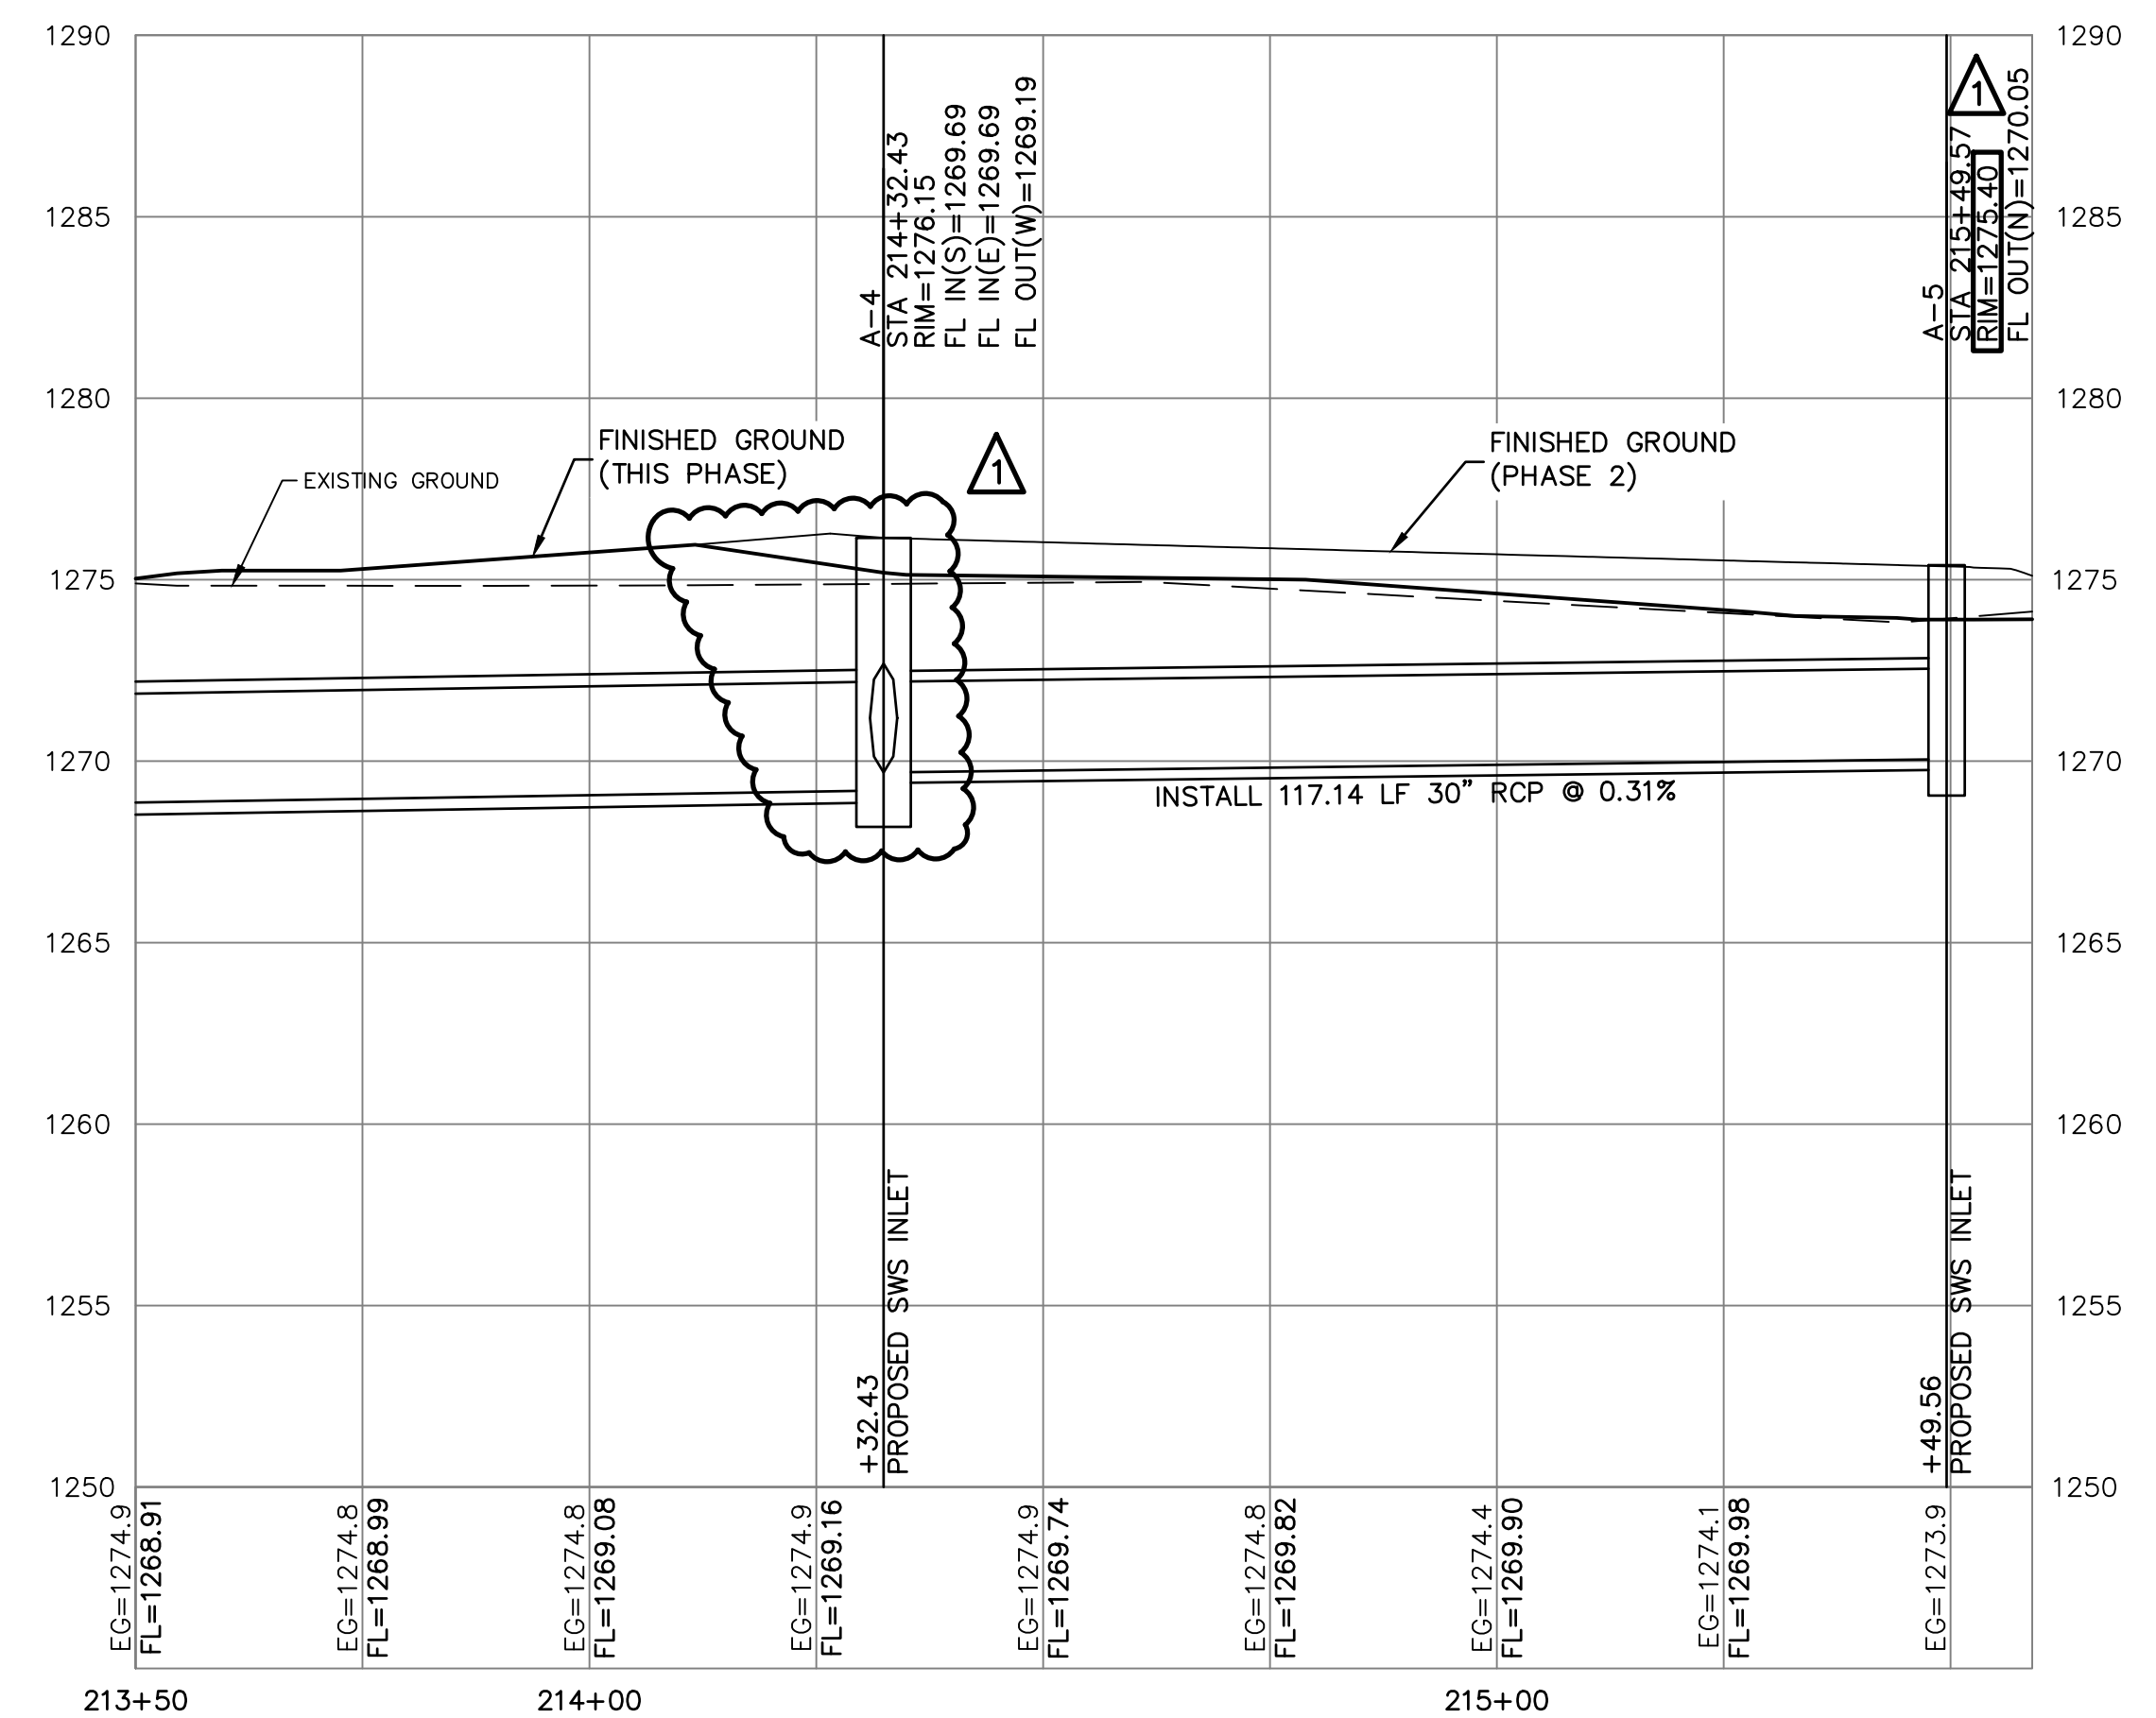

THIS DRAWING SHALL NOT BE UTILIZED BY ANY PERSON, FIRM, OR CORPORATION IN WHOLE OR IN PART WITHOUT THE SPECIFIC PERMISSION OF KAW VALLEY ENGINEERING, INC.

EKATERINA MIKHAYLICHENKO ENGINEER KS # 28404	PROJECT NO. G19-1259 DESIGNER TRA DRAWN BY ST CFN 1259-ID-DPP SHEET 4 REV 1
SYCAMORE POND ADDITION W 50TH STREET S & S OSAGE CIRCLE WICHITA, KANSAS PHASE II - STORM SEWER IMPROVEMENTS STORM SEWER LINE A - PLAN & PROFILE	200 N. EMPORIA, SUITE 100 WICHITA, KANSAS 67202 PH. (316) 440-4304 FAX (316) 440-4309 www.kawvalleyeng.com www.kveng.com KAW VALLEY ENGINEERING KAW VALLEY ENGINEERING, INC. IS AUTHORIZED TO OFFER ENGINEERING SERVICES BY KANSAS STATE CERTIFICATE OF AUTHORIZATION # E-113. EXPIRES 12/31/22
REV DATE DESCRIPTION	1 6-1-22 REVISED PER CITY & CLIENT COMMENT 0 4-15-22 INITIAL ISSUE
KM SRB DSN DWN CHK	KM SRB DSN DWN CHK