
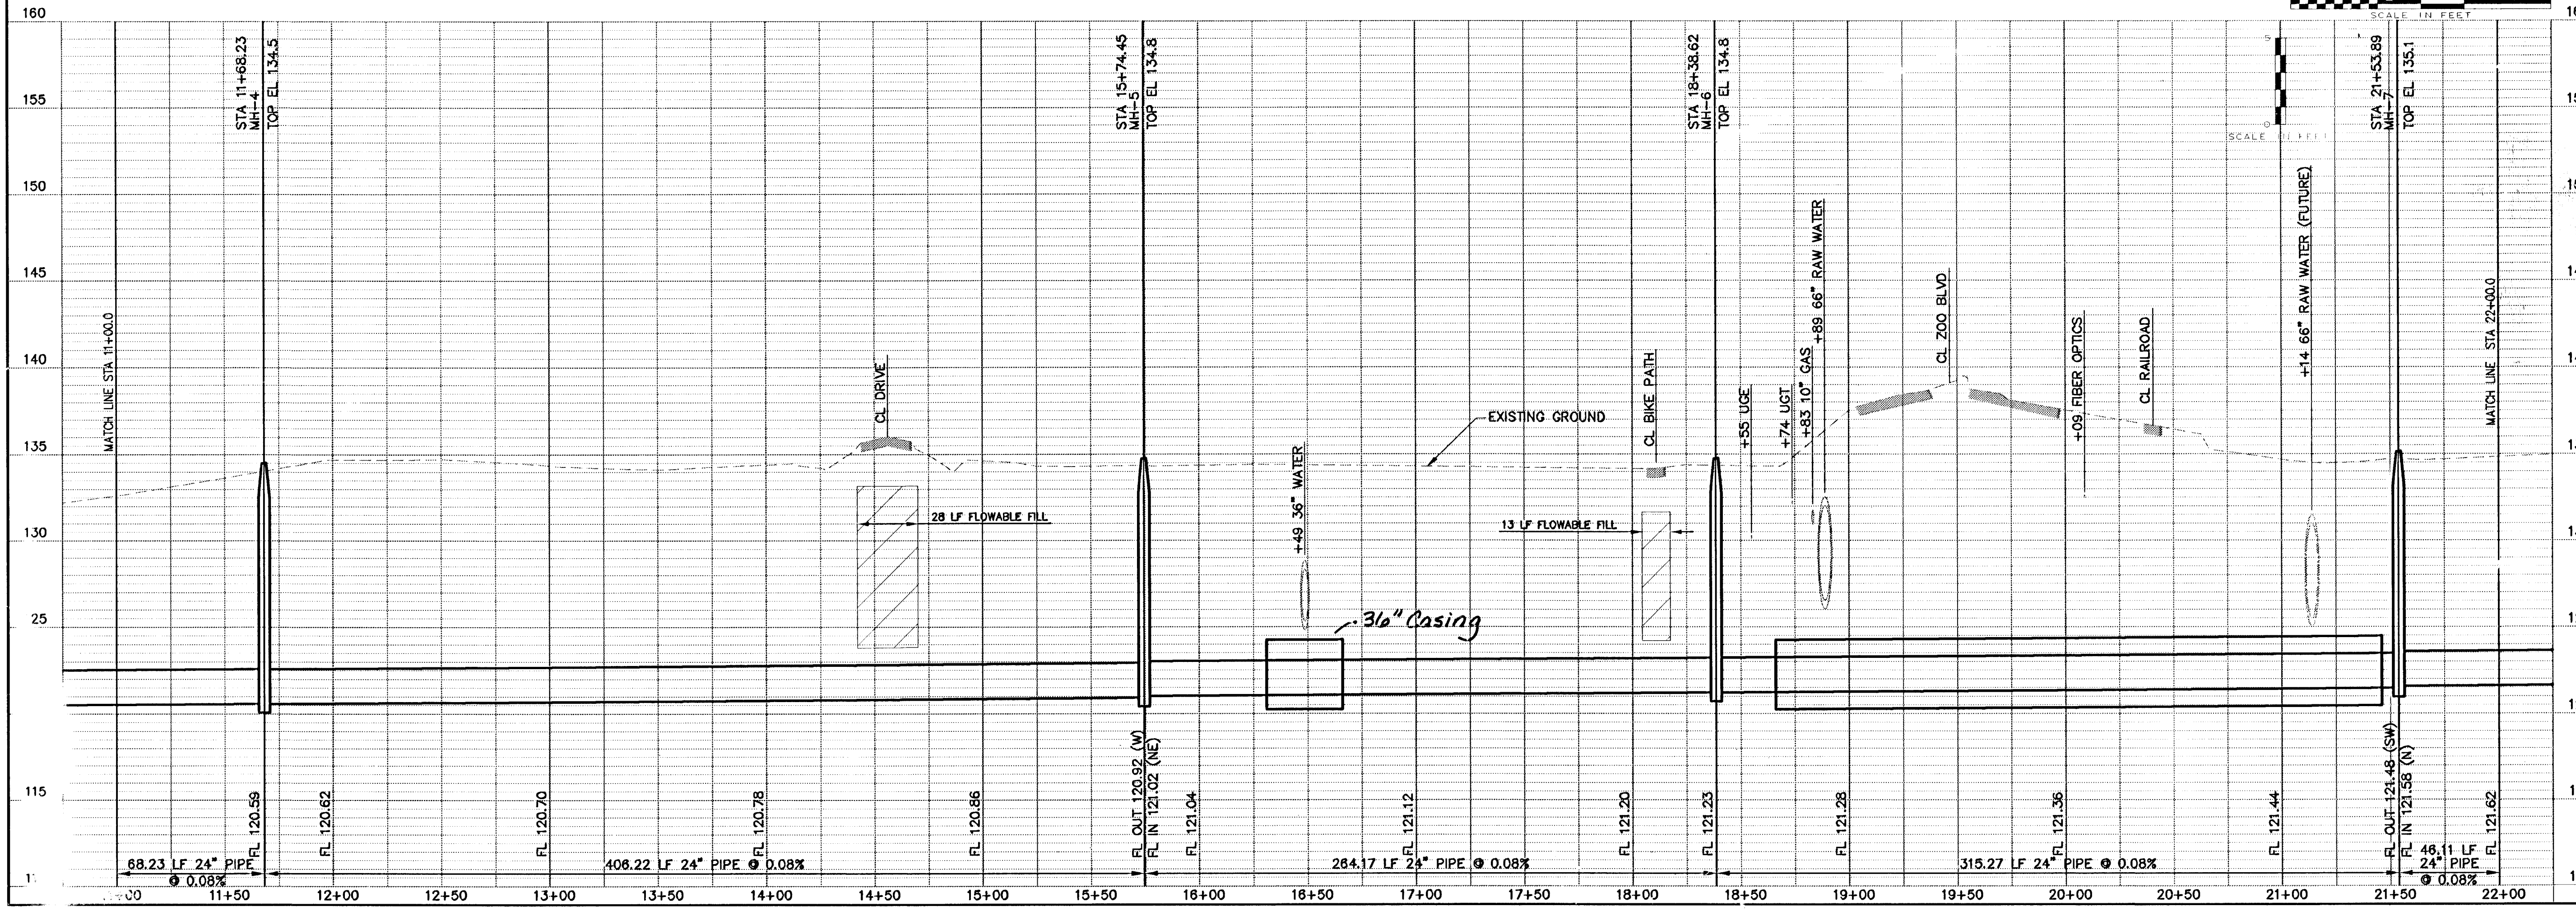


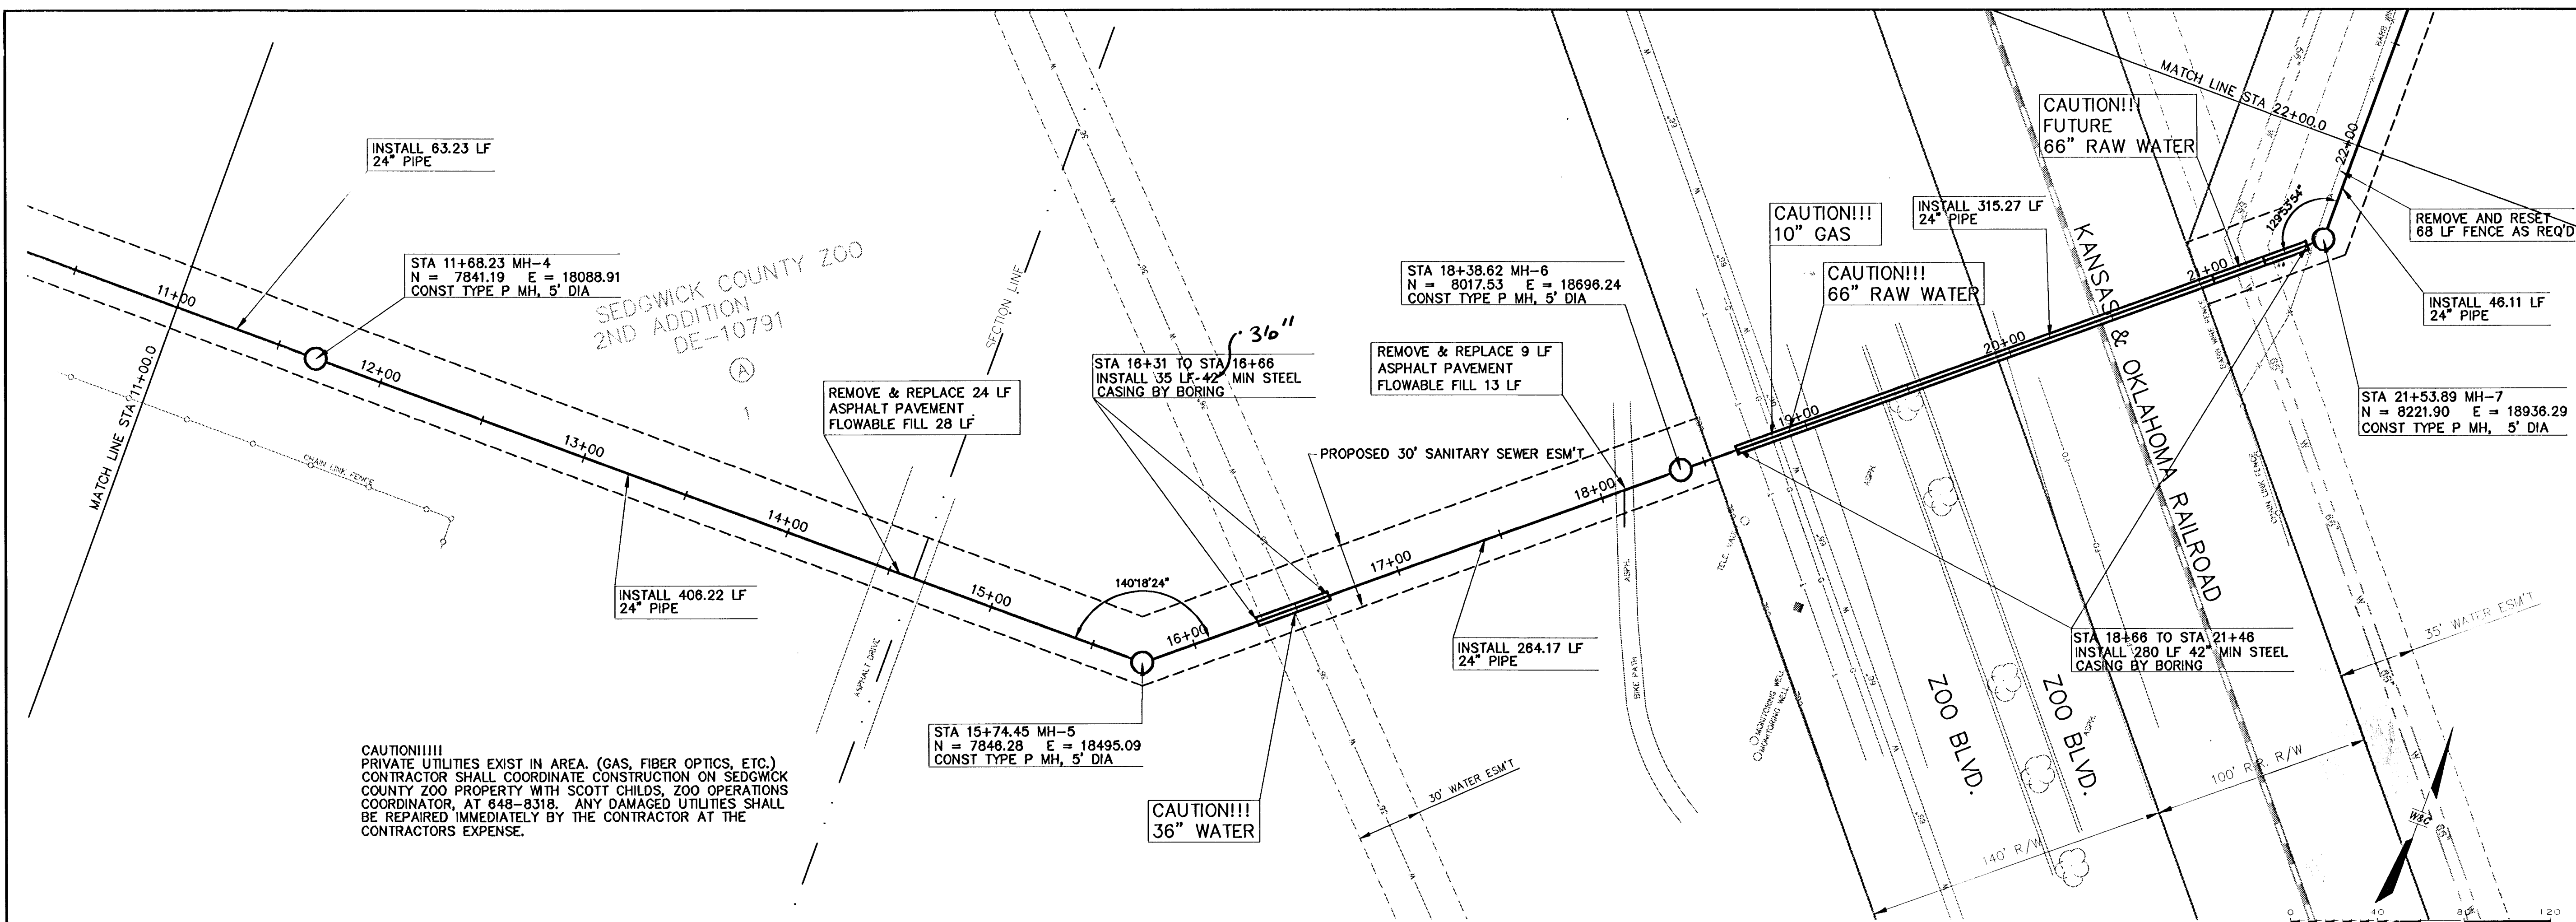

NO.	REVISION	DATE	BY

WILSON & COMPANY

CITY OF WICHITA, KANSAS
 MAIN 20 SOUTHWEST INTERCEPTOR SEWER
 468-83186
 PLAN & PROFILE
 STA. 11+00.0 TO STA. 22+00.0
 JIM L. ARMOUR, P.E. - CITY ENGINEER

DESIGN	CHECKED
DWH	JLM
DRAWN	MEK/KMD
DATE	APRIL 2004
FILE NO.	X1460002
SHEET NO.	4

WILSON & COMPANY
 WICHITA, KANSAS