
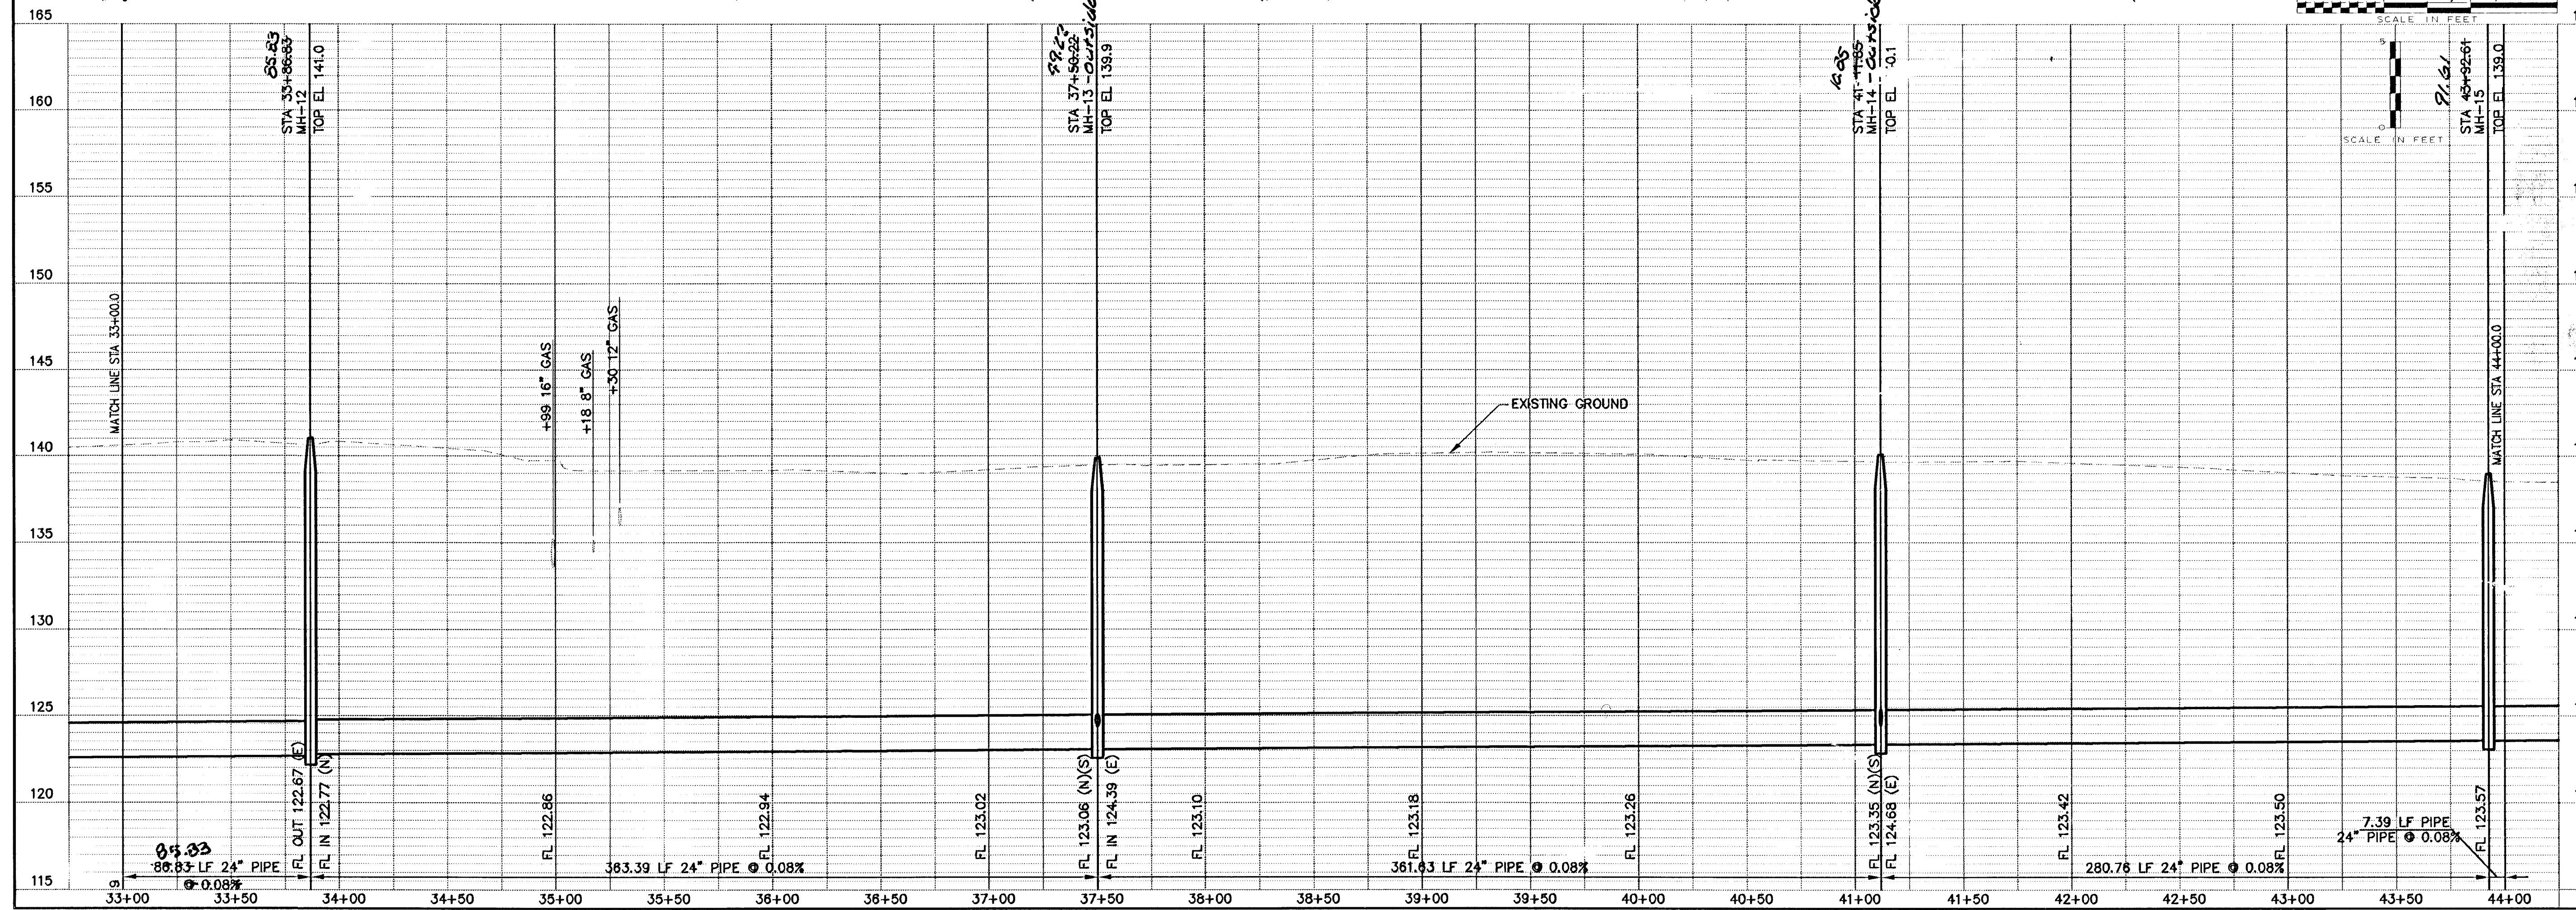


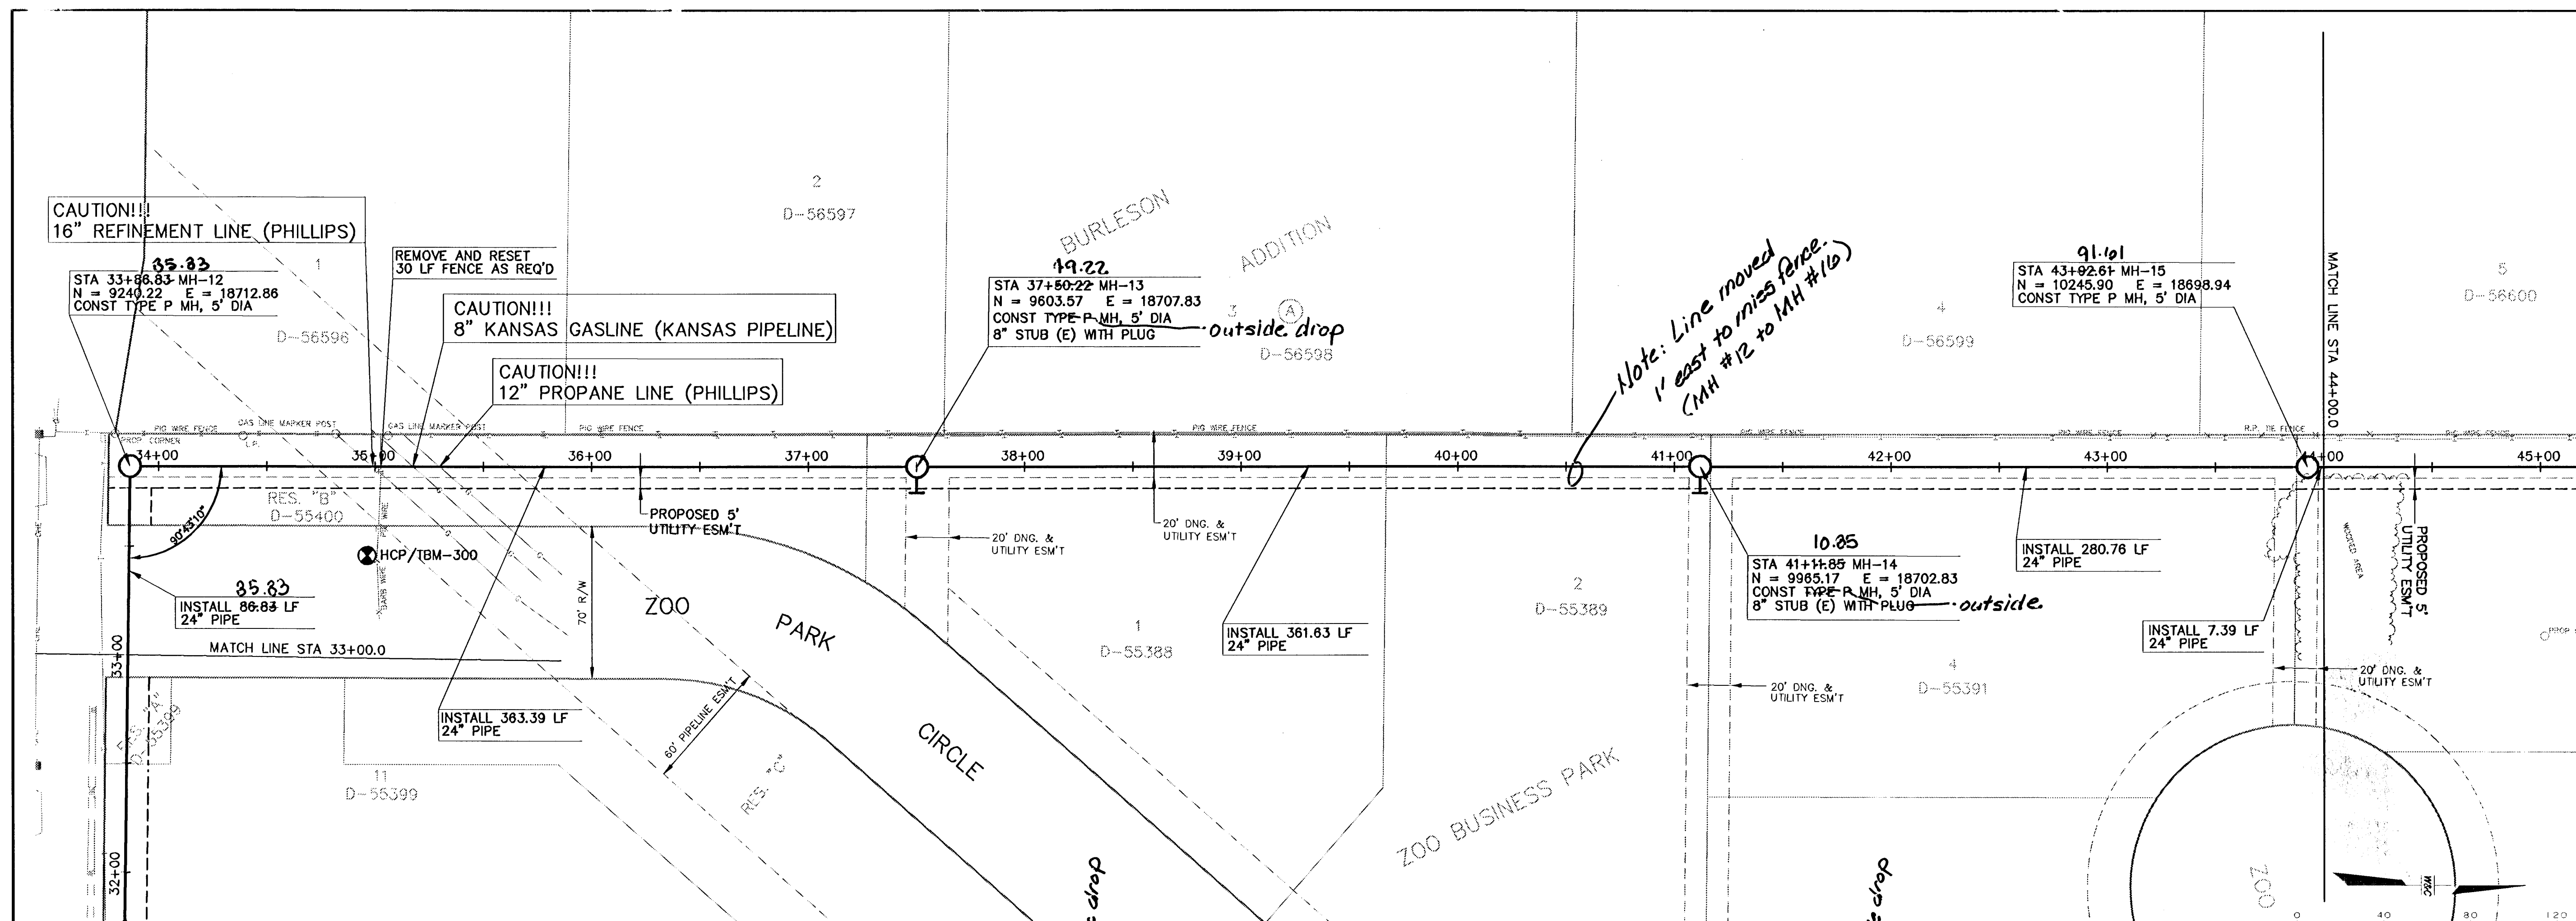

WILSON & COMPANY	
CITY OF WICHITA, KANSAS MAIN 20 SOUTHWEST INTERCEPTOR SEWER 468-83185 PLAN 8 PROFILE STA. 33+00.0 TO STA. 44+00.0 JIM L. ARMOUR, P.E., C.T. ENGINEER	
DESIGN: DWH DRAWN: MEK/KMD DATE: APRIL 2004 FILE NO: X1460002 SHEET NO: 6	CHECKED: JLM MEK/KMD APRIL 2004 X1460002 6