
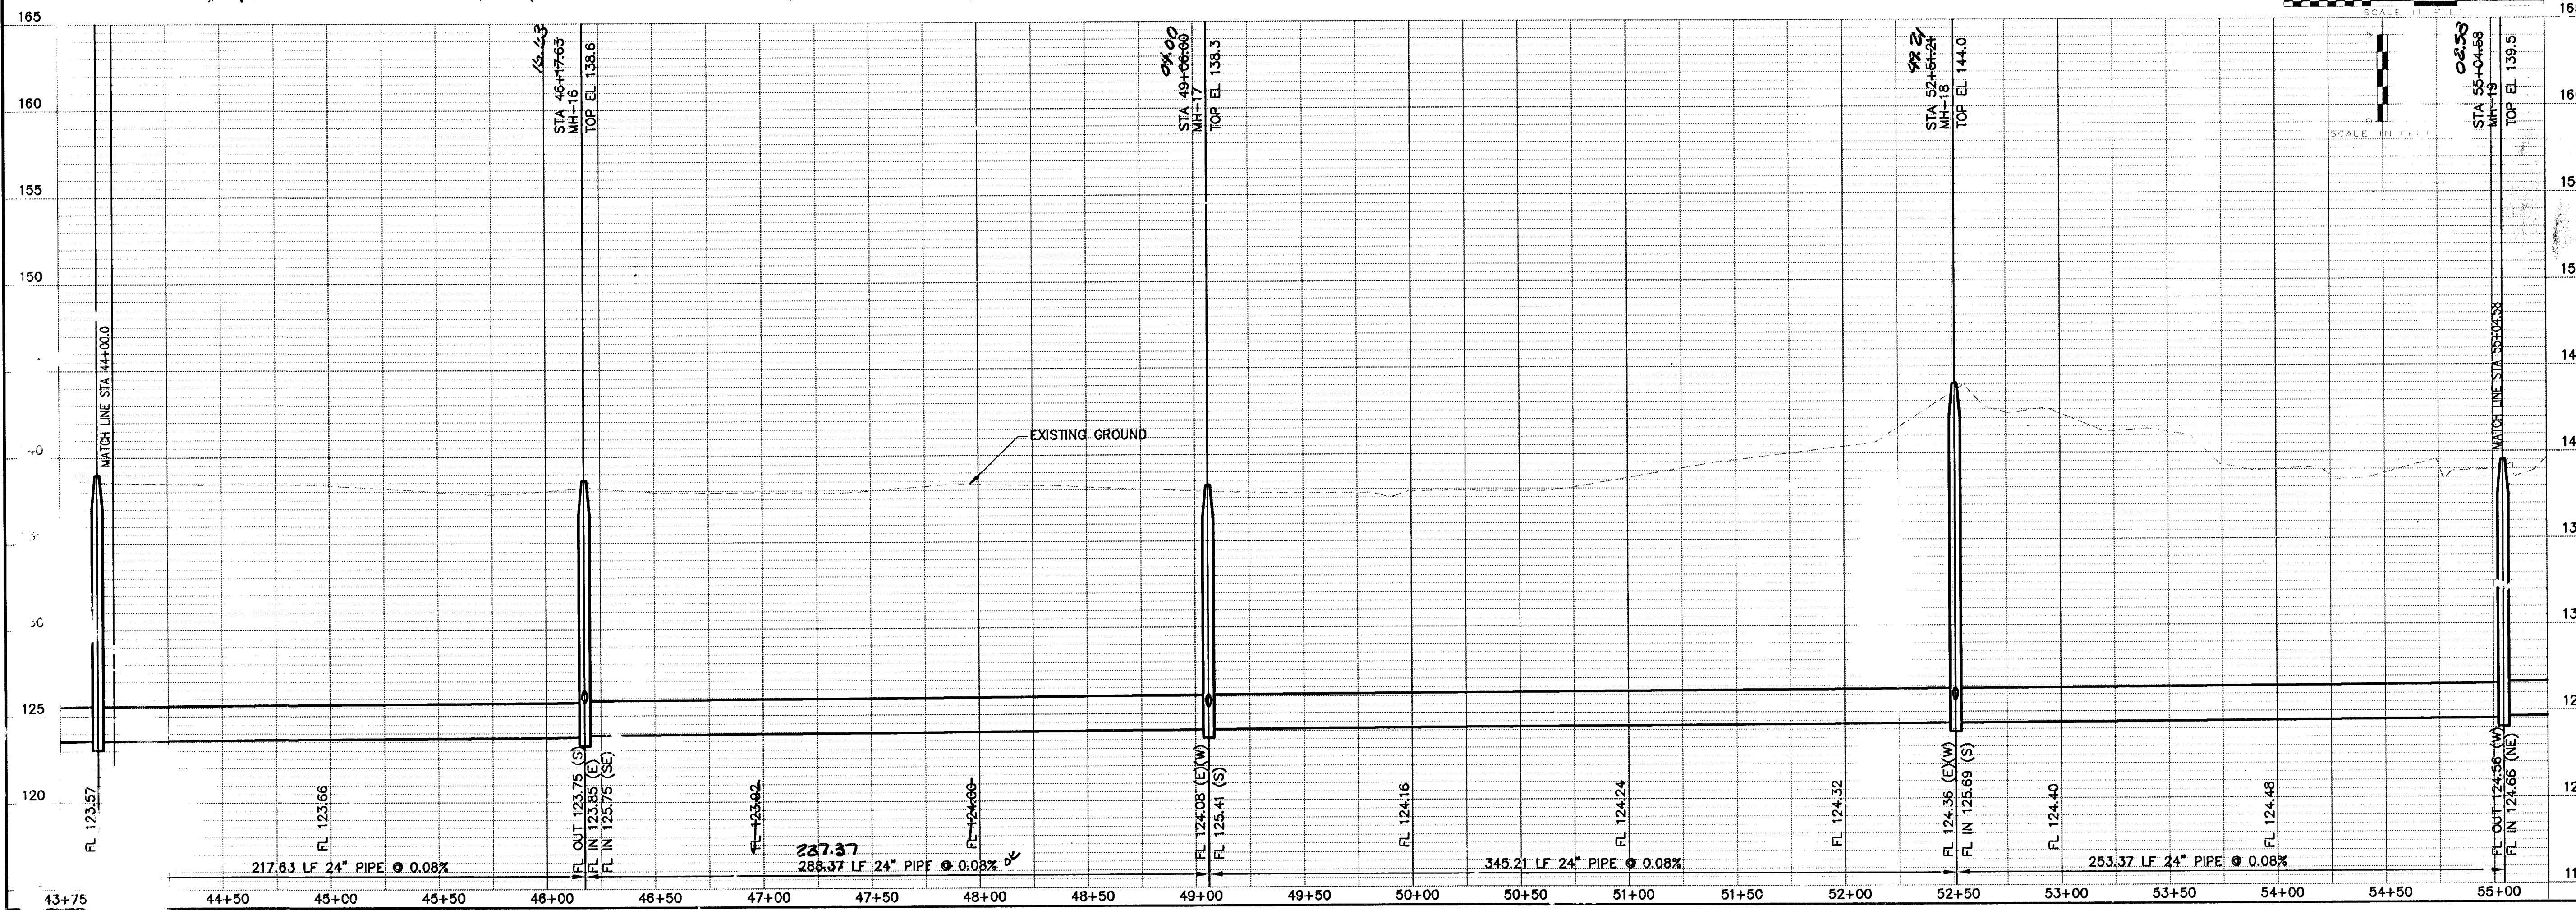


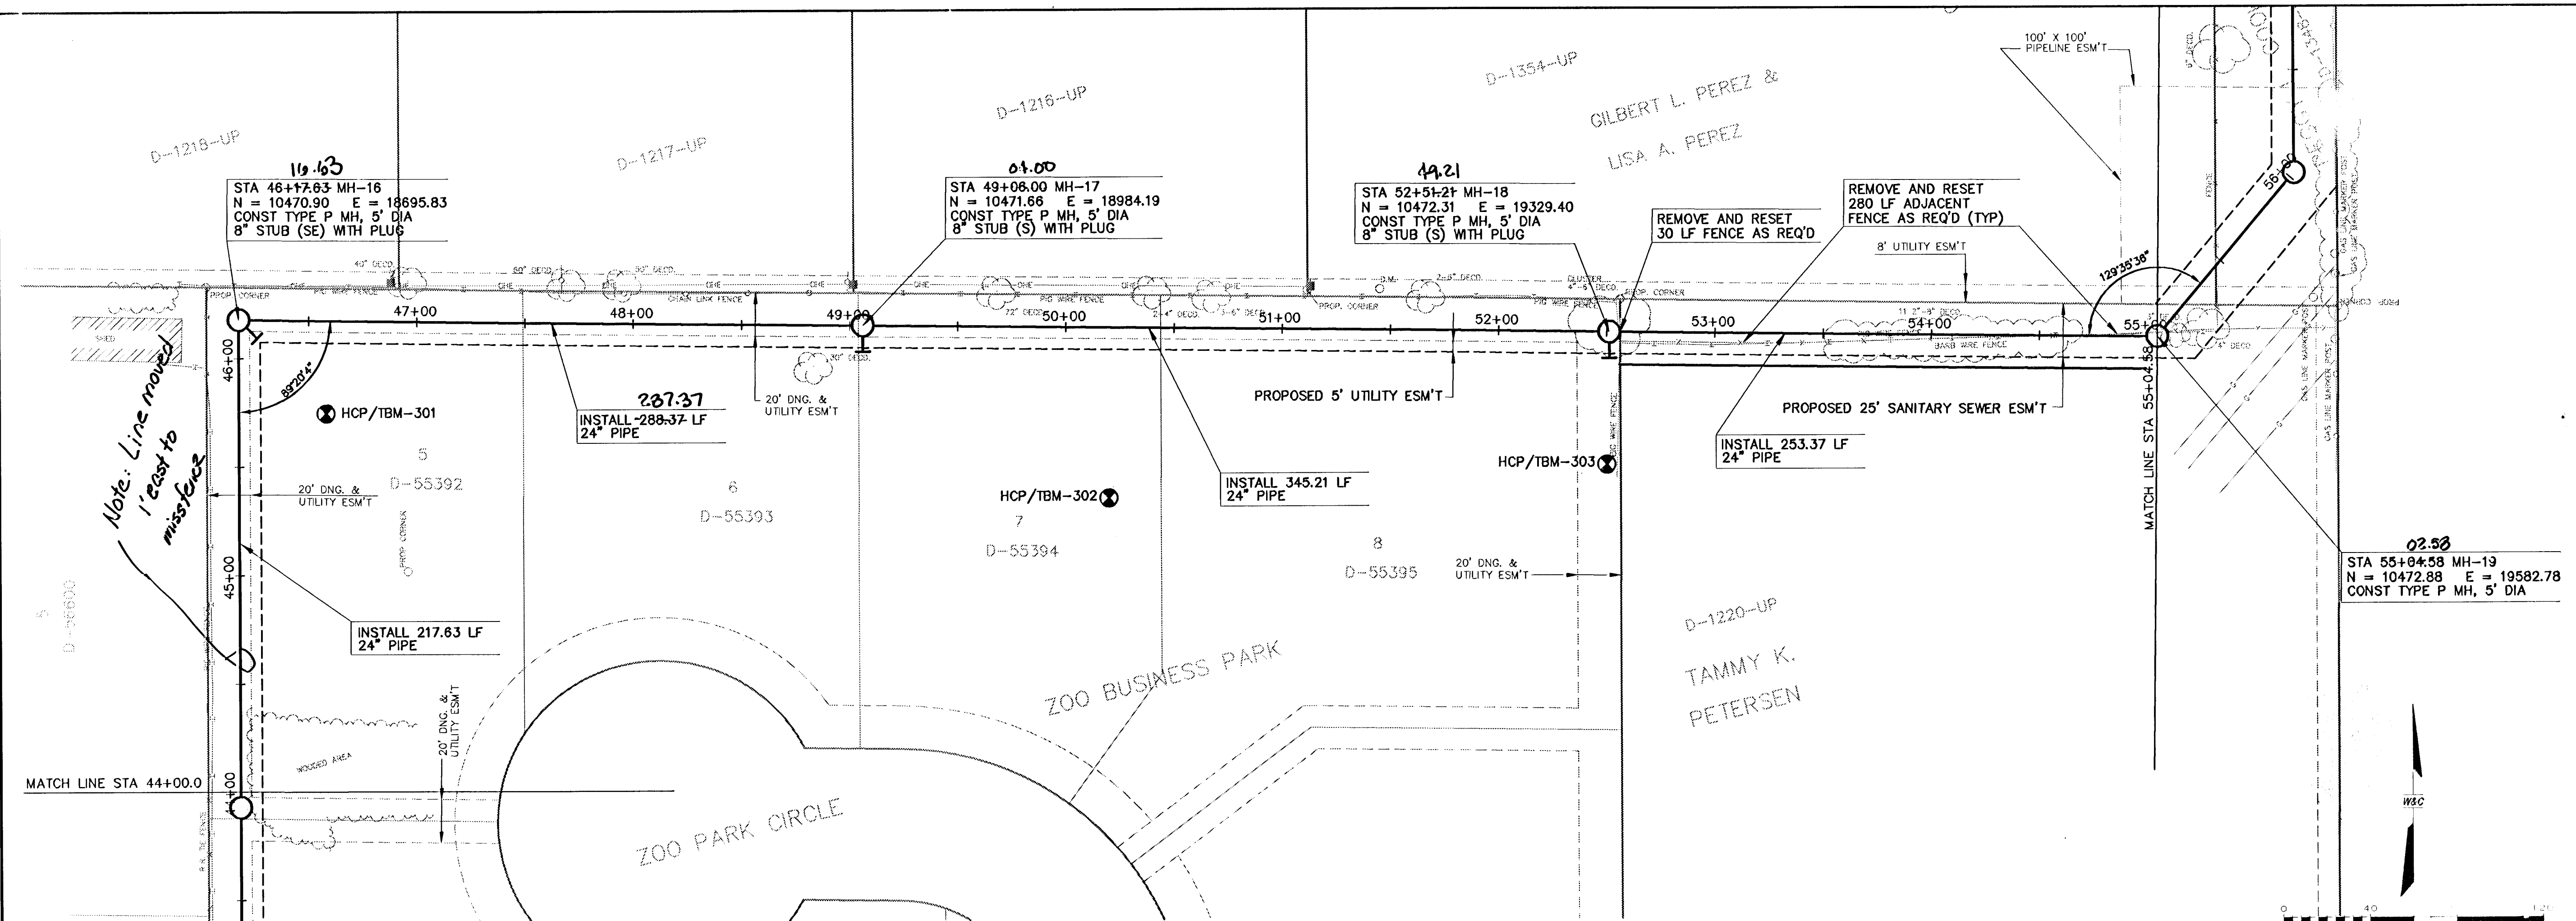

DESIGN: DHW		CHECKED: JLM	
DRAWN: MEK/KMD			
DATE: APRIL 2004			
FILE NO: X1460002			
SHEET NO: 7			

WILSON & COMPANY
WICHITA, KANSAS

CITY OF WICHITA, KANSAS
MAIN 20 SOUTHWEST INTERCEPTOR SEWER
PLAN & PROFILE
STA. 44+00.0 TO STA. 55+04.58

PROFESSIONAL ENGINEER
KANSAS
13329
4-06-04
J. L. ARMOUR, P.E. - CITY ENGINEER