LATERAL 33, MAIN 1, WESTLINK SEWER

EVERGREEN PLACE ADDITION
PROJECT NUMBER 468-83804
OCA NUMBER 744061

WICHITA, KANSAS
JIM ARMOUR, P.E., ACTING CITY ENGINEER

GENERAL NOTES

1. Contractor will be required to provide notice to utility companies a minimum of twenty-four (24) hours prior to any excavation, as follows:

The Contractor must notify the following in case of an emergency:

Southwestern Bell Telephone Co.
154 N. Broadway
Wichita, Kansas 67202
Jim Toben
316-268-2245

Westar Energy
P.O. Box 208
Wichita, Kansas 67201
Jimmy Washington
316-261-6315

Wichita Water & Sewer Dept.
8th Floor, City Hall
455 N. Main St.
Wichita, Kansas 67202
Bill Perkins
316-268-4555

Aquila Network
1611 S. Hoover
Wichita, Kansas 67209
Calvin Briggs
316-941-7233

Wichita Water & Sewer Dept.
8th Floor, City Hall
455 N. Main St.
Wichita, Kansas 67202
Bill Perkins/Paul Bryant
316-268-4555

Cox Communications
701 E. Douglas
Wichita, Kansas 67202
Brian Ring
316-262-4270 Ext.169

Kansas One Call
800-344-7233

Emergency 911

2. Contractor shall not start work on the project until the project inspector is assigned to the project and is present on the site. Any work done without inspection will be required to be uncovered for inspection.

3. Underground utility service lines and overhead utility pole lines are to be adjusted as necessary by others prior to construction, unless the plans specifically call for their locations, as shown on the plans, represent the best information obtainable for design. Location information has been obtained from the various utility companies and is either from company record drawings or company-provided field locations. The Contractor will be required to work around existing utilities within the right-of-way which do not conflict with proposed construction.

4. The contractor shall be responsible for preserving property irons. The Contractor will be required to reestablish any property irons which are damaged or destroyed by his construction operations. Such irons shall be reestablished by a licensed land surveyor in accordance with state law.

5. All areas disturbed by construction operations shall be seeded with rye grass at a rate of 300 lbs/acre immediately following construction in that area. Ground shall be prepared per City of Wichita specifications prior to seeding.

6. Contractor shall verify the location of all utilities prior to beginning construction.


7. Contractor shall implement Best Management Practices in accordance with city regulations.

8. Remove trees only as necessary for sanitary sewer construction.

9. Restore ditch flowline grades prior to project completion.

10. Replace culvert pipes with existing pipe to previous flowline elevations.

11. Replace mailboxes with existing mailboxes.

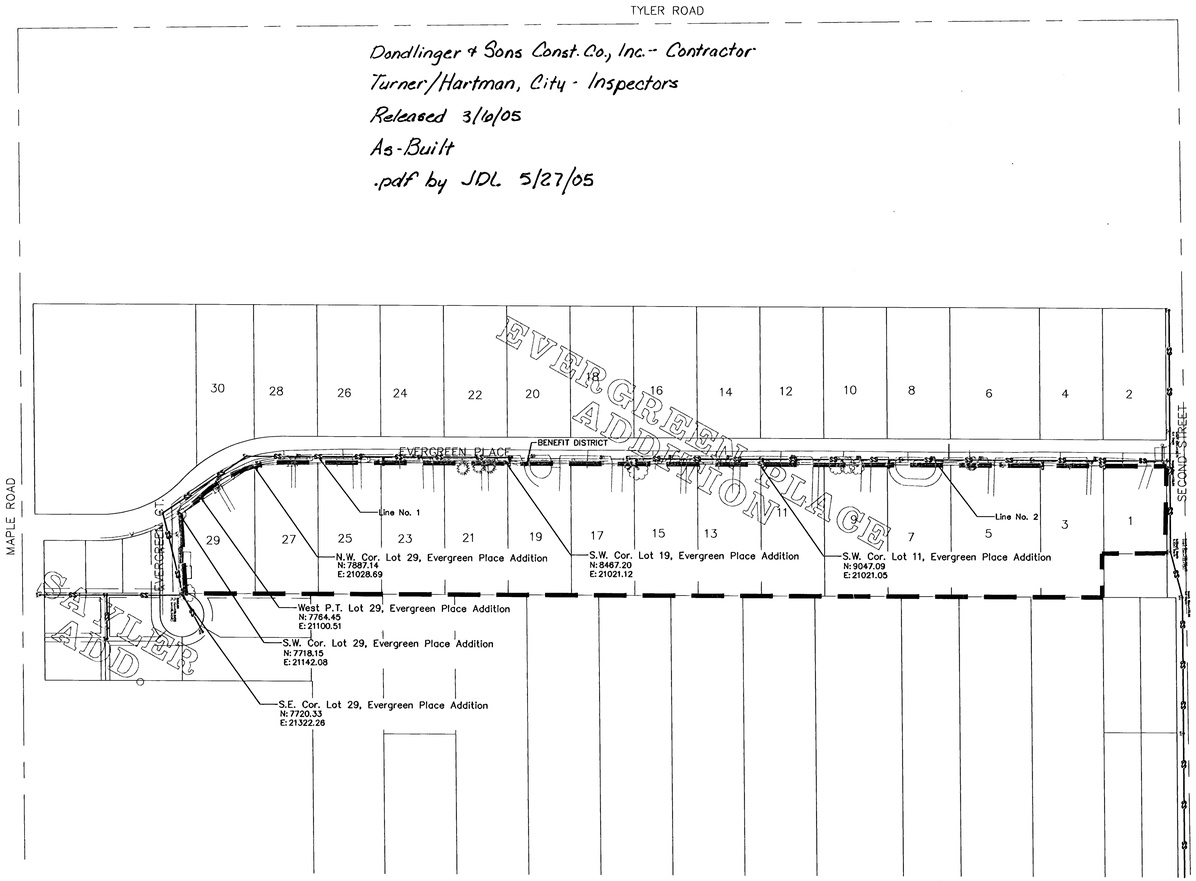

SCALE
150 0 150 300

SHEET INDEX

1	Cover Sheet
2	Standard Type "P" Manhole
3-5	Plan & Profile
6-10	BMP'S


BENCHMARK

1. City of Wichita disc in turn island 50.7' N. & 39.3' E of Intersection of Tyler & Maple.

   Elev. 144.12 City Datum

2. "U" cut in the center of the concrete headwall of RCP Approx. 200' N. of 2nd Street & Approx. 990' W. of Evergreen.

   Elev. 137.25 City Datum

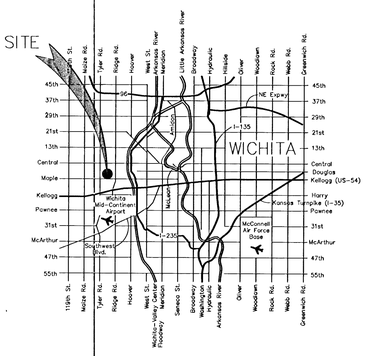

VICINITY MAP

FILENAME: 040255st1fp

TIMOTHY R. MARTIN
LICENSED
11498
KANSAS
PROFESSIONAL ENGINEER
10/8/04

© AM Consulting, Inc.

AM CONSULTING Inc.
ENGINEERING SERVICES
142 N. Emporia Wichita, KS 67202
316/265-2870 fax: 316/265-2839