WCEA FILE: 81-323B

CITY	STATE	PROJECT NO.	FISCAL YEAR	SHEET NO.	TOTAL SHEETS
WICHITA	KANSAS	*	1982	8	22

* 472-76-245-81101-000-000-001

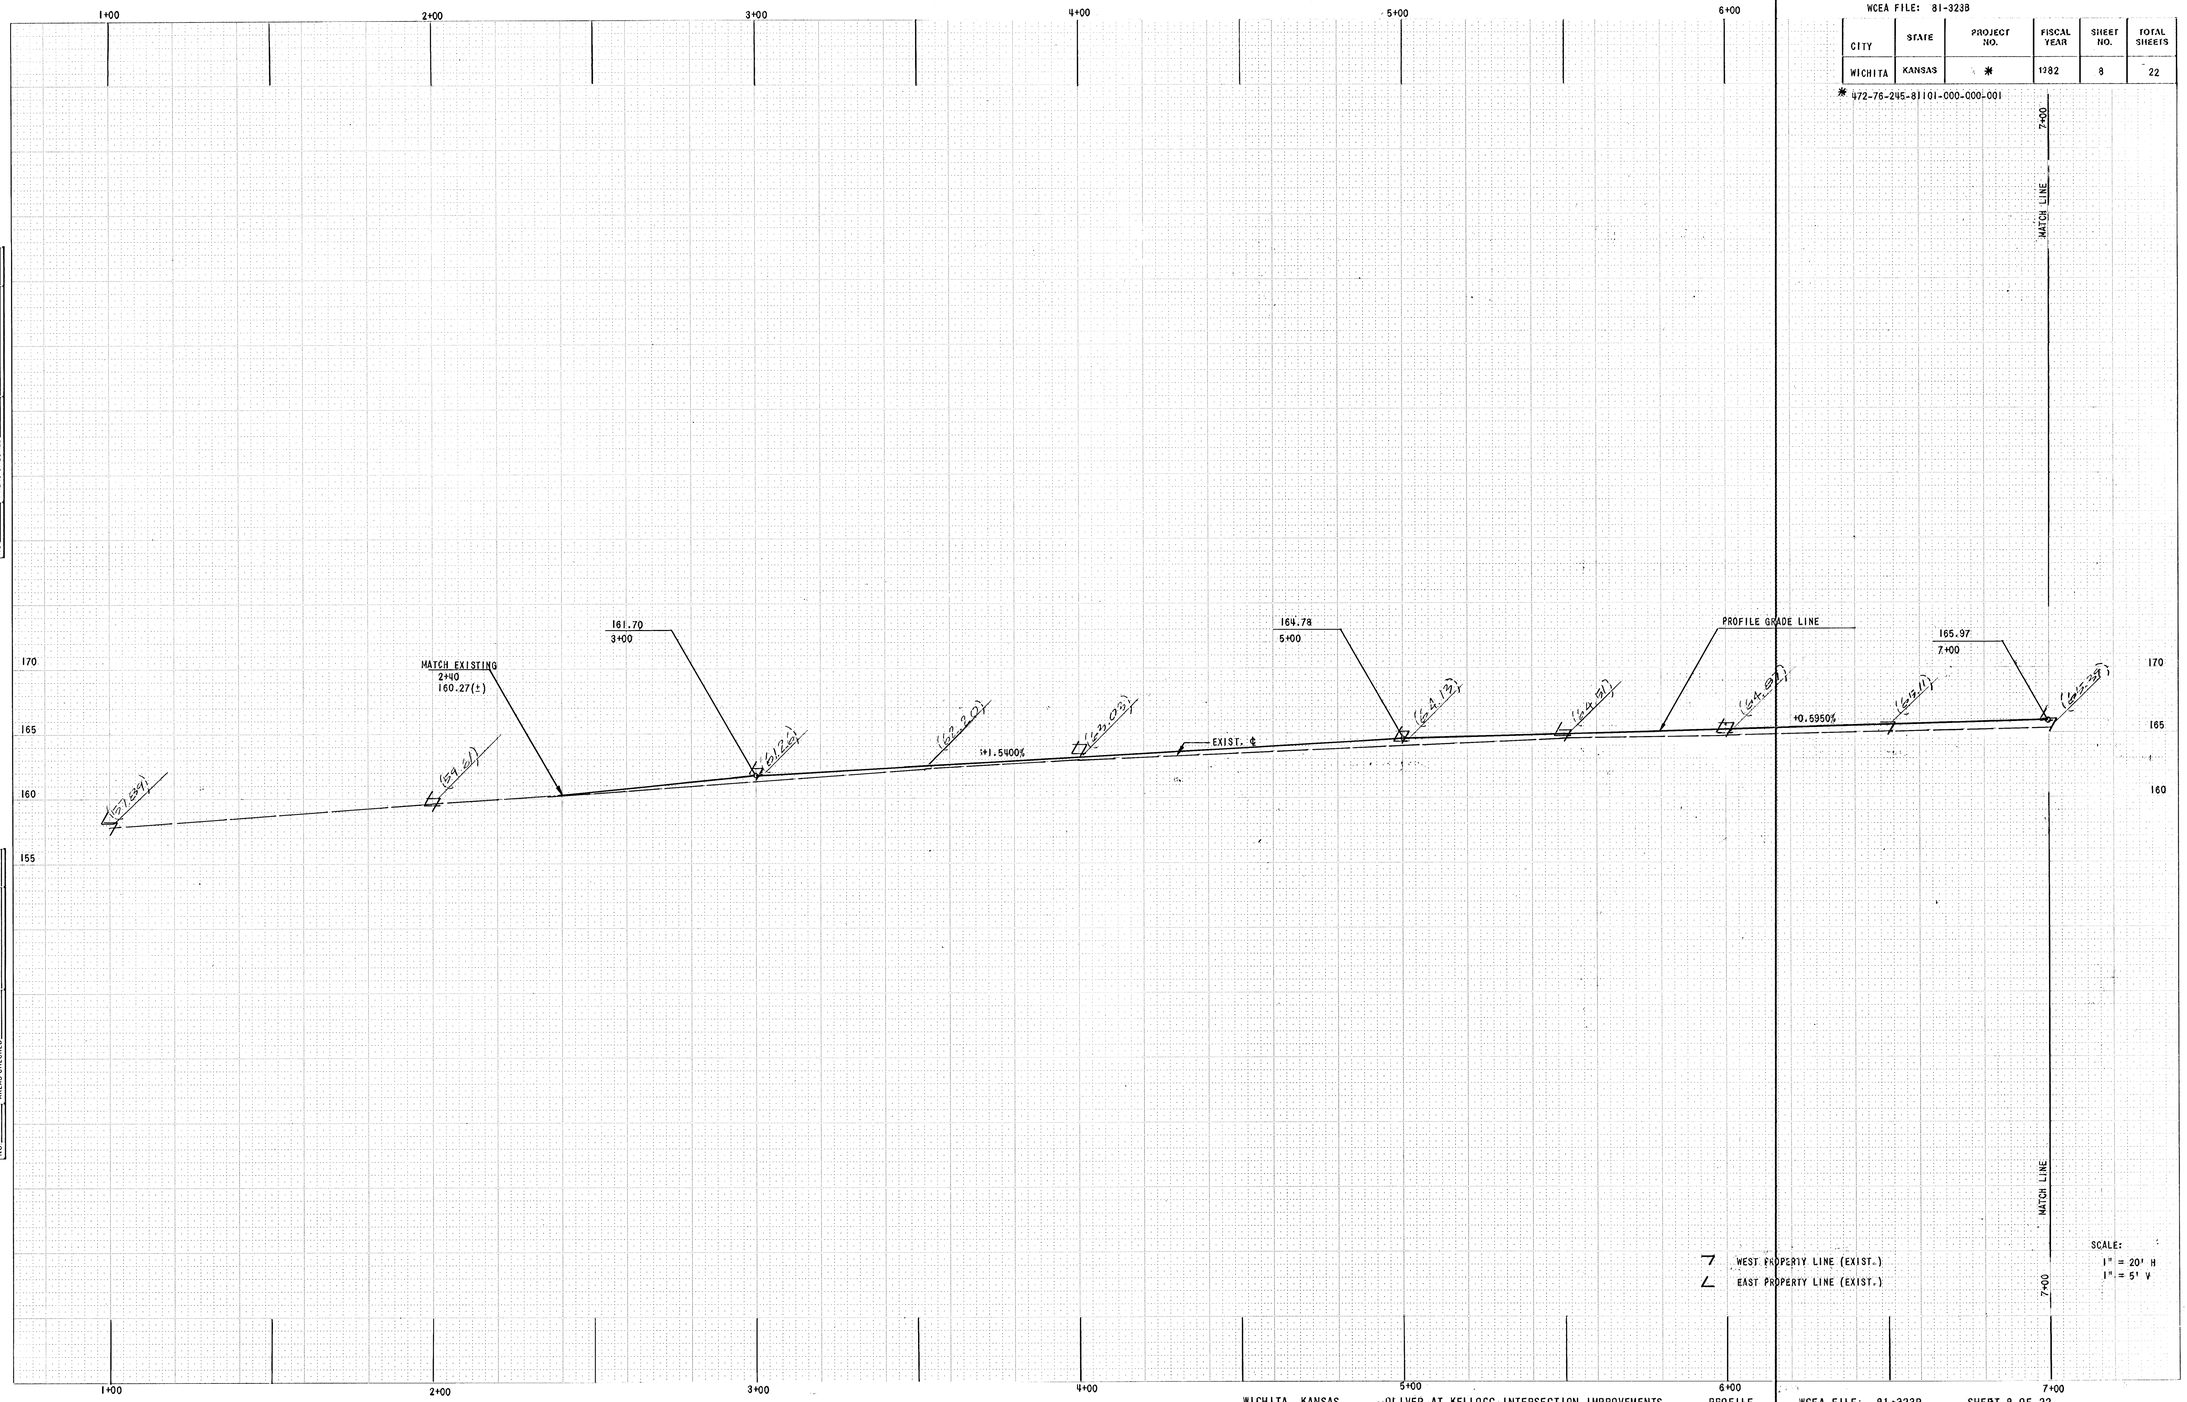

FINAL SURVEY		BY	DATE
NOTE BOOK	SURVEYED		
NO.	PLOTTED		
	TABULATED		
	AREAS		
	AREAS CHECKED		

ORIGINAL SURVEY		BY	DATE
NOTE BOOK	SURVEYED		
NO.	PLOTTED		
	TABULATED		
	AREAS		
	AREAS CHECKED		